	INDEX TO DRAWINGS	
SHEET NO.	DESCRIPTION	
1	TITLE SHEET	
2	STANDARD PLANS SUMMARY	
3	GENERAL NOTES AND LEGEND	
4 - 6	TYPICAL SECTIONS & DETAILS	
7 – 22	ROADWAY PLANS	
23 – 26	SAFETY IMPROVEMENTS AT WAIAKOA, KULANIHAKOI, WAIPUILANI AND KEOKEA BRIDGES	
27	PAVEMENT MARKINGS LEGEND, DETAILS & NOTES	
28 – 43	SIGNING AND PAVEMENT MARKING PLAN	
44 – 45	SIGN PANEL LAYOUT & NOTES	
46 – 47	MISCELLANEOUS SUMMARIES	
48	SURVEY MONUMENTS SUMMARY	

STATE OF HAWAII

DEPARTMENT OF TRANSPORTATION


HIGHWAYS DIVISION HONOLULU, HAWAII "AS-BUILT"


PLANS FOR

PIILANI HIGHWAY RESURFACING

VICINITY OF KEALIA POND TO KILOHANA DRIVE FEDERAL-AID PROJECT NO. STP-031-1(8)

> DISTRICTS OF WAILUKU AND MAKAWAO **ISLAND OF MAUI**

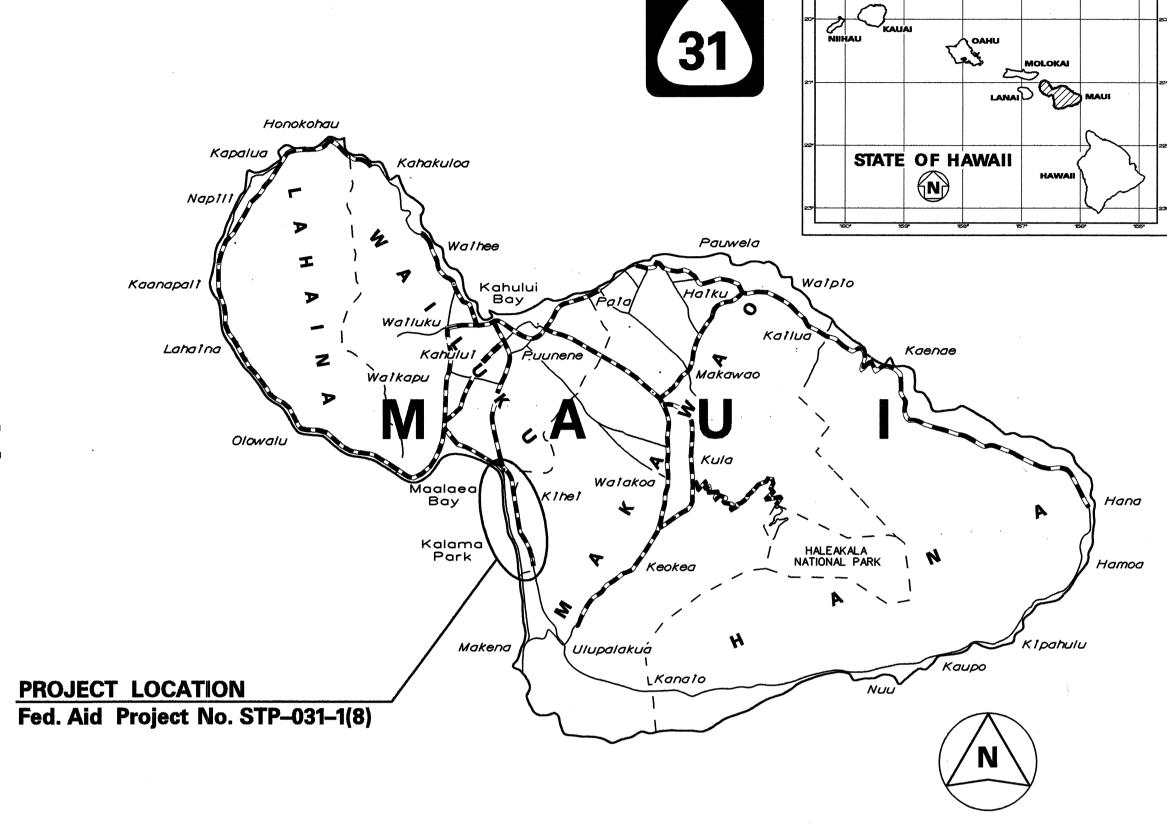

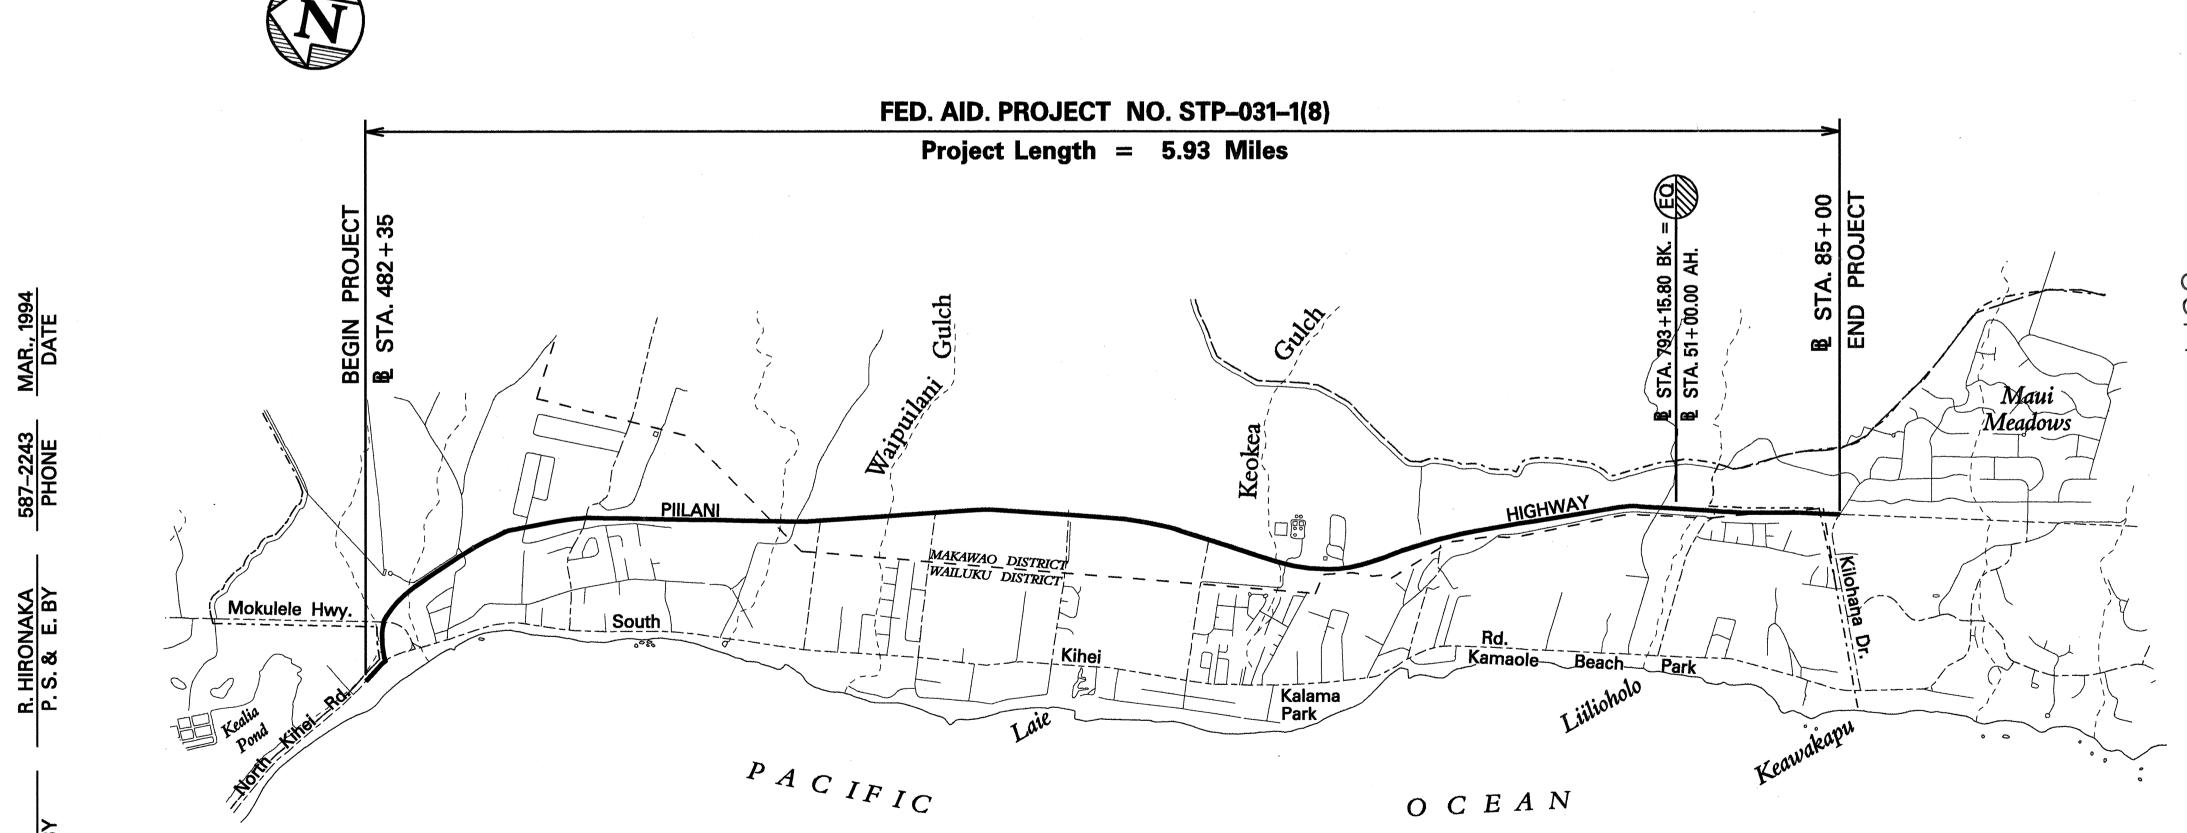

SCALE IN THOUSAND FEET

FEDERAL AID PROJECTS PREVIOUSLY CONSTRUCTED OR UNDER CONSTRUCTION

MILE POST <u>0.00</u> TO MILE POST <u>5.93</u>

CHANGES MADE DURING CONSTRUCTION HAVE BEEN INCORPORATED ON THESE PLANS EXCEPT CHANGES IN THE ORIGINAL THEORETICAL QUANTITIES. FOR ACTUAL QUANTITIES, REFER TO PROJECT LEDGER AND/OR COMPUTATION BOOK.

3/25/99 DATE FOR RESIDENT ENGINEER

DESIGN DESIGNATION

ADT (1994)	24,600
ADT (2004)	37,900
DHV	4,600
D (Design)	60/40
T (Design)	. 5.5 %
T ₂₄	7.5 %
v	50 M P I

v 50 M.P.H.

LAYOUT PLAN

GROSS LENGTH OF PROJECT.....5.93 MILES NET LENGTH OF PROJECT..... 5.93 MILES

DEPARTMENT OF TRANSPORTATION FEDERAL HIGHWAY ADMINISTRATION **APPROVED:** 6/2/94 DATE

For DIVISION ADMINISTRATOR

DEPARTMENT OF TRANSPORTATION STATE OF HAWAII		
APPROVED:		
+ Harans	5/24/9	
DIR. OF TRANSPORTATION	DATE	