

INDEX TO DRAWINGS	
SHEET NO.	DESCRIPTION
1	TITLE SHEET
2	STANDARD PLANS SUMMARY
3	GENERAL NOTES & LEGEND
4 - 6	WATER POLLUTION & EROSION CONTROL NOTES
7 - 15	GUARDRAIL DETAILS & NOTES
16	RUMBLE STRIP DETAILS & NOTES
17	WORK ZONE SIGNING PLAN, NOTES & DETAILS
18	PAVEMENT MARKING LEGEND, DETAILS & NOTES
19 - 38	SIGNING & PAVEMENT MARKING PLANS
39	SIGNAL HEAD SCHEDULE AND STREET NAME SIGN SUMMARY

STATE OF HAWAII

DEPARTMENT OF TRANSPORTATION

HIGHWAYS DIVISION

HONOLULU, HAWAII

"AS-BUILT"

PLANS FOR

PIILANI HIGHWAY SAFETY IMPROVEMENTS





NORTH KIHAI ROAD TO THE VICINITY OF WALEA IKE DR.

FEDERAL-AID PROJECT NO. HSIP-031-1(013)

DISTRICTS OF WAILUKU AND MAKAWAO

ISLAND OF MAUI


FED. ROAD DIST. NO.	STATE	FED. AID PROJ. NO.	FISCAL YEAR	SHEET NO.	TOTAL SHEETS
HAWAII	HAW.	HSIP-031-1(013)	2019	1	39

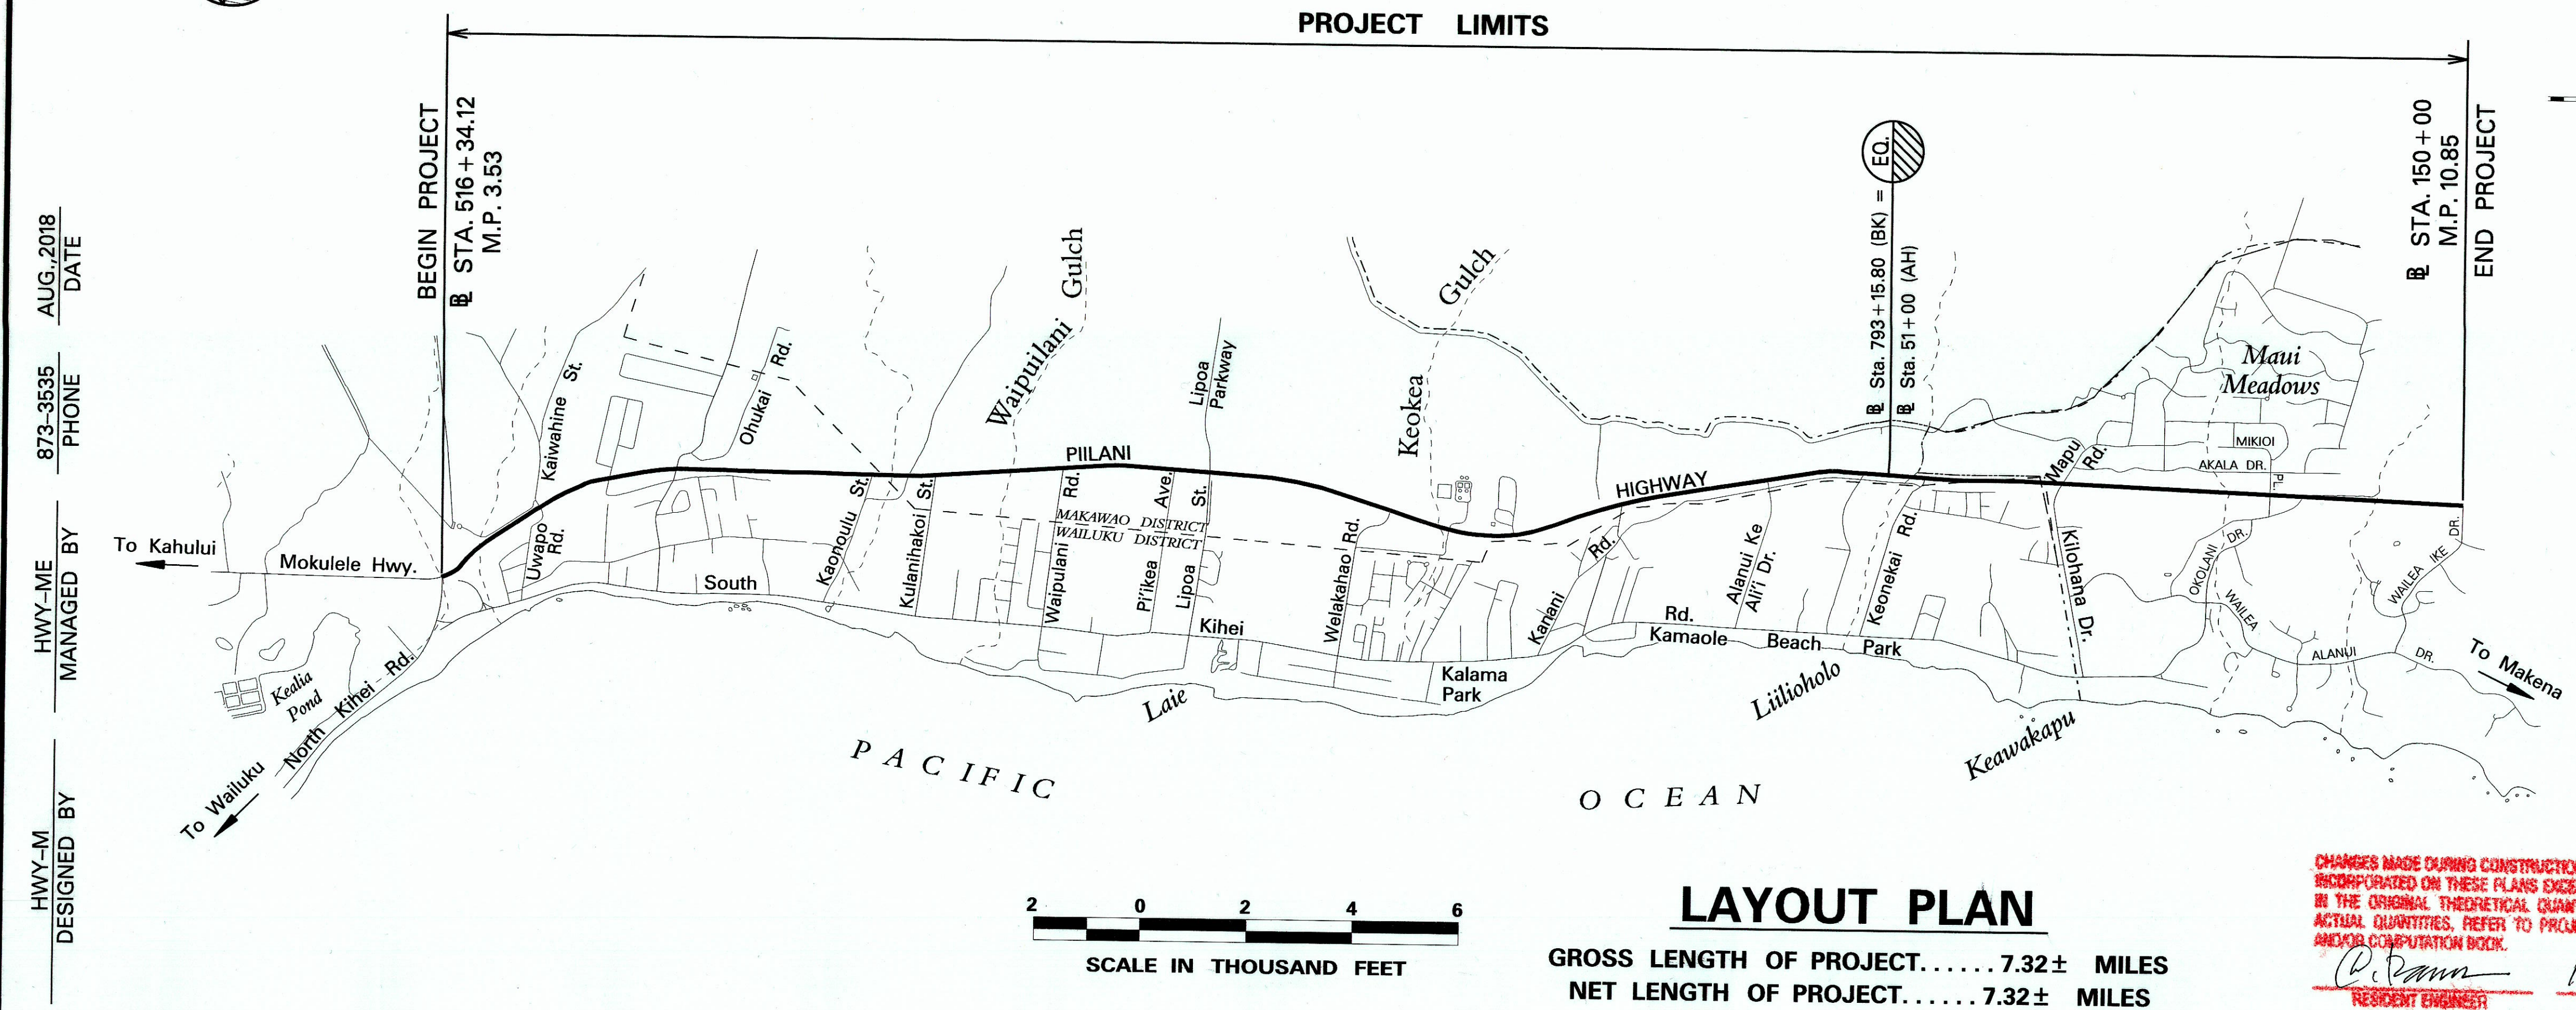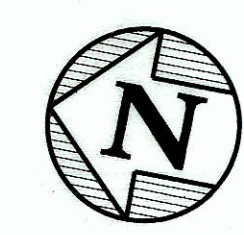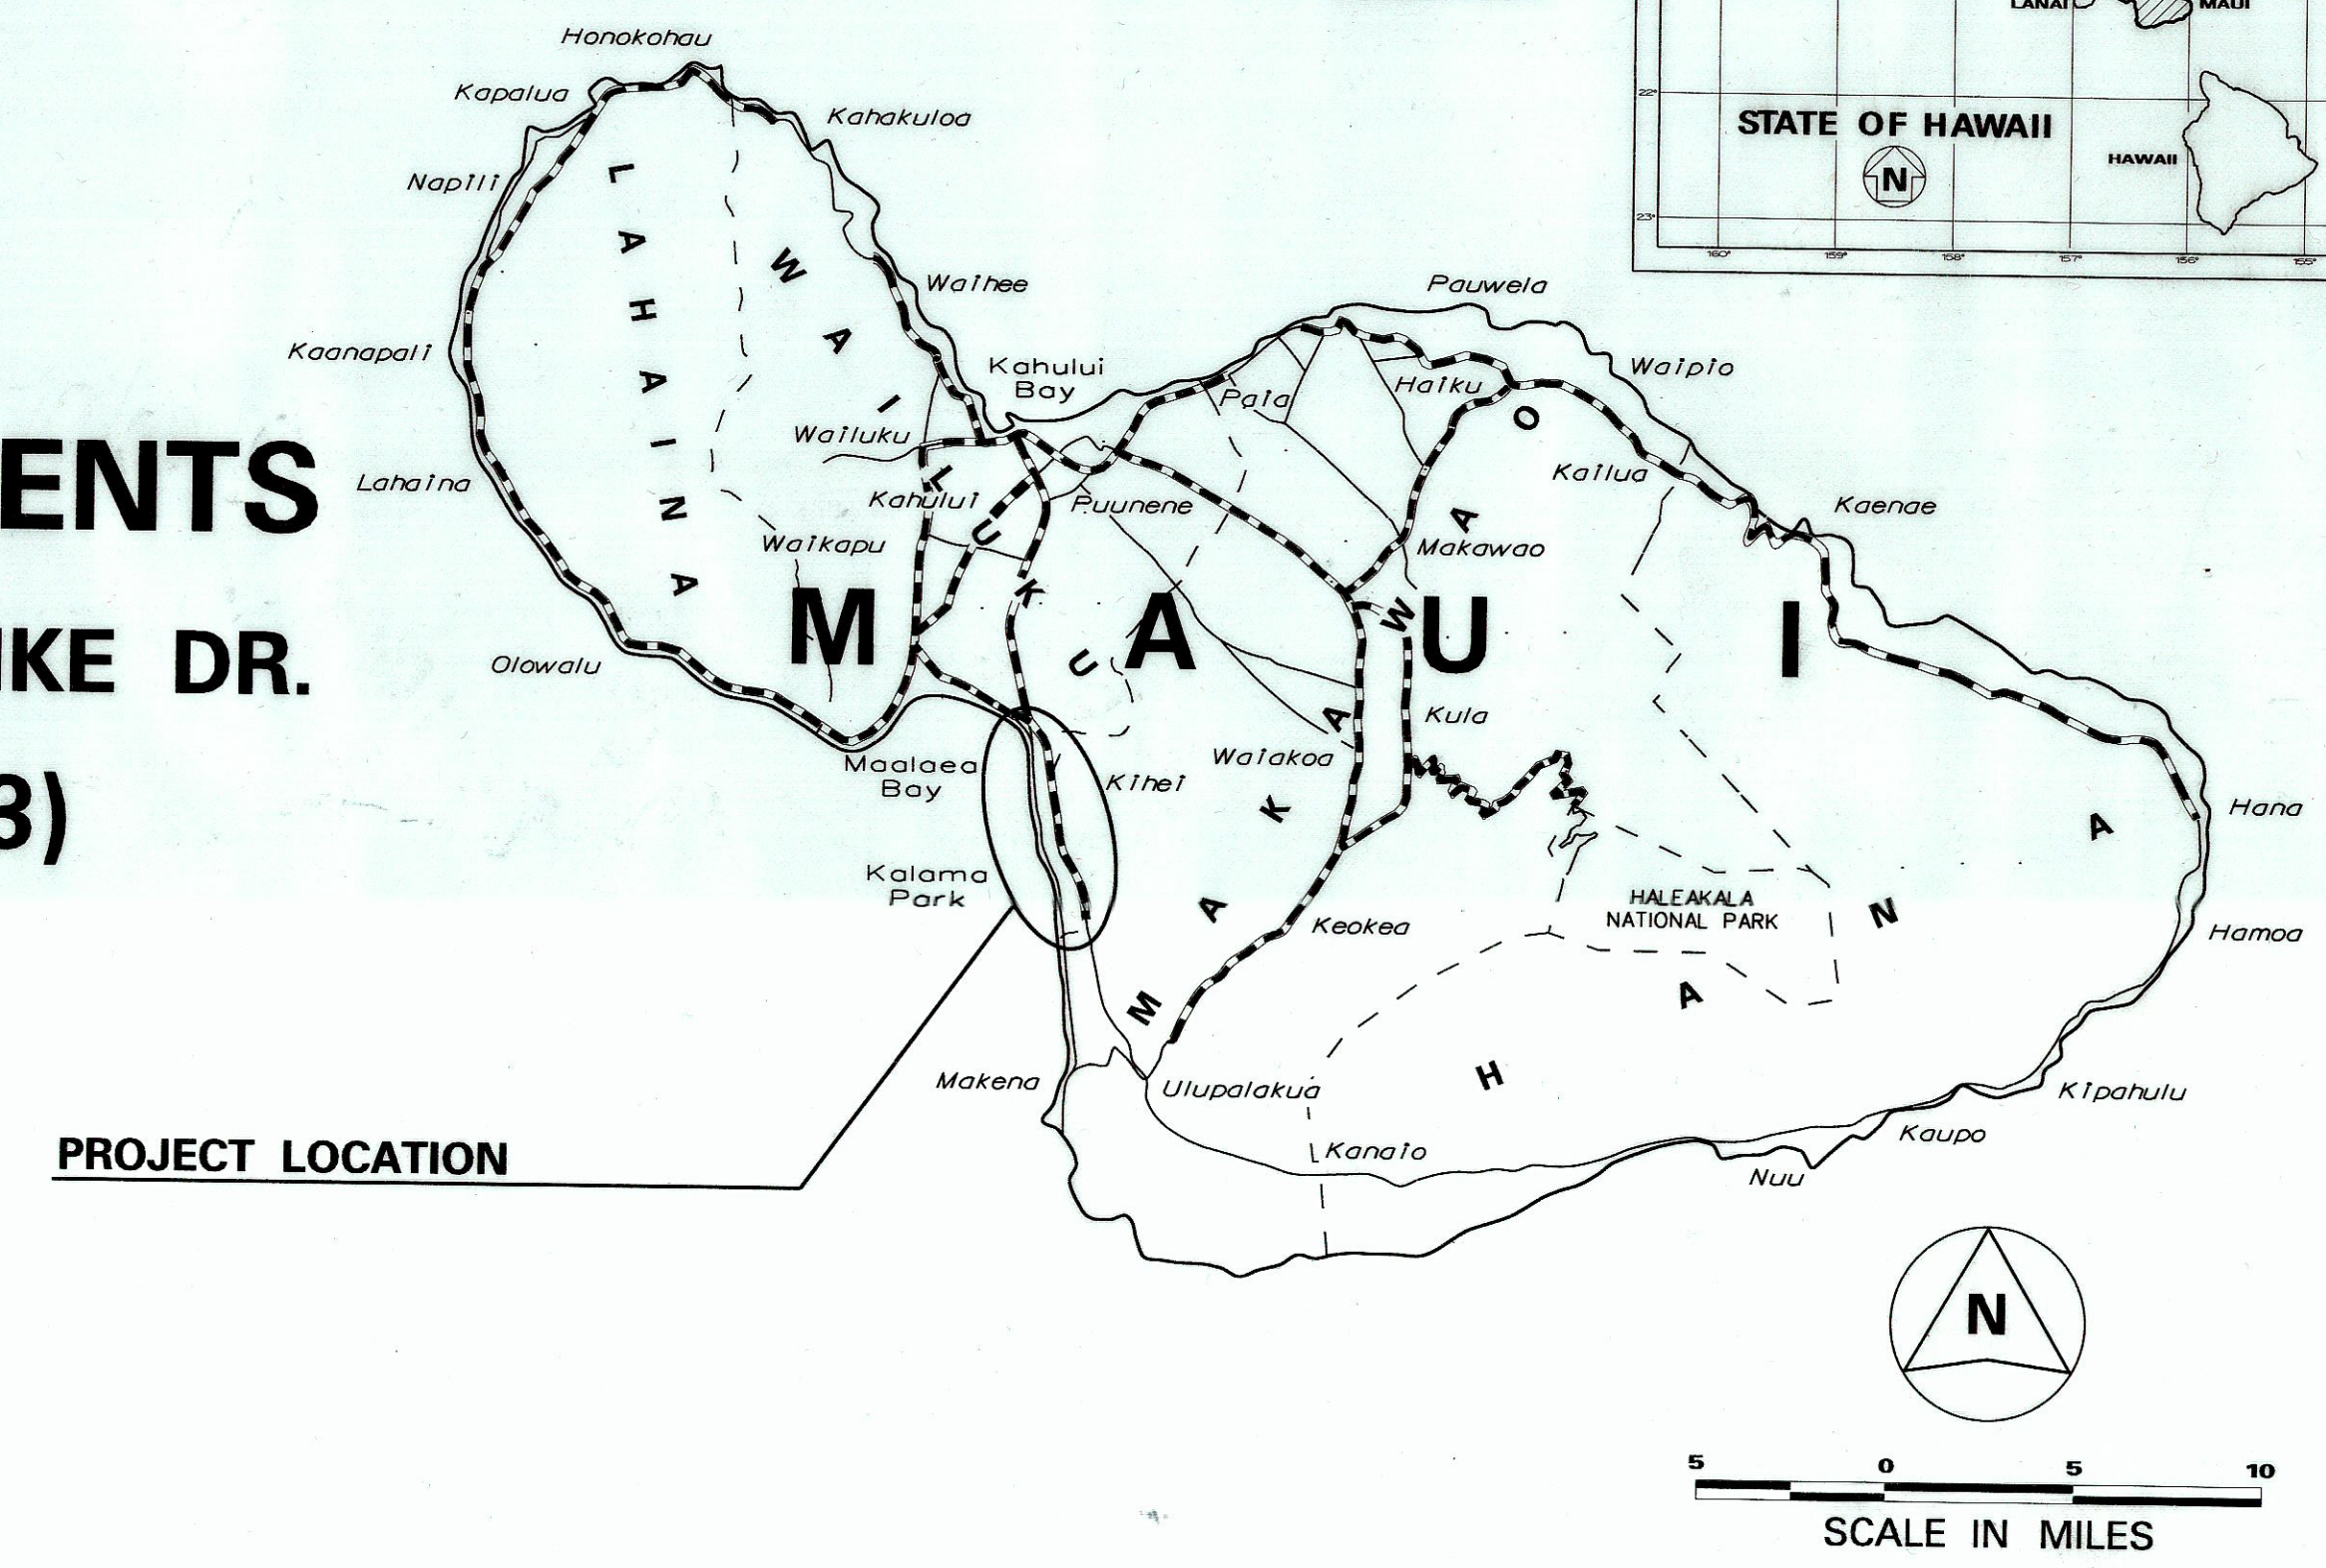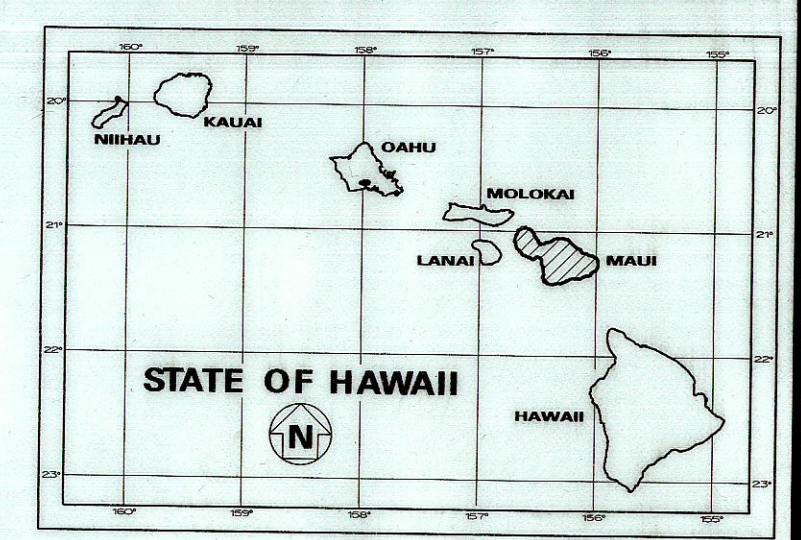

----- FEDERAL AID PROJECTS PREVIOUSLY CONSTRUCTED OR UNDER CONSTRUCTION

MILE POST 3.53 TO MILE POST 10.85

DESIGN DESIGNATION		
PIILANI HIGHWAY		
TRAFFIC DATA	MOKULELE HWY. TO KILOHANA DR. Route 31 (MP 0.00 to 5.93)	KILOHANA DR. TO WALEA IKE DR. Route 31 (MP 5.93 to 7.15)
ADT (2018)	42,900	17,400
ADT (2028)	53,100	21,500
DHV	4,510	1,830
DESIGN K	8.5	8.5
DESIGN D	55/45	60/40
DESIGN T	3.5	3.5
T24	4.0	4.0

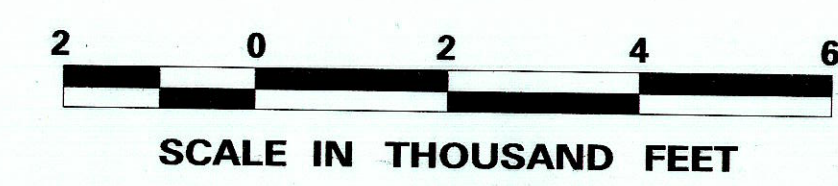

LAYOUT PLAN

GROSS LENGTH OF PROJECT.....7.32± MILES

NET LENGTH OF PROJECT.....7.32± MILES

CHANGES MADE DURING CONSTRUCTION HAVE BEEN INCORPORATED ON THESE PLANS EXCEPT CHANGES IN THE ORIGINAL THEORETICAL QUANTITIES. FOR ACTUAL QUANTITIES, REFER TO PROJECT LEADER AND/OR COMPUTATION BOOK.

[Signature] 10/28/22
RESIDENT ENGINEER DATE

DEPARTMENT OF TRANSPORTATION
STATE OF HAWAII

APPROVED: *[Signature]* 6/28/19
DIR. OF TRANSPORTATION DATE