

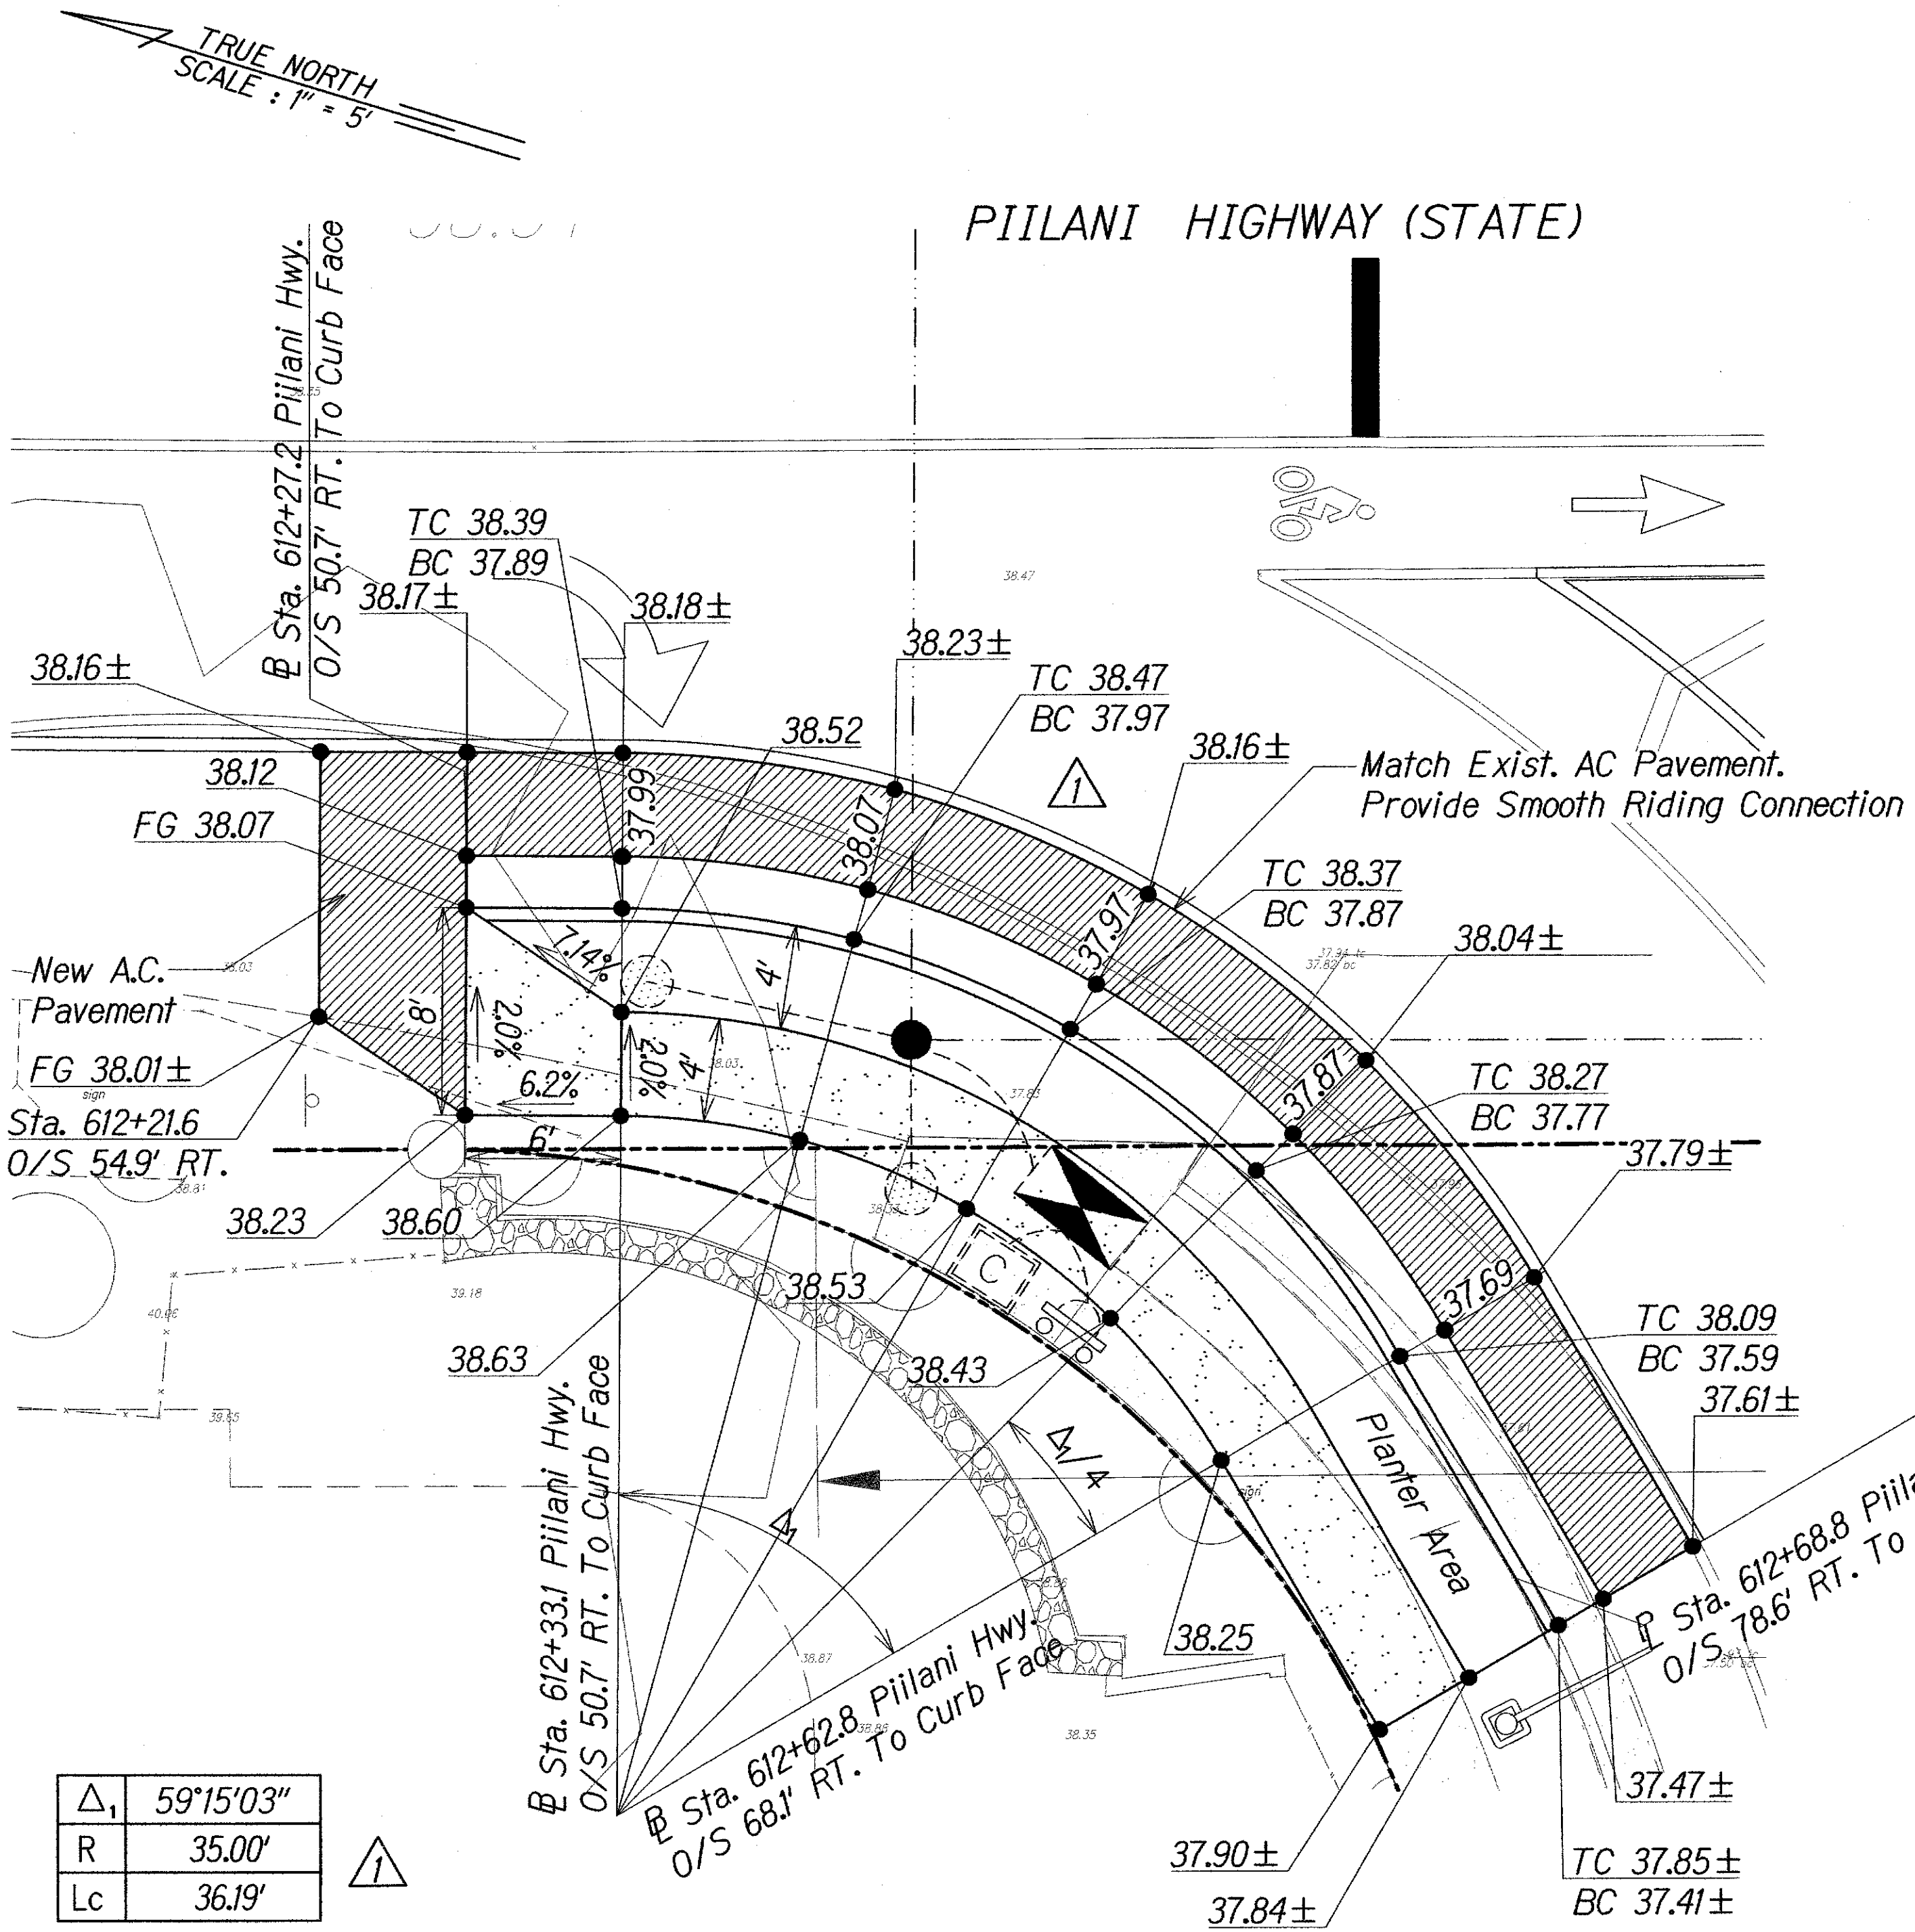


FED. ROAD DIST. NO.	STATE	PROJ. NO.	FISCAL YEAR	SHEET NO.	TOTAL SHEETS
HAWAII	HAW.	31A-02-17	2018	15	29

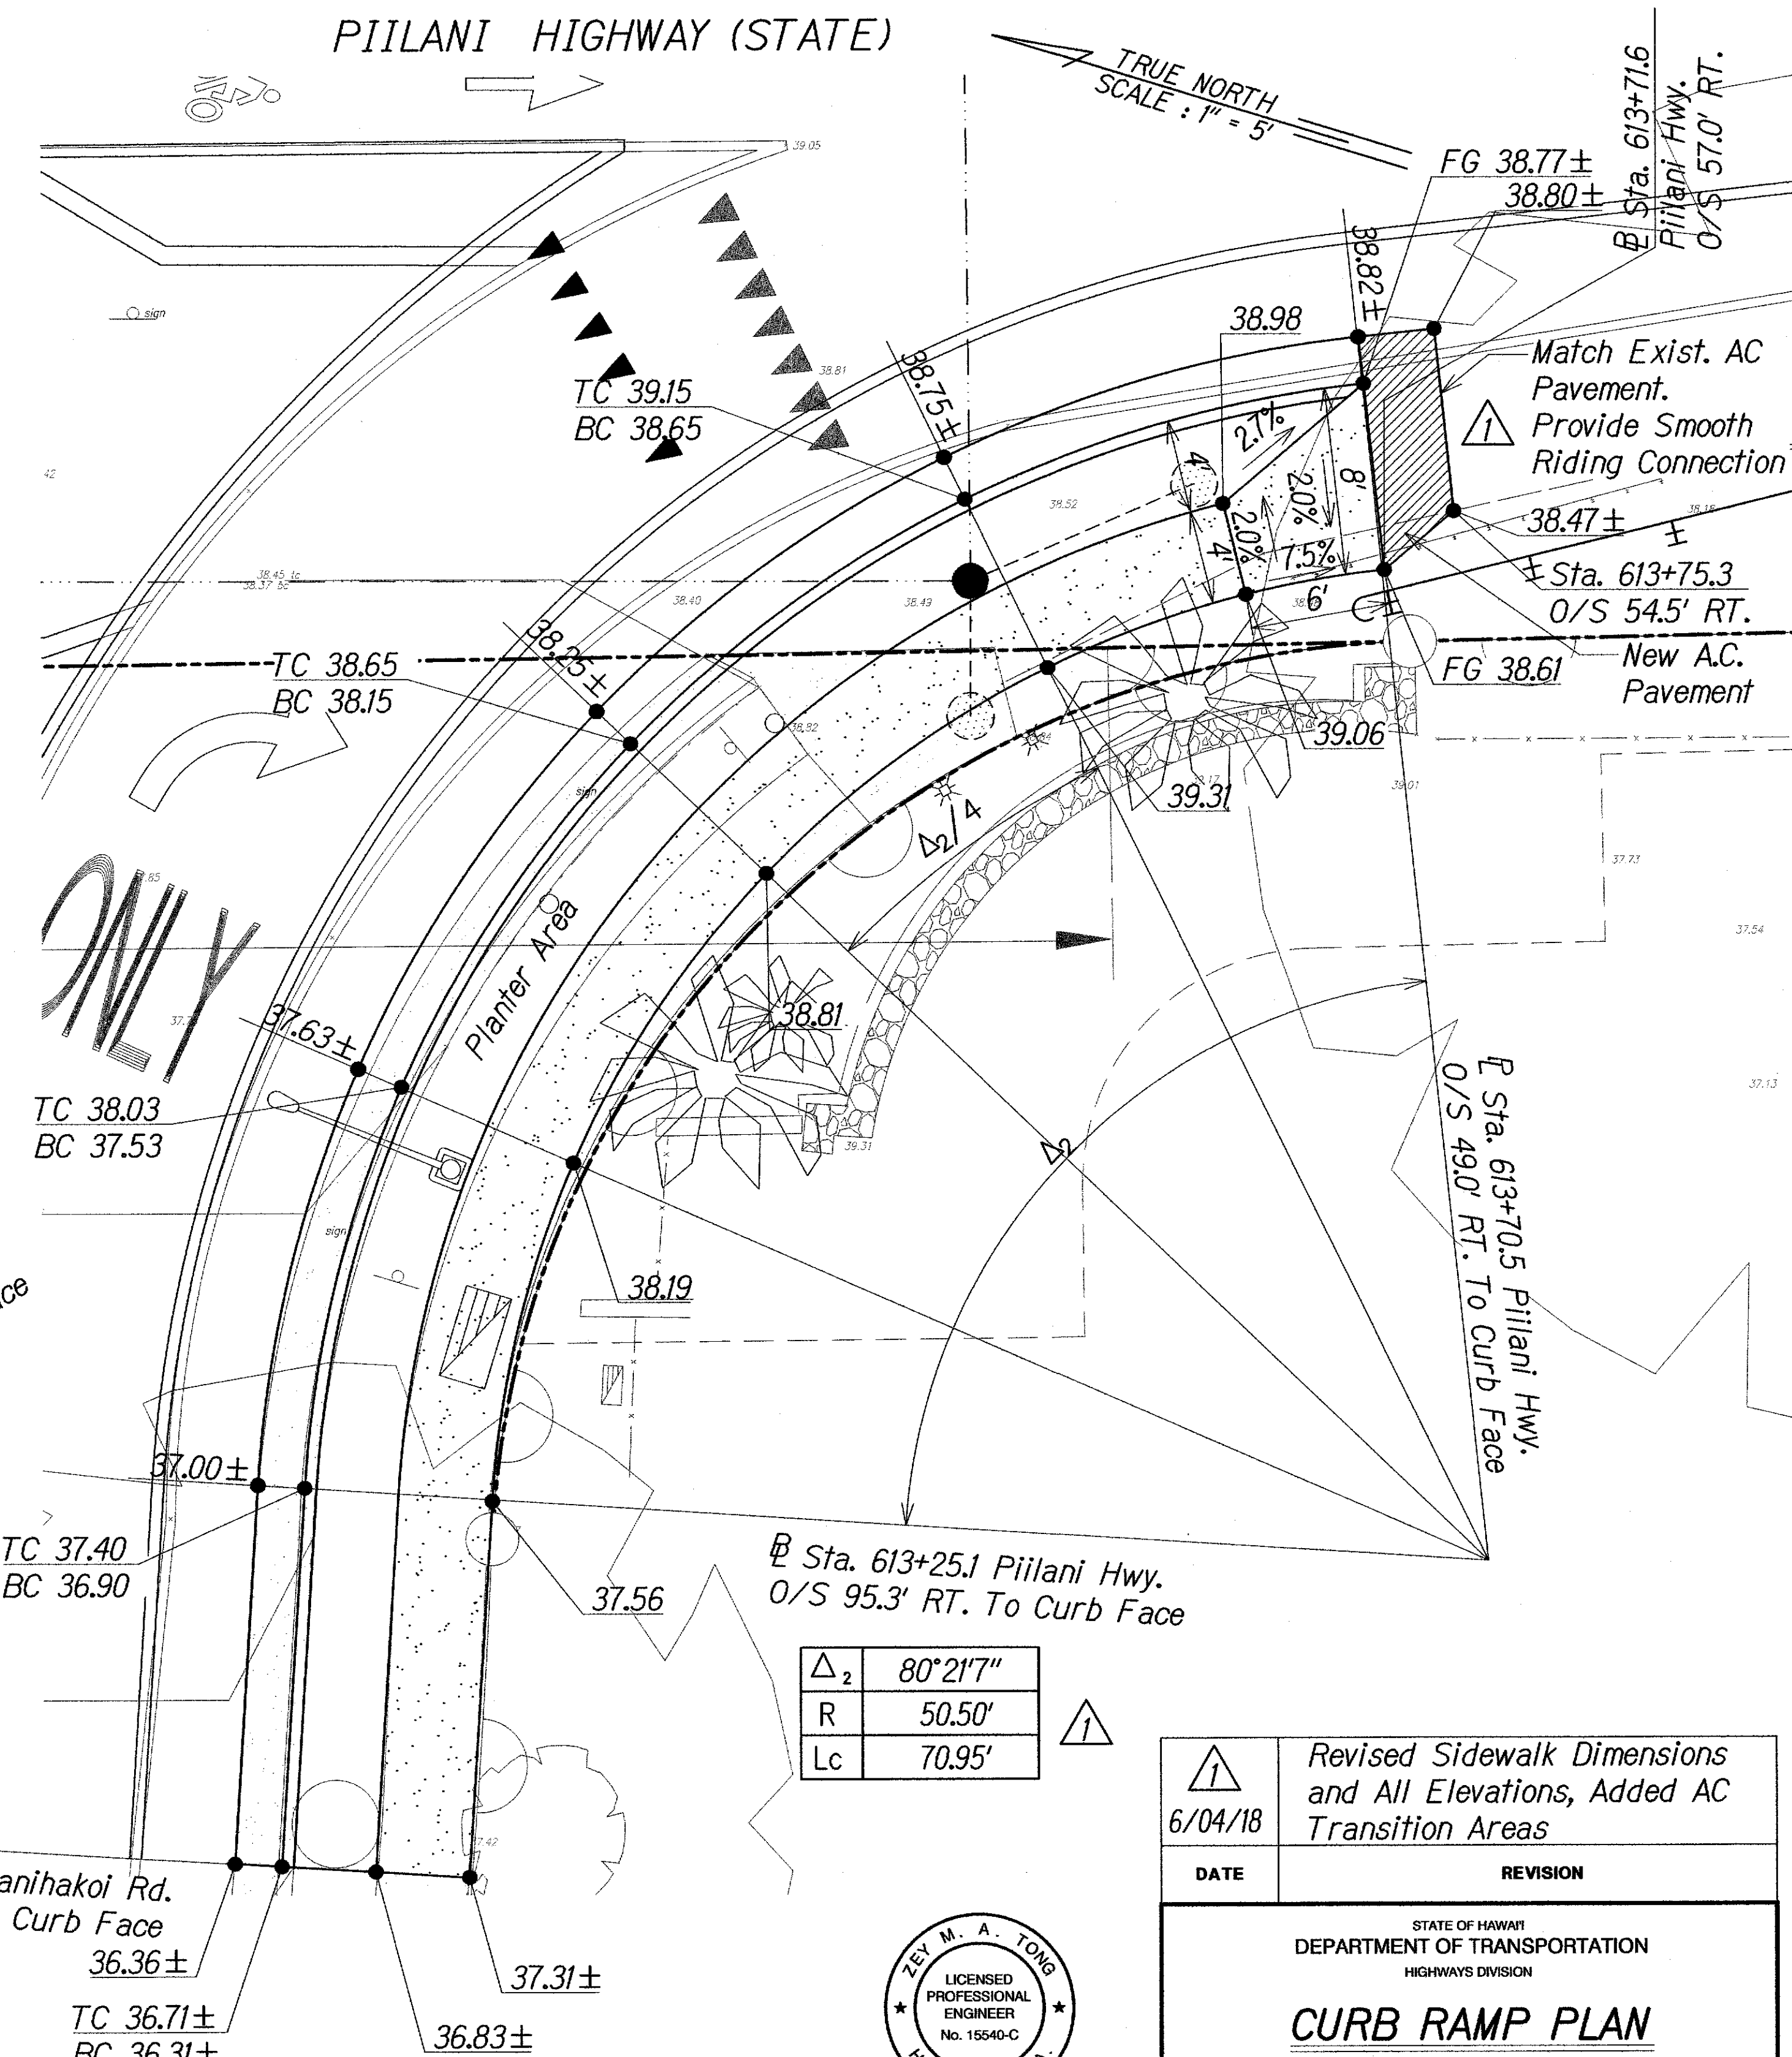

△ CURB RAMP 1
Scale: 1" = 5'

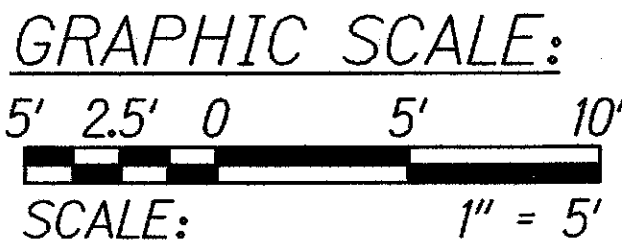

△ CURB RAMP 2
Scale: 1" = 5'



THIS WORK WAS PREPARED BY
ME OR UNDER MY SUPERVISION.
Zey Tong
APRIL 30, 2020
LIC. EXP. DATE

△ 6/04/18	Revised Sidewalk Dimensions and All Elevations, Added AC Transition Areas
DATE	REVISION
STATE OF HAWAII DEPARTMENT OF TRANSPORTATION HIGHWAYS DIVISION CURB RAMP PLAN <i>Piilani Highway Improvements</i> <i>Vicinity of Kulanihakai Street</i> <i>Project No. 31A-02-17</i> Scale: As Shown Date: Mar 2018	
SHEET No. C-14 OF 24 SHEETS	