


FED. ROAD DIST. NO.	STATE	PROJ. NO.	FISCAL YEAR	SHEET NO.	TOTAL SHEETS
HAWAII	HAW.	31A-02-17	2018	17	29

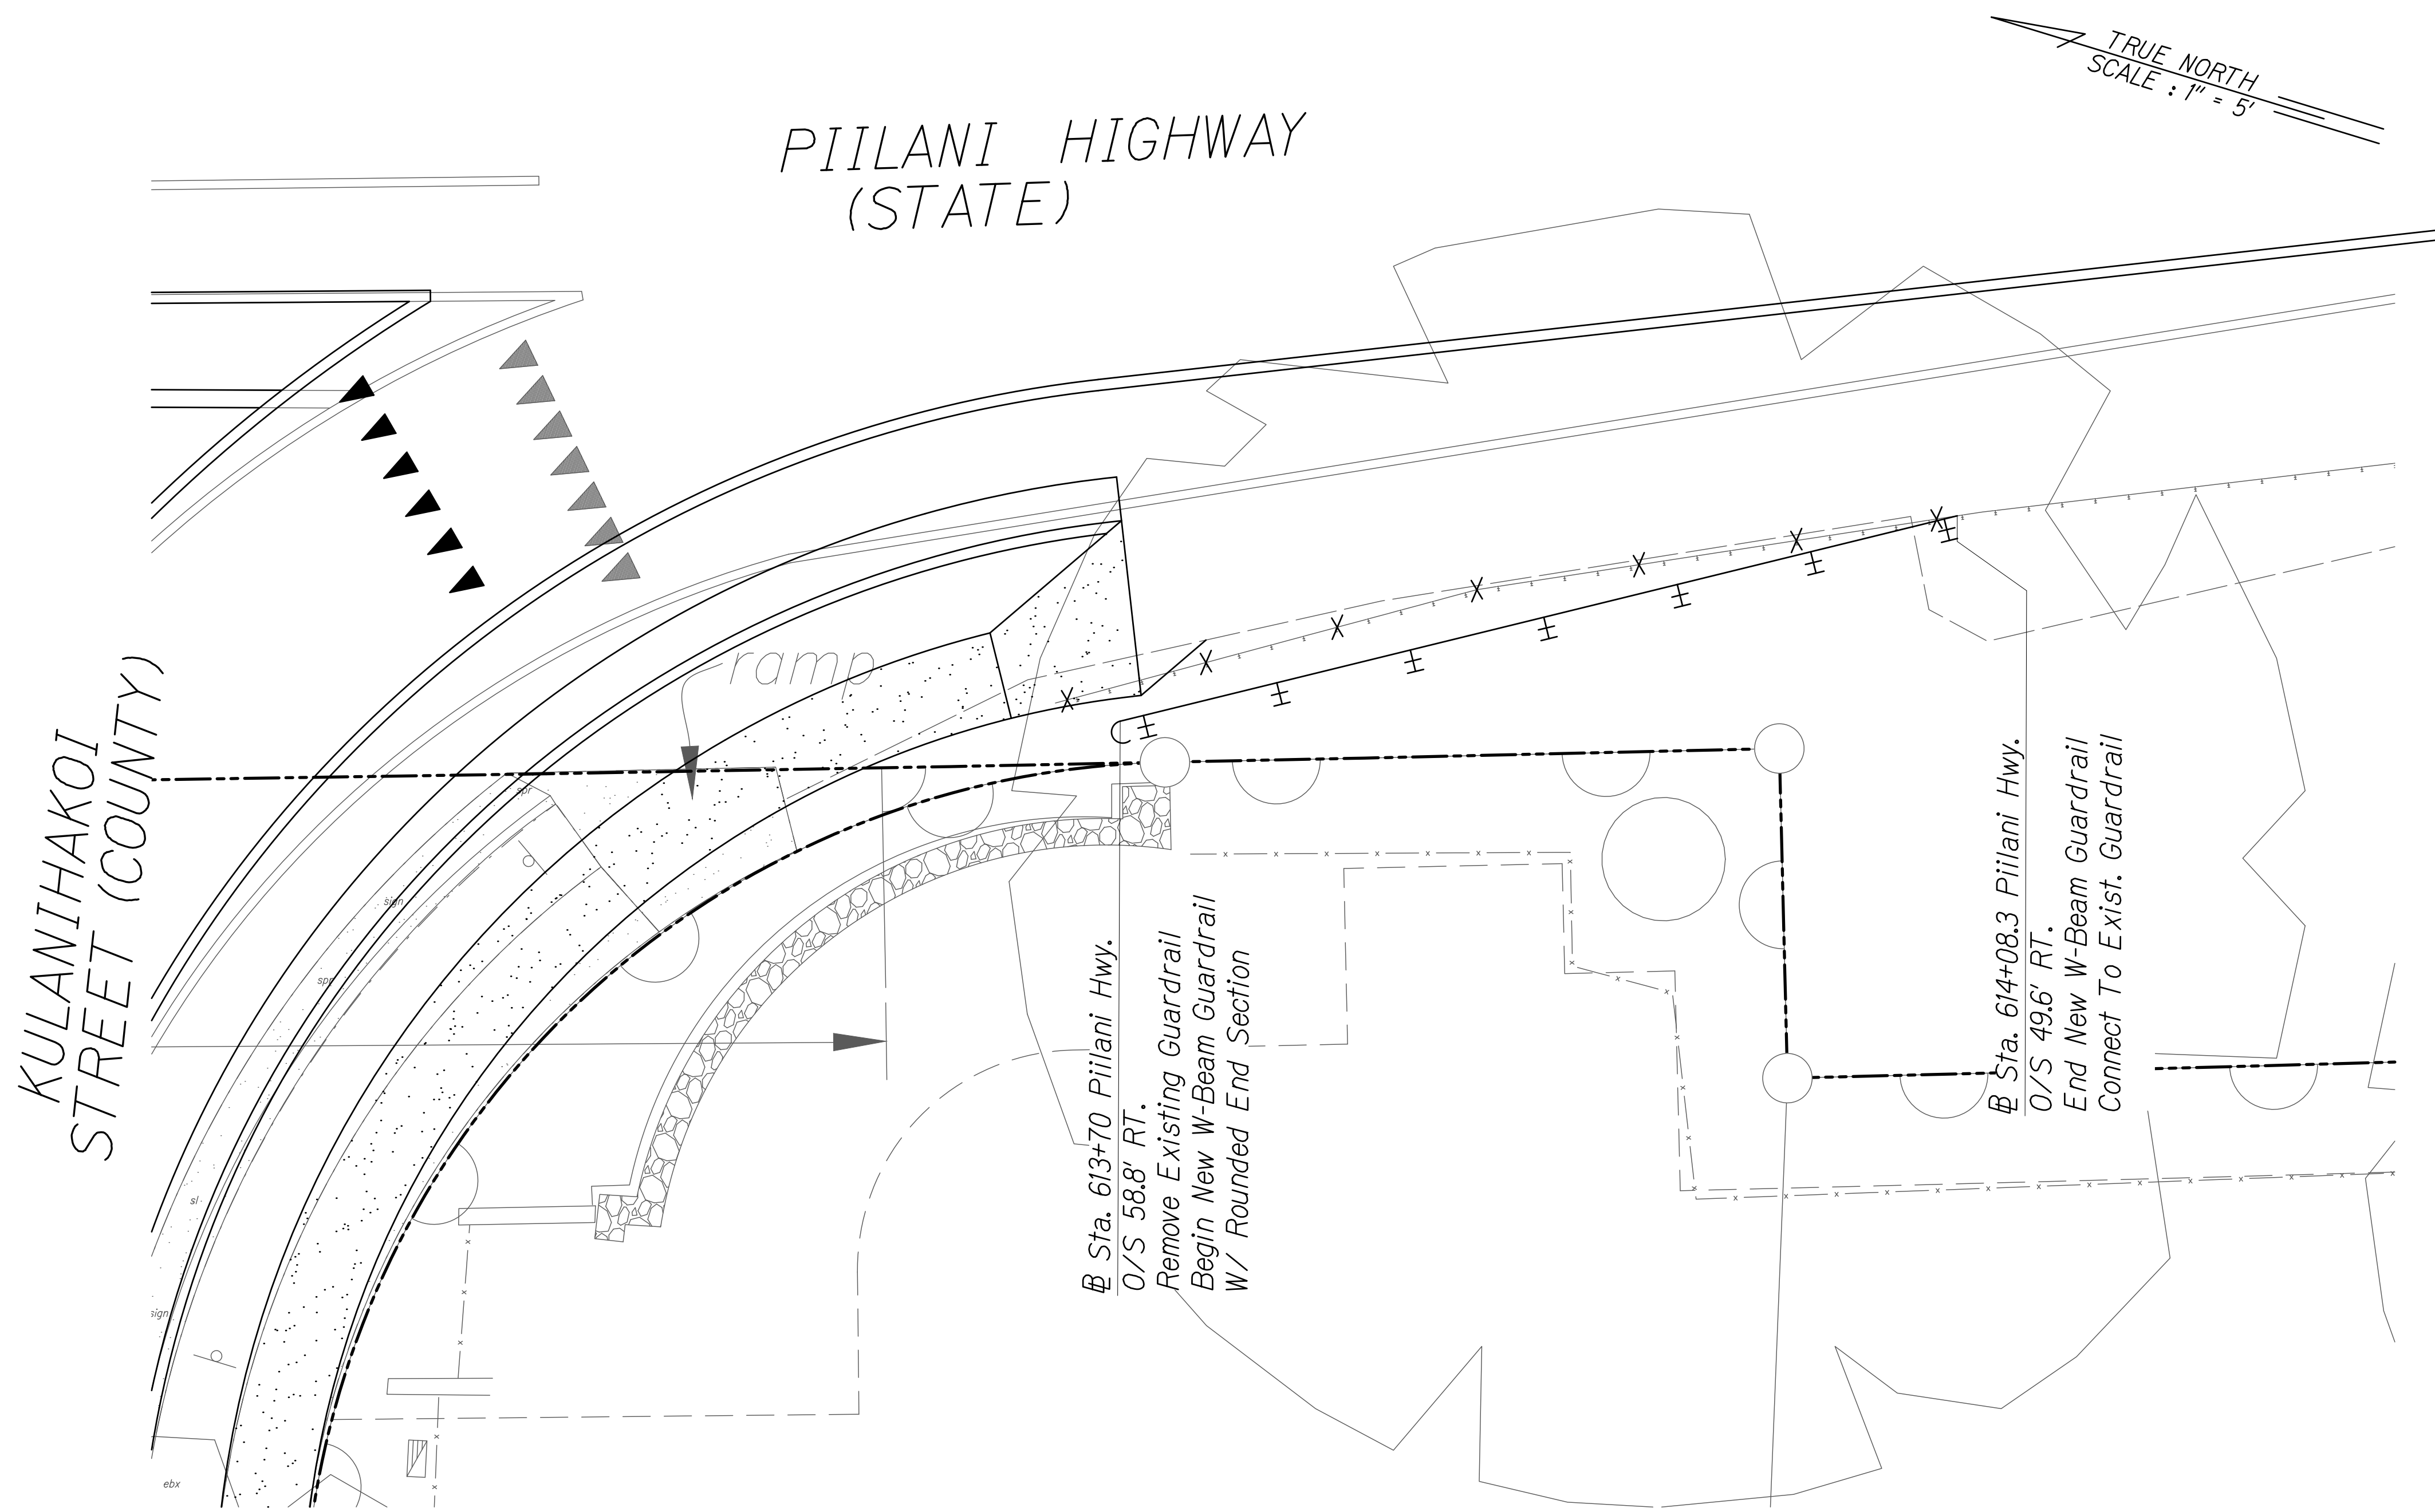


NOTE:
For Guardrail Details, See Sheet C-17 and C-18.

ORIGINAL PLAN	SURVEY PLOTTED BY	DATE
NOTE BOOK	DESIGNED BY	
	QUANTITIES BY	
	CHECKED BY	

GRAPHIC SCALE:
5' 2.5' 0 5' 10'
SCALE: 1" = 5'

GUARDRAIL PLAN
Scale : 1" = 5'

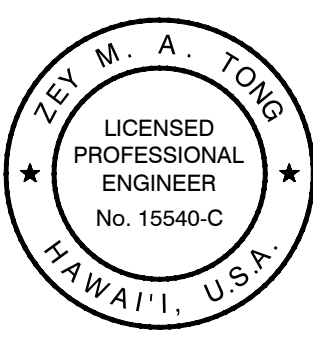

THIS WORK WAS PREPARED BY ME, OR UNDER MY SUPERVISION.
Zey Tong
APRIL 30, 2020
LIC. EXP. DATE

STATE OF HAWAII
DEPARTMENT OF TRANSPORTATION
HIGHWAYS DIVISION

GUARDRAIL PLAN

Piilani Highway Improvements
Vicinity of Kulanihako Street
Project No. 31A-02-17

Scale: As Shown Date: Mar 2018

SHEET No. C-16 OF 24 SHEETS