

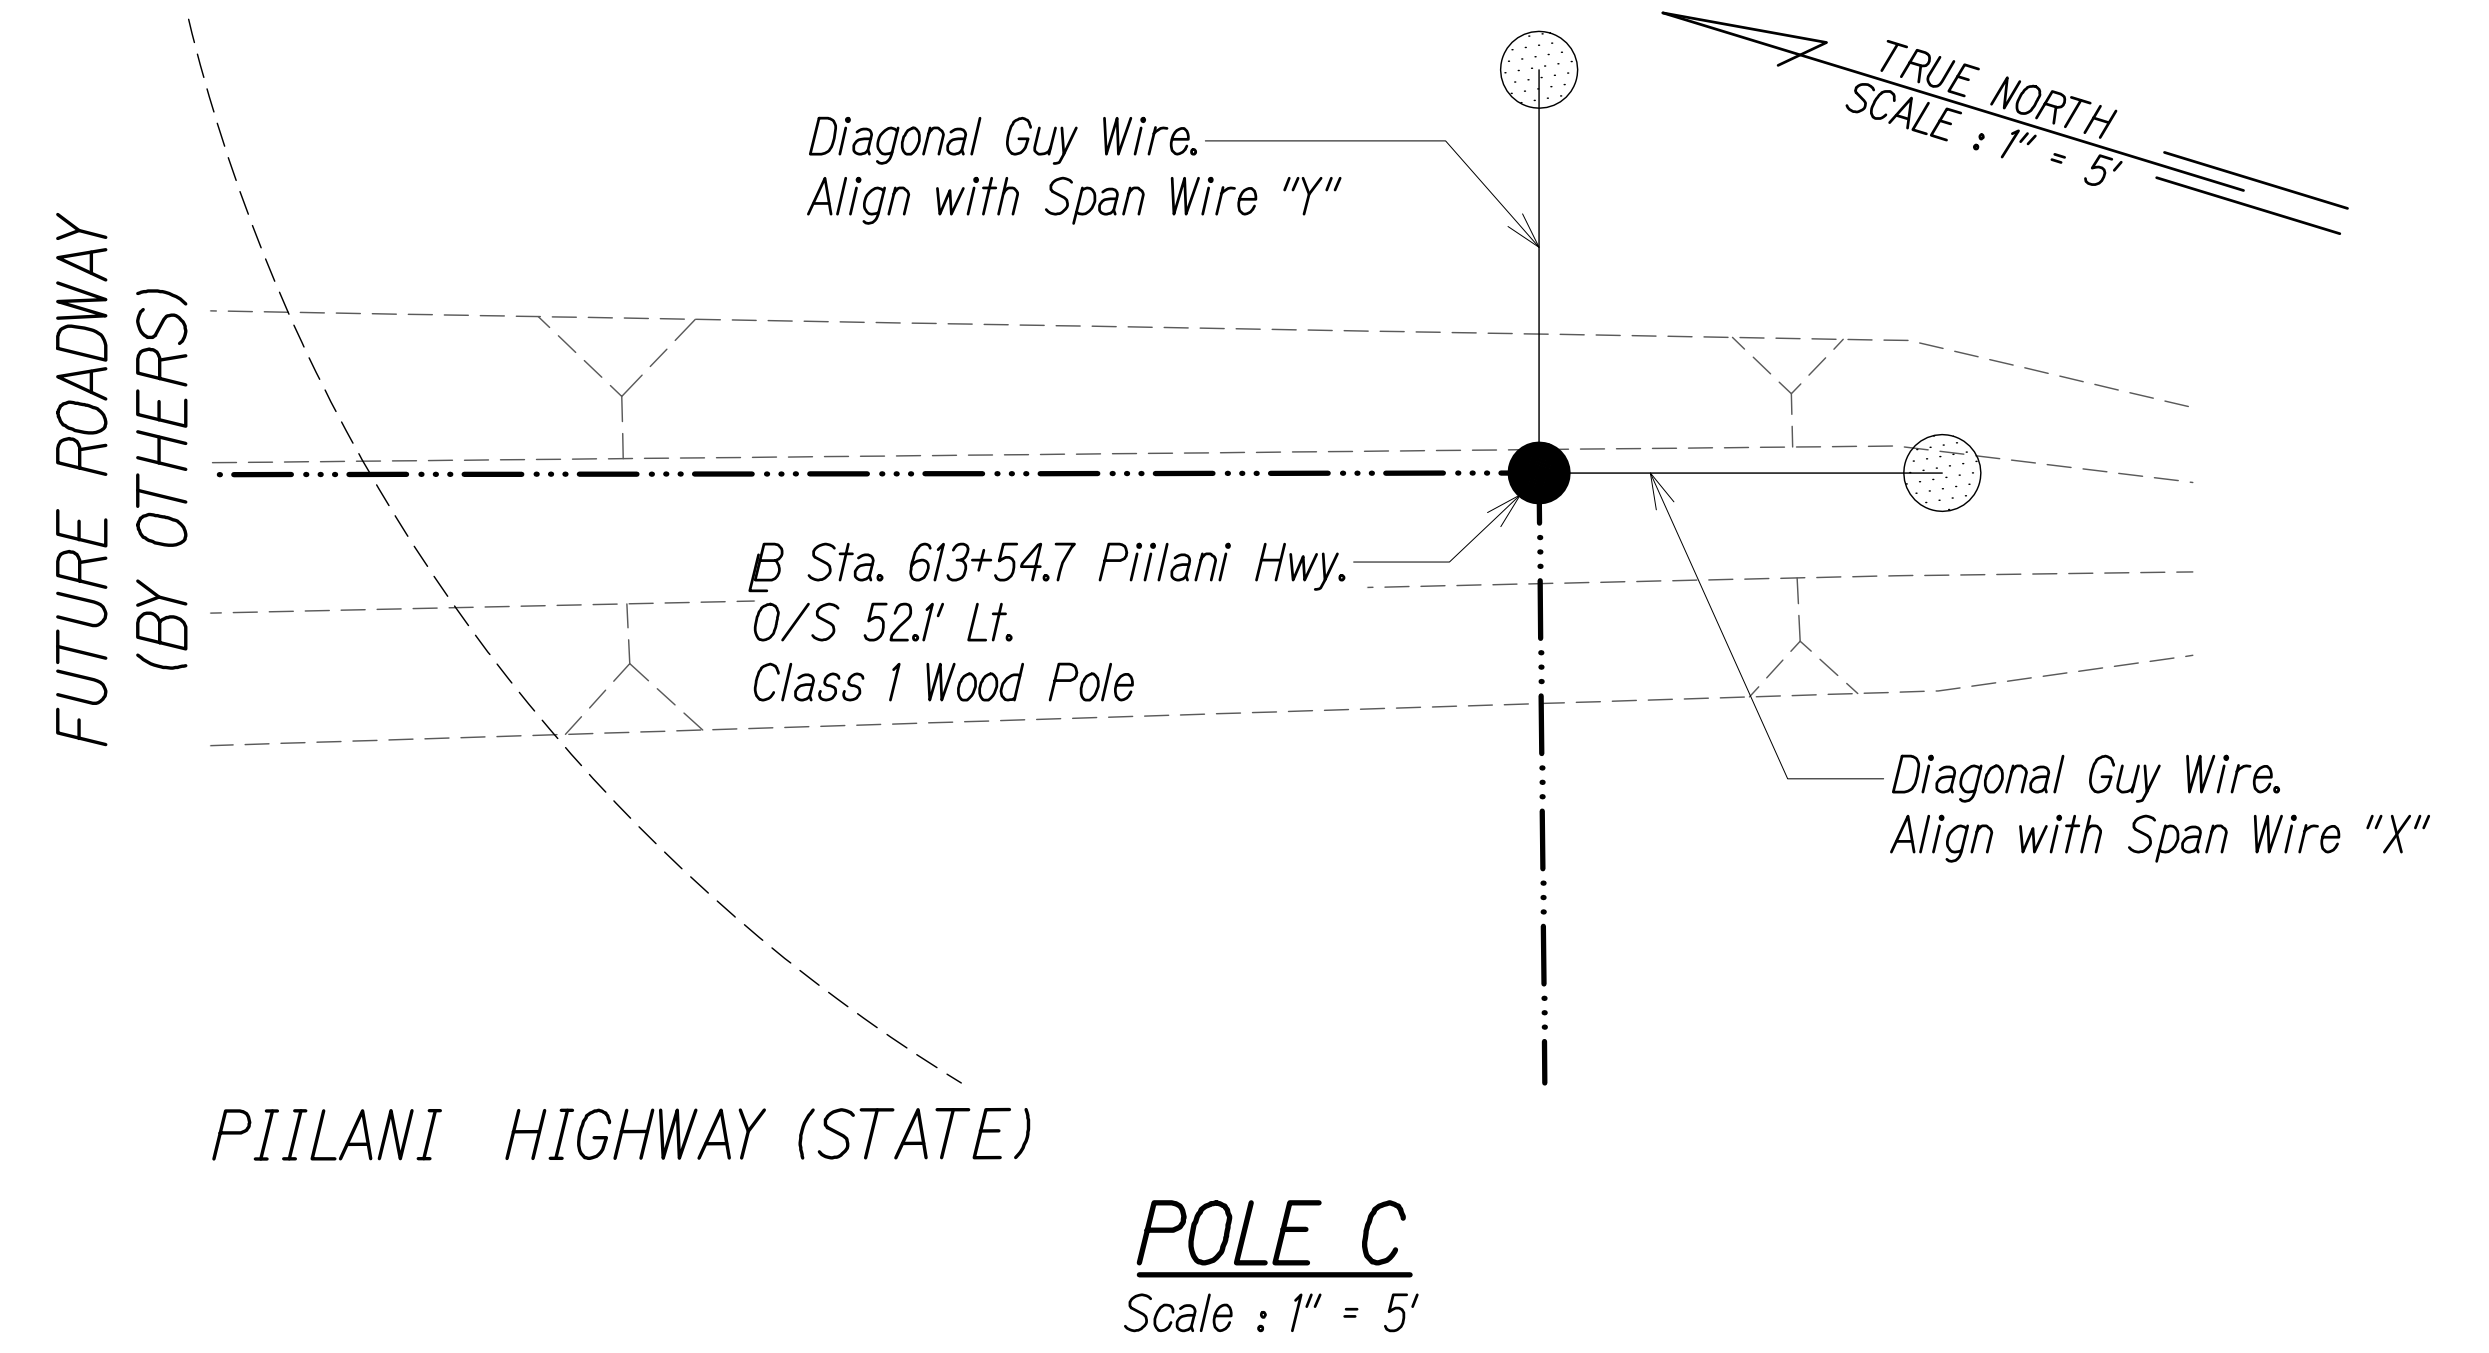
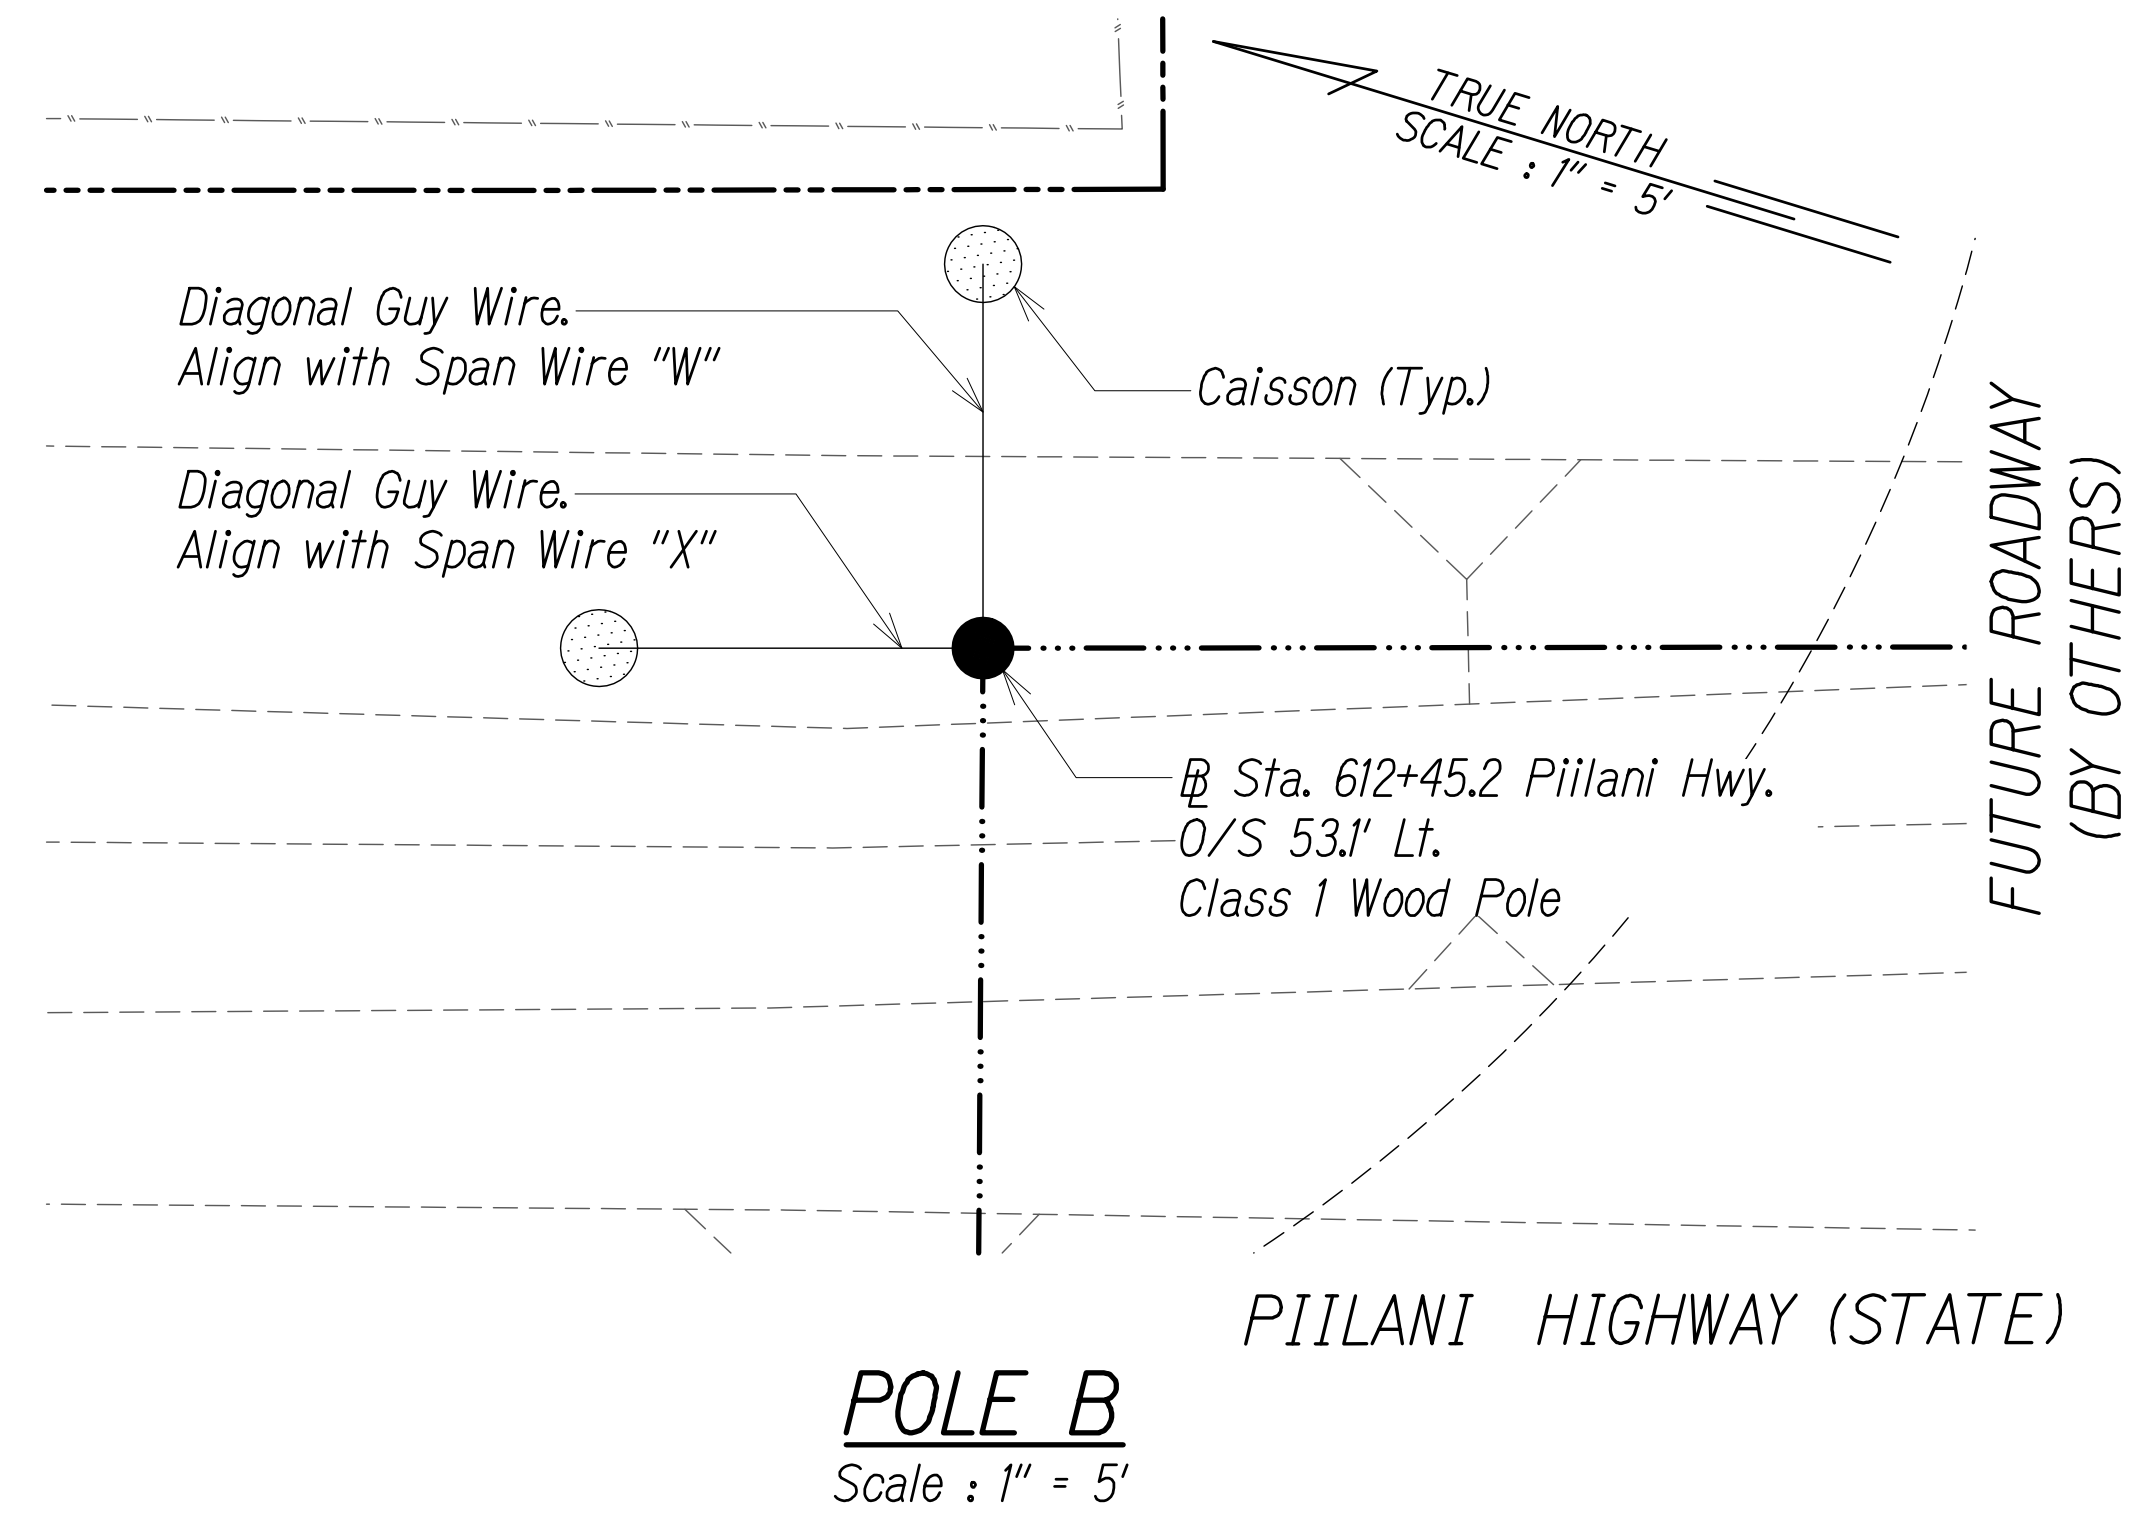


FED. ROAD DIST. NO.	STATE	PROJ. NO.	FISCAL YEAR	SHEET NO.	TOTAL SHEETS
HAWAII	HAW.	31A-02-17	2018	22	29

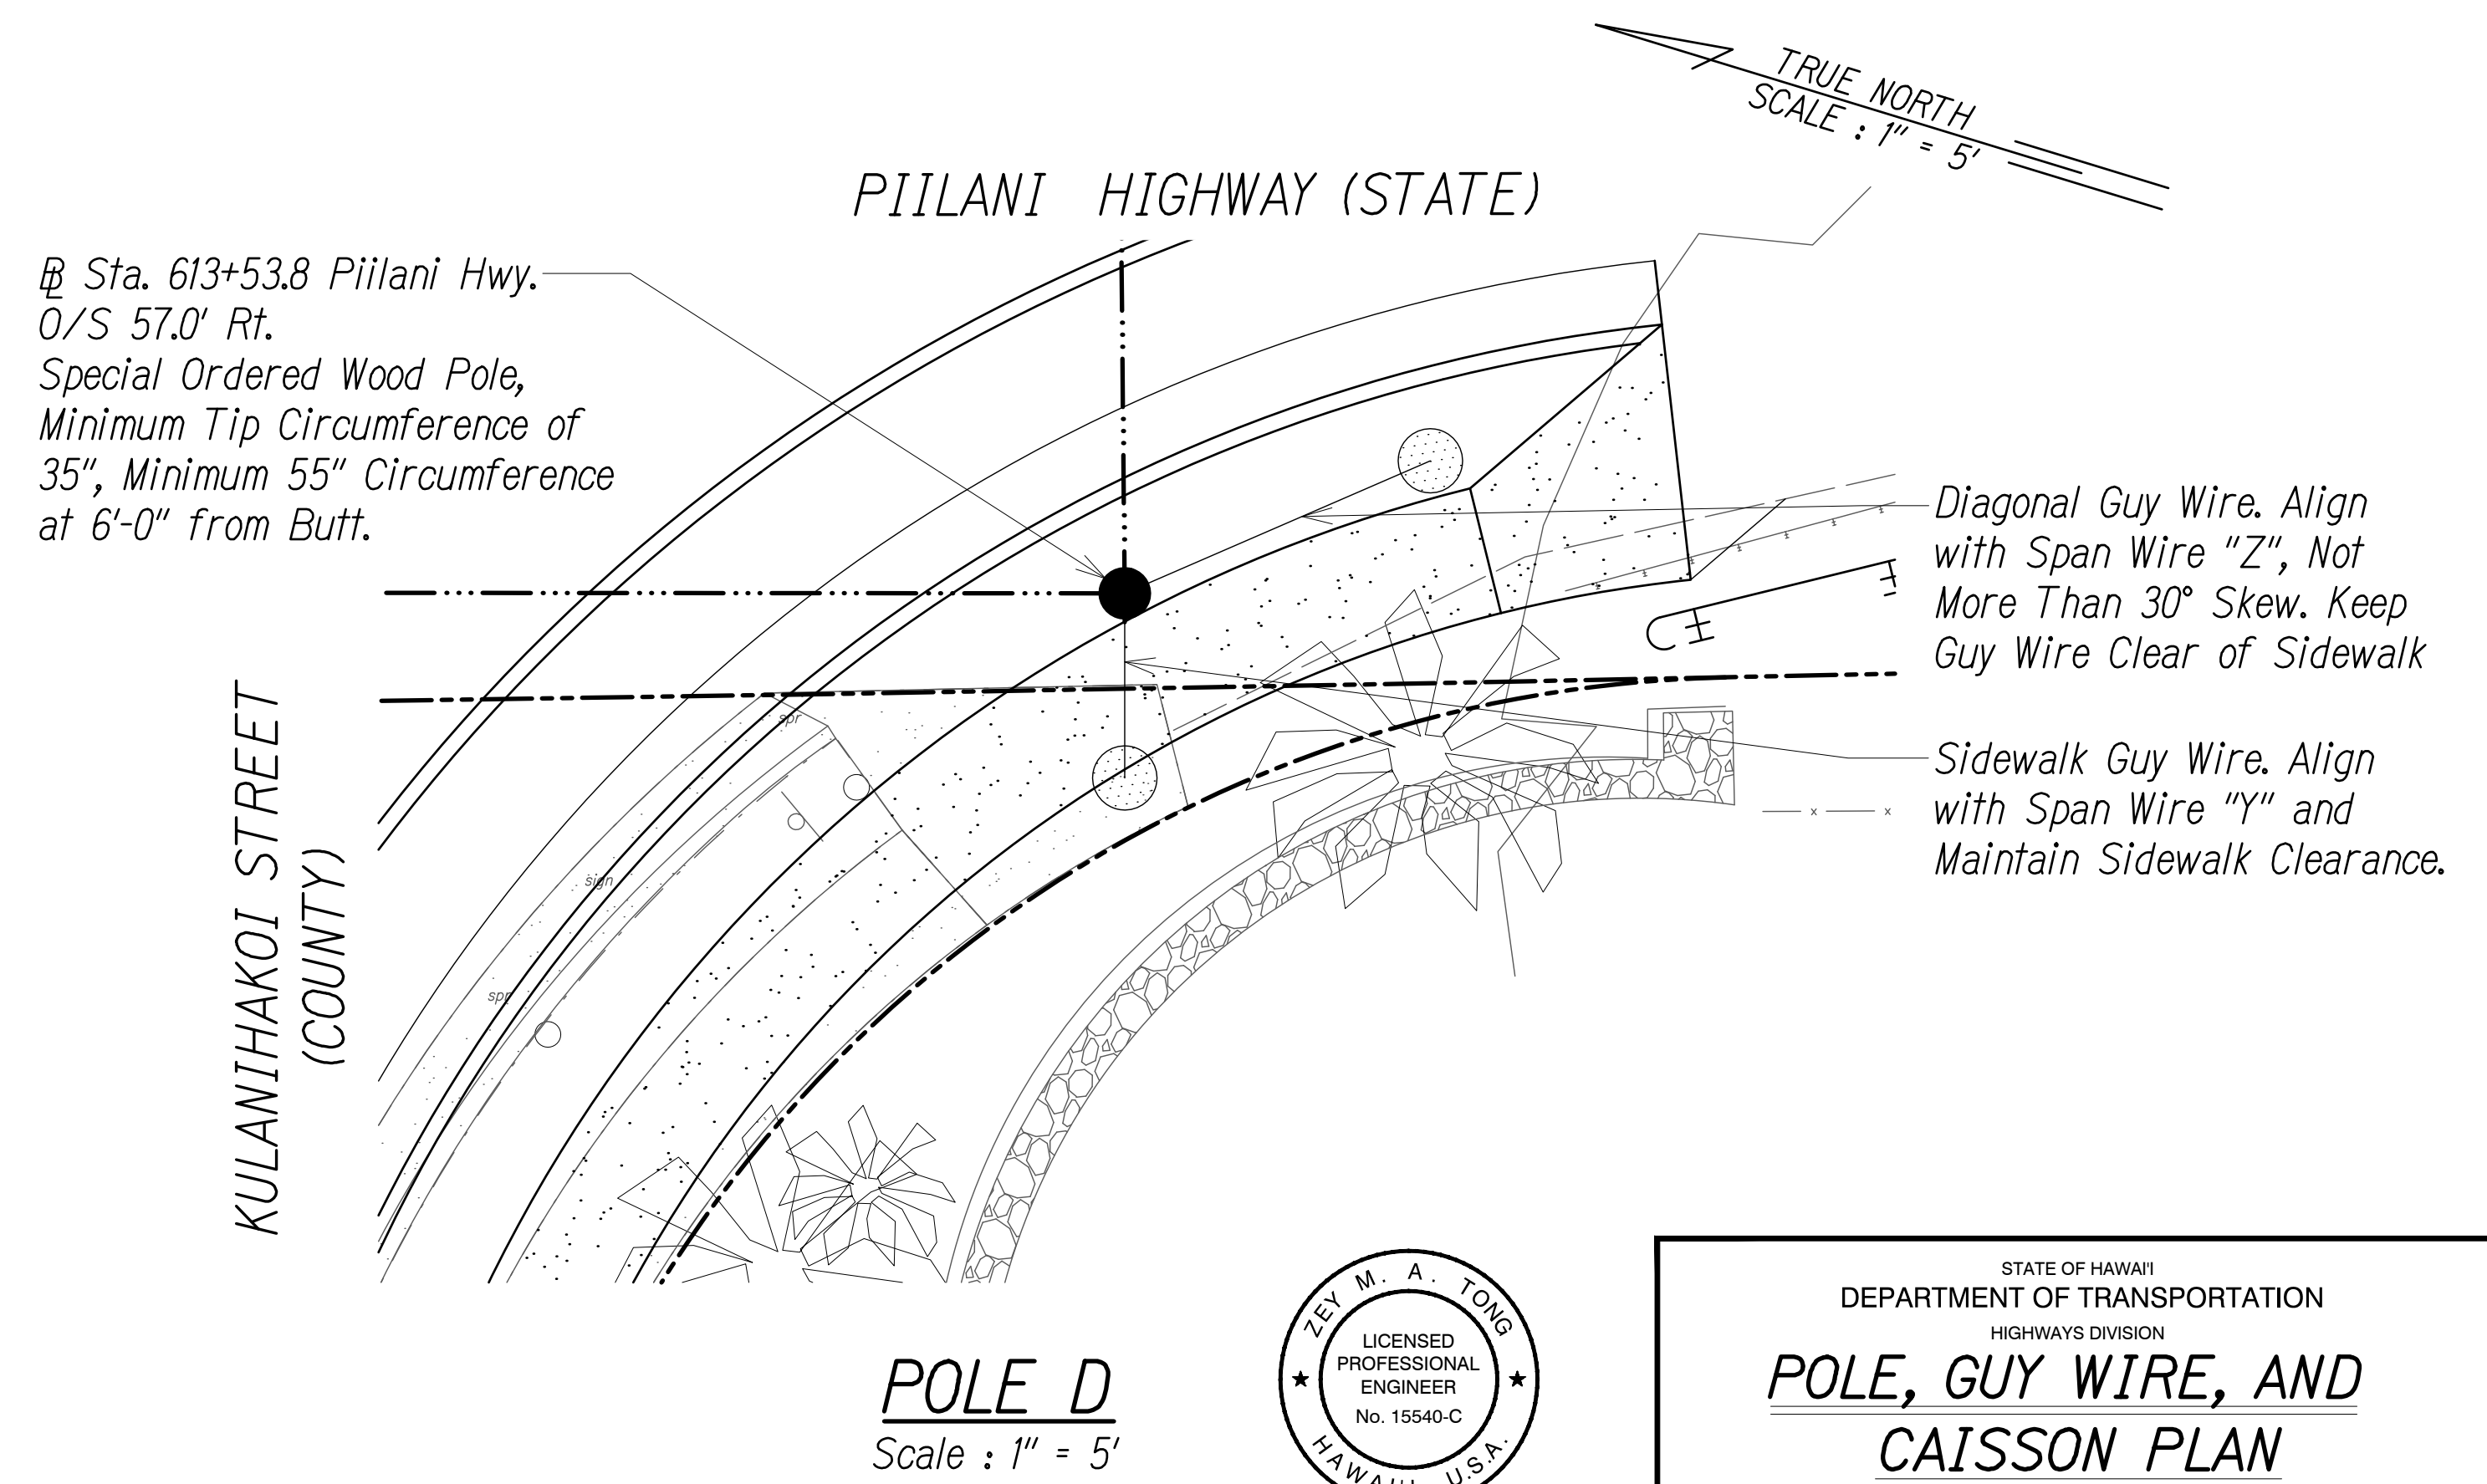


Note: See C-24 For Guy Wire and Caisson Details

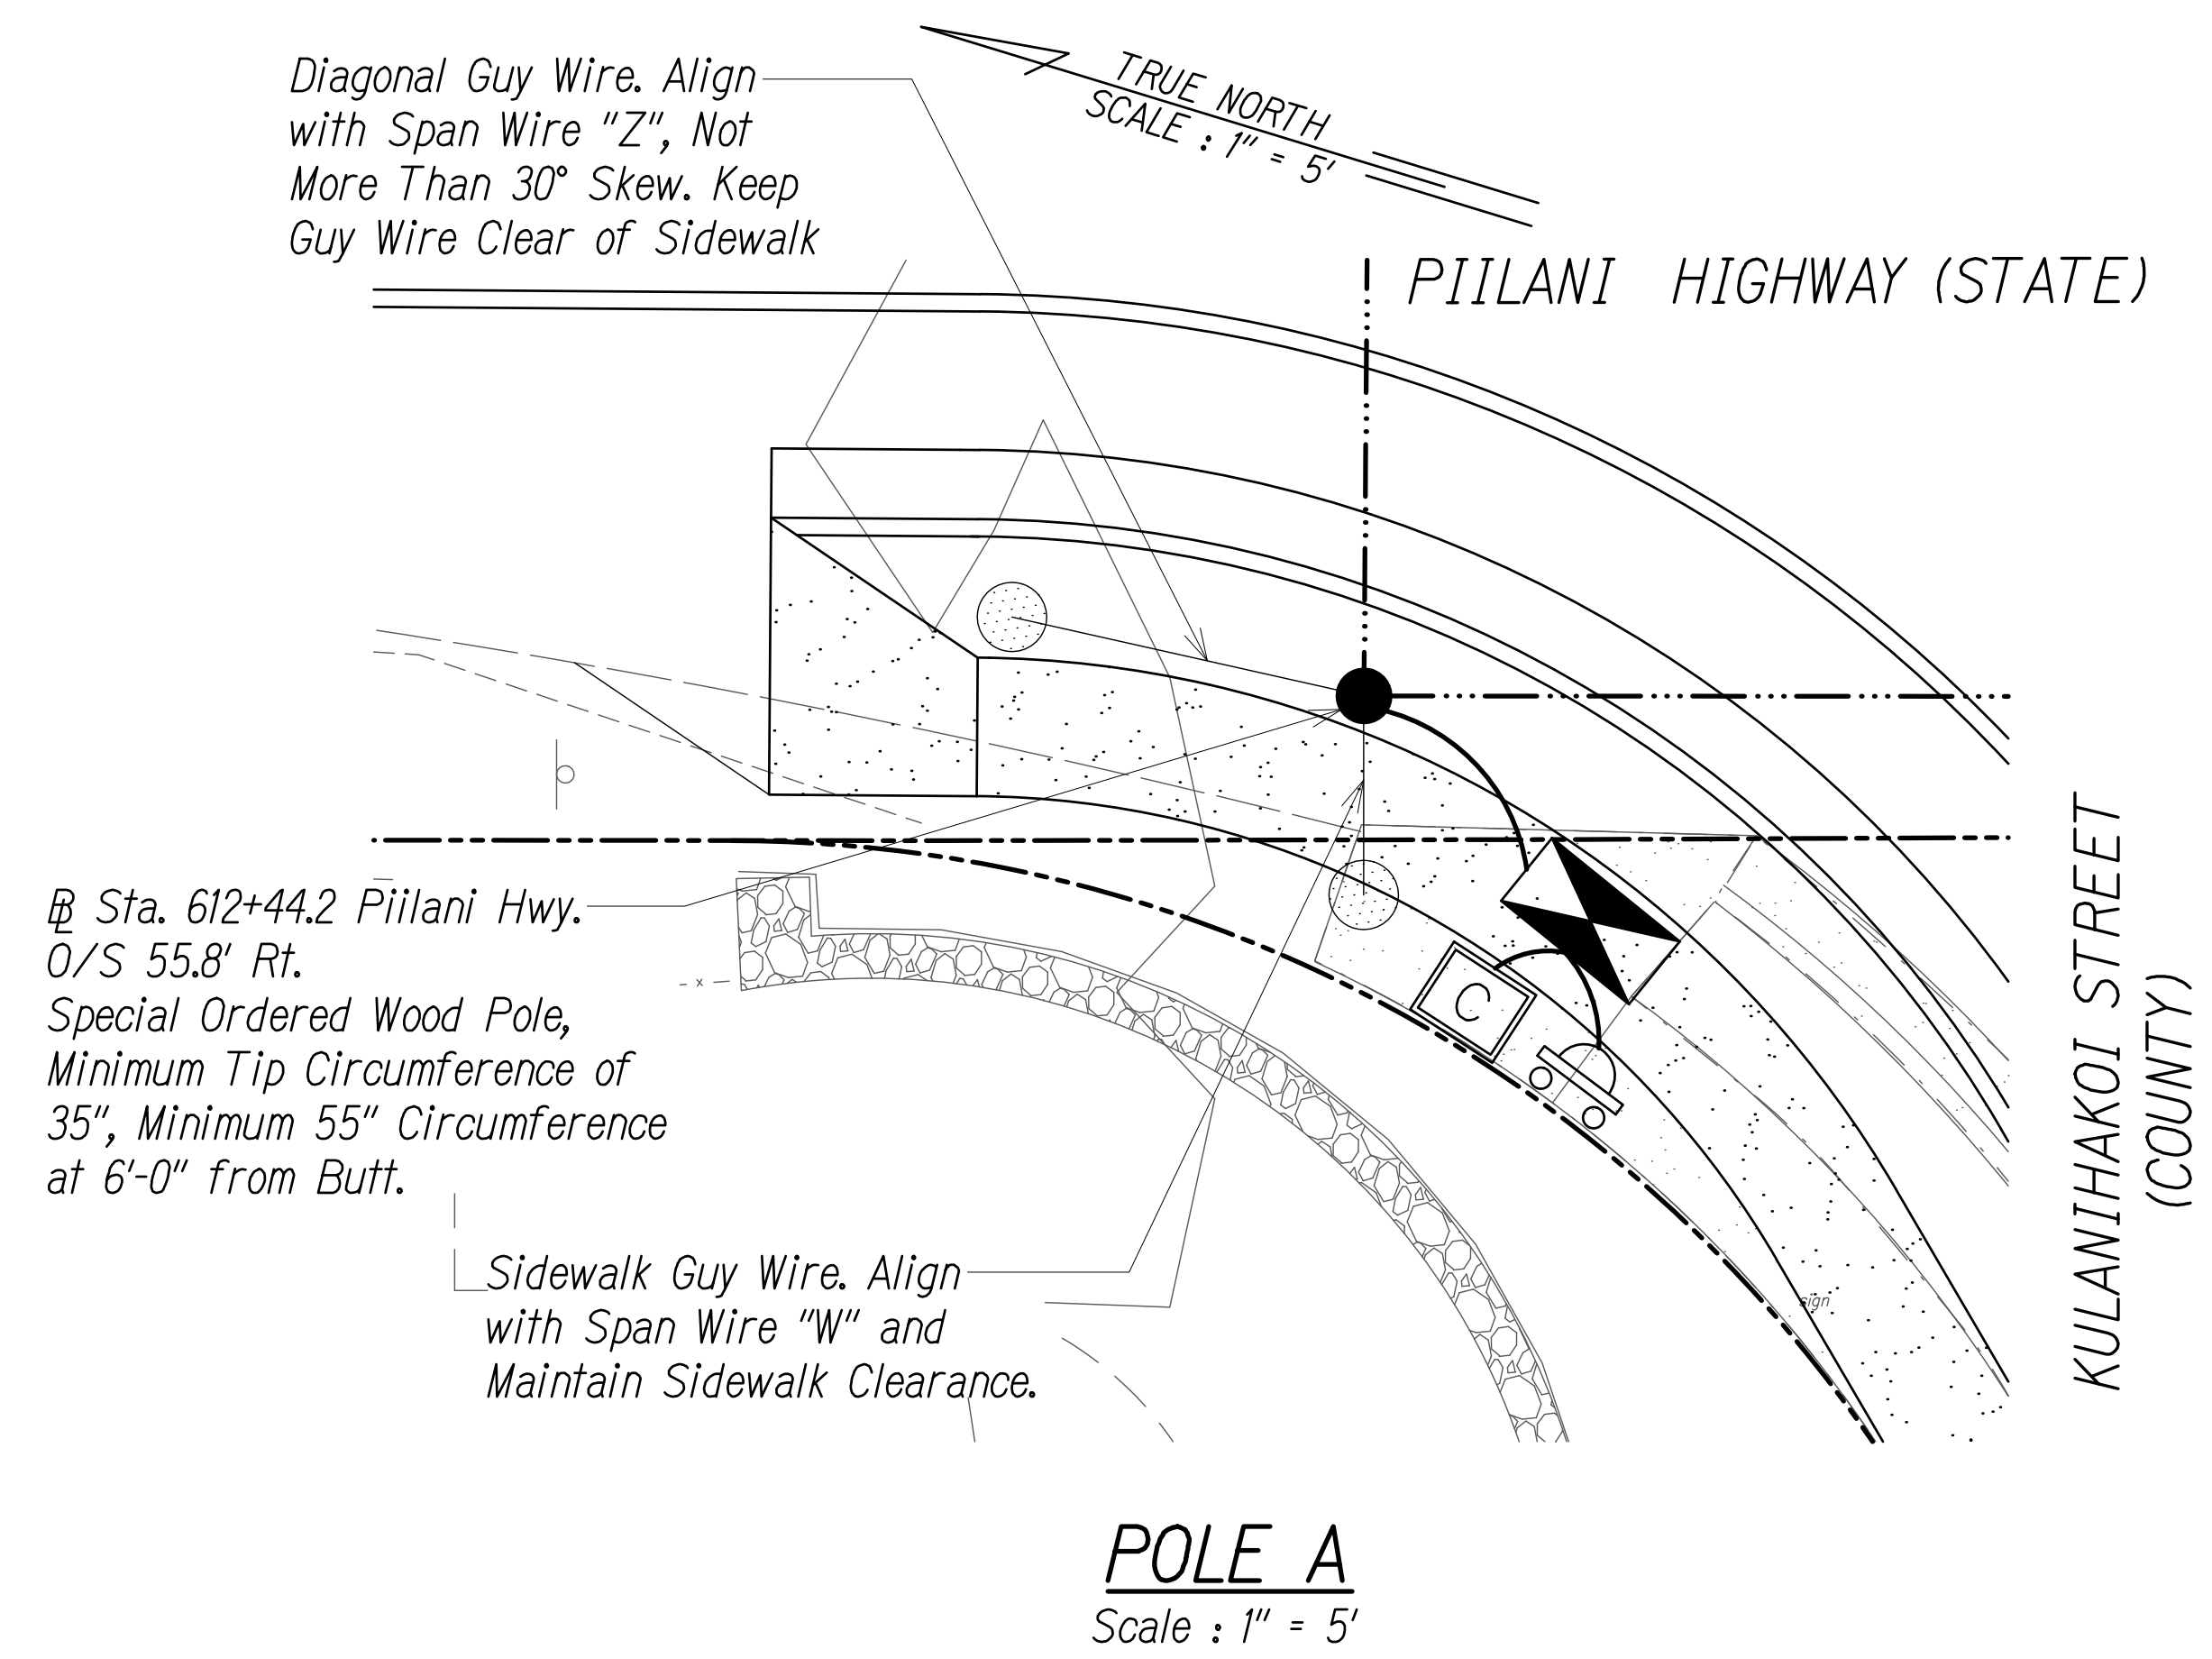

GRAPHIC SCALE:
5' 2.5' 0 5' 10'
SCALE: 1" = 5'

POLE, GUY WIRE, AND CAISSON PLAN
Scale : 1" = 5'

ORIGINAL PLAN	SURVEY PLOTTED BY	DATE
NOTE BOOK	DRAWN BY	
No.	DESIGNED BY	
	QUANTITIES BY	
	CHECKED BY	

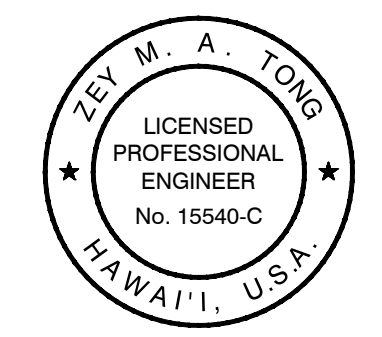

THIS WORK WAS PREPARED BY ME OR UNDER MY SUPERVISION.
Zey Tong
APRIL 30, 2020
LIC. EXP. DATE

STATE OF HAWAII
DEPARTMENT OF TRANSPORTATION
HIGHWAYS DIVISION
POLE, GUY WIRE, AND CAISSON PLAN
*Piilani Highway Improvements
Vicinity of Kulanihako Street
Project No. 31A-02-17*
Scale: As Shown Date: Mar 2018
SHEET No. C-21 OF 24 SHEETS