



FED. ROAD DIST. NO.	STATE	PROJ. NO.	FISCAL YEAR	SHEET NO.	TOTAL SHEETS
HAWAII	HAW.	31A-02-17	2018	21	29

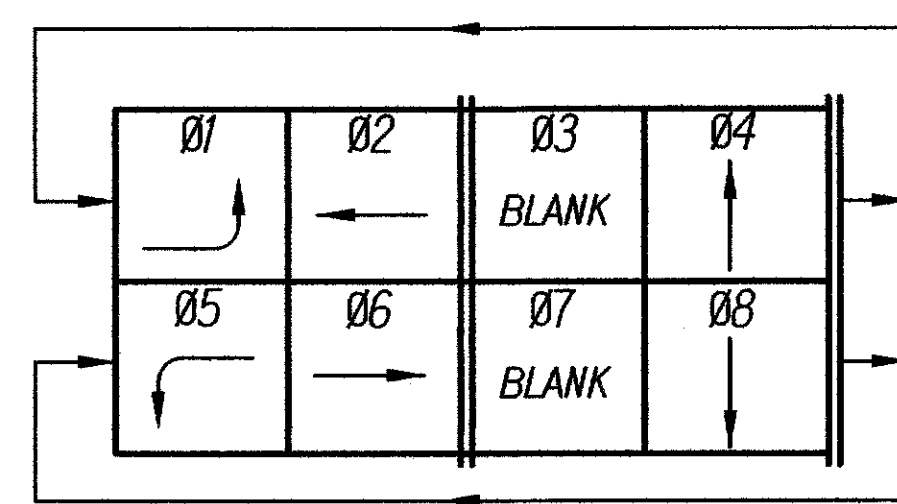


PHASE DIAGRAM
New Model 2070 Controller
New 332 Cabinet

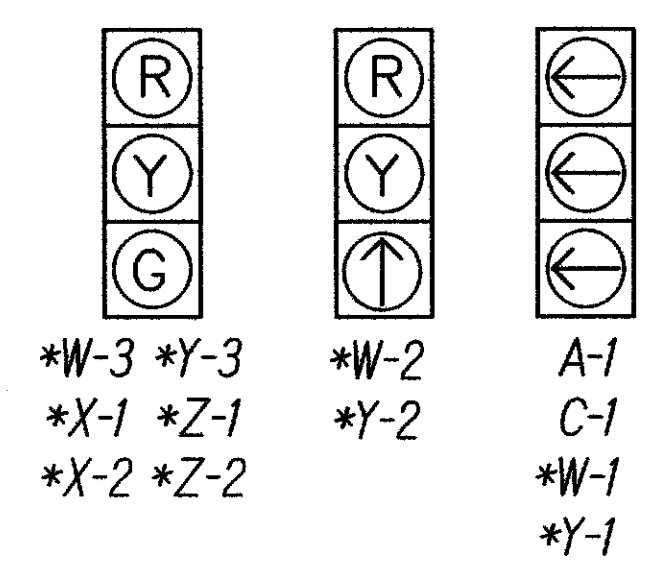

SIGNAL INDICATIONS
*Indicates Back Plate to be Installed on Signal Head

CONDUIT	CABLE
2" Conc.	1-26C#14
2" Conc.	1-26C#14
2" Conc.	1-26C#14
2" Conc.	1-26C#14
2" Conc.	2-Camera
2" Conc.	4-Evp Cable
2" Conc.	Spare

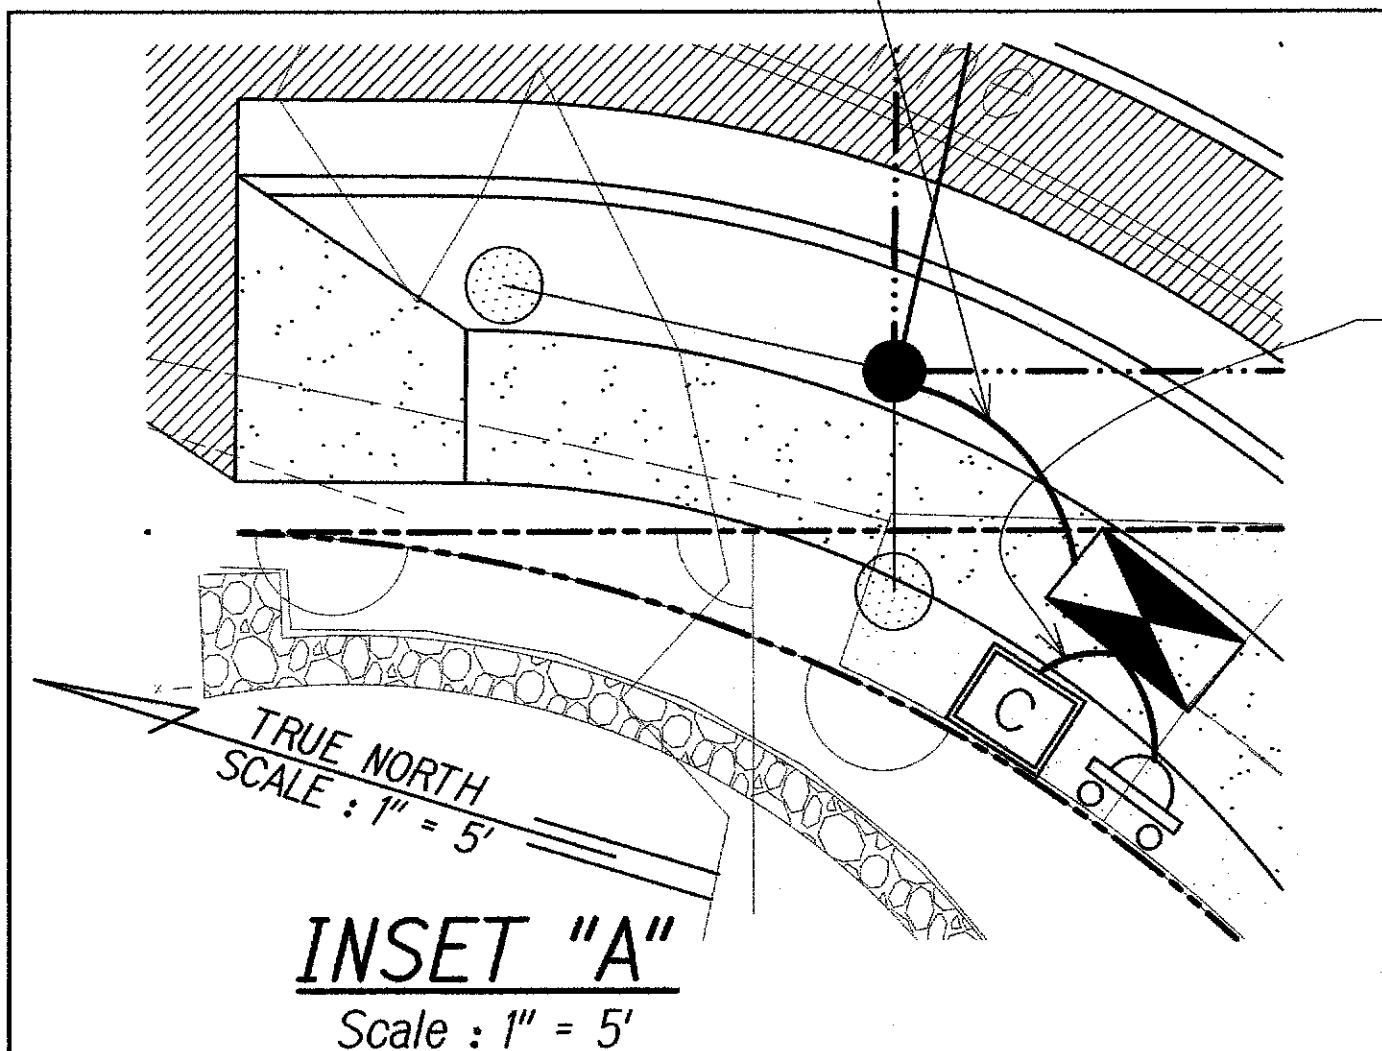

GRAPHIC SCALE:
20' 10' 0 20' 40'
SCALE: 1" = 20'

CONDUIT	CABLE
O/H	2-26C#14
O/H	1-Evp Cable



CONDUIT	CABLE
O/H	2-26C#14
O/H	1-Camera

LOT 1
TMK: (2) 2-2-002: 081
STATE OF HAWAII - BLNR


CONDUIT	CABLE
O/H	2-26C#14
O/H	1-Camera
O/H	1-Evp Cable

CONDUIT	CABLE
2" Conc.	1-26C#14
2" Conc.	1-26C#14
2" Conc.	1-26C#14
2" Conc.	1-26C#14
2" Conc.	2-Camera
2" Conc.	4-Evp Cable
2" Conc.	1-3C#4
2" Conc.	Spare

CONDUIT	CABLE
O/H	2-26C#14
O/H	1-Camera
O/H	2-Evp Cable

TRAFFIC SIGNAL PLAN
Scale : 1" = 20'

SURVEY PLOTTED BY	DATE
DRAWN BY	
DESIGNED BY	
QUANTITIES BY	
CHECKED BY	
ORIGINAL PLAN	No.
NOTE BOOK	

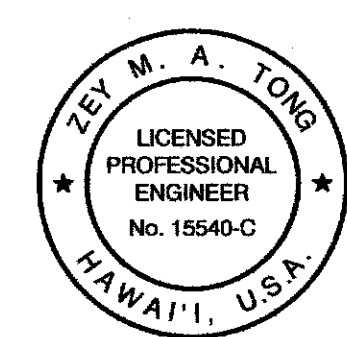

THIS WORK WAS PREPARED BY ME OR UNDER MY SUPERVISION.
Zey Tong
APRIL 30, 2020
LIC. EXP. DATE

- Notes:**
1. Wood Poles Designated By "A", "B", "C", and "D".
 2. Span Wire Runs Designated By "W", "X", "Y", and "Z".
 3. For Guy Wire and Caisson Layout, See Sht. C-21.
 4. Ongoing "Kihei High School" Project in Area. Coordinate as Required. ⚠

⚠	Added Note Referencing "Kihei High School" Project
6/04/18	
DATE	REVISION
STATE OF HAWAII DEPARTMENT OF TRANSPORTATION HIGHWAYS DIVISION	
TRAFFIC SIGNAL PLAN	
Piilani Highway Improvements Vicinity of Kulanihako Street Project No. 31A-02-17	
Scale: As Shown	Date: Mar 2018
SHEET No. C-20 OF 24 SHEETS	