



FED. ROAD DIST. NO.	STATE	PROJ. NO.	FISCAL YEAR	SHEET NO.	TOTAL SHEETS
HAWAII	HAW.	31A-02-17	2018	14	29

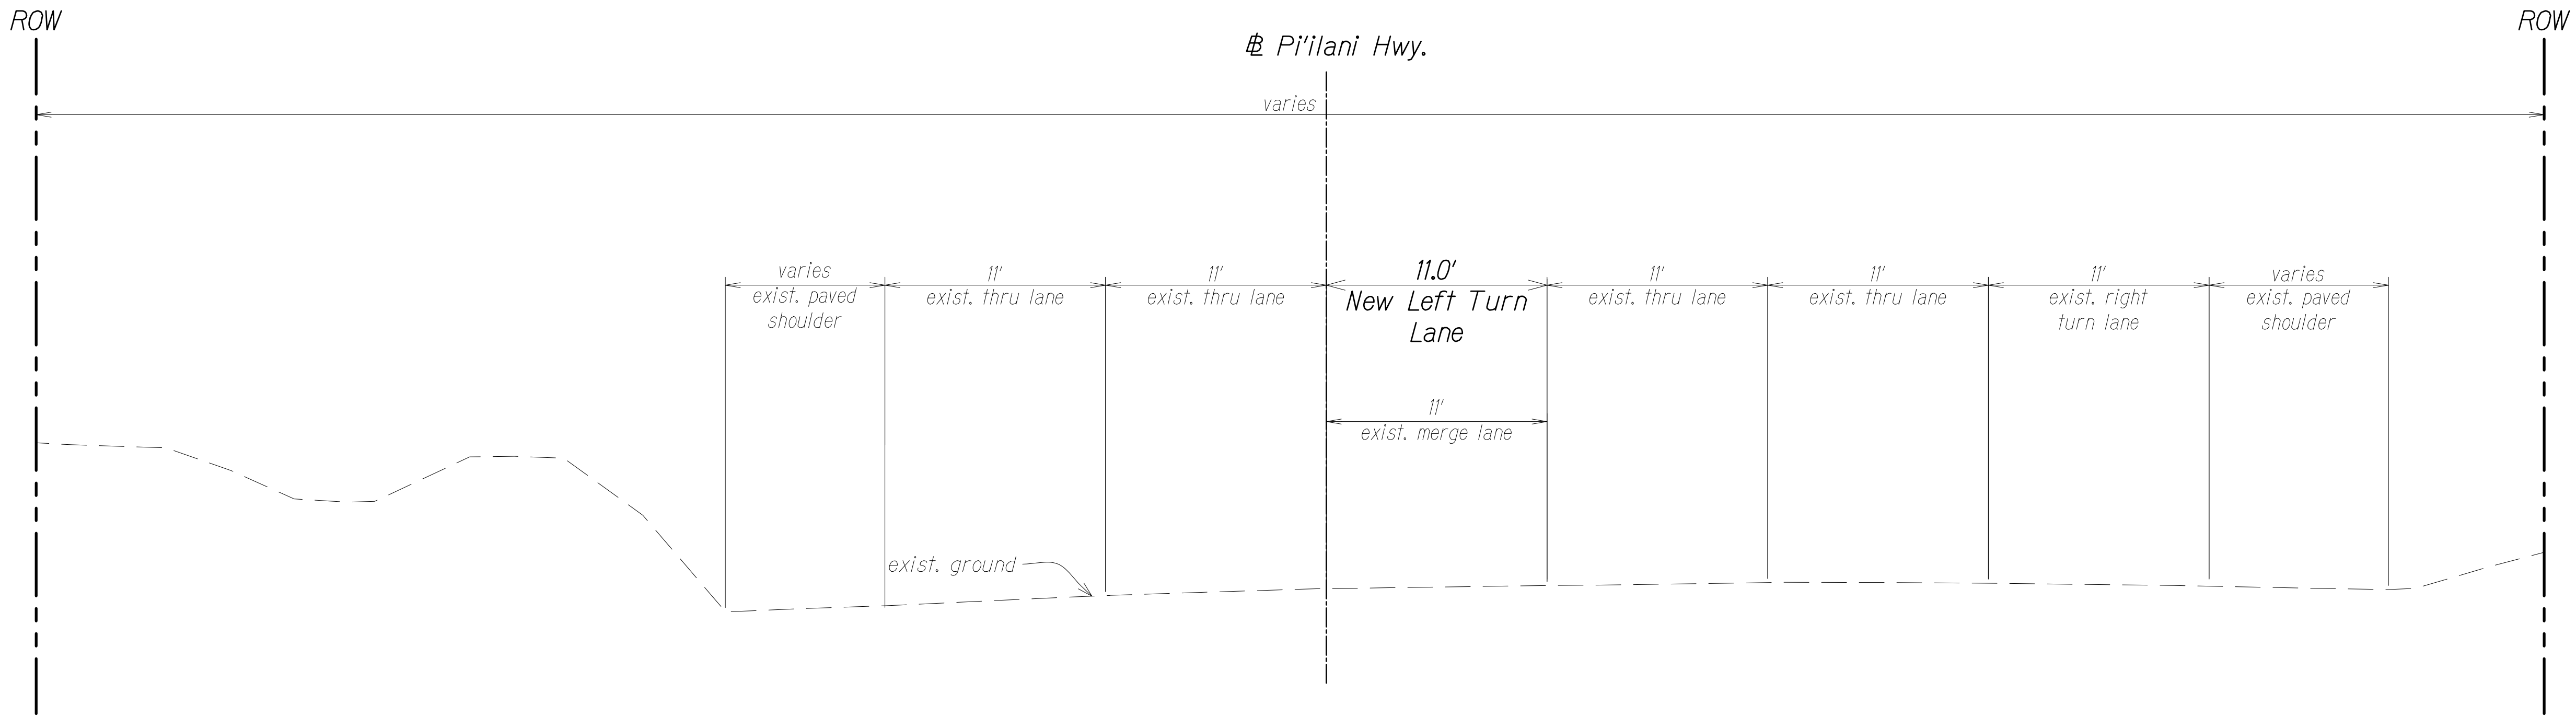

TYPICAL SECTION - PIILANI HIGHWAY

Scale : 1" = 5'

ORIGINAL PLAN	SURVEY PLOTTED BY	DATE
	DRAWN BY	
	DESIGNED BY	
	QUANTITIES BY	
	CHECKED BY	
NOTE BOOK	No.	

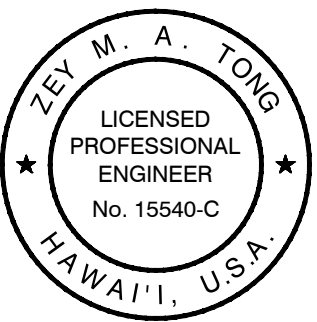

THIS WORK WAS PREPARED BY  
ME OR UNDER MY SUPERVISION.  
*Zey Tong*  
APRIL 30, 2020  
LIC. EXP. DATE

STATE OF HAWAII  
DEPARTMENT OF TRANSPORTATION  
HIGHWAYS DIVISION

TYPICAL SECTION PLAN

Piilani Highway Improvements  
Vicinity of Kulanihako Street  
Project No. 31A-02-17

Scale: As Shown Date: Mar 2018

SHEET No. C-13 OF 24 SHEETS