
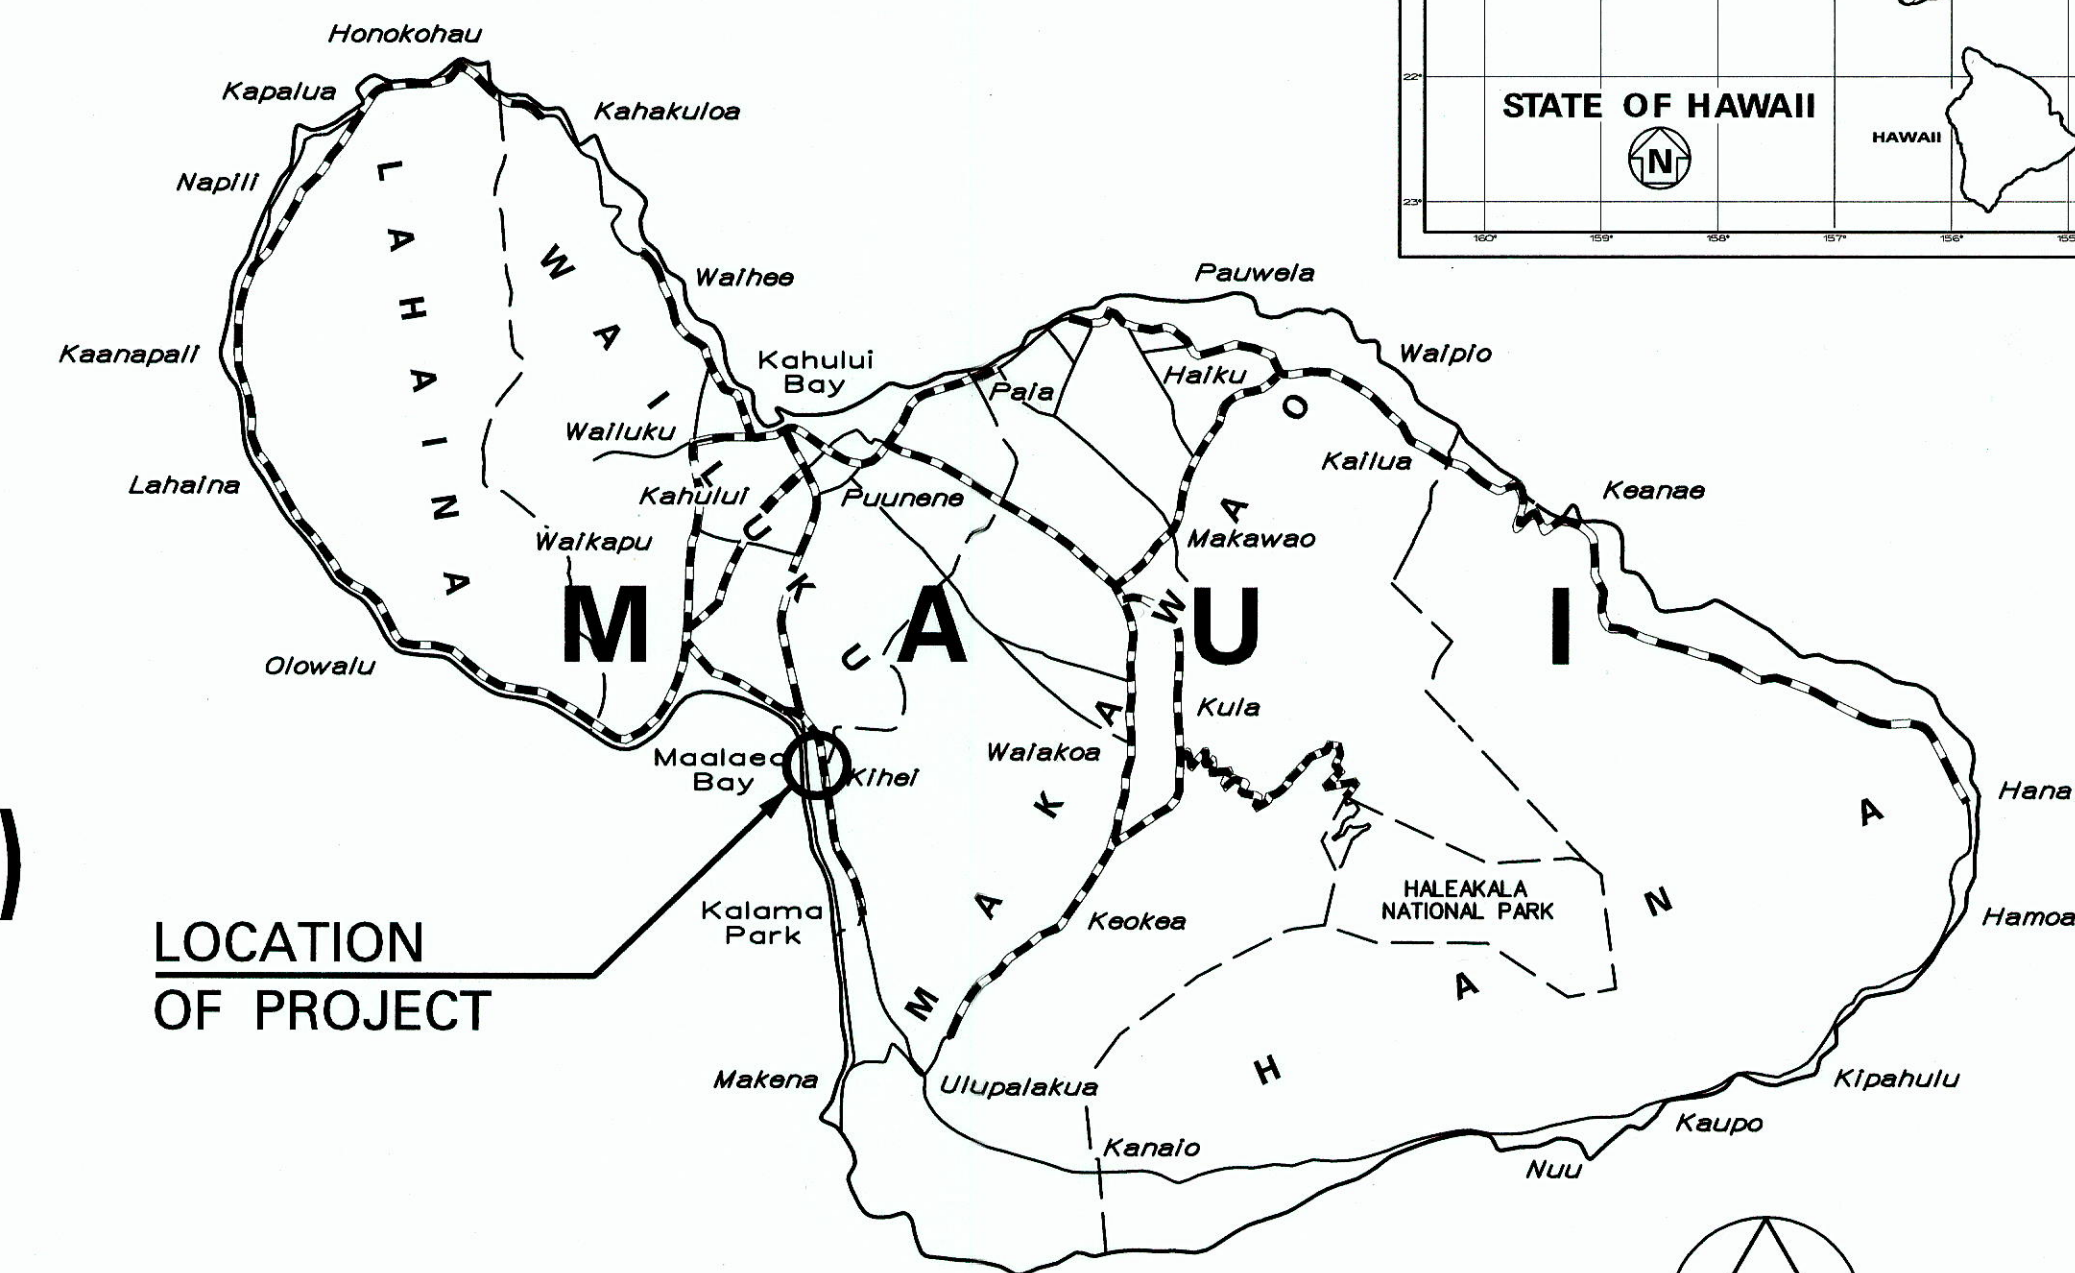


INDEX TO DRAWINGS	
SHEET NO.	DESCRIPTION
1	TITLE SHEET
2	STANDARD PLANS SUMMARY
3 - 8	GENERAL NOTES
9 - 15	UTILITY NOTES
16	WATER POLLUTION AND EROSION CONTROL DETAILS
17	LEGEND AND ABBREVIATIONS
18	DEMOLITION AND SURVEY CONTROL PLAN
19	TYPICAL SECTIONS
20 - 21	ROADWAY CONSTRUCTION PLANS
22 - 23	GRADING AND DRAINAGE PLANS
24	CURB RAMP NOTES AND DETAILS
25 - 27	TRAFFIC ISLAND PLANS AND DETAILS
28	MISCELLANEOUS DETAILS
29 - 30	GUARDRAIL DETAILS AND NOTES
31	FLARED ENERGY ABSORBING TERMINAL PLANS
32	SIGNING AND PAVEMENT MARKINGS NOTES AND LEGEND
33 - 34	SIGNING AND PAVEMENT MARKING PLANS
35 - 39	TRAFFIC SIGNAL PLAN, NOTES, LEGEND AND MISC. DETAILS
40 - 46	TRAFFIC CONTROL NOTES, LEGEND AND PLANS
47 - 50	LIGHTING PLANS AND MISC. DETAILS
51 - 54	CROSS SECTIONS


Sheet No. ① ADD.395-1 is a Supplementary Sheet to this project.
 Total Sheet Count After "AS-BUILT" Posting 55 Sheets.

STATE OF HAWAII
 DEPARTMENT OF TRANSPORTATION
 HIGHWAYS DIVISION
 HONOLULU, HAWAII
"AS-BUILT"
 PLANS FOR
**PIILANI HIGHWAY
 TRAFFIC OPERATION IMPROVEMENTS
 AT OHUKAI ROAD**
FEDERAL AID PROJECT NO. CMAQ-031-1(012)
 DISTRICTS OF WAILUKU AND MAKAWAO
 ISLAND OF MAUI

FED. ROAD DIST. NO.	STATE	FED. AID PROJ. NO.	FISCAL YEAR	SHEET NO.	TOTAL SHEETS
HAWAII	HAW.	CMAQ-031-1(012)	2013	1	54

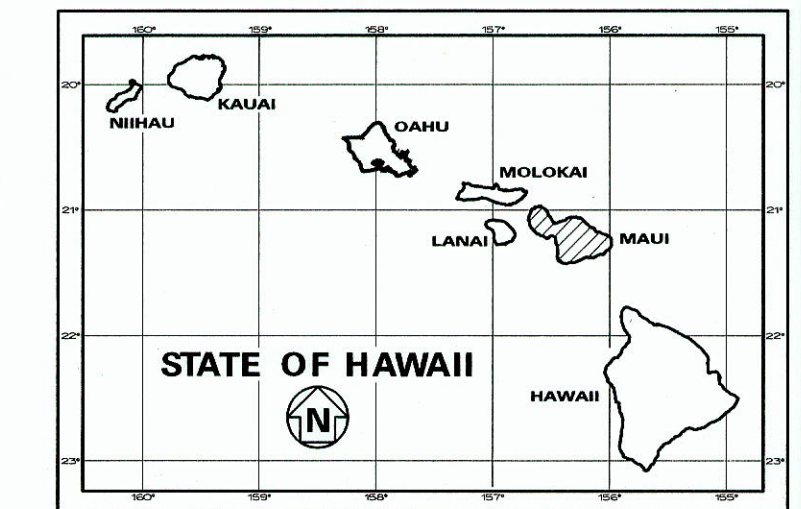

LOCATION OF PROJECT

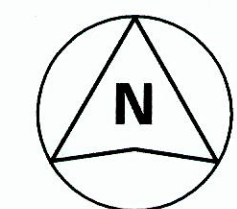


SCALE IN MILES
 0 5 10

--- FEDERAL AID PROJECTS PREVIOUSLY CONSTRUCTED OR UNDER CONSTRUCTION

MILE POST 0.05 TO MILE POST 0.11

DESIGN DESIGNATION

ADT (2009)	34,745
ADT (2030)	47,498
DHV (2009)	2,894
D	<u>53/47</u>
T	1.9 %
T ₂₄	2.2 %
V	40 M.P.H.

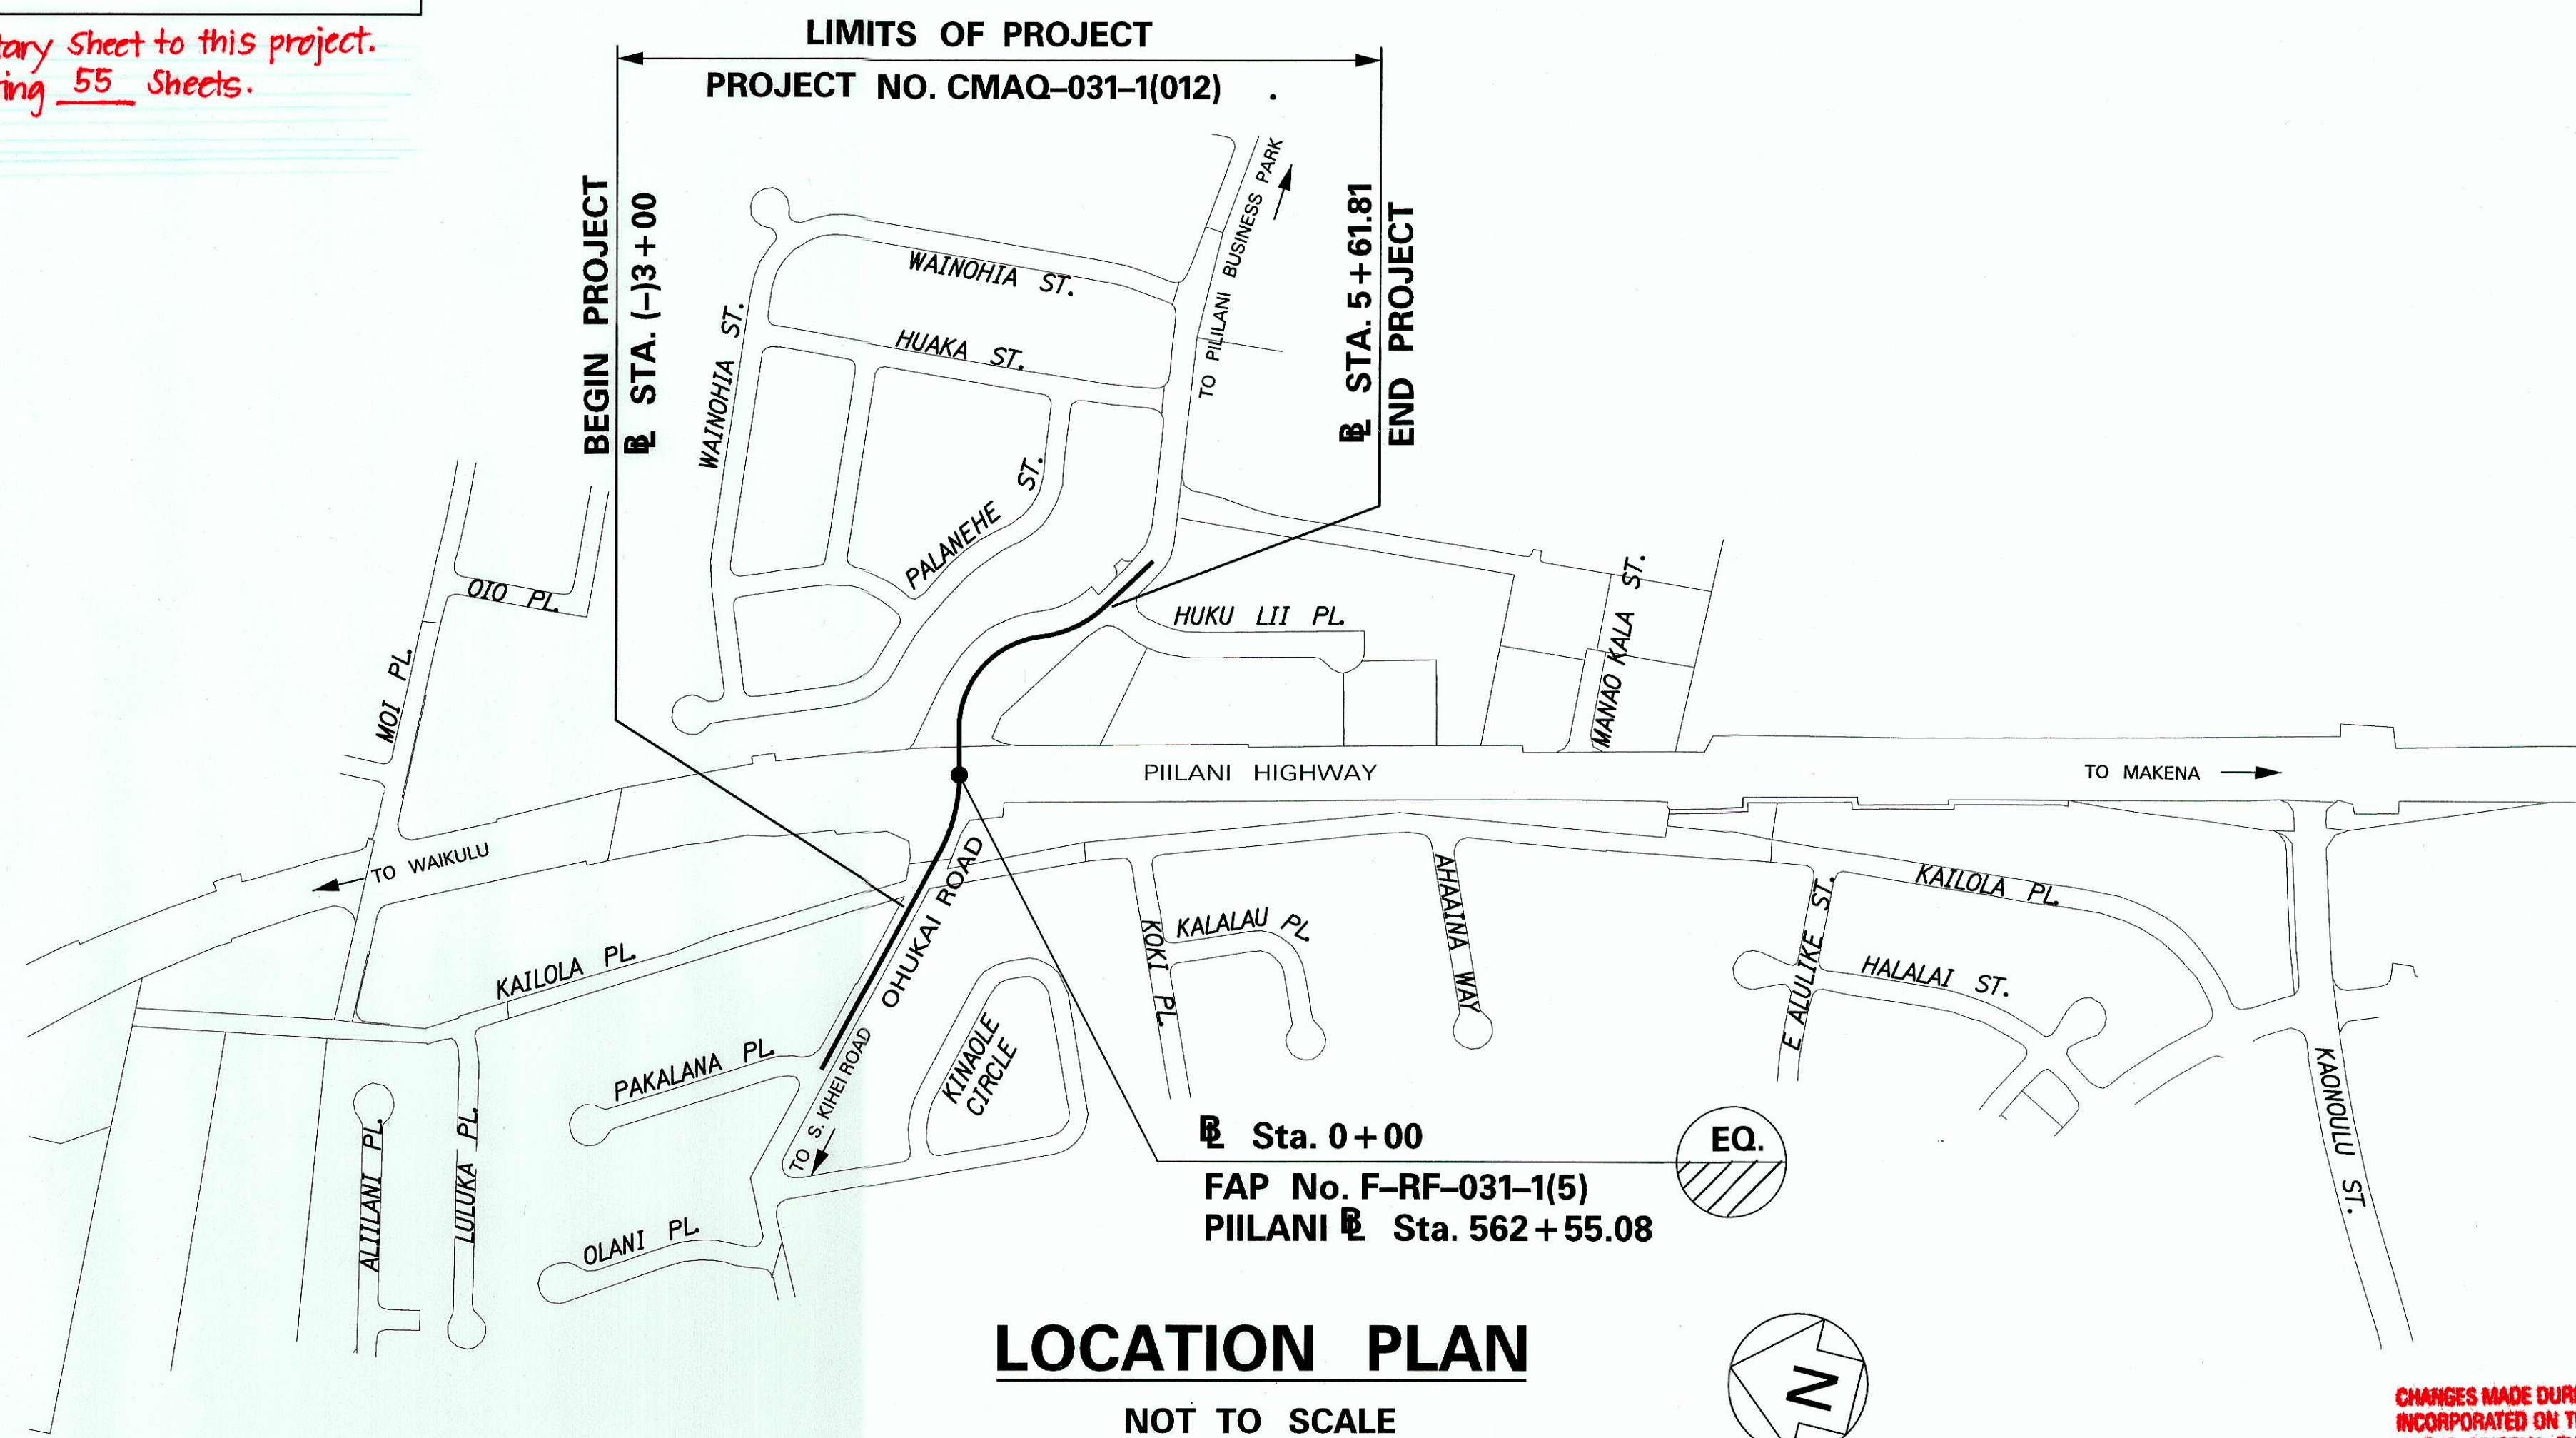

CHANGES MADE DURING CONSTRUCTION HAVE BEEN INCORPORATED ON THESE PLANS EXCEPT CHANGES IN THE ORIGINAL THEORETICAL QUANTITIES. FOR ACTUAL QUANTITIES, REFER TO PROJECT LEDGER AND/OR COMPUTATION BOOK.

[Signature] 8/9/16
 RESIDENT ENGINEER DATE

DEPARTMENT OF TRANSPORTATION
 STATE OF HAWAII
 APPROVED:
[Signature] 3/06/13
 FOR DIR. OF TRANSPORTATION DATE

ORIGINAL PLAN	DATE
DESIGNED BY	
DESIGNED BY	
QUANTITIES BY	
CHECKED BY	
N.	

Parsons Brinckerhoff, Inc. HWY-ME 873-3390 03/2013
 DESIGNED BY MANAGED BY PHONE DATE