



FED. ROAD DIST. NO.	STATE	FEDERAL AID PROJ. NO.	FISCAL YEAR	SHEET NO.	TOTAL SHEETS
HAWAII	HAW.	CMAQ-031-K012	2013	19	54

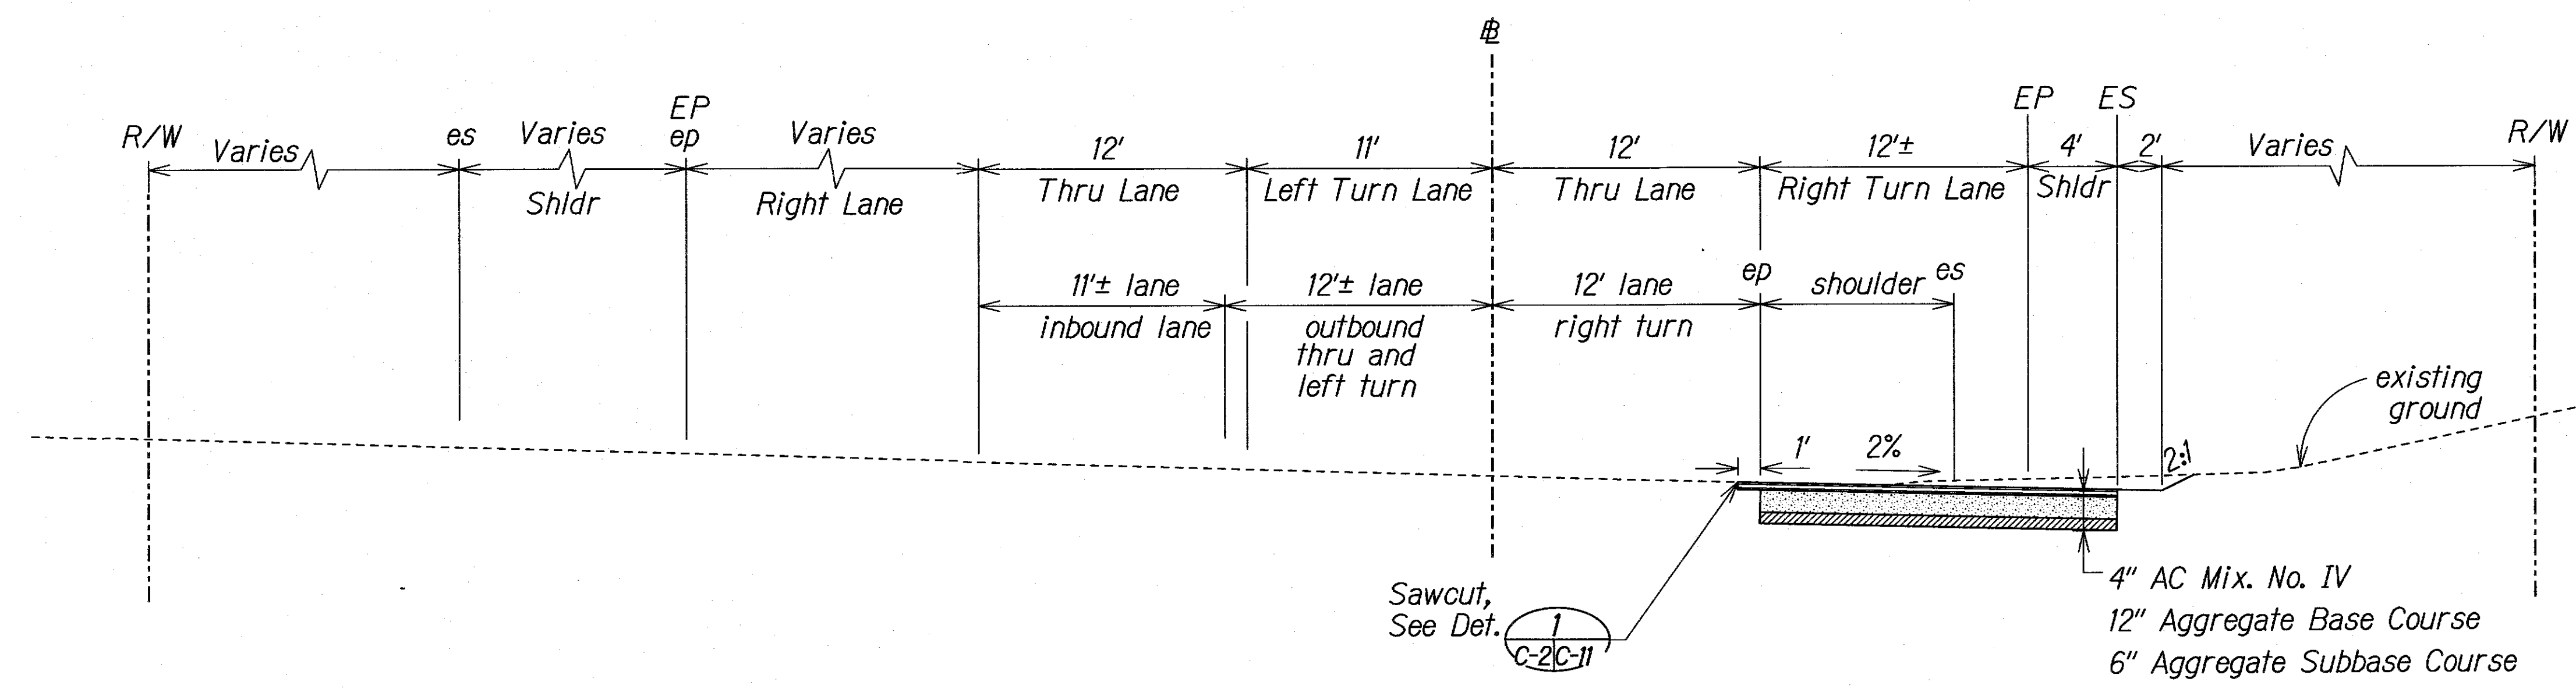


TYPICAL SECTION
OHUKAI ROAD # STA. (-)2+00 TO # STA. (-)10+50
 Scale: 1"=5'-0"

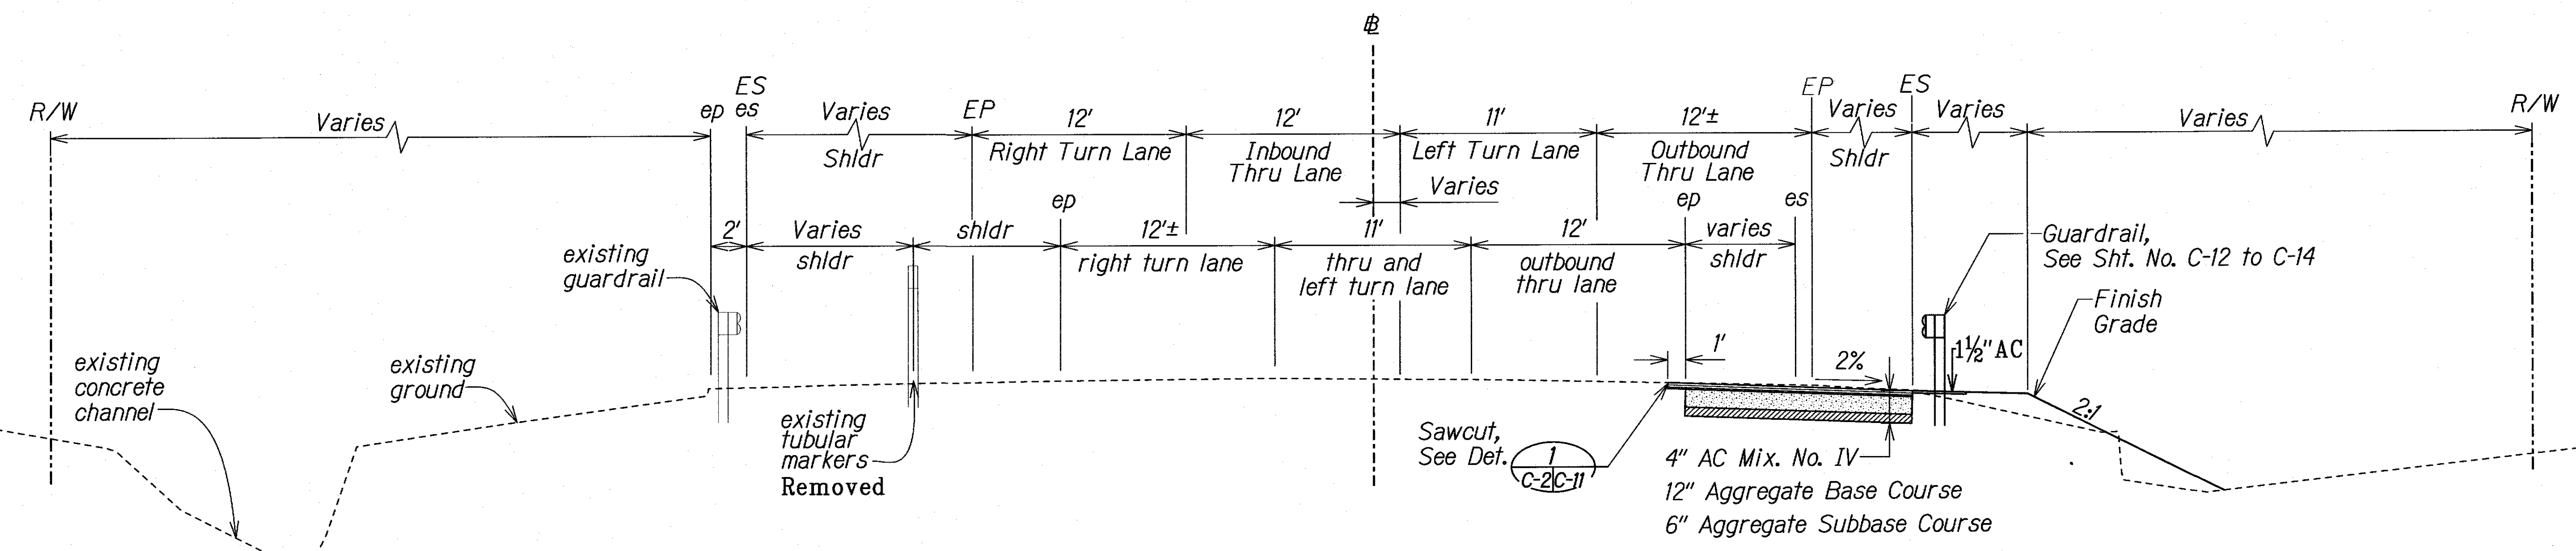

LEGEND FOR AS-BUILT POSTINGS

	Squiggly line for as-built deletion
	Double line for as-built deletion
Roadway	Text for as-built posting

TYPICAL SECTION
OHUKAI ROAD # STA. 0+50 TO # STA. 4+50
 Scale: 1"=5'-0"

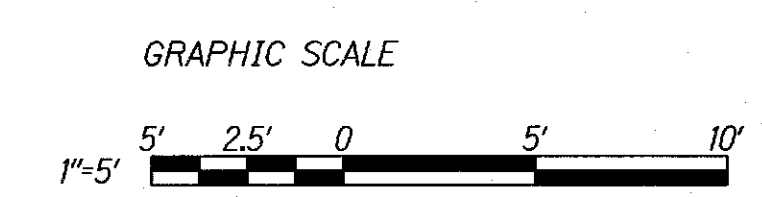

THIS WORK WAS PREPARED BY ME OR UNDER MY SUPERVISION.
 SIGNATURE: *[Signature]* DATE: 04/30/14
 EXPIRATION DATE OF THE LICENSE

STATE OF HAWAII
 DEPARTMENT OF TRANSPORTATION
 HIGHWAYS DIVISION

TYPICAL SECTIONS

PIILANI HIGHWAY
 TRAFFIC OPERATION IMPROVEMENTS AT OHUKAI ROAD
 FEDERAL AID PROJECT NO. CMAQ-031-K012
 Scale: 1"=5' Date: March 2013

SHEET No. C-2 OF 29 SHEETS

"AS-BUILT"