
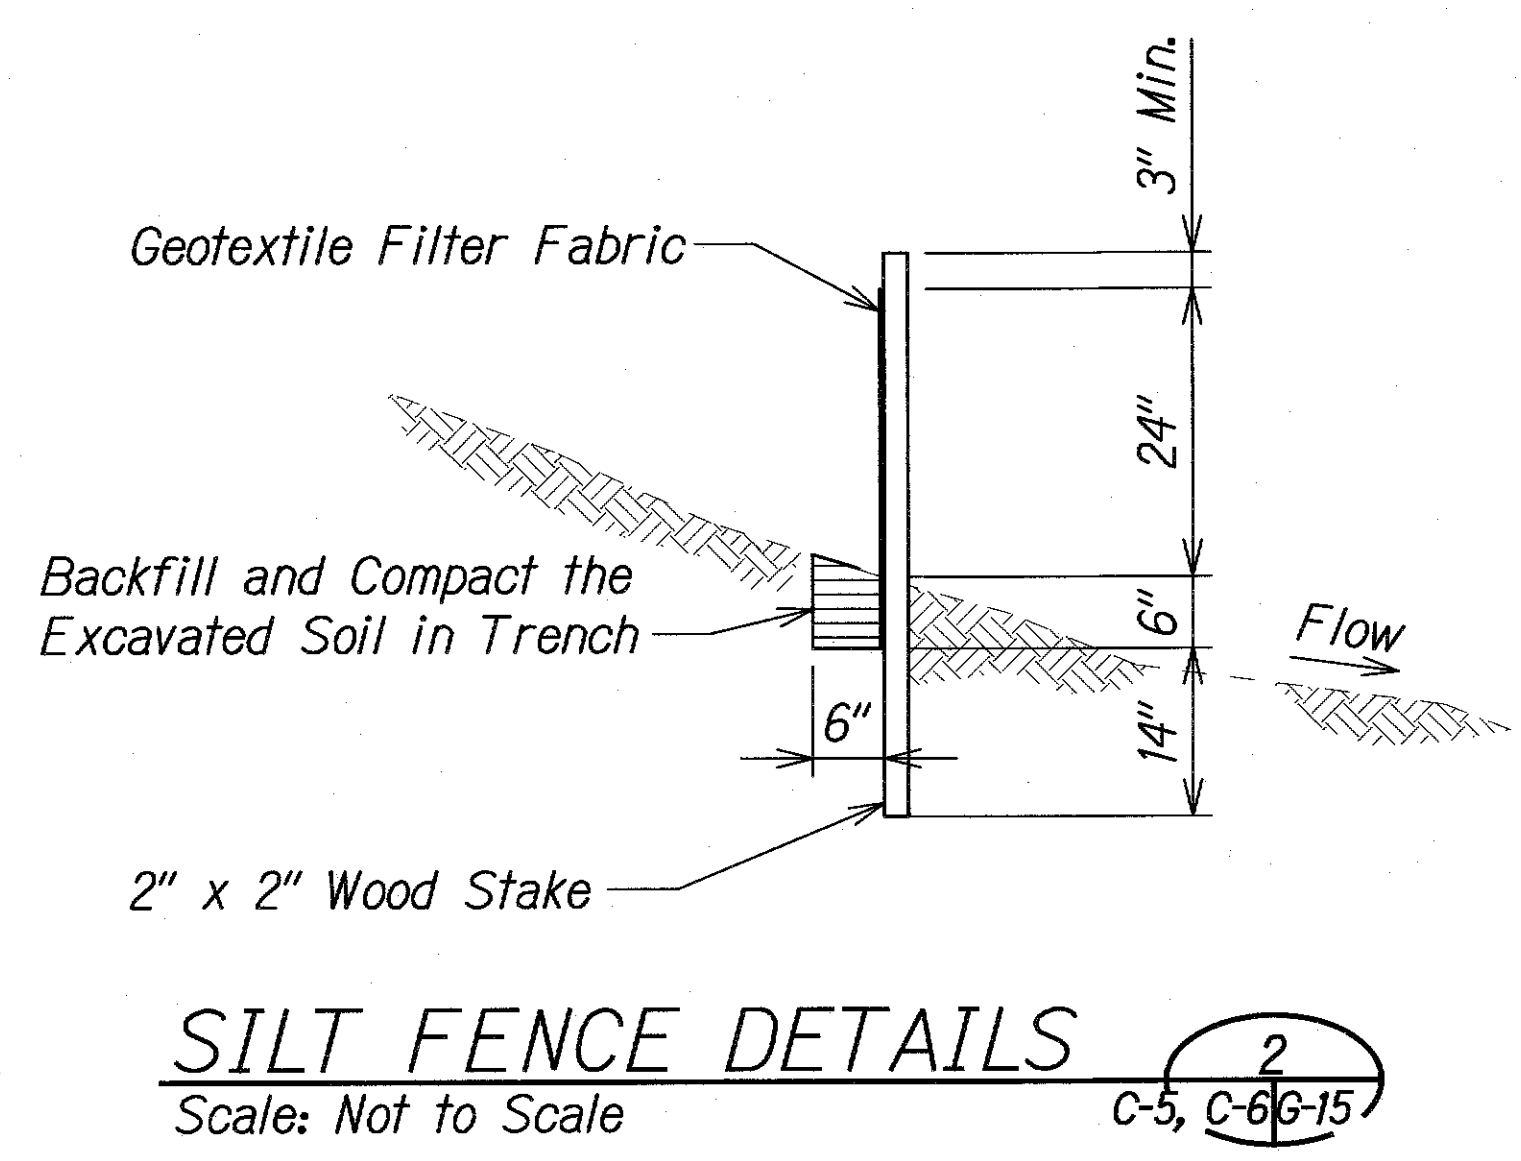
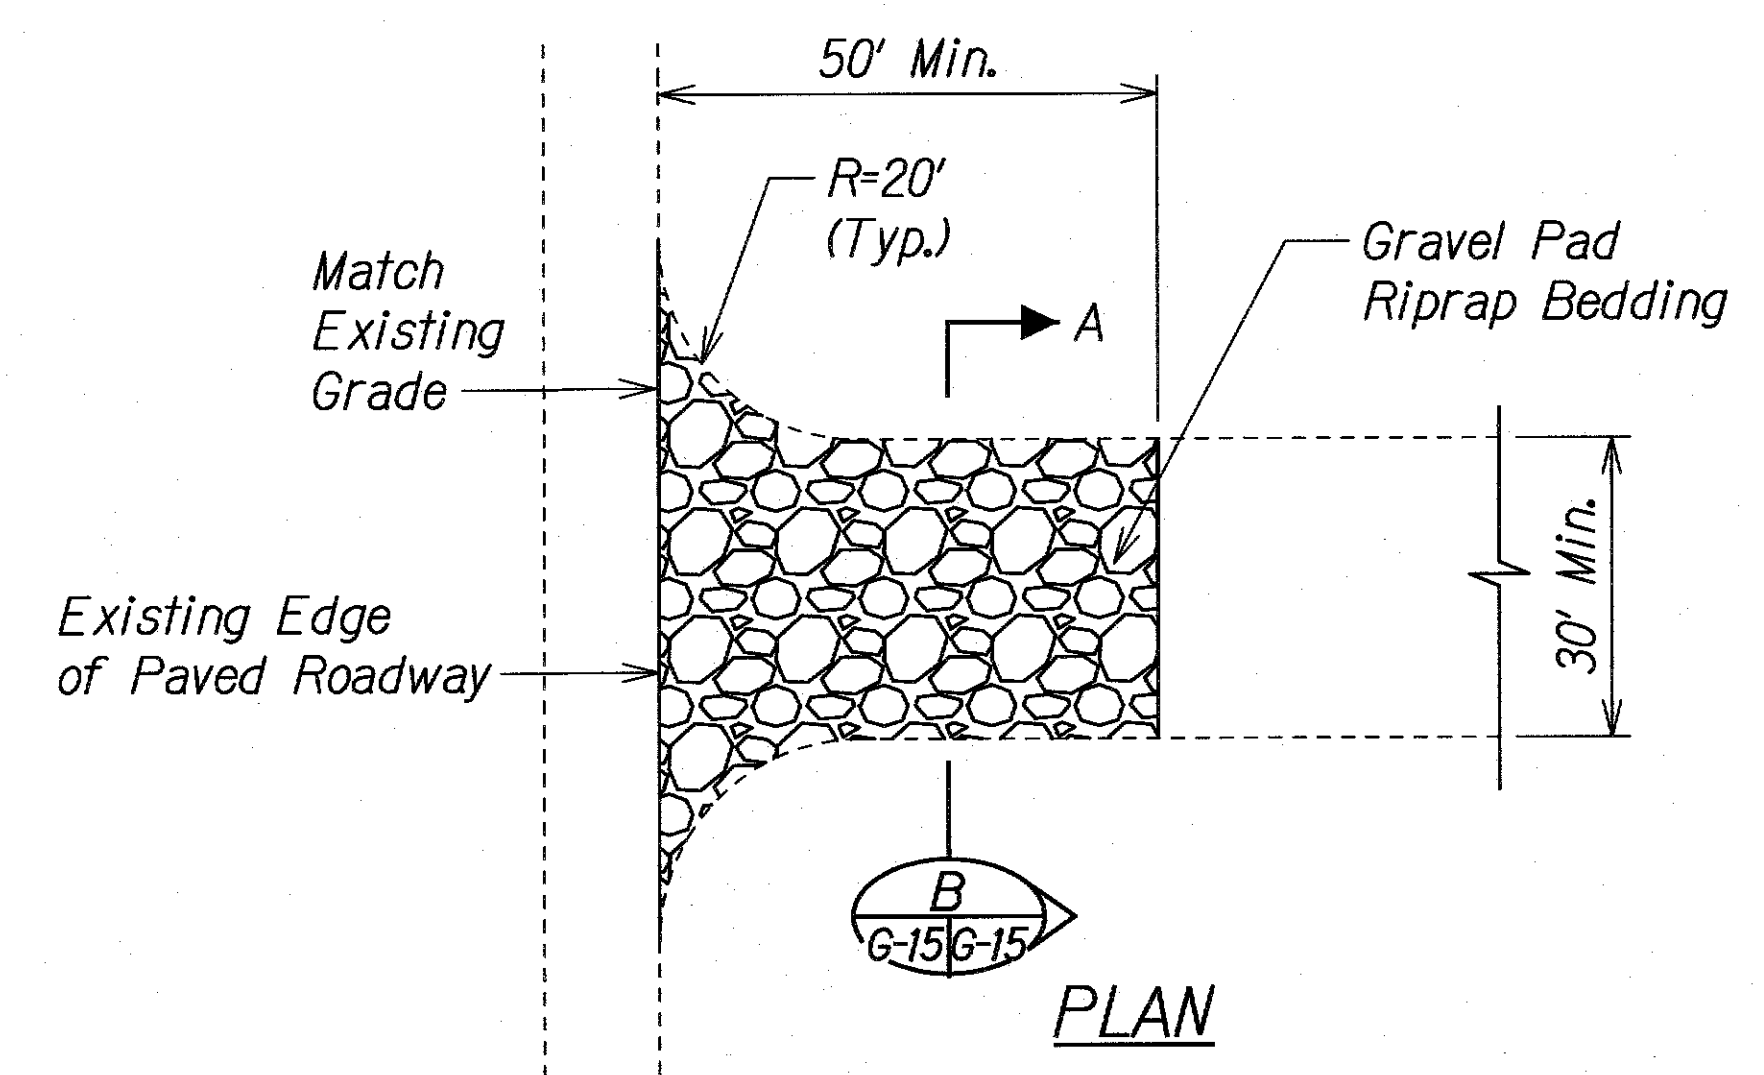
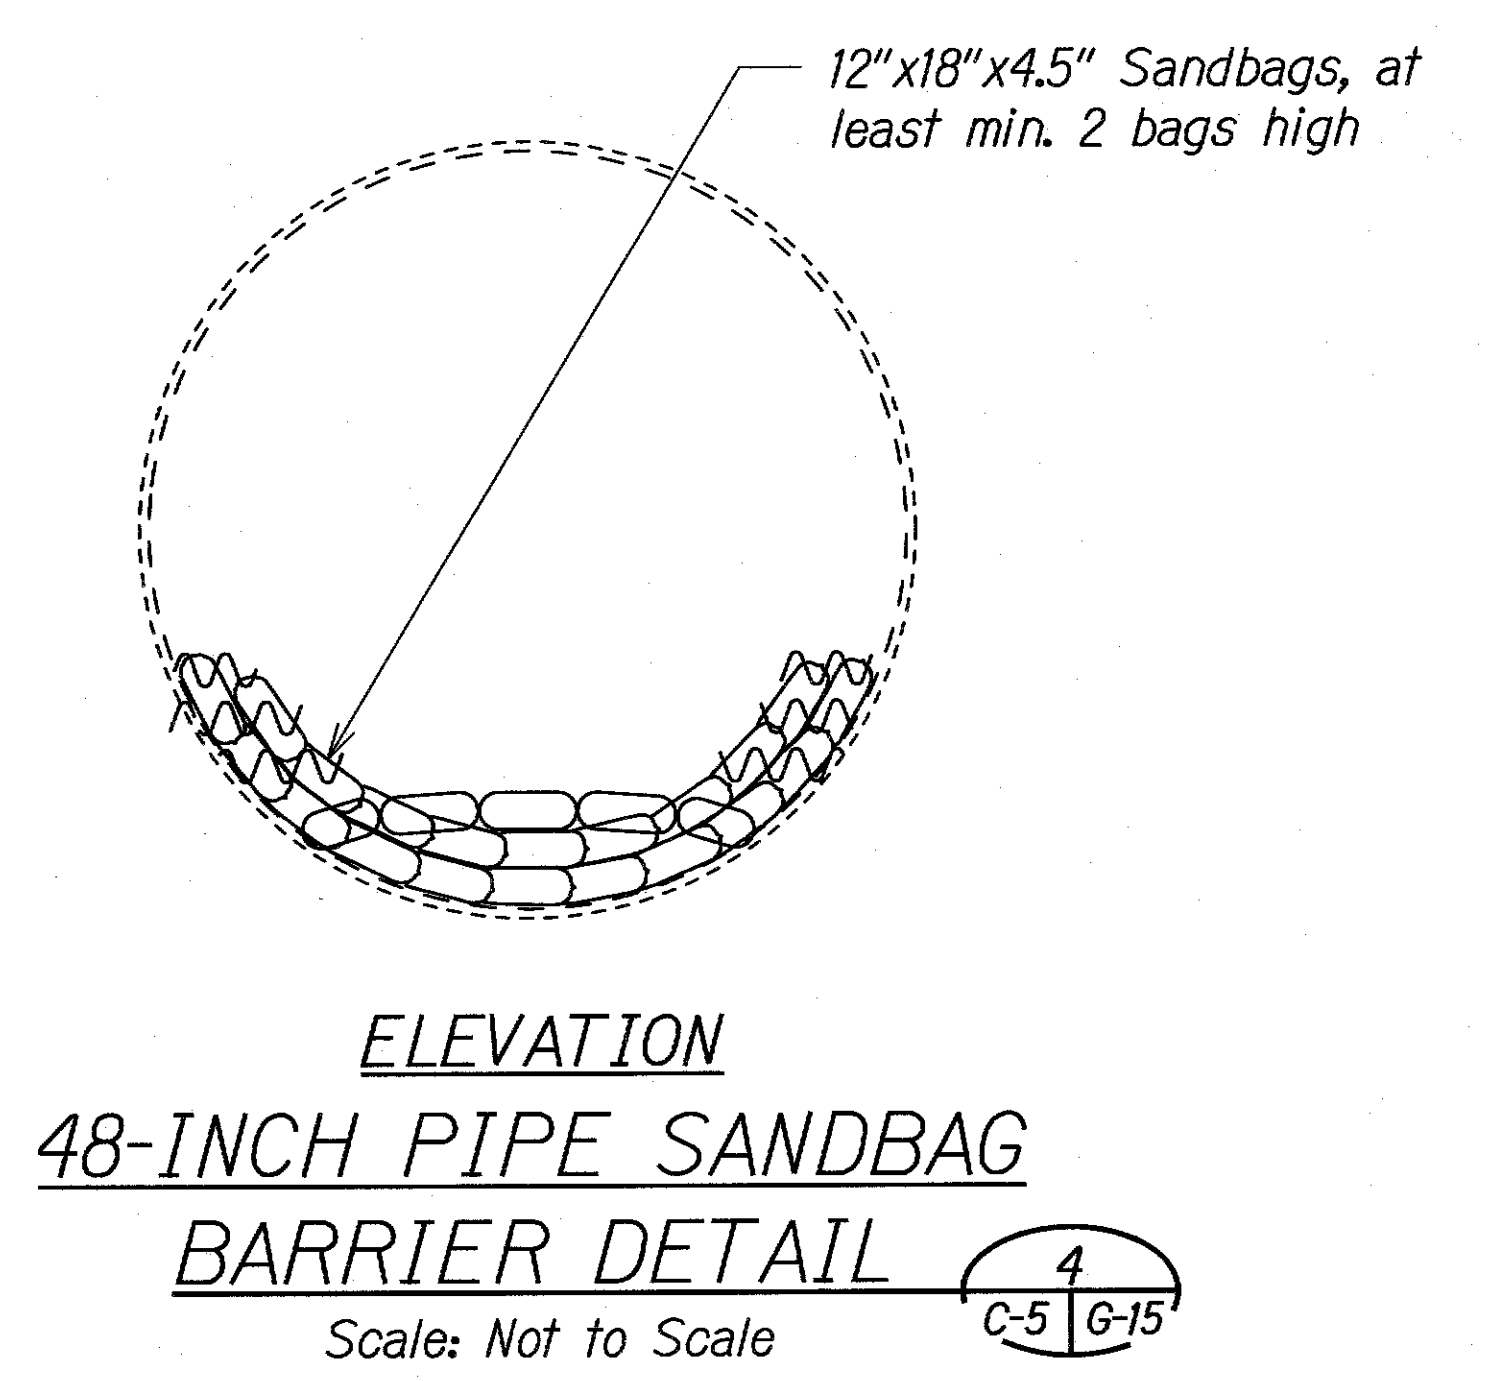
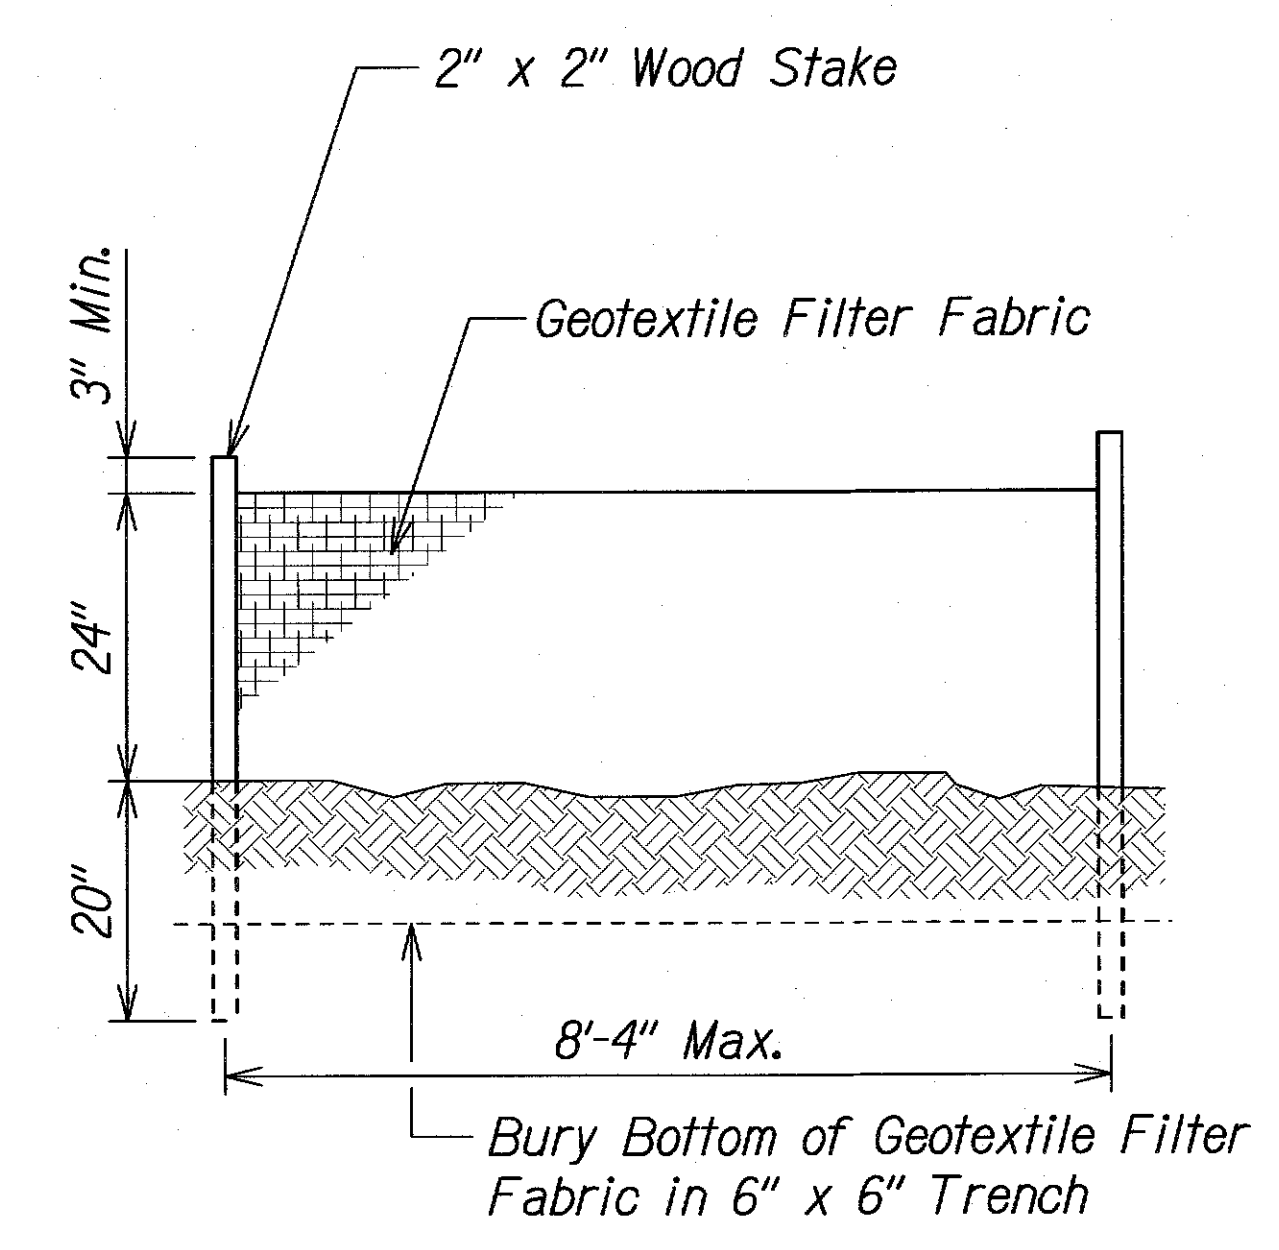


FED. ROAD DIST. NO.	STATE	FEDERAL AID PROJ. NO.	FISCAL YEAR	SHEET NO.	TOTAL SHEETS
HAWAII	HAW.	CMAQ-031-1(012)	2013	16	54

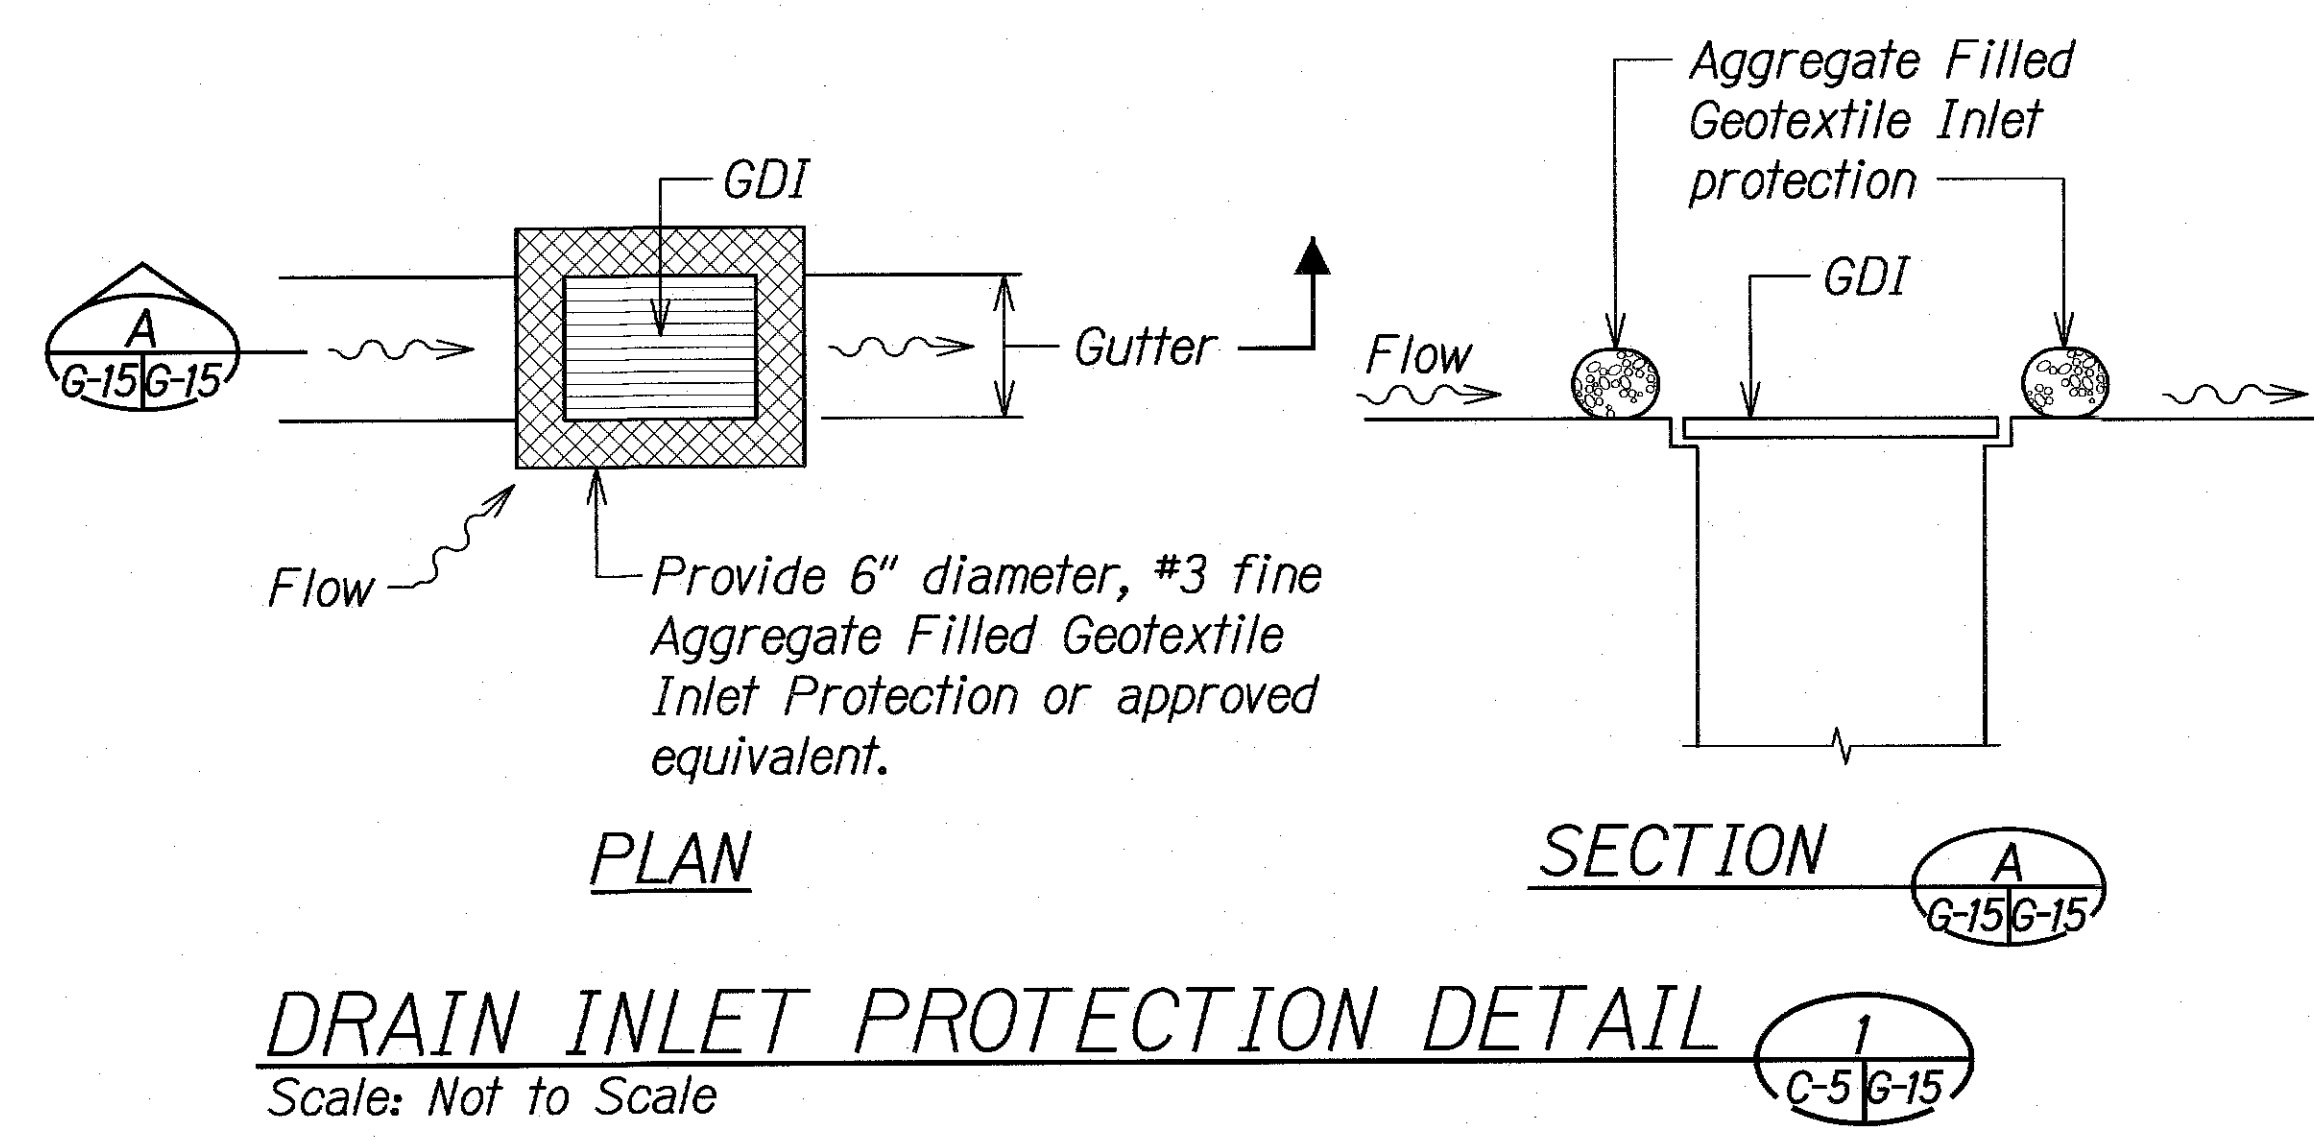

- SILT FENCE NOTES:**
- The filter fabric shall be a minimum of 36 inches wide.
 - If silt fence is obtained from manufacturer as a package (i.e. fabric attached to post) the manufacturer's installation instructions shall be adhered to.

LEGEND FOR AS-BUILT POSTINGS	
	Squiggly line for as-built deletion
	Double line for as-built deletion
Roadway	Text for as-built posting

THIS WORK WAS PREPARED BY ME OR UNDER MY SUPERVISION.
SIGNATURE: *Dexter S. Eji* EXPIRATION DATE: 04/30/14

STATE OF HAWAII
DEPARTMENT OF TRANSPORTATION
HIGHWAYS DIVISION

WATER POLLUTION & EROSION CONTROL DETAILS

PITILANI HIGHWAY
TRAFFIC OPERATION IMPROVEMENTS AT OHUKAI ROAD
FEDERAL AID PROJECT NO. CMAQ-031-1(012)
Scale: Not to Scale Date: March 2013