


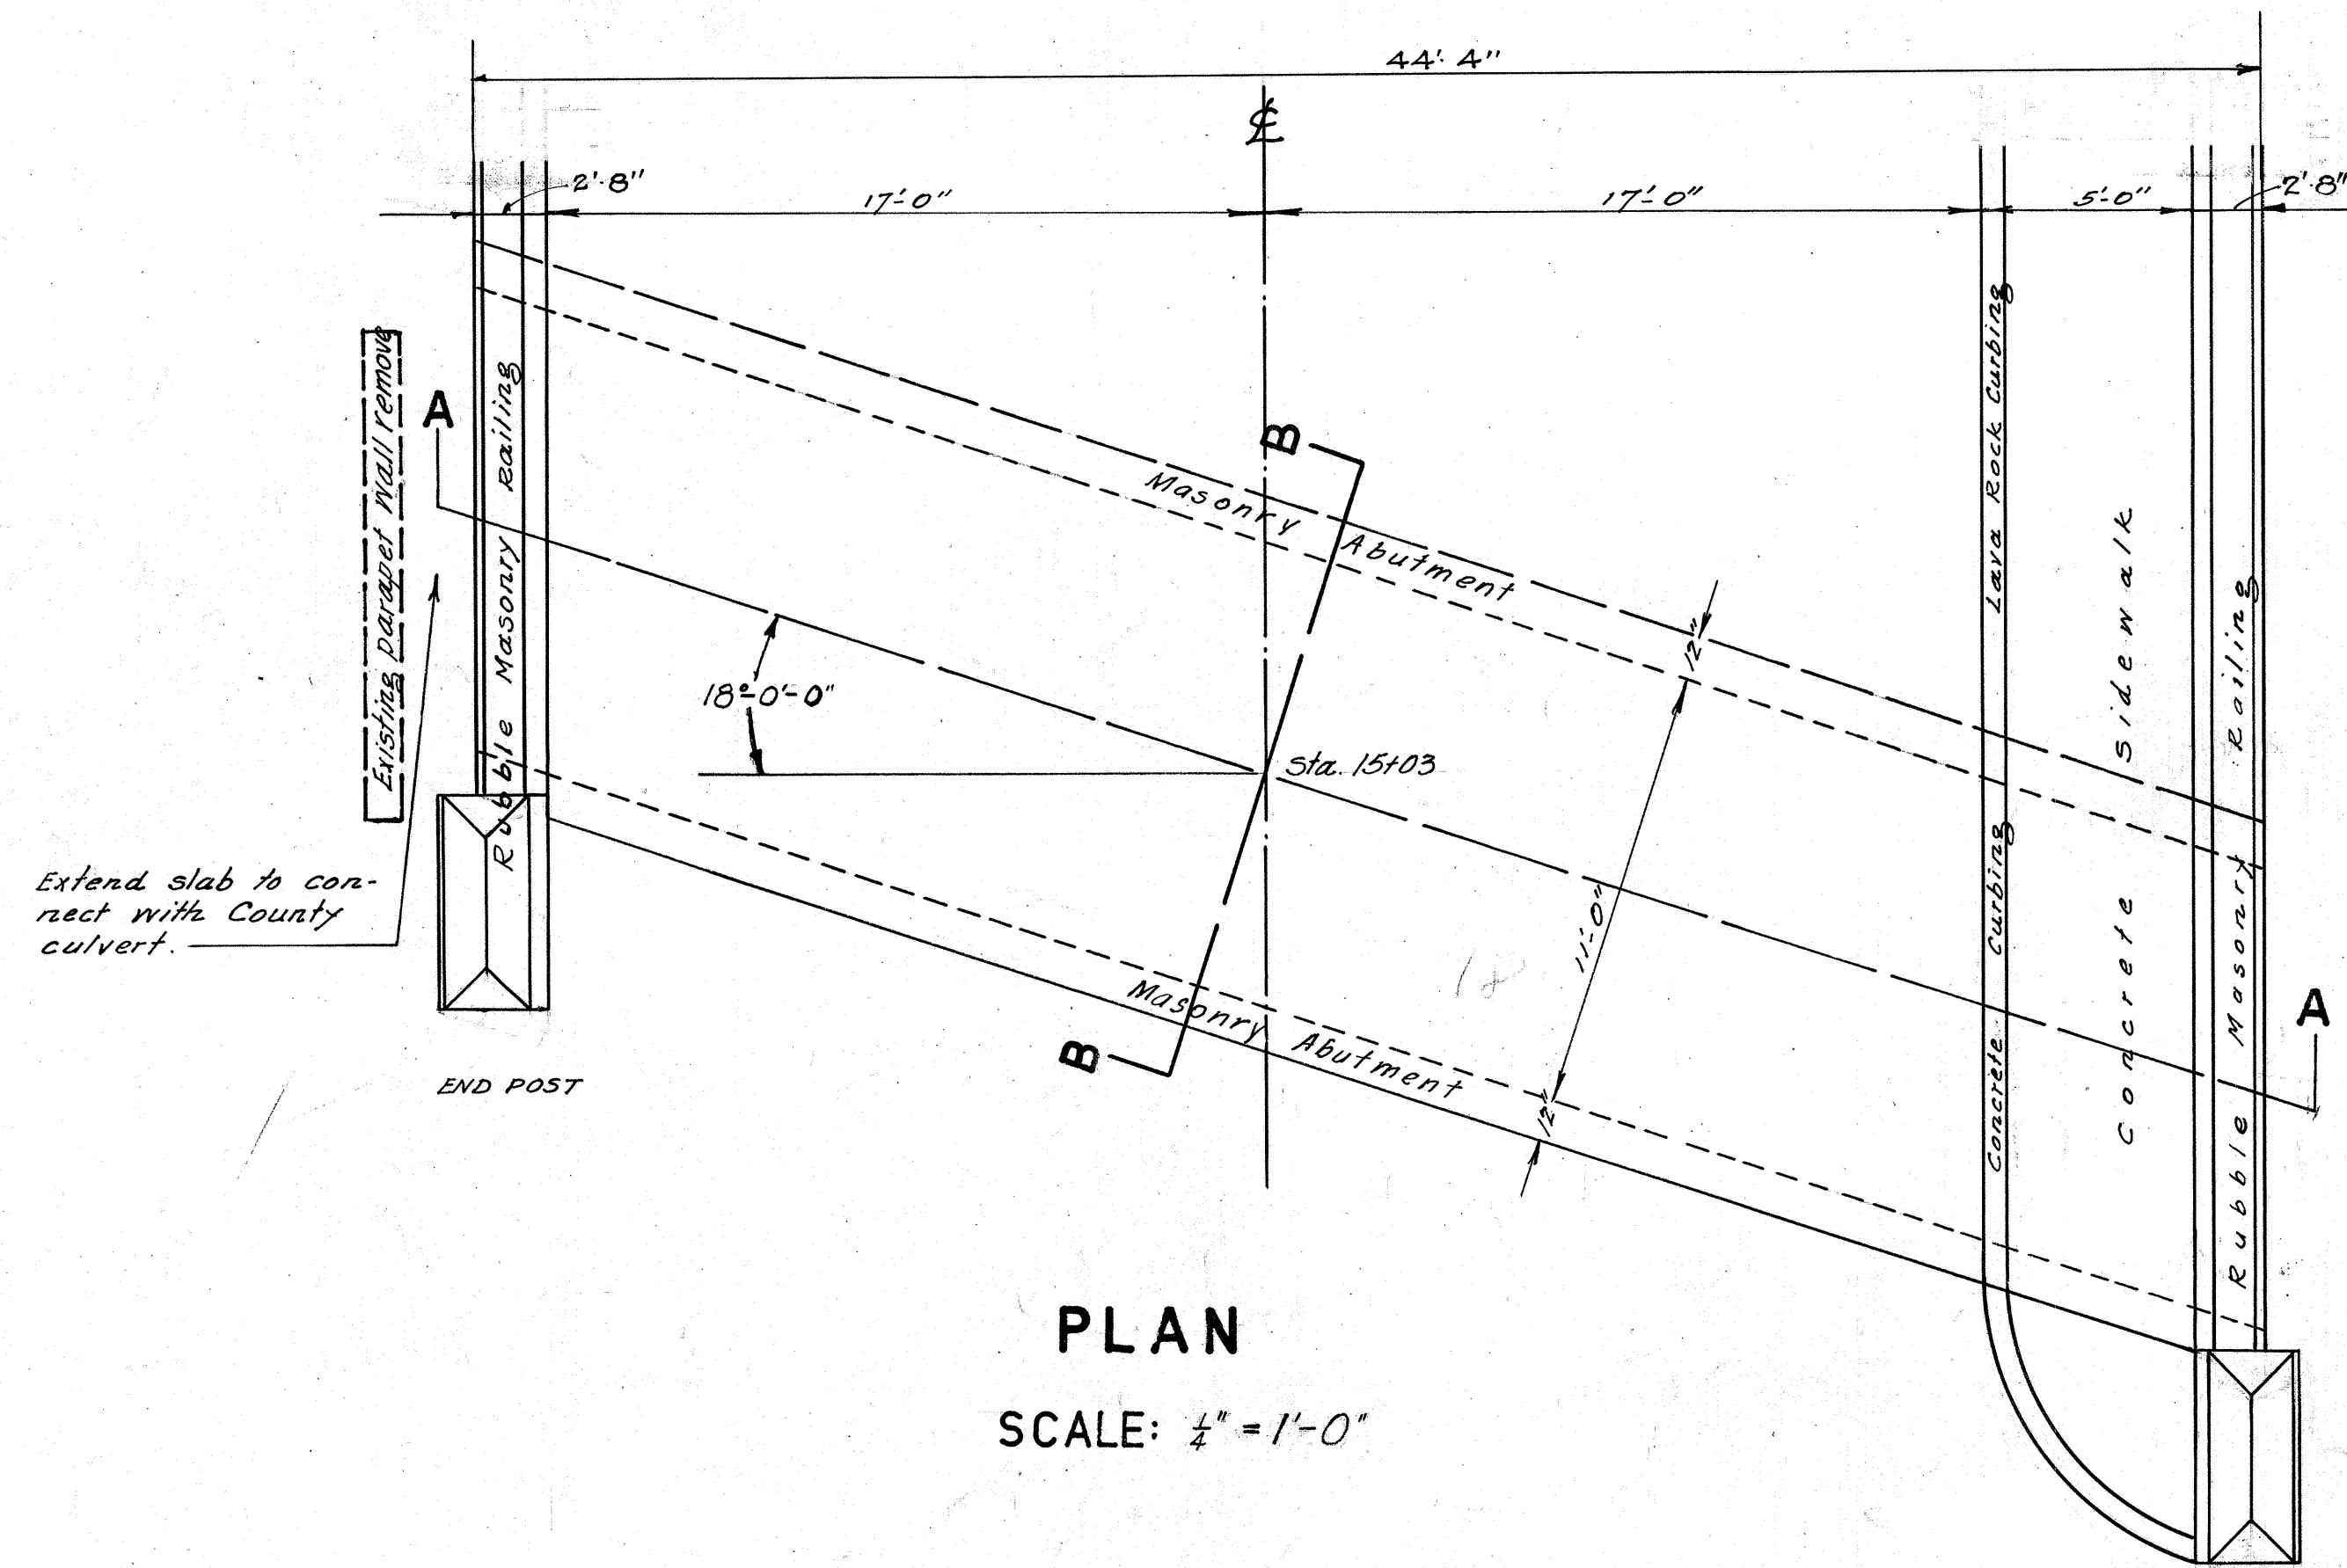
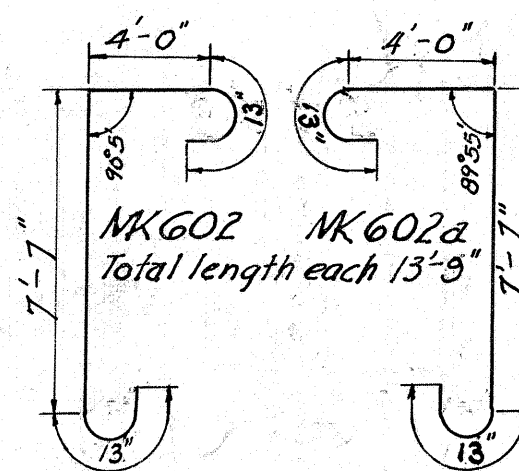
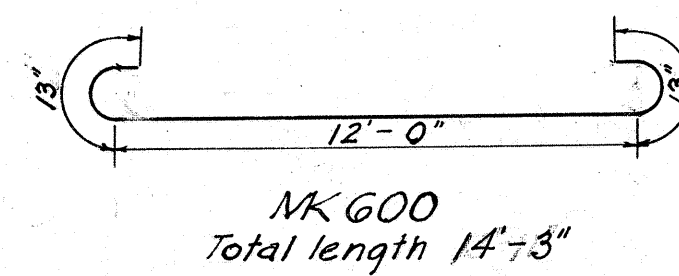


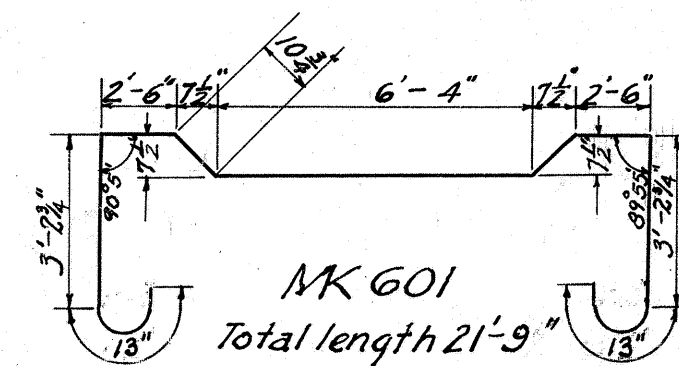



QUANTITIES		
Structural Exc.	Class "A" Conc.	Reinf. Steel
46.3 Cu.Yds	61 Cu.Yds.	7,234 lbs

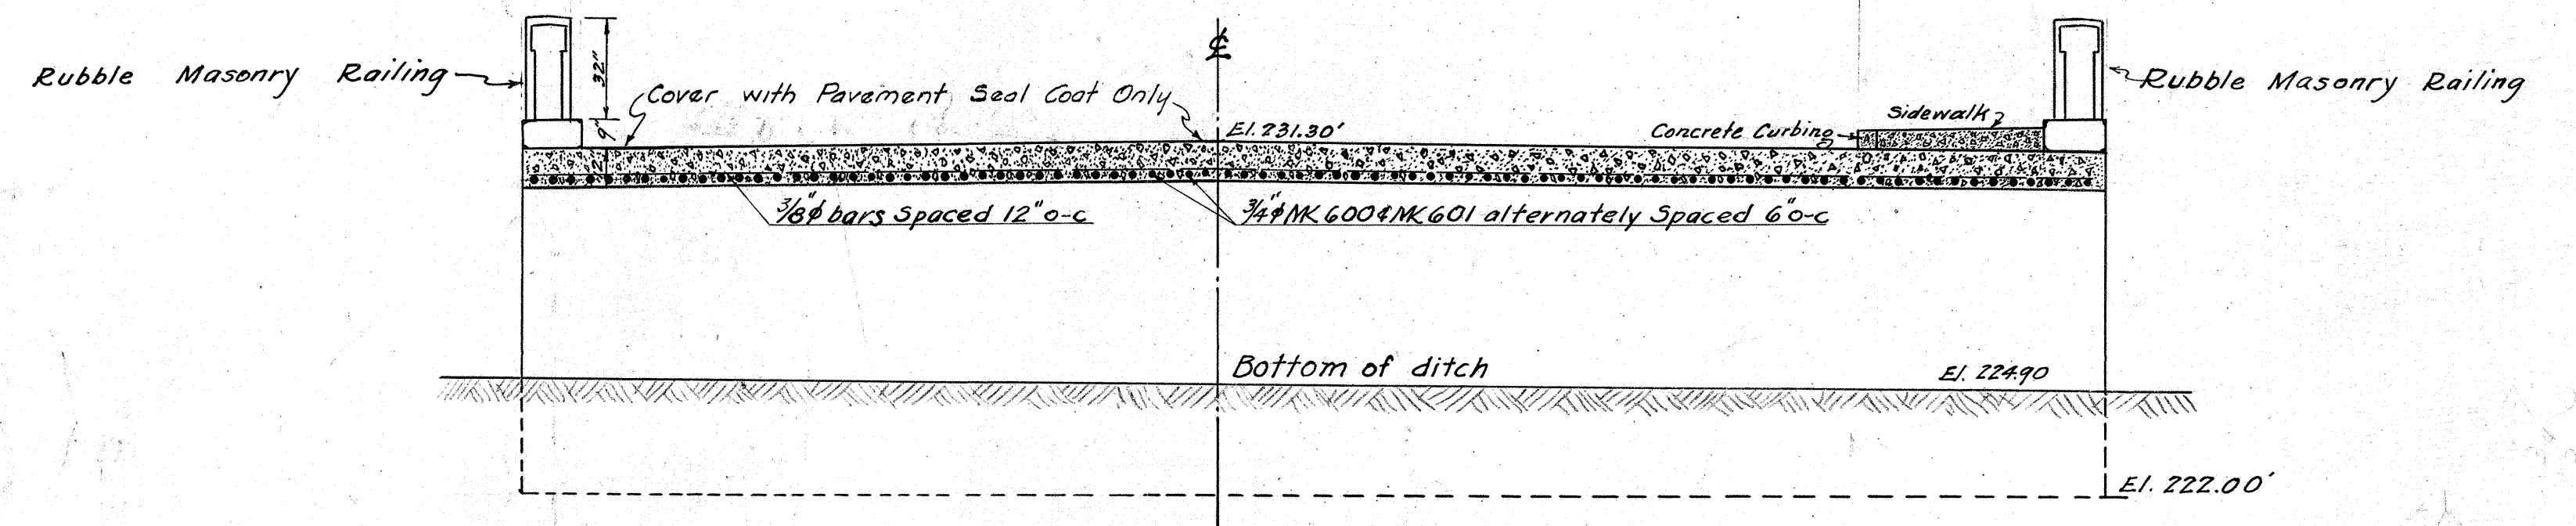

Caps of all Posts, End Posts and Railing to match as to color and to be Brush-Hammered, finished to exact size.

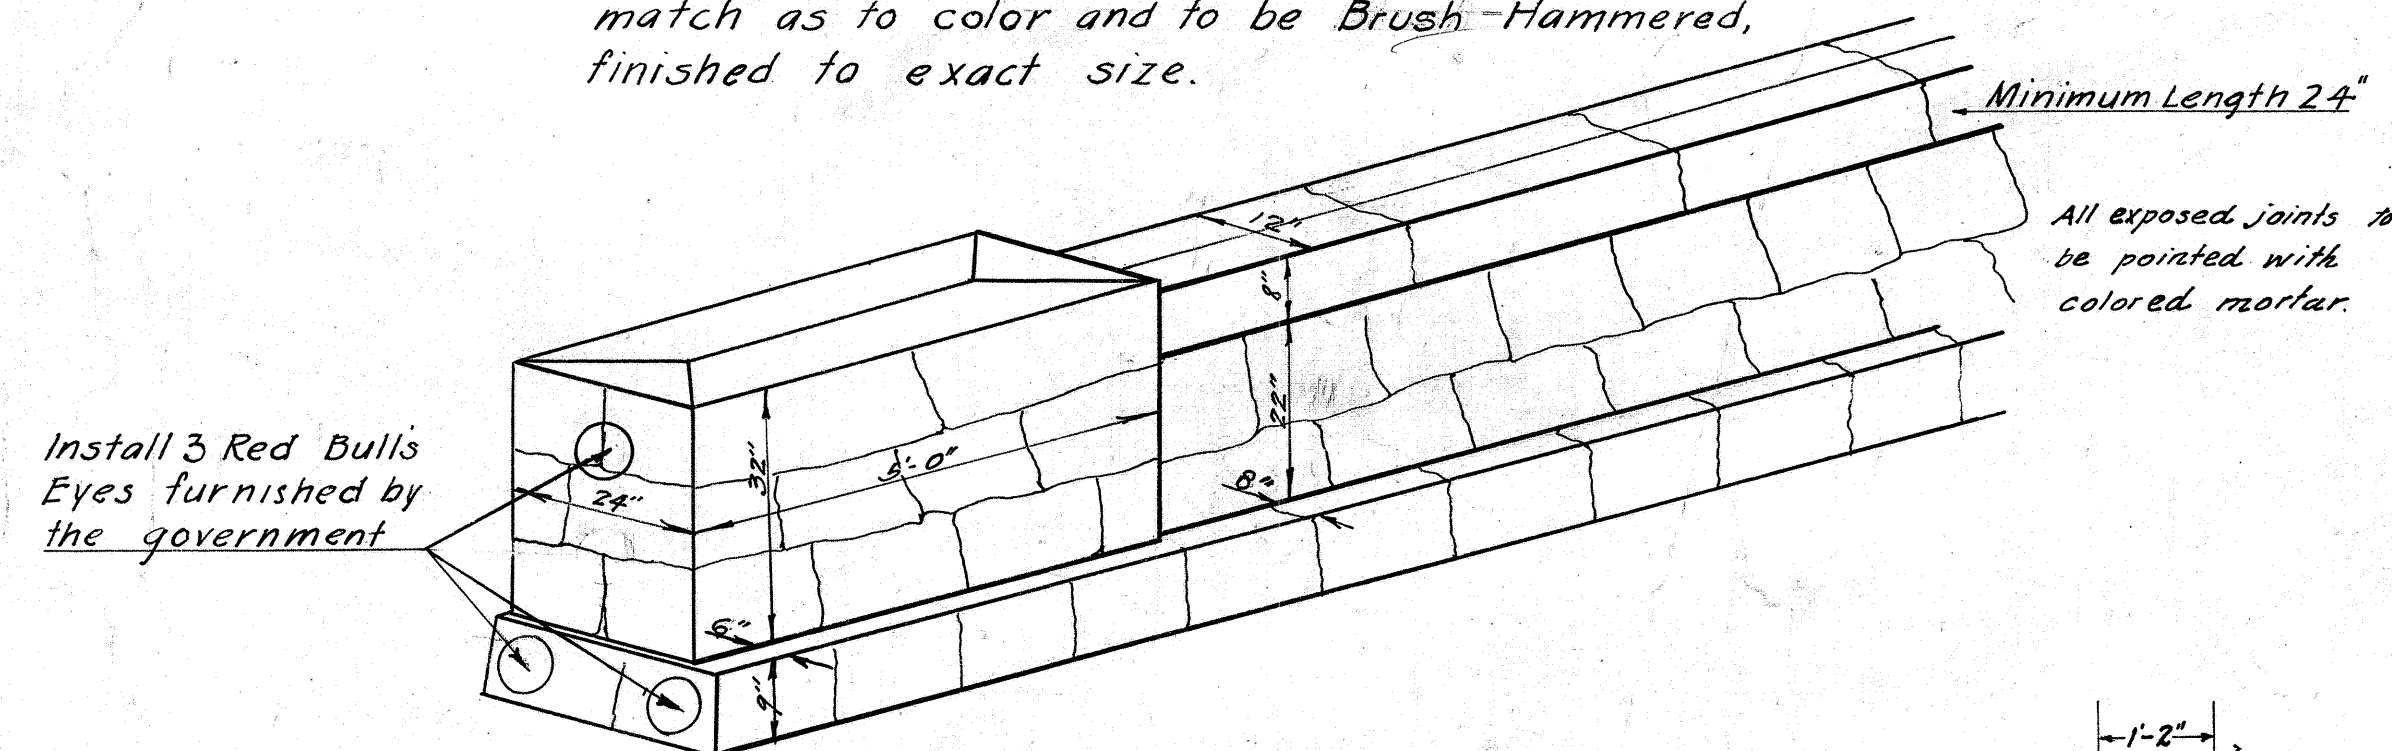

Flow of water in ditch varies from 6 inches to 3 feet and must not be interrupted during construction.

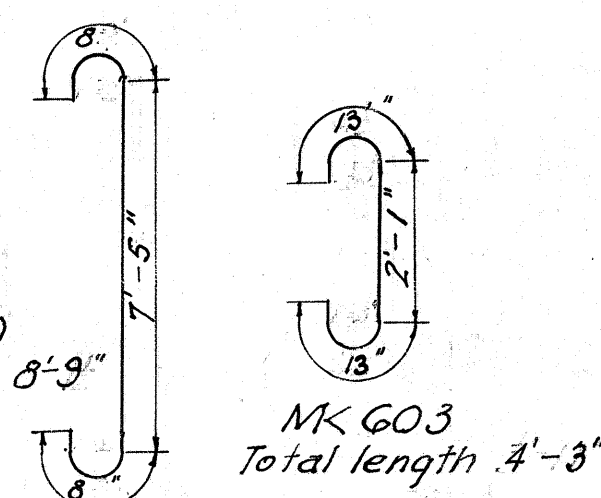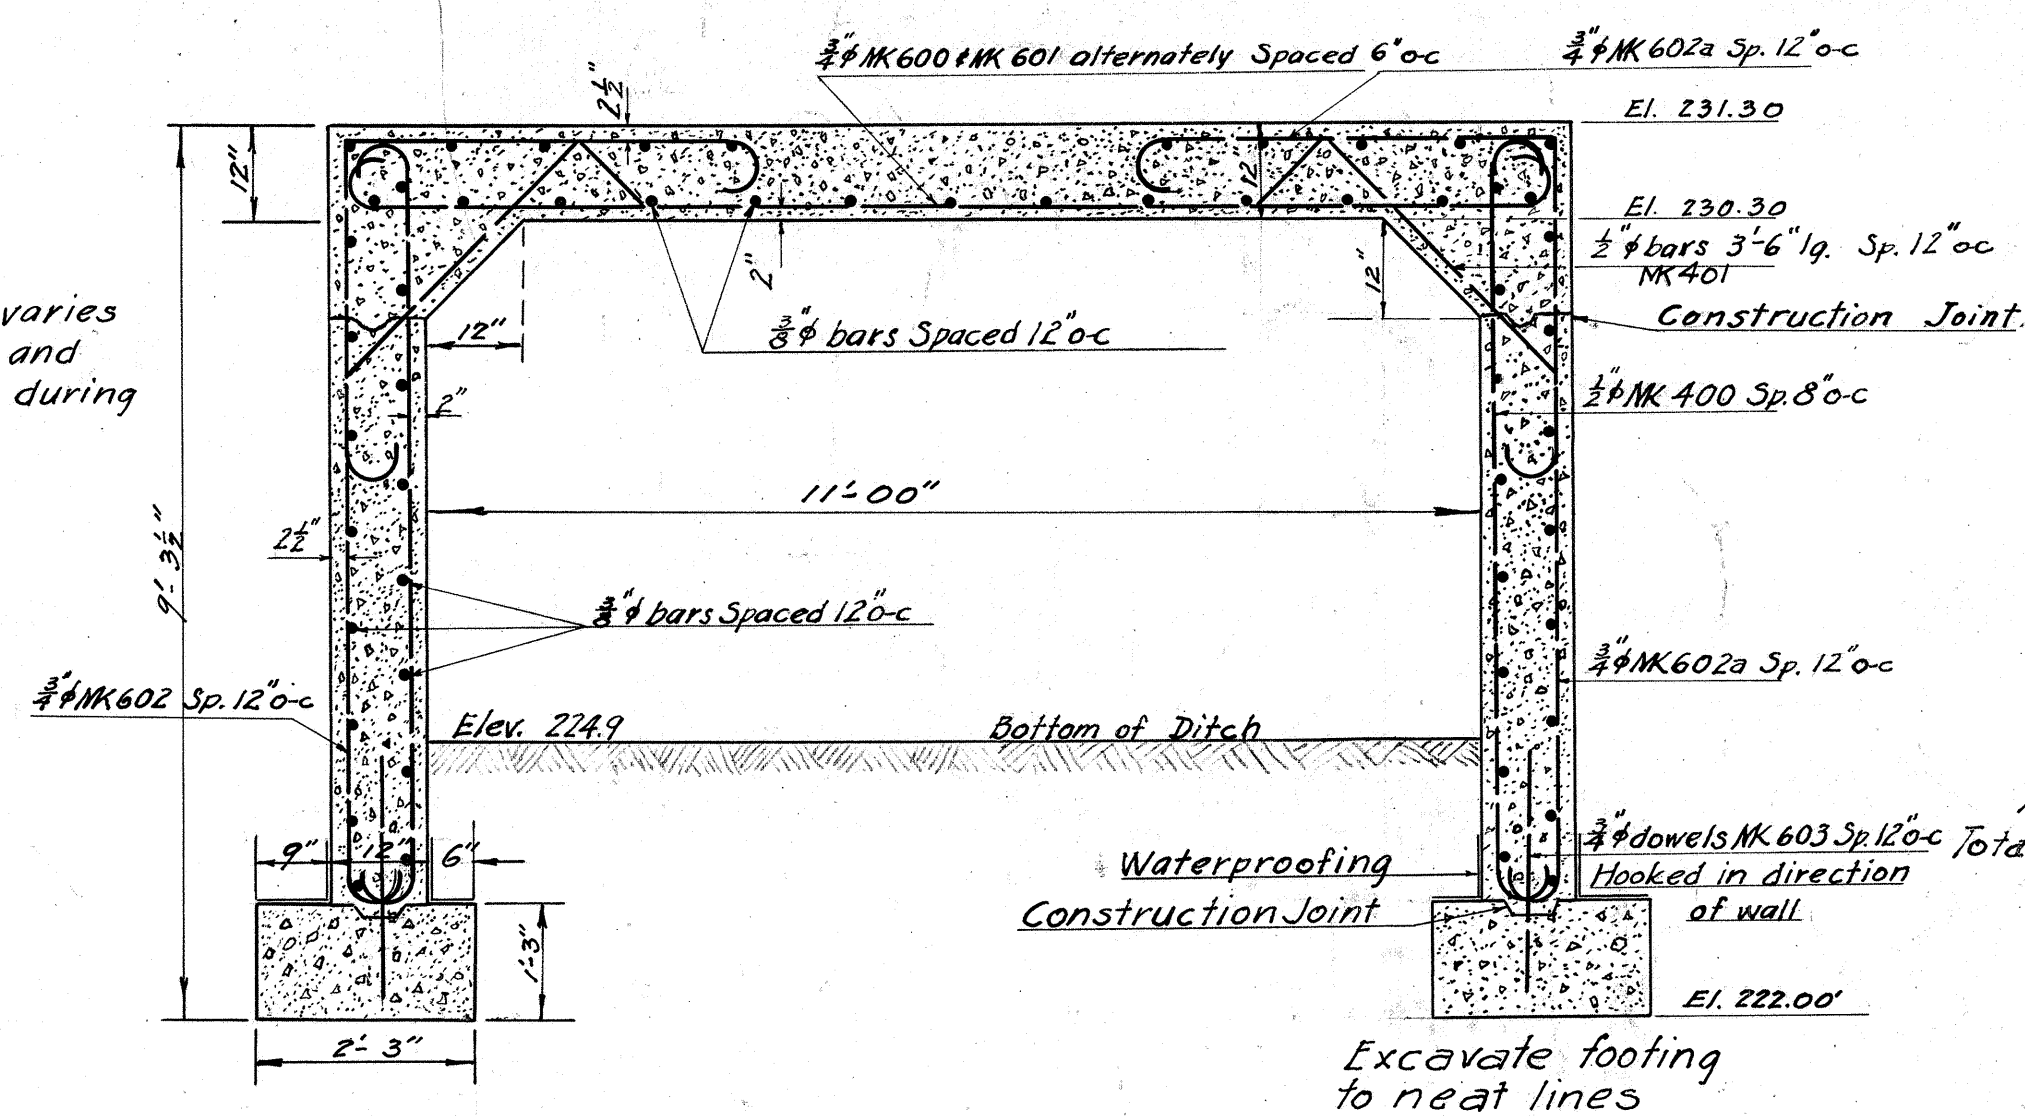

SPRECKELS DITCH CULVERT

STATION 15+03

