
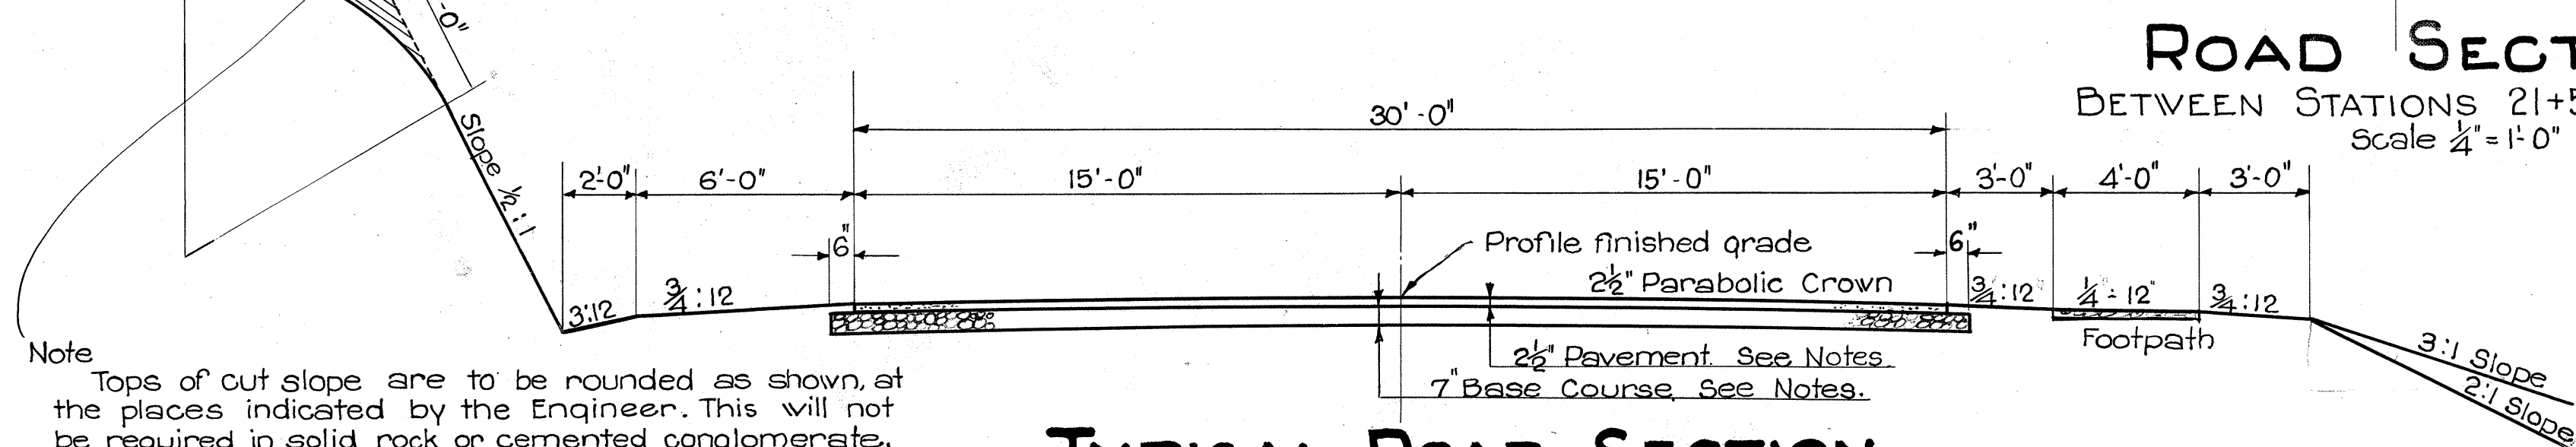


FED. ROAD DIST. NO.	STATE	FED. AID PROJ. NO.	FISCAL YEAR	SHEET NO.	TOTAL SHEETS
HAWAII	HAW.	W.P.M. 1335	1935	2	14
FED. ROAD DIST. NO.	STATE	FED. AID PROJ. NO.	FISCAL YEAR	SHEET NO.	TOTAL SHEETS
HAWAII	HAW.	W.P.M. 1335	1935	3	27

THIS ROAD SECTION SUPERCEDED
SEE SHEET 4348.7A FOR DETAILS.

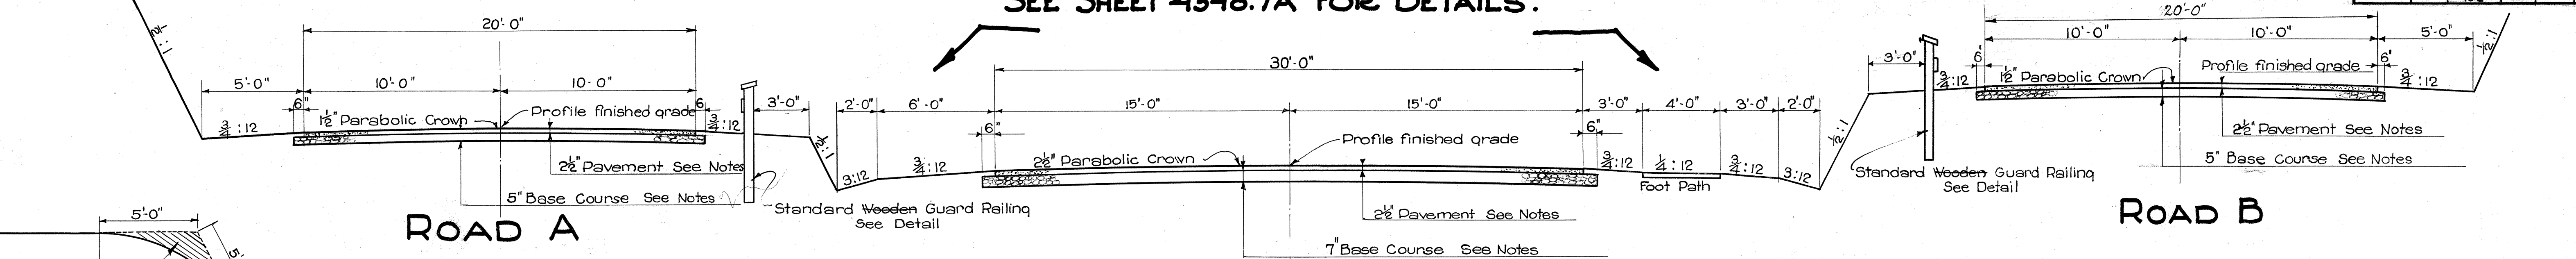







BASE COURSE & PAVEMENT NOTES

BASE COURSE: Broken stone base course of 3 inch, 5 inch or 7 inch compacted thickness, as required in details, consists of mineral aggregate (12% wear).

PAVEMENT: Bituminous macadam pavement: 2 1/2 inch compacted thickness as follows; 2 1/2 inch compacted thickness of 12 lbs per sq. yd. of Bituminous binder; approx. 0.012 cu. yd. per sq. yd. of Keystone (1' to 1/2") between 3 to 4 lbs per sq. yd. of Bituminous binder; approx. 0.005 Cu. yd. per sq. yd. of pea gravel (1/4 to 3/8).

BITUMINOUS TREATED FOOTPATH SURFACING: 3 inch compacted layer of broken stone base course with a bituminous surface treatment.

GENERAL NOTES: Particular reference is made to the specification covering these items of work.

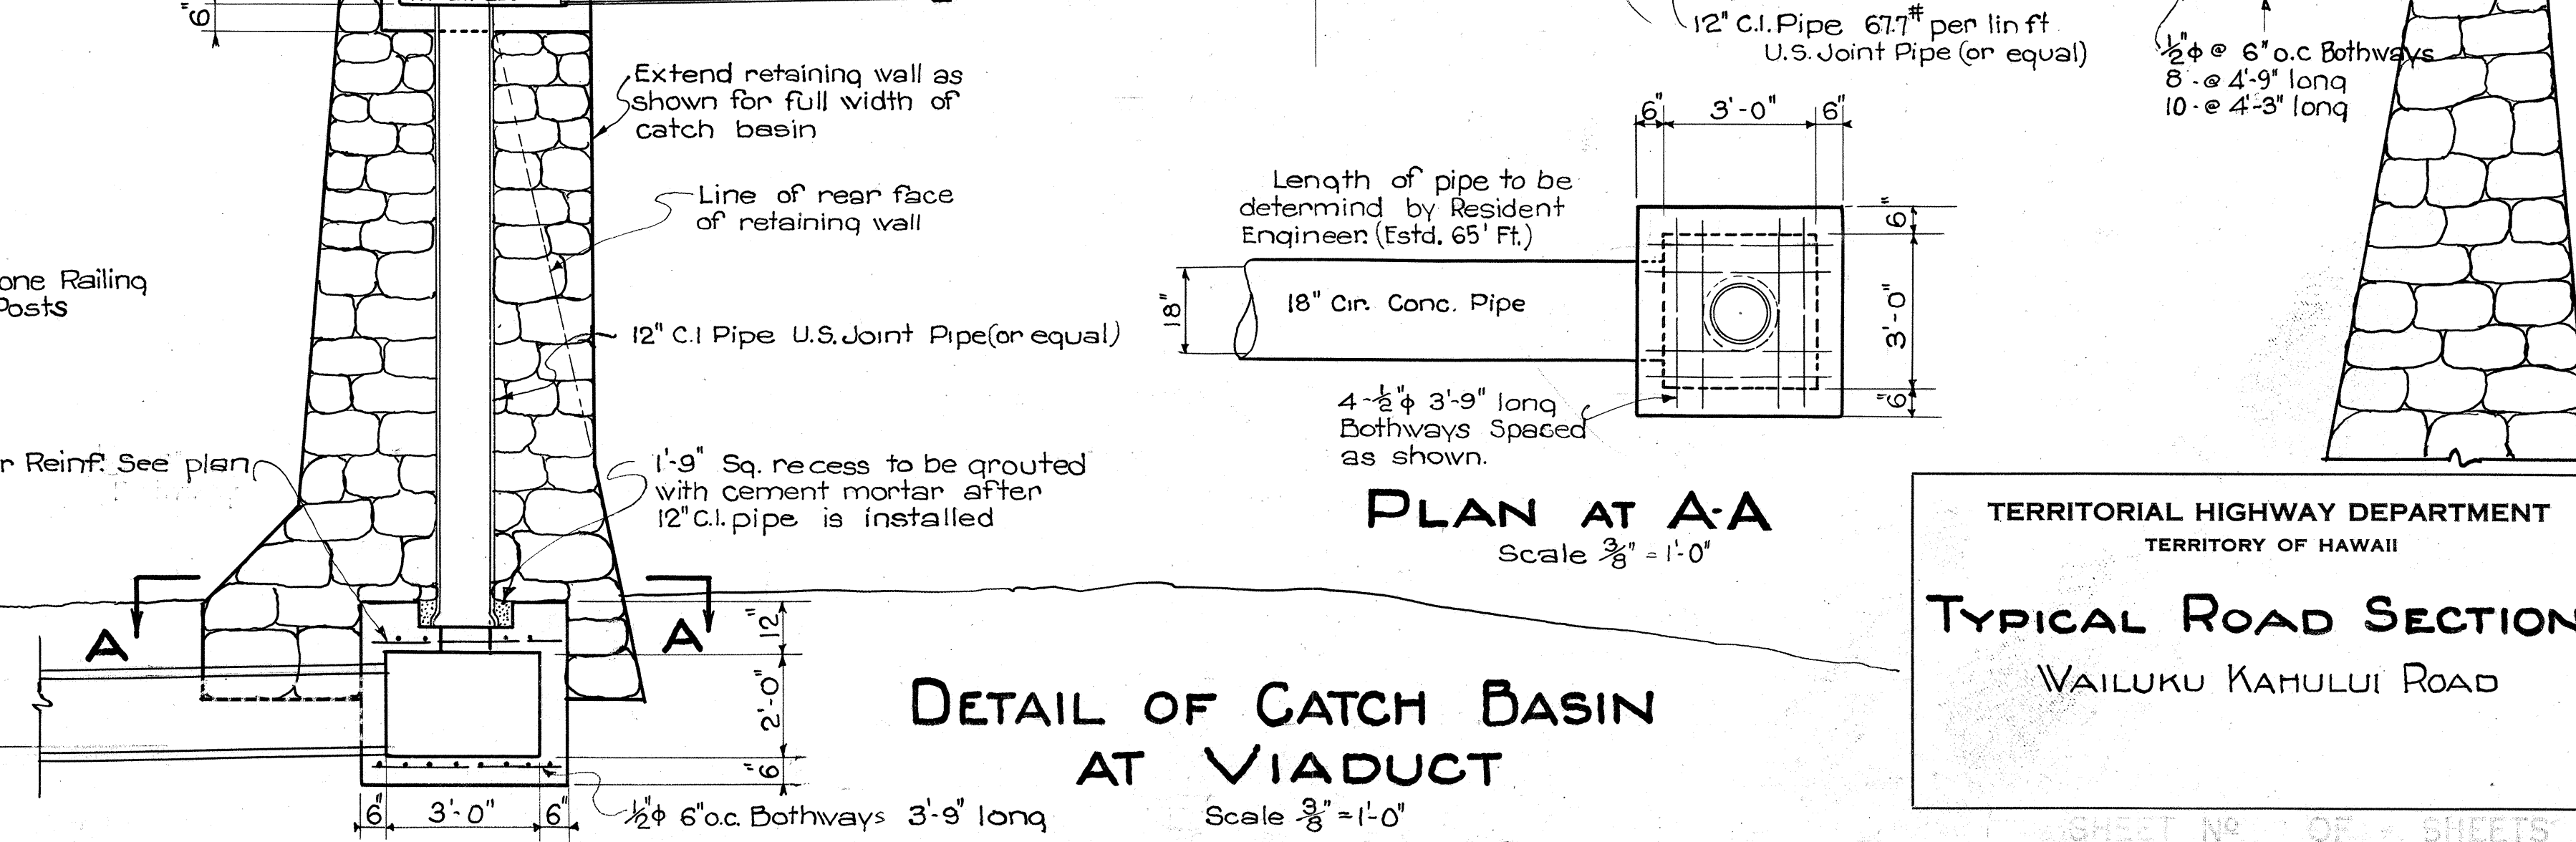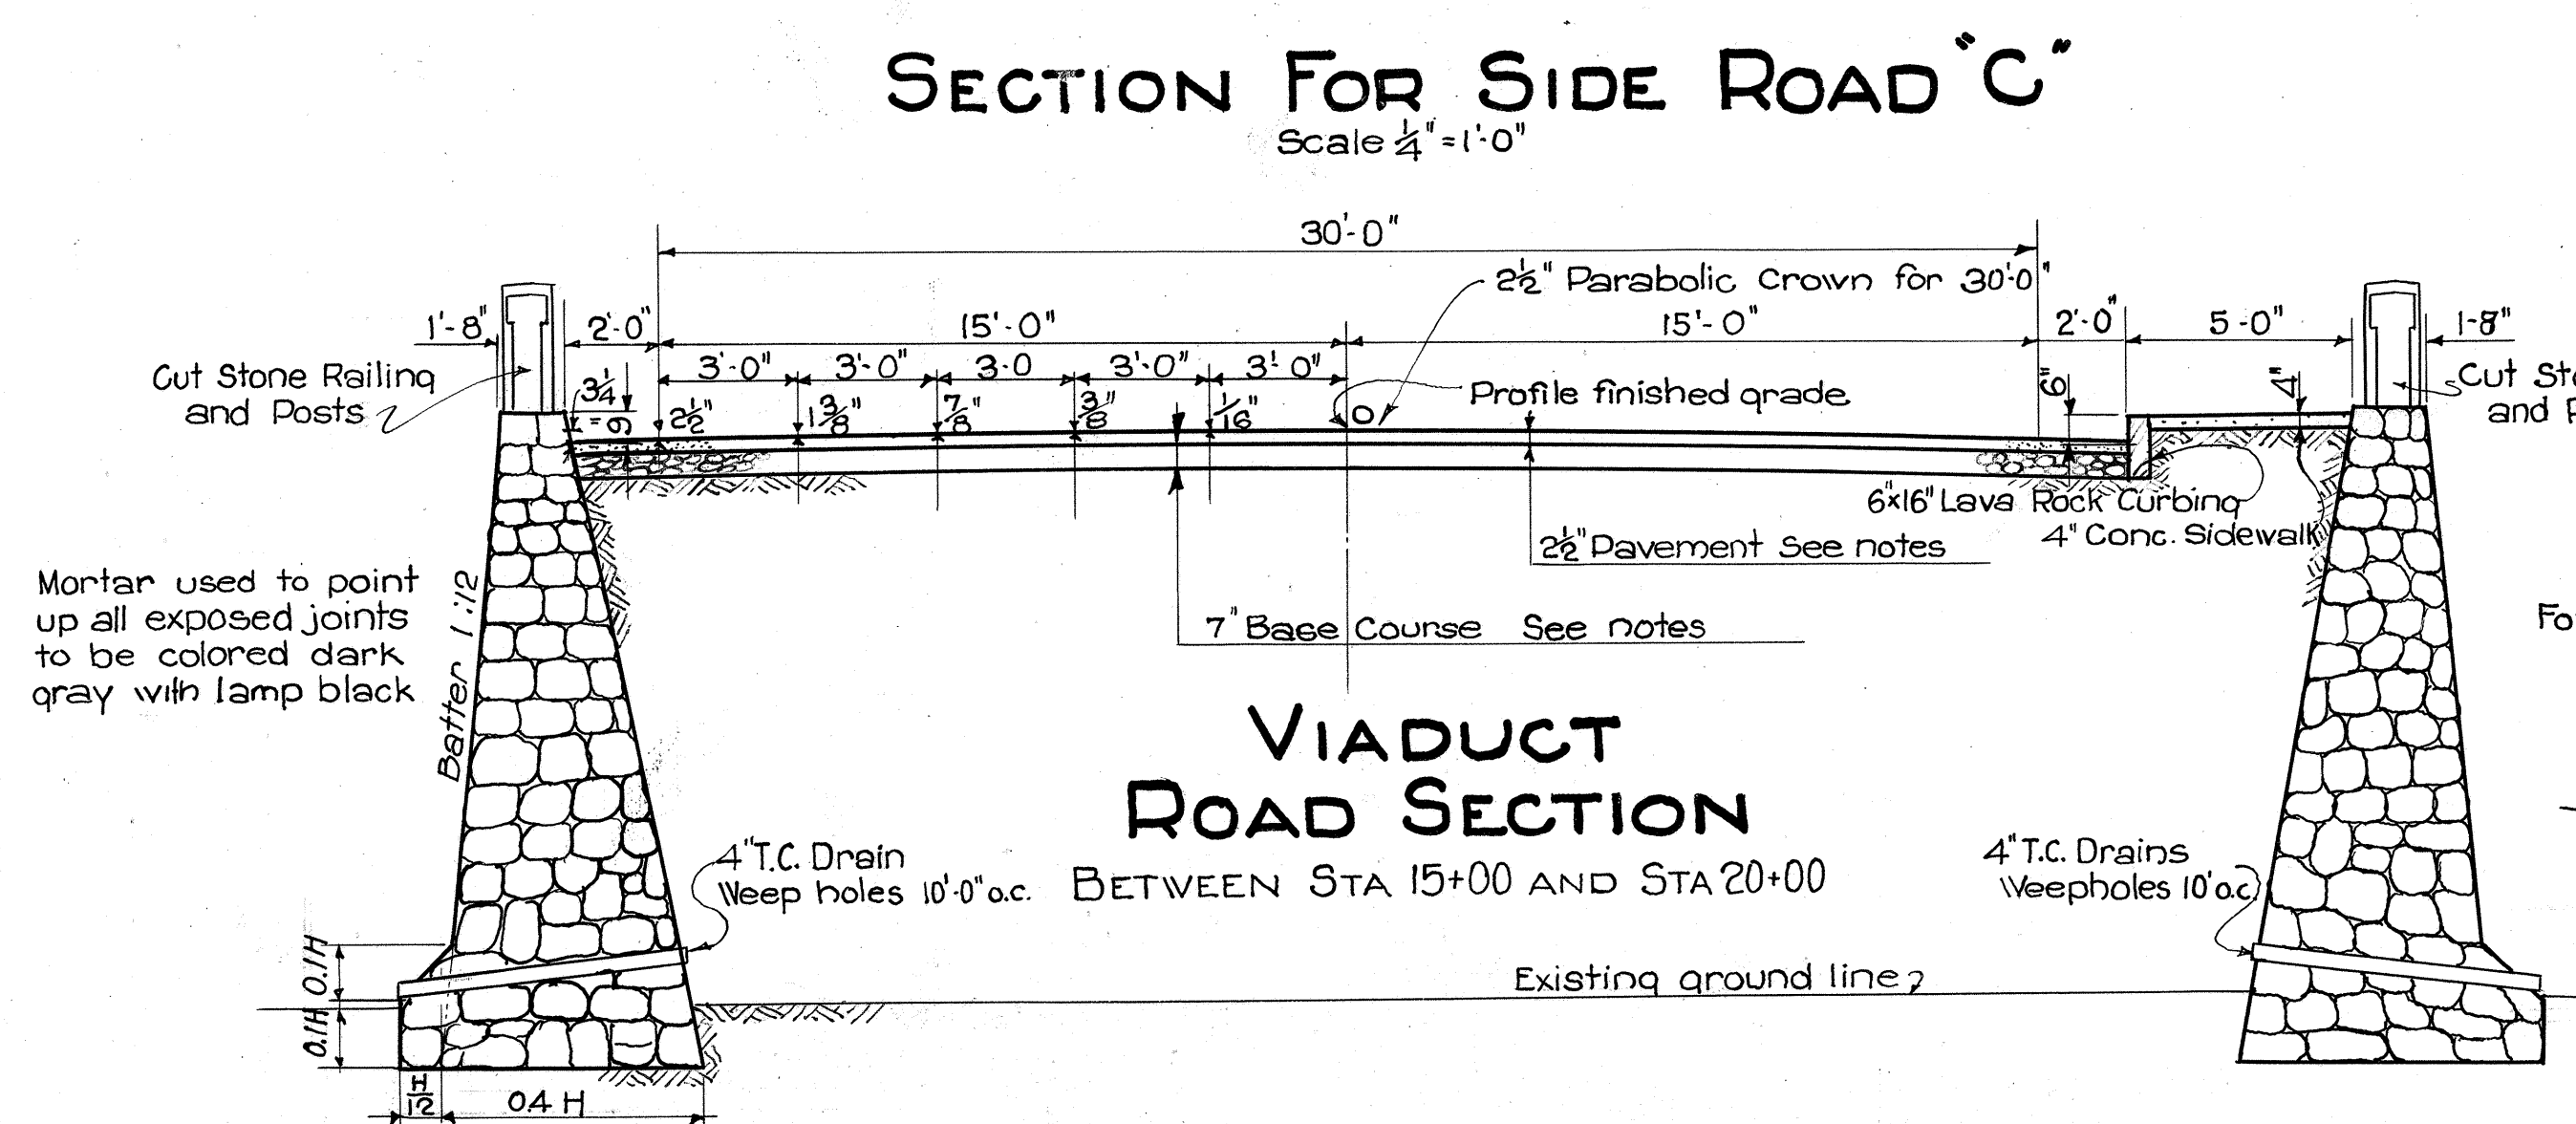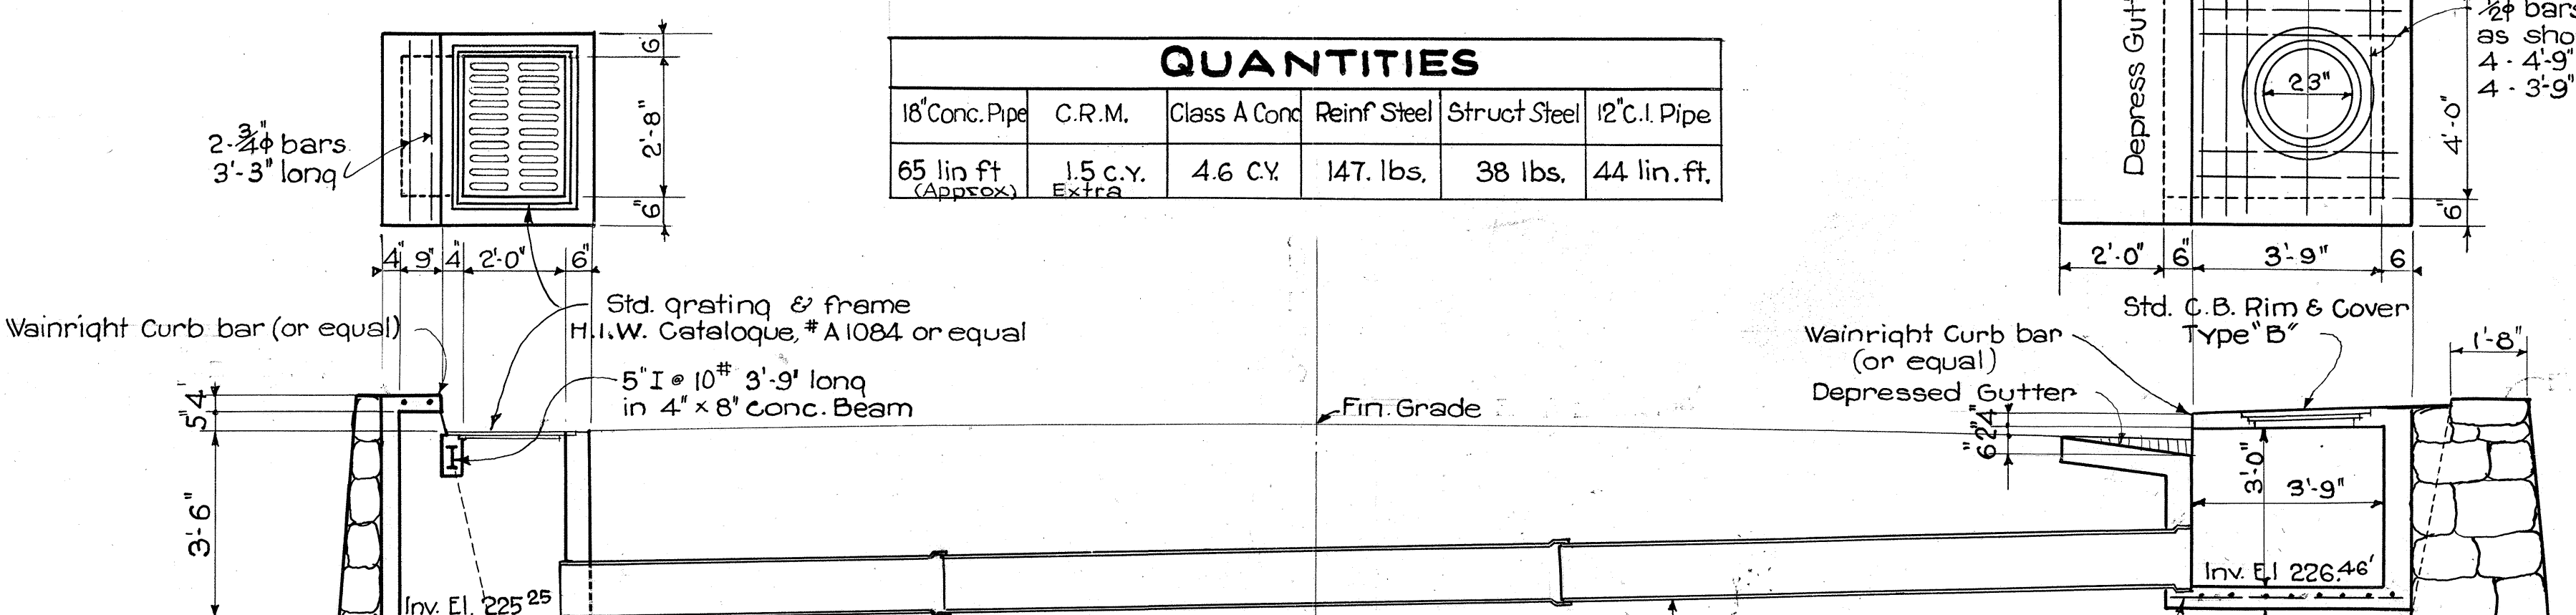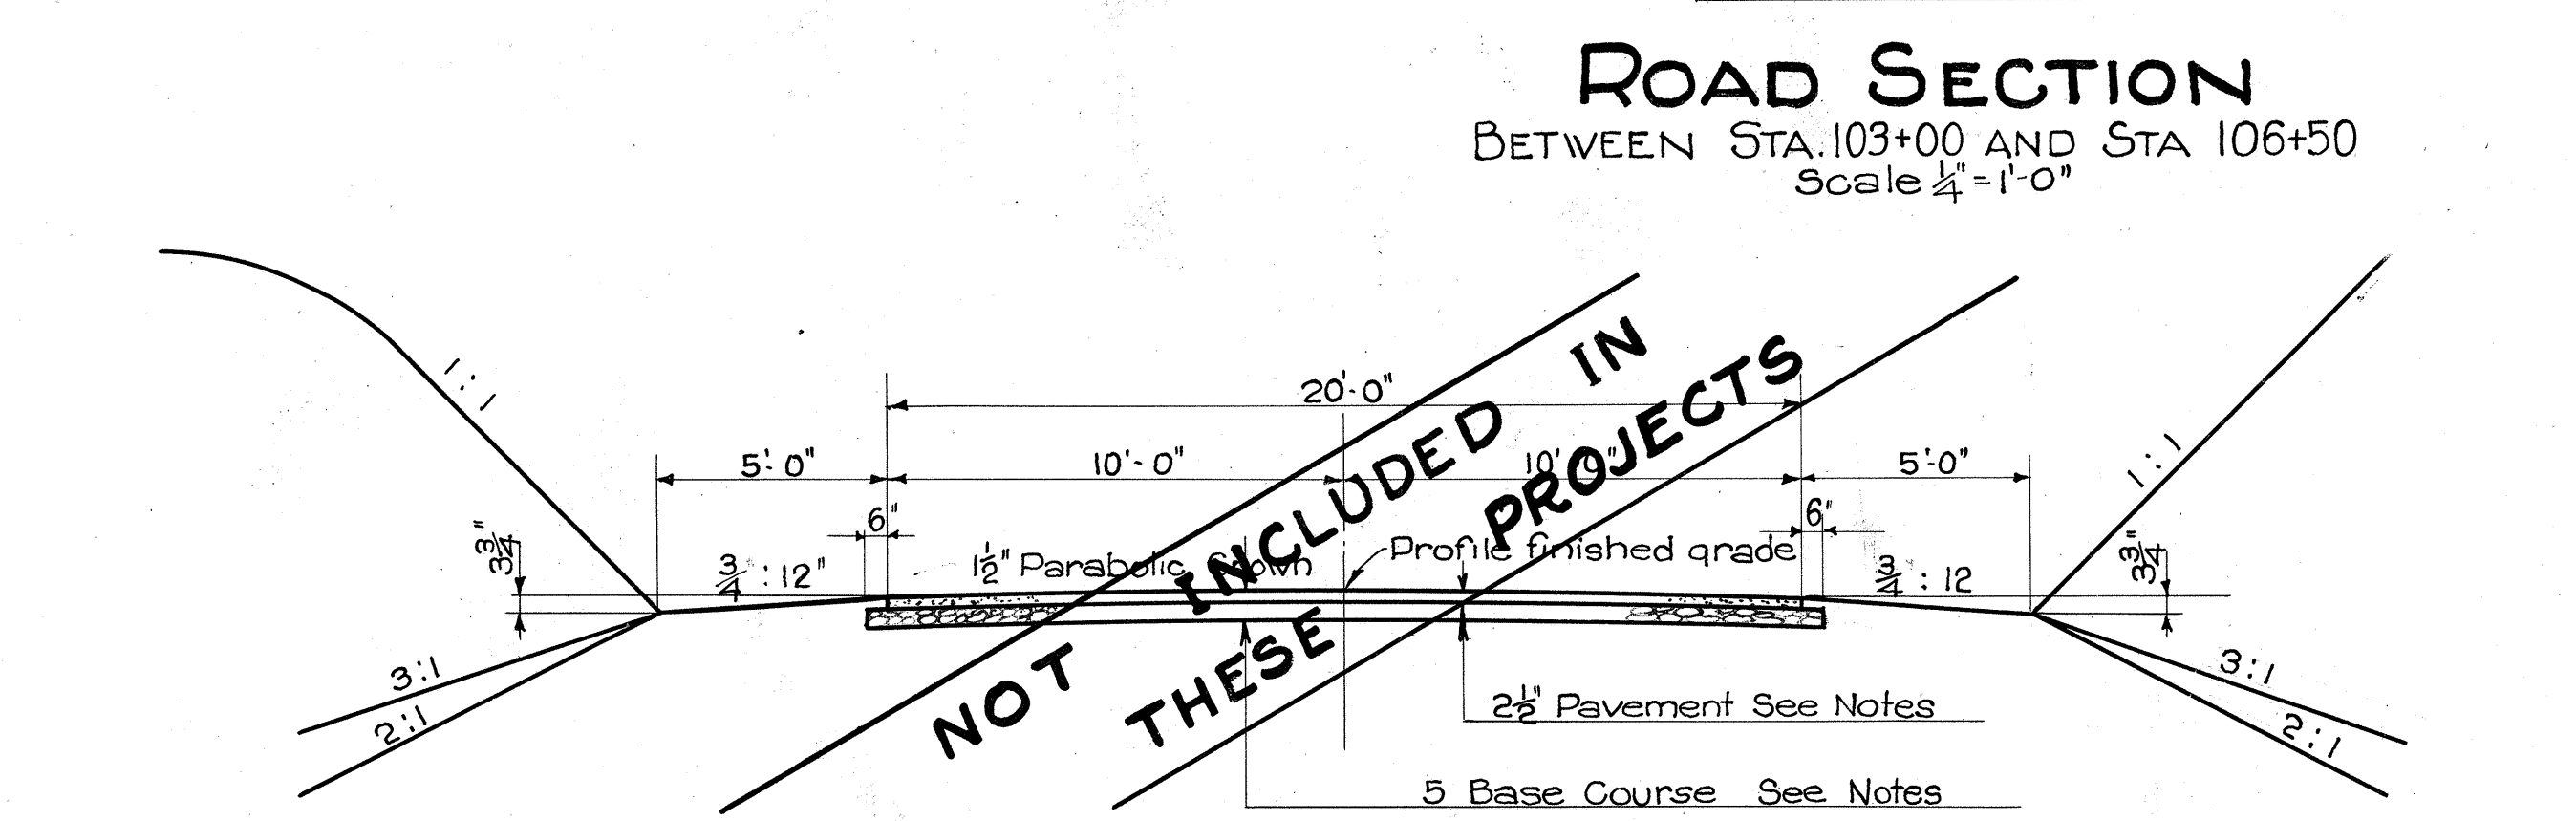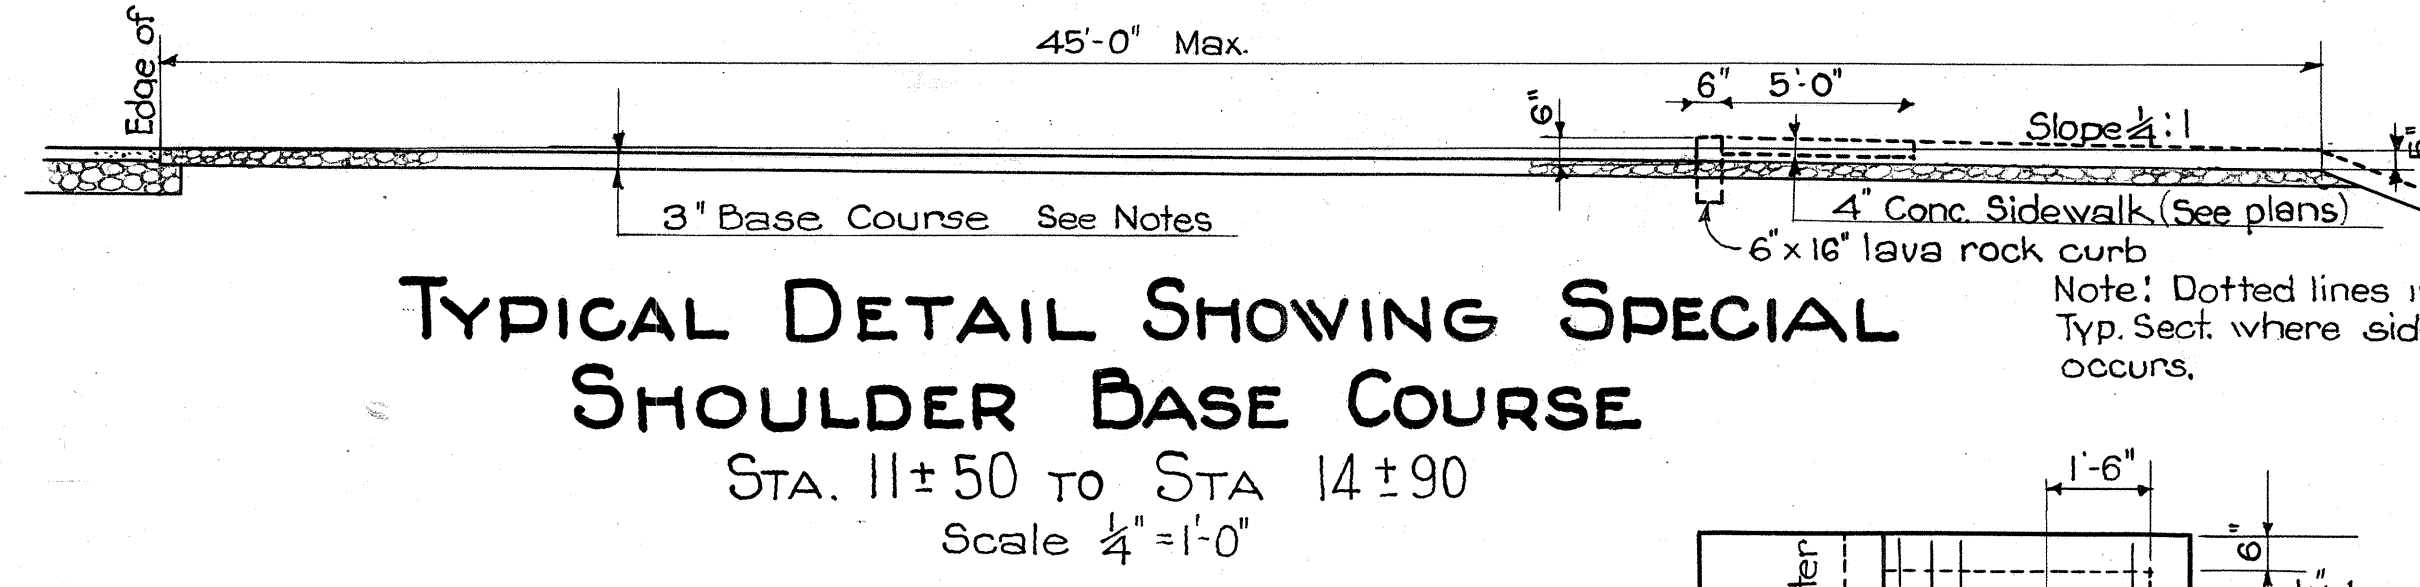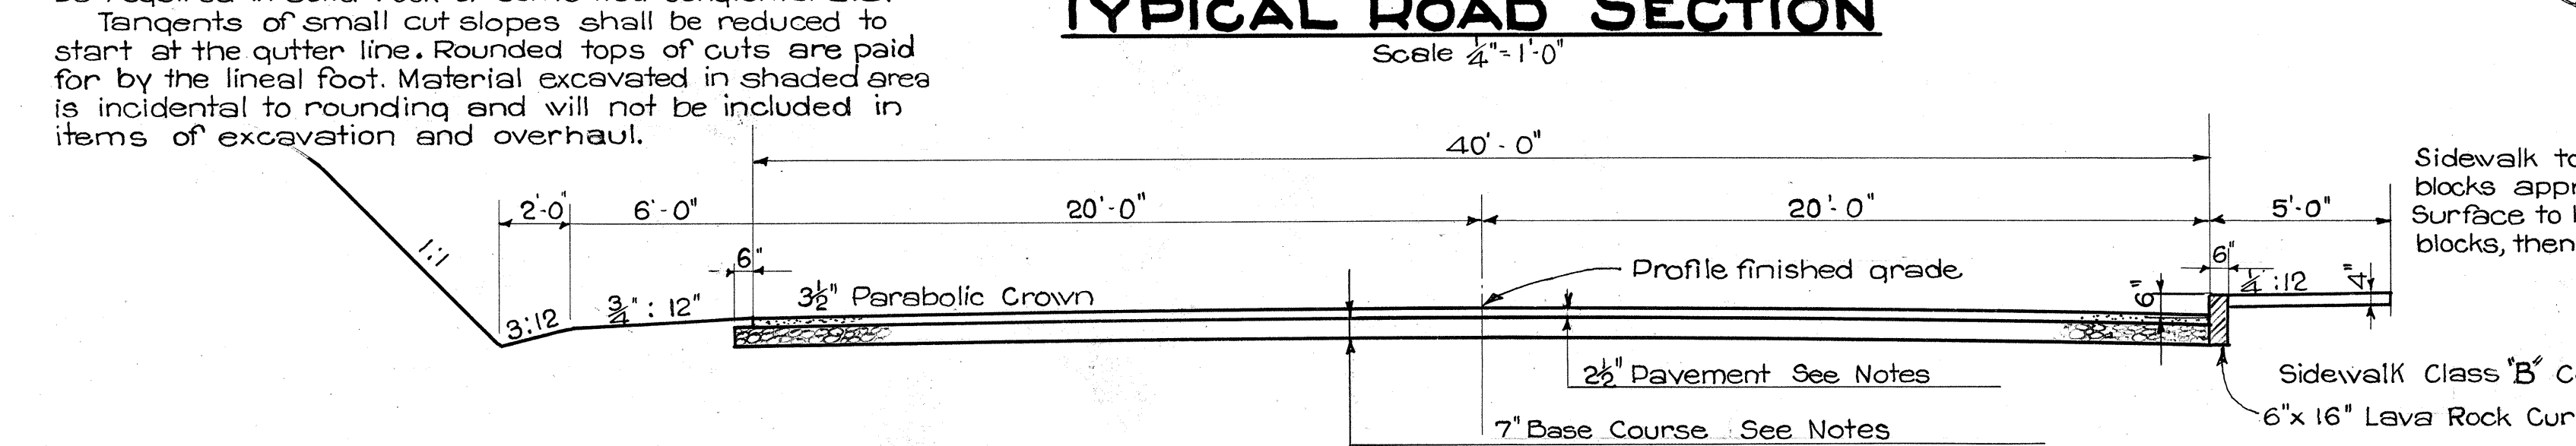

QUANTITIES					
18" Conc. Pipe	C.R.M.	Class A Conc.	Reinf. Steel	Struct. Steel	12" C.I. Pipe
65 lin. ft. (Approx.)	1.5 c.y. Extra	4.6 C.Y.	147. lbs.	38 lbs.	44 lin. ft.

TERRITORIAL HIGHWAY DEPARTMENT
TERRITORY OF HAWAII
TYPICAL ROAD SECTIONS
WAILUKU KAHULUI ROAD

DETAIL OF CATCH BASIN
AT VIADUCT
Scale 3/8" = 1'-0"