

FED. ROAD DIST. No.	STATE	FED. AID PROJ. No.	FISCAL YEAR	SHEET No.	TOTAL SHEETS
HAWAII	HAW.	F-032(2)	1955	22	27

(40)

S-0340(1) Break Line
F-032(2)

Exc. = 78.7 78.7
Emb. = 41.7 46.3

STA. 3+00

C=45.4 49
F=20.4 25

C=2
F=12

C=75.4 77
F=40.4 35

Exc. = 115.7 116.7
Emb. = 78.7 74.1

STA. 5+50

C=40.4 36
F=25.4 25

Exc. = 69.4 70.4
Emb. = 47.2 55.6

STA. 2+50

C=0
F=10

C=50.4 49
F=45.4 45

Exc. = 95.4 99.1
Emb. = 86.1 86.1

STA. 5+00

C=35.4 40
F=20.4 35

Exc. = 76.9 82.4
Emb. = 25.0 33.3

STA. 2+00

C=48.4 49
F=14.4 1

Exc. = 113.9 110.2
Emb. = 69.4 74.1

STA. 4+50

C=53.4 58
F=40.4 48

Exc. = 72.2 84.3
Emb. = 11.1 9.3

STA. 1+50

C=30.4 42
F=11.4 9

Exc. = 103.7 92.6
Emb. = 85.2 91.7

STA. 4+00

C=70.4 61
F=37.4 32

Exc. = 74.1 82.4
Emb. = 23.1 21.3

STA. 1+00

C=50.4 47
F=14.4 14

BEG. PROJECT F032(2) P.T. STA. 3+85.21

C=42.4 39
F=65.4 67

Exc. = 30.9 29.0
Emb. = 8.6 8.6

STA. 0+50

Exc. = 80.6 81.5
Emb. = 78.7 85.2

STA. 3+50


C=0
F=0

STA. 0+16.68

DATE	BY	FINAL SURVEY	PLOTTED	NOTED	NO.

DATE	BY	ORIGINAL SURVEY	PLOTTED	NOTED	NO.

FED. ROAD DIST. No.	STATE	FED. AID PROJ. No.	FISCAL YEAR	SHEET No.	TOTAL SHEETS
HAWAII	HAW.	F-032(2)	1955	23	27

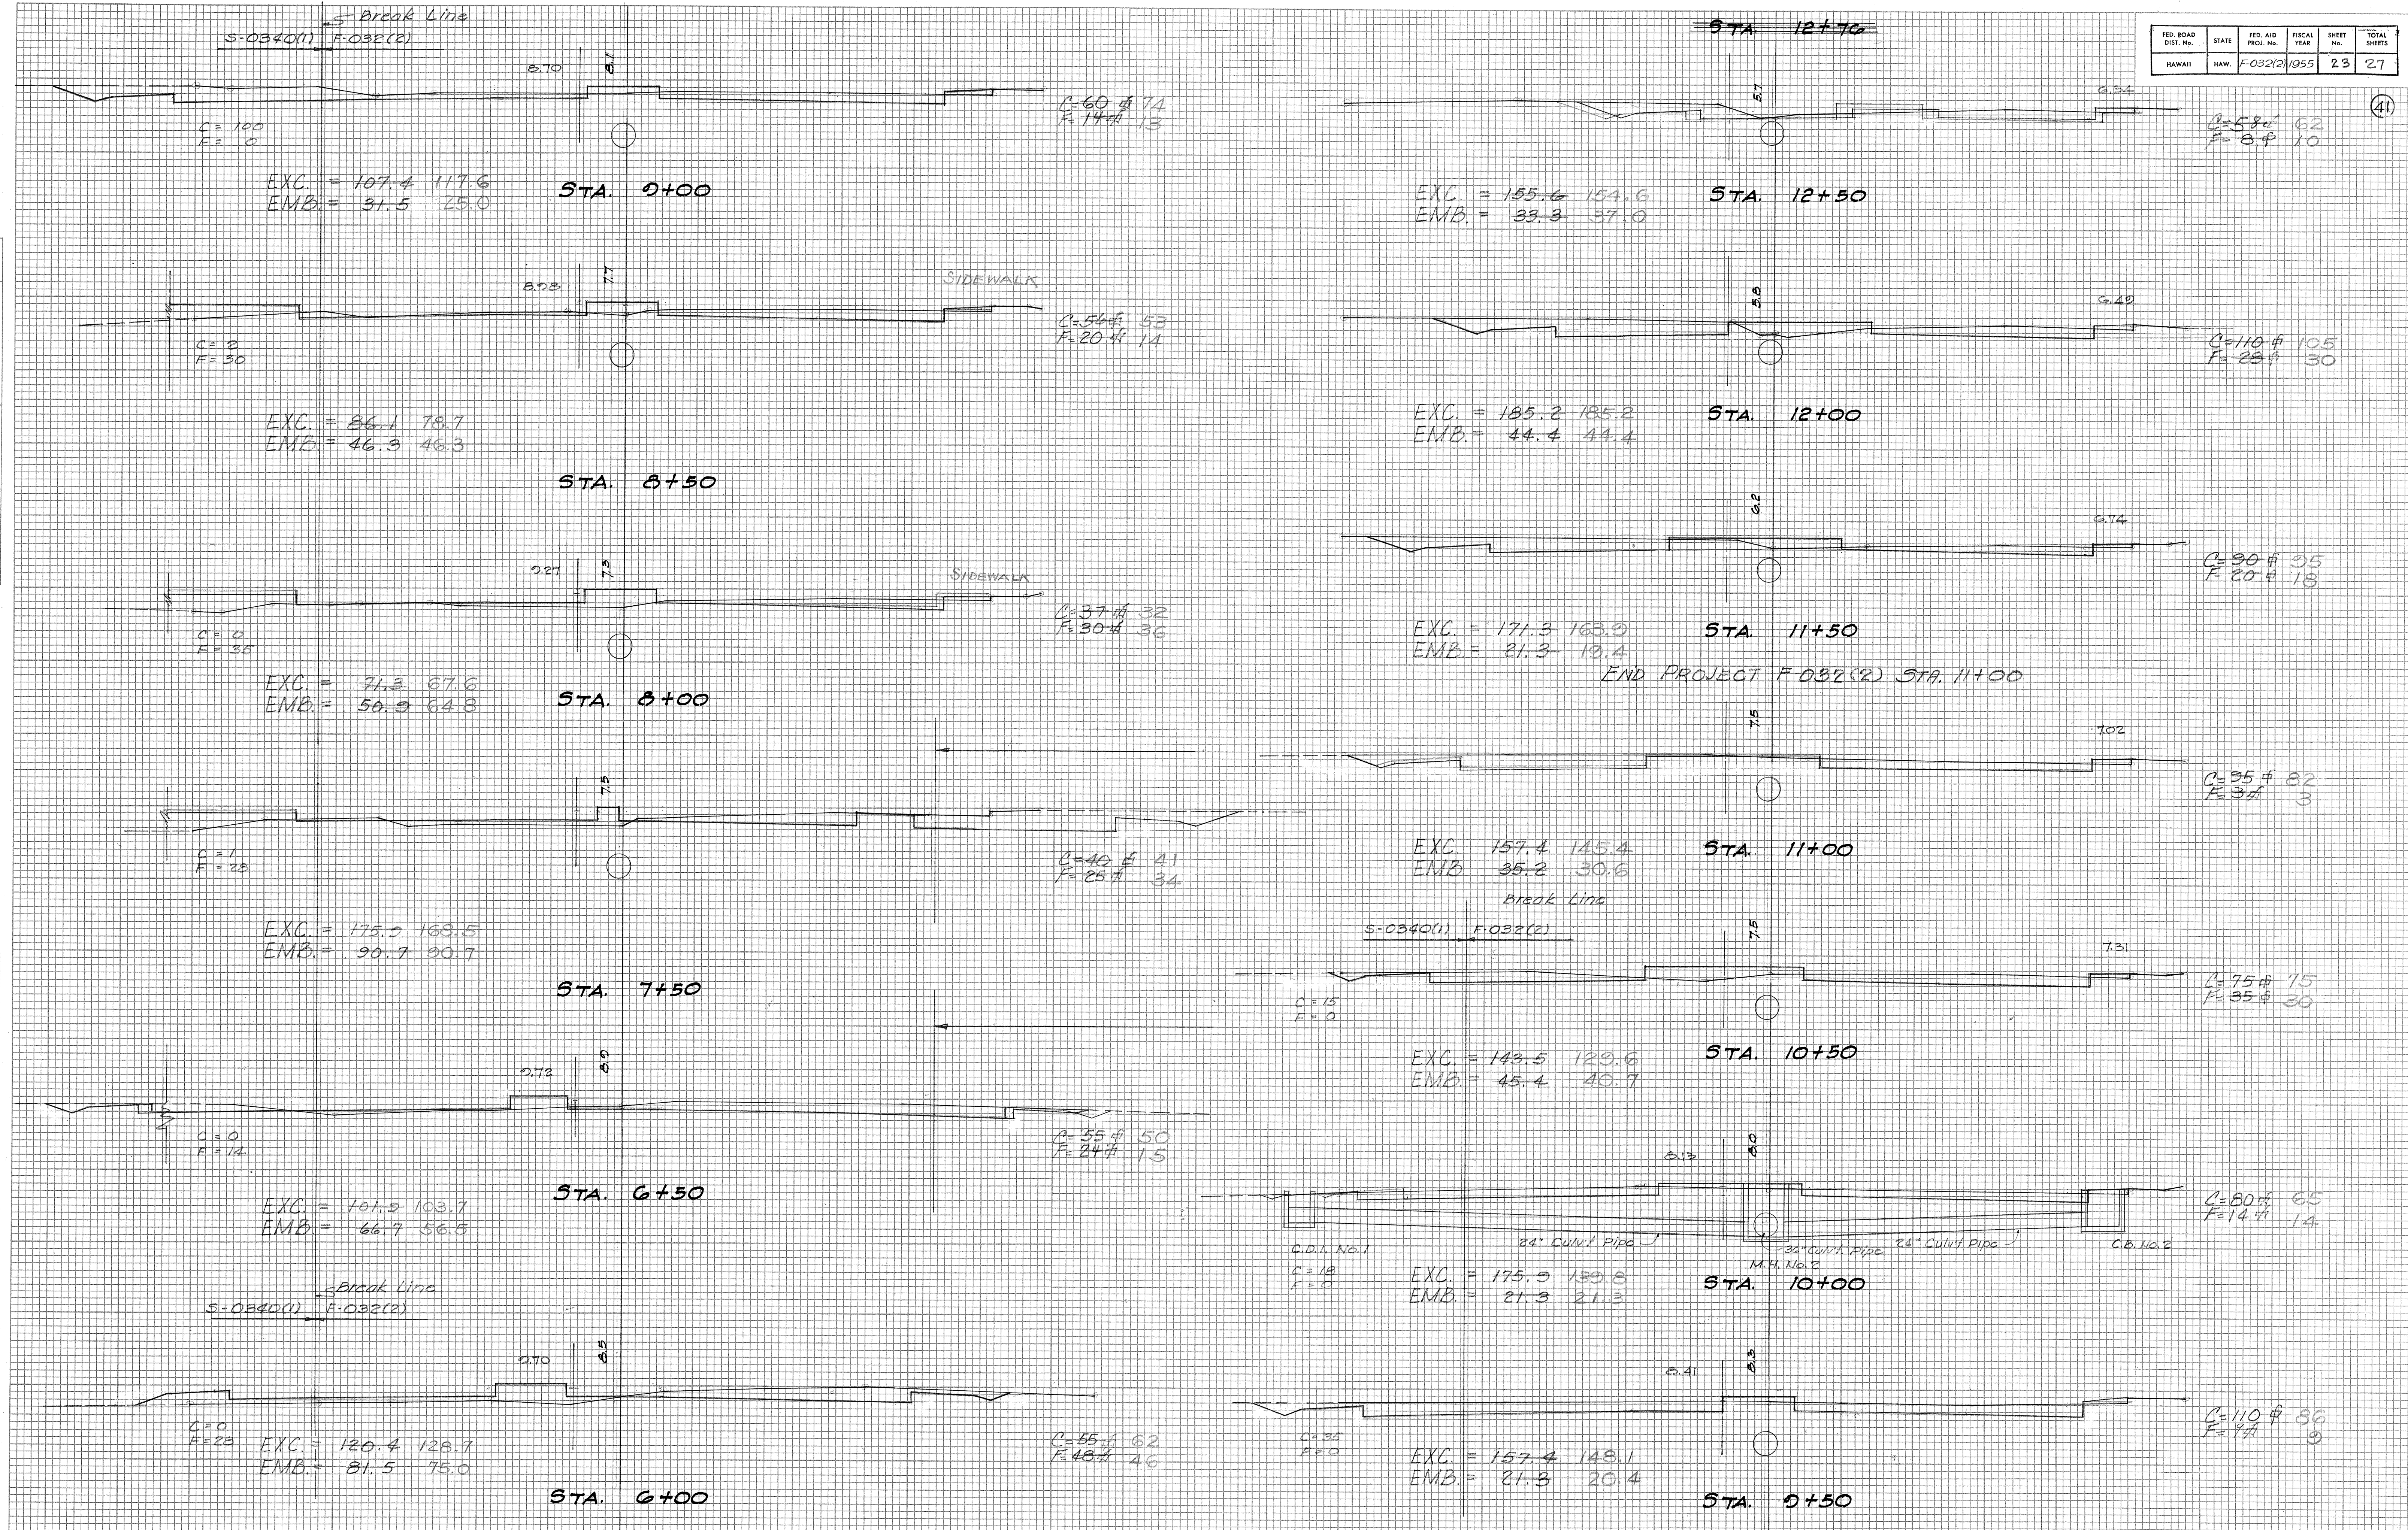


FED. ROAD DIST. No.	STATE	FED. AID PROJ. No.	FISCAL YEAR	SHEET No.	TOTAL SHEETS
HAWAII	HAW.	F-032(2)	1955	24	27

42


FINAL SURVEY	BY	DATE
	SURVEYED	
	NOTE BOOK	
	NO.	

ORIGINAL SURVEY	BY	DATE
	SURVEYED	
	NOTE BOOK	
	NO.	

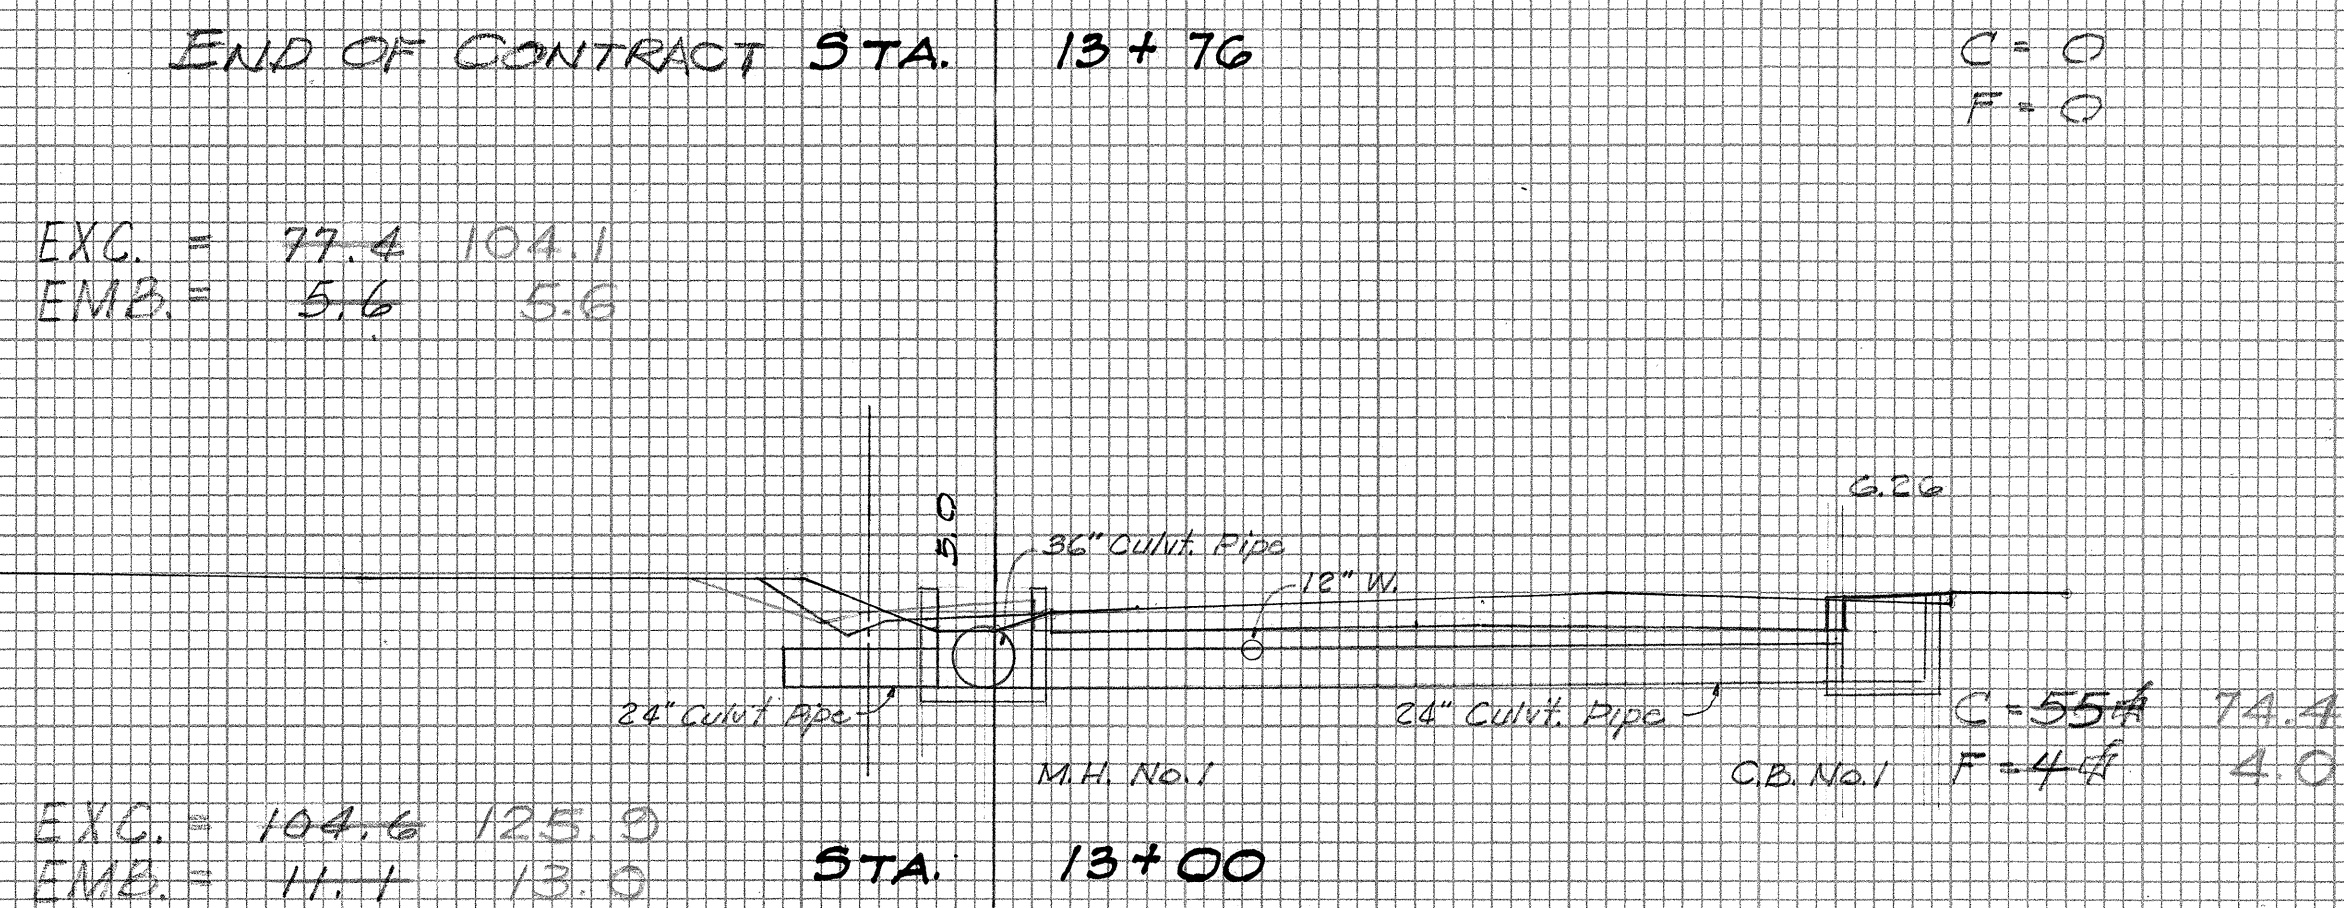

DATE
BY
SURVEYED
FINAL SURVEY
NOTE BOOK
NO.

DATE
BY
SURVEYED
ORIGINAL SURVEY
NOTE BOOK
NO.

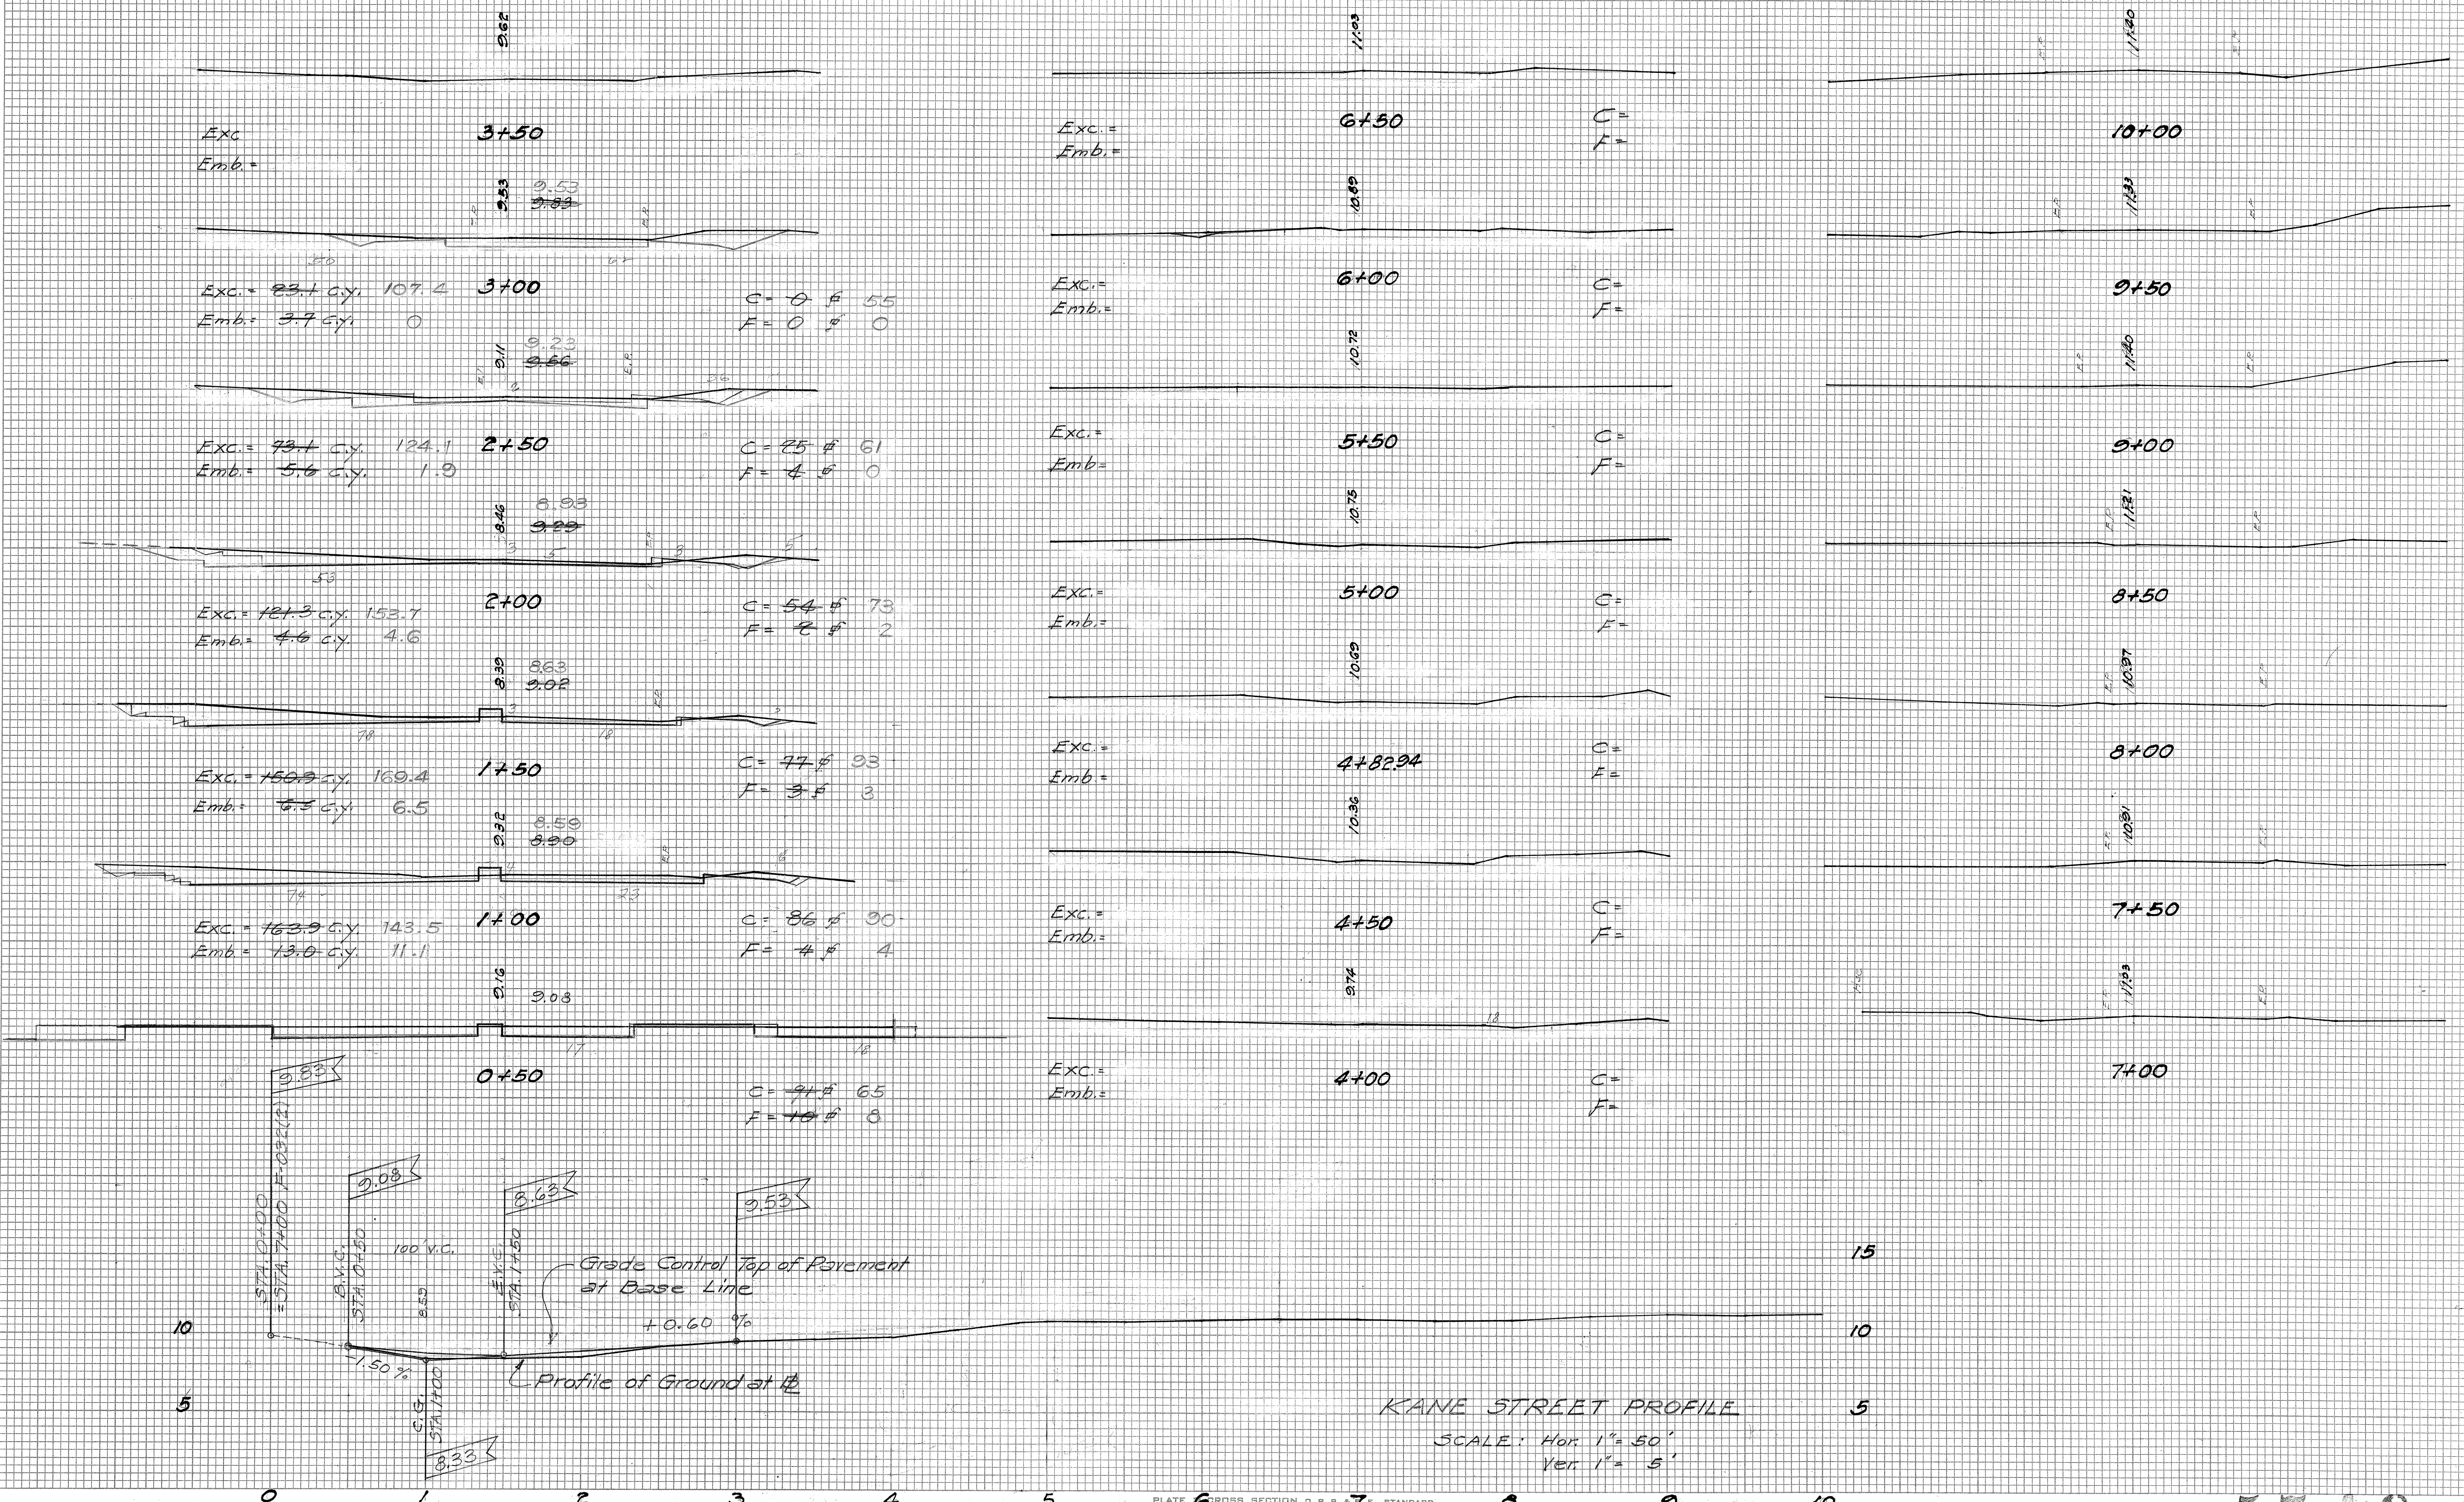

KANE STREET PROFILE

SCALE: Hor 1"=50'
Ver 1"=5'

④

SCALES: AS NOTED


ORIGINAL SURVEY		BY	DATE
	SURVEYED	<i>H. Hayashi</i>	<i>May 55</i>
	PLOTTED	<i>H. Bell</i>	<i>"</i>
NOTE BOOK	TEMPLATE	<i>H. Bell</i>	<i>"</i>
	AREAS	<i>H. Hayashi</i>	<i>"</i>
NO.	AREAS CHECKED		

DATE	BY	DATE	BY
FINAL SURVEY	BUREAU	FINAL SURVEY	BUREAU
NOTE BOOK	NOTE BOOK	NOTE BOOK	NOTE BOOK
NO.	NO.	NO.	NO.

DATE	BY	DATE	BY
ORIGINAL SURVEY	ORIGINAL SURVEY	ORIGINAL SURVEY	ORIGINAL SURVEY
NOTE BOOK	NOTE BOOK	NOTE BOOK	NOTE BOOK
NO.	NO.	NO.	NO.

FED. ROAD DIST. No.	STATE	FED. AID PROJ. No.	FISCAL YEAR	SHEET No.	TOTAL SHEETS
HAWAII	HAW.	F-032(0)	1955	27	27

(45)

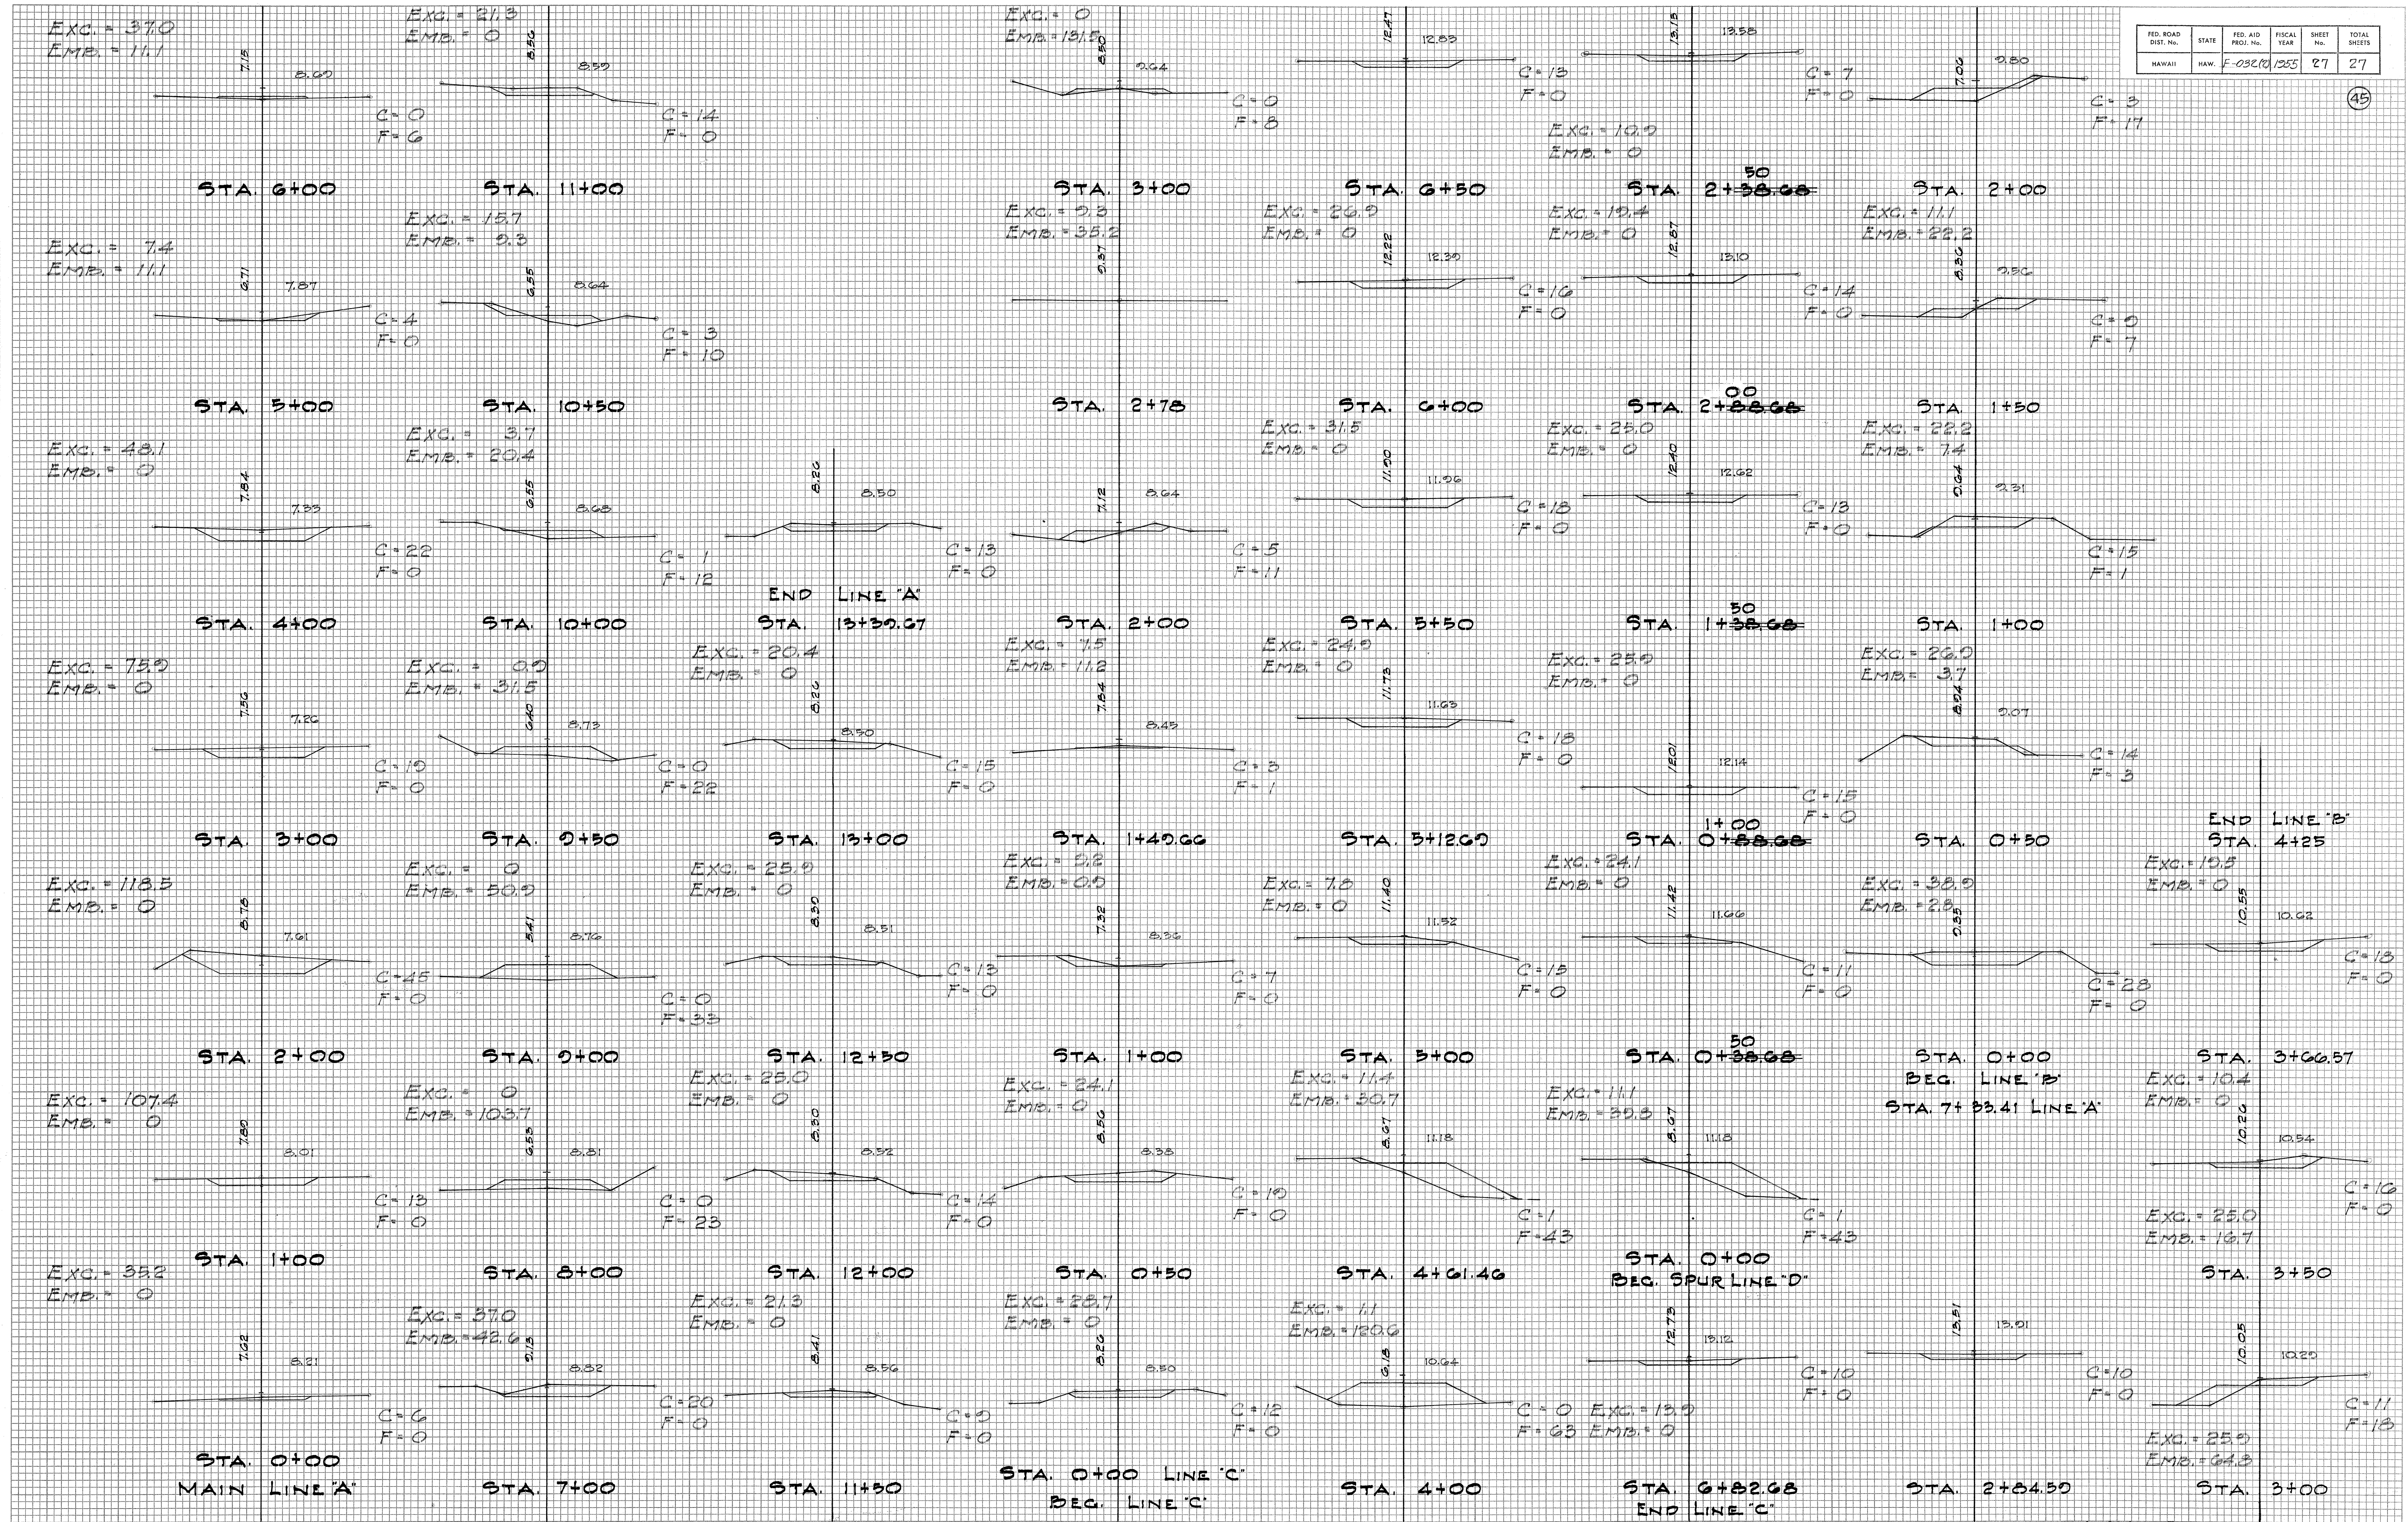

5748.27