




FED. ROAD DIST. No.	STATE	FED. AID PROJ. No.	FISCAL YEAR	SHEET No.	TOTAL SHEETS
HAWAII	HAW.	S-0340(1)	1955	3	29

FED. ROAD DIST. No.	STATE	FED. AID PROJ. No.	FISCAL YEAR	SHEET No.	TOTAL SHEETS
HAWAII	HAW.	F-032(2)	1955	3	27


15

PLAN	DATE	BY	CHKD.
SURVISED			
PLOTTED			
NOTE BOOK			
ALIGNMENT CHECKED			
NO. OF ANY CHECKED			





PROFILE	DATE	BY	CHKD.
SURVISED			
PLOTTED			
NOTE BOOK			
GRADES CHECKED			
STRUCTURE NOTATIONS			

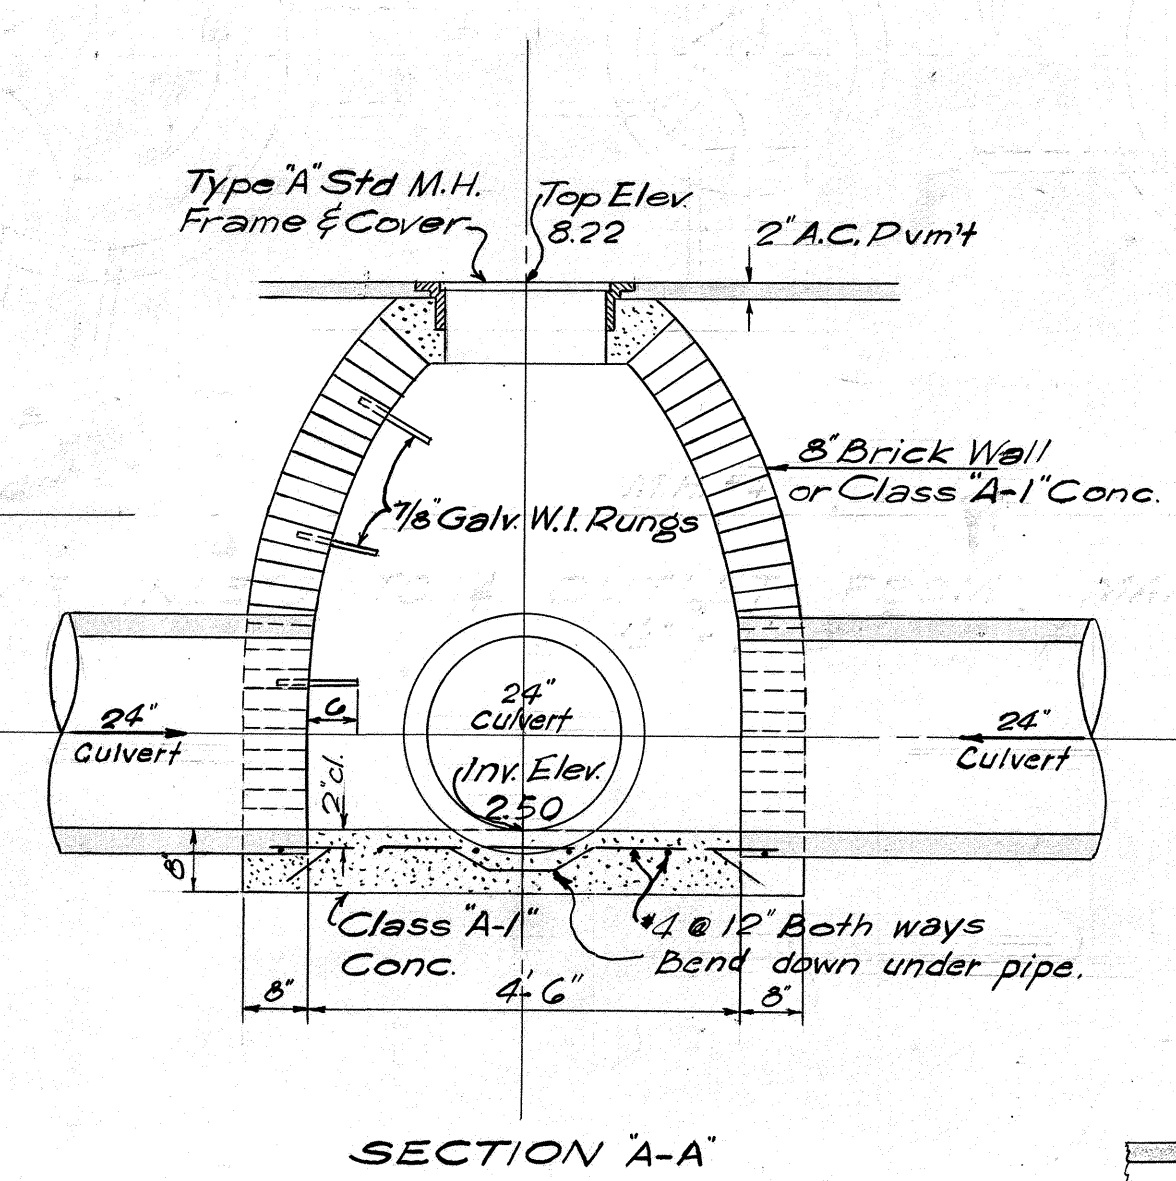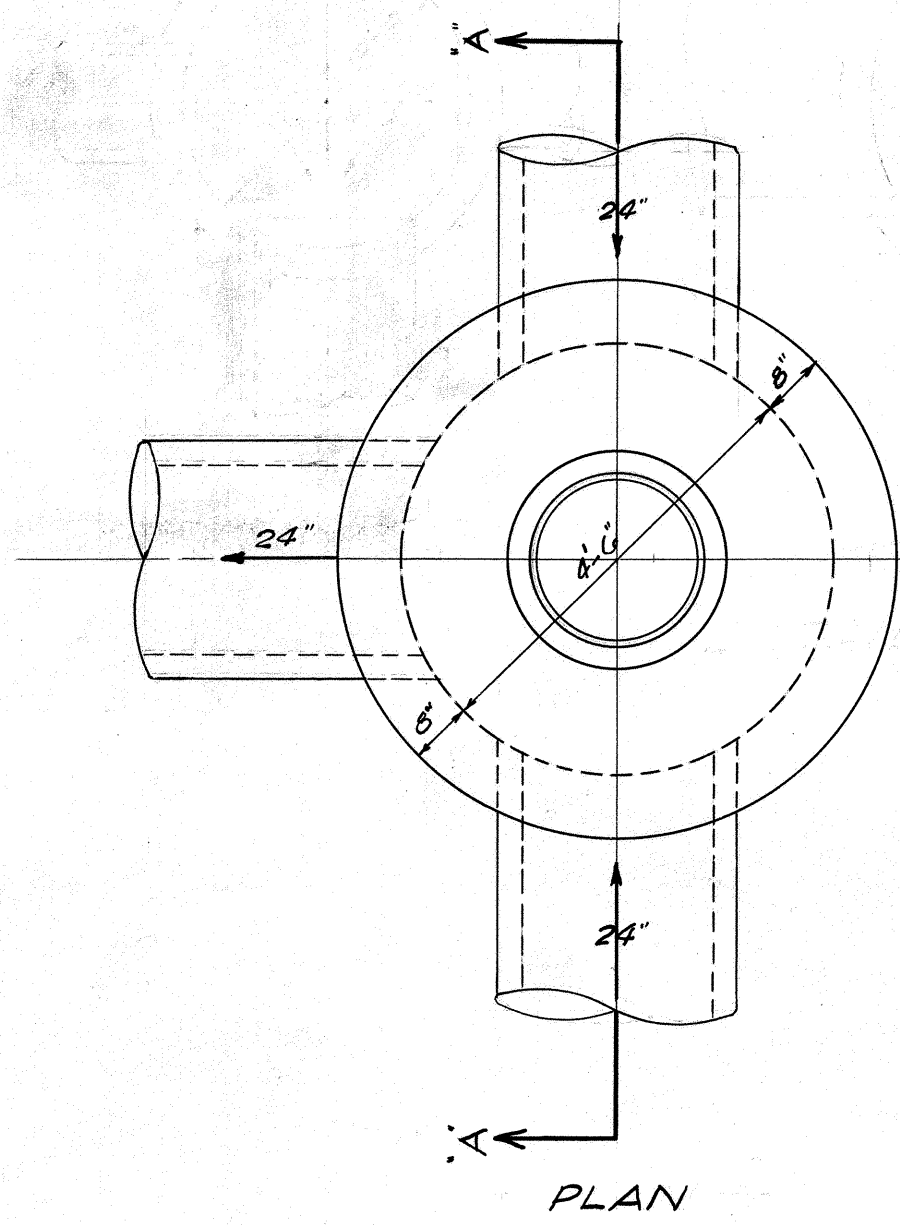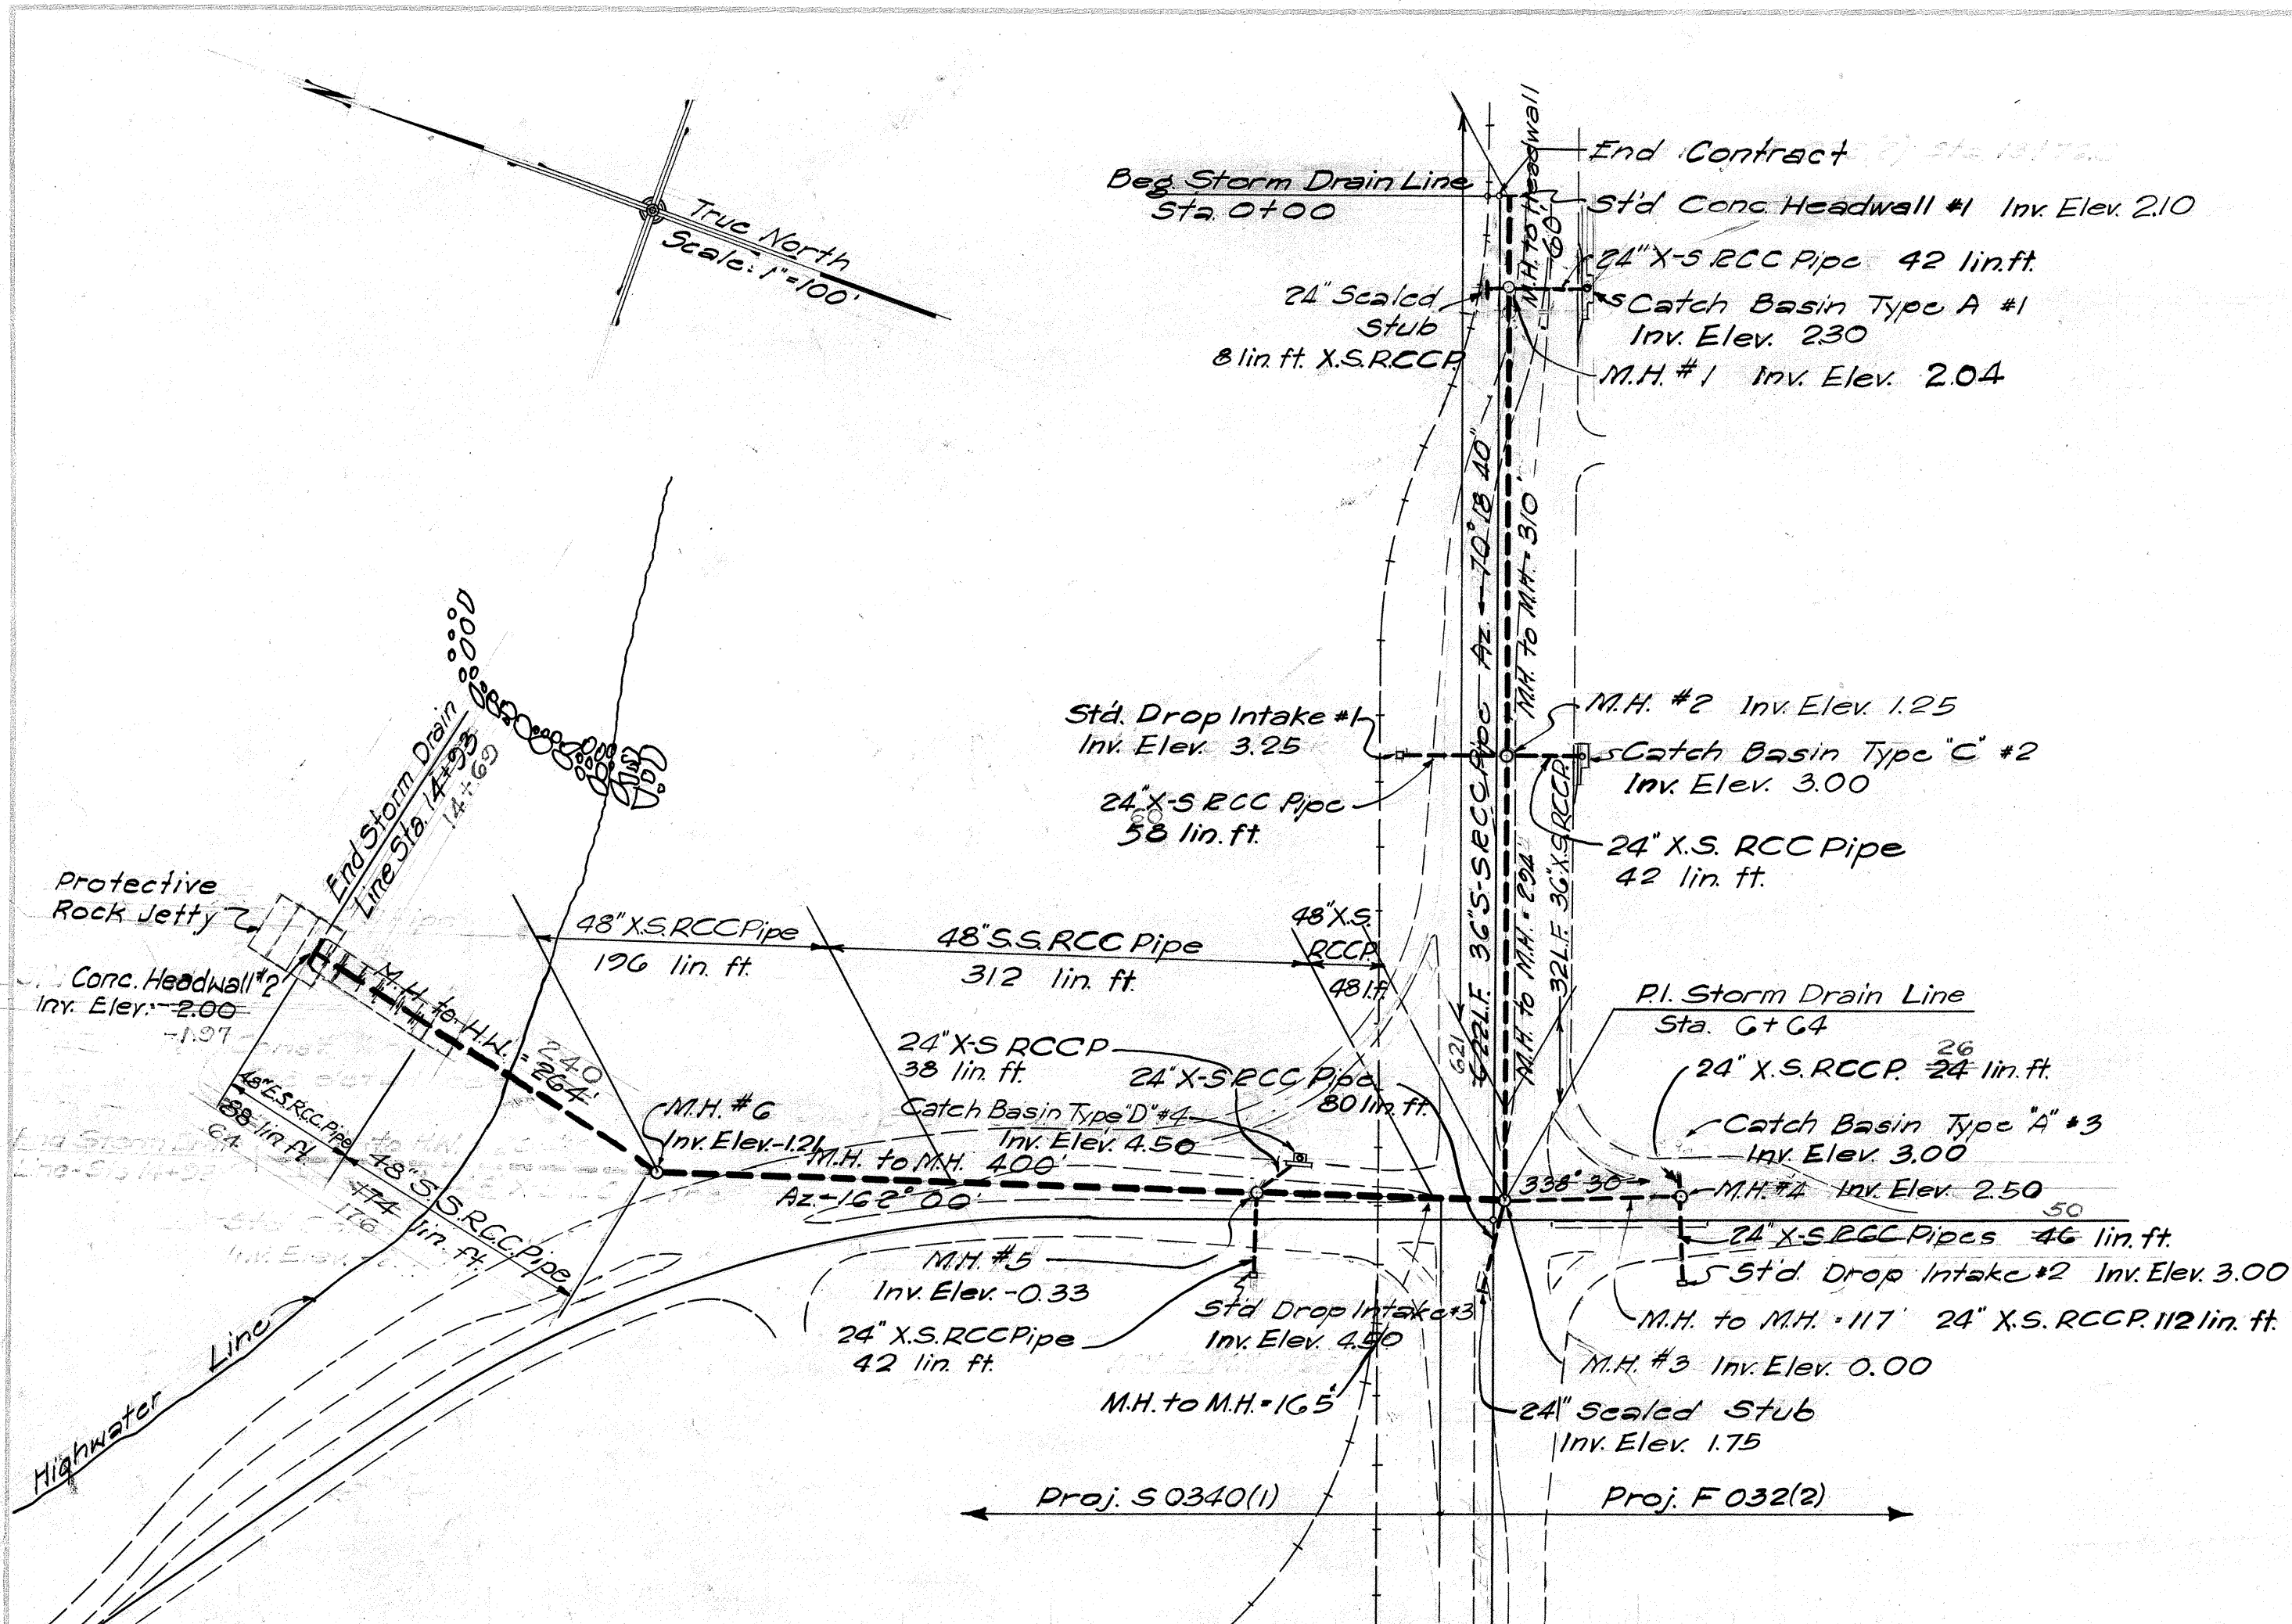

NOTE: If brick is used exterior surface of wall shall be plastered with 1" thickness of 1:2 cement mortar.

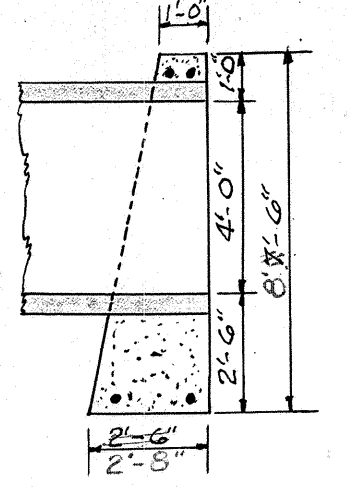


NOTE: For details of Special Manholes Nos. 1, 2, 3, 5, 6 See Sheet No. 5748.9 Crush Rock Cushion Under Culvert Outfall to be Paid for Under Item No. 20. Special Rock Fill. STORM DRAIN PLAN & PROFILE Rev. No. F-032(2) & S-0340(1) Scale: as Noted

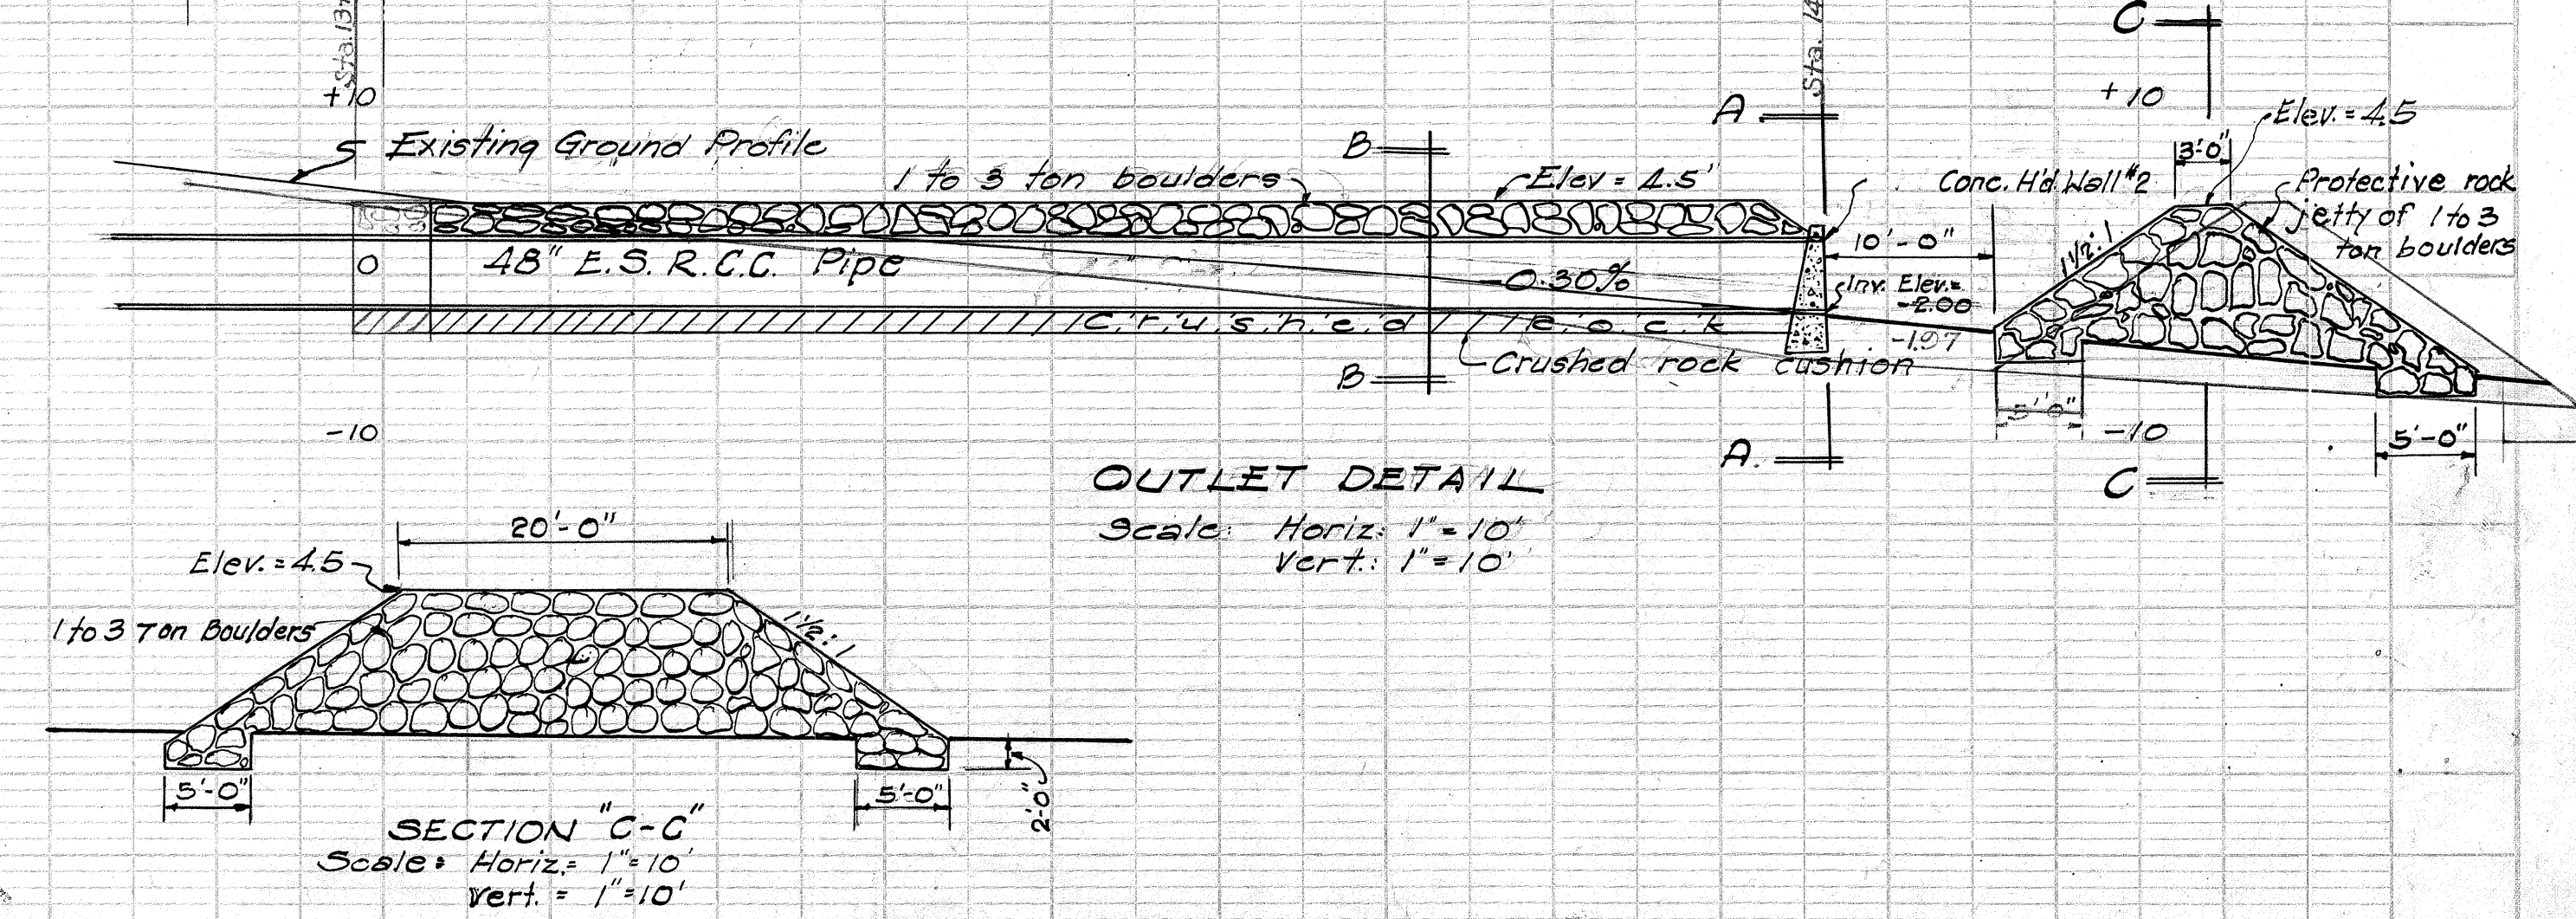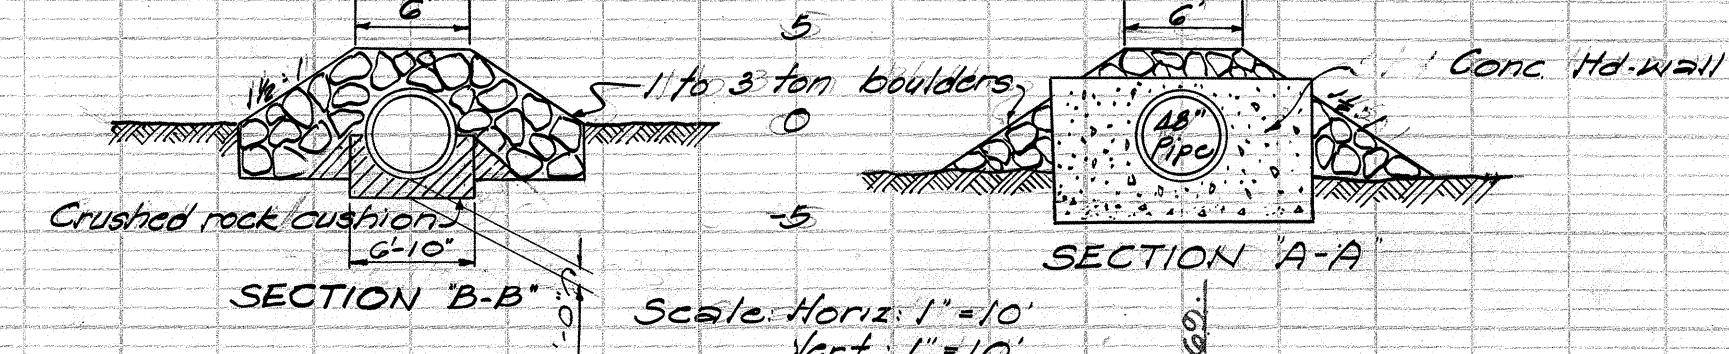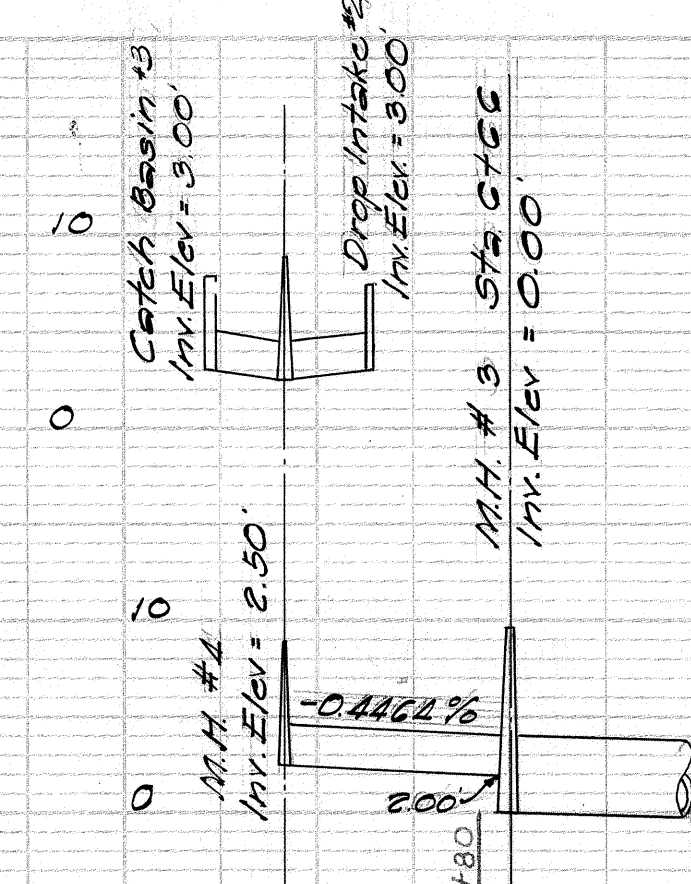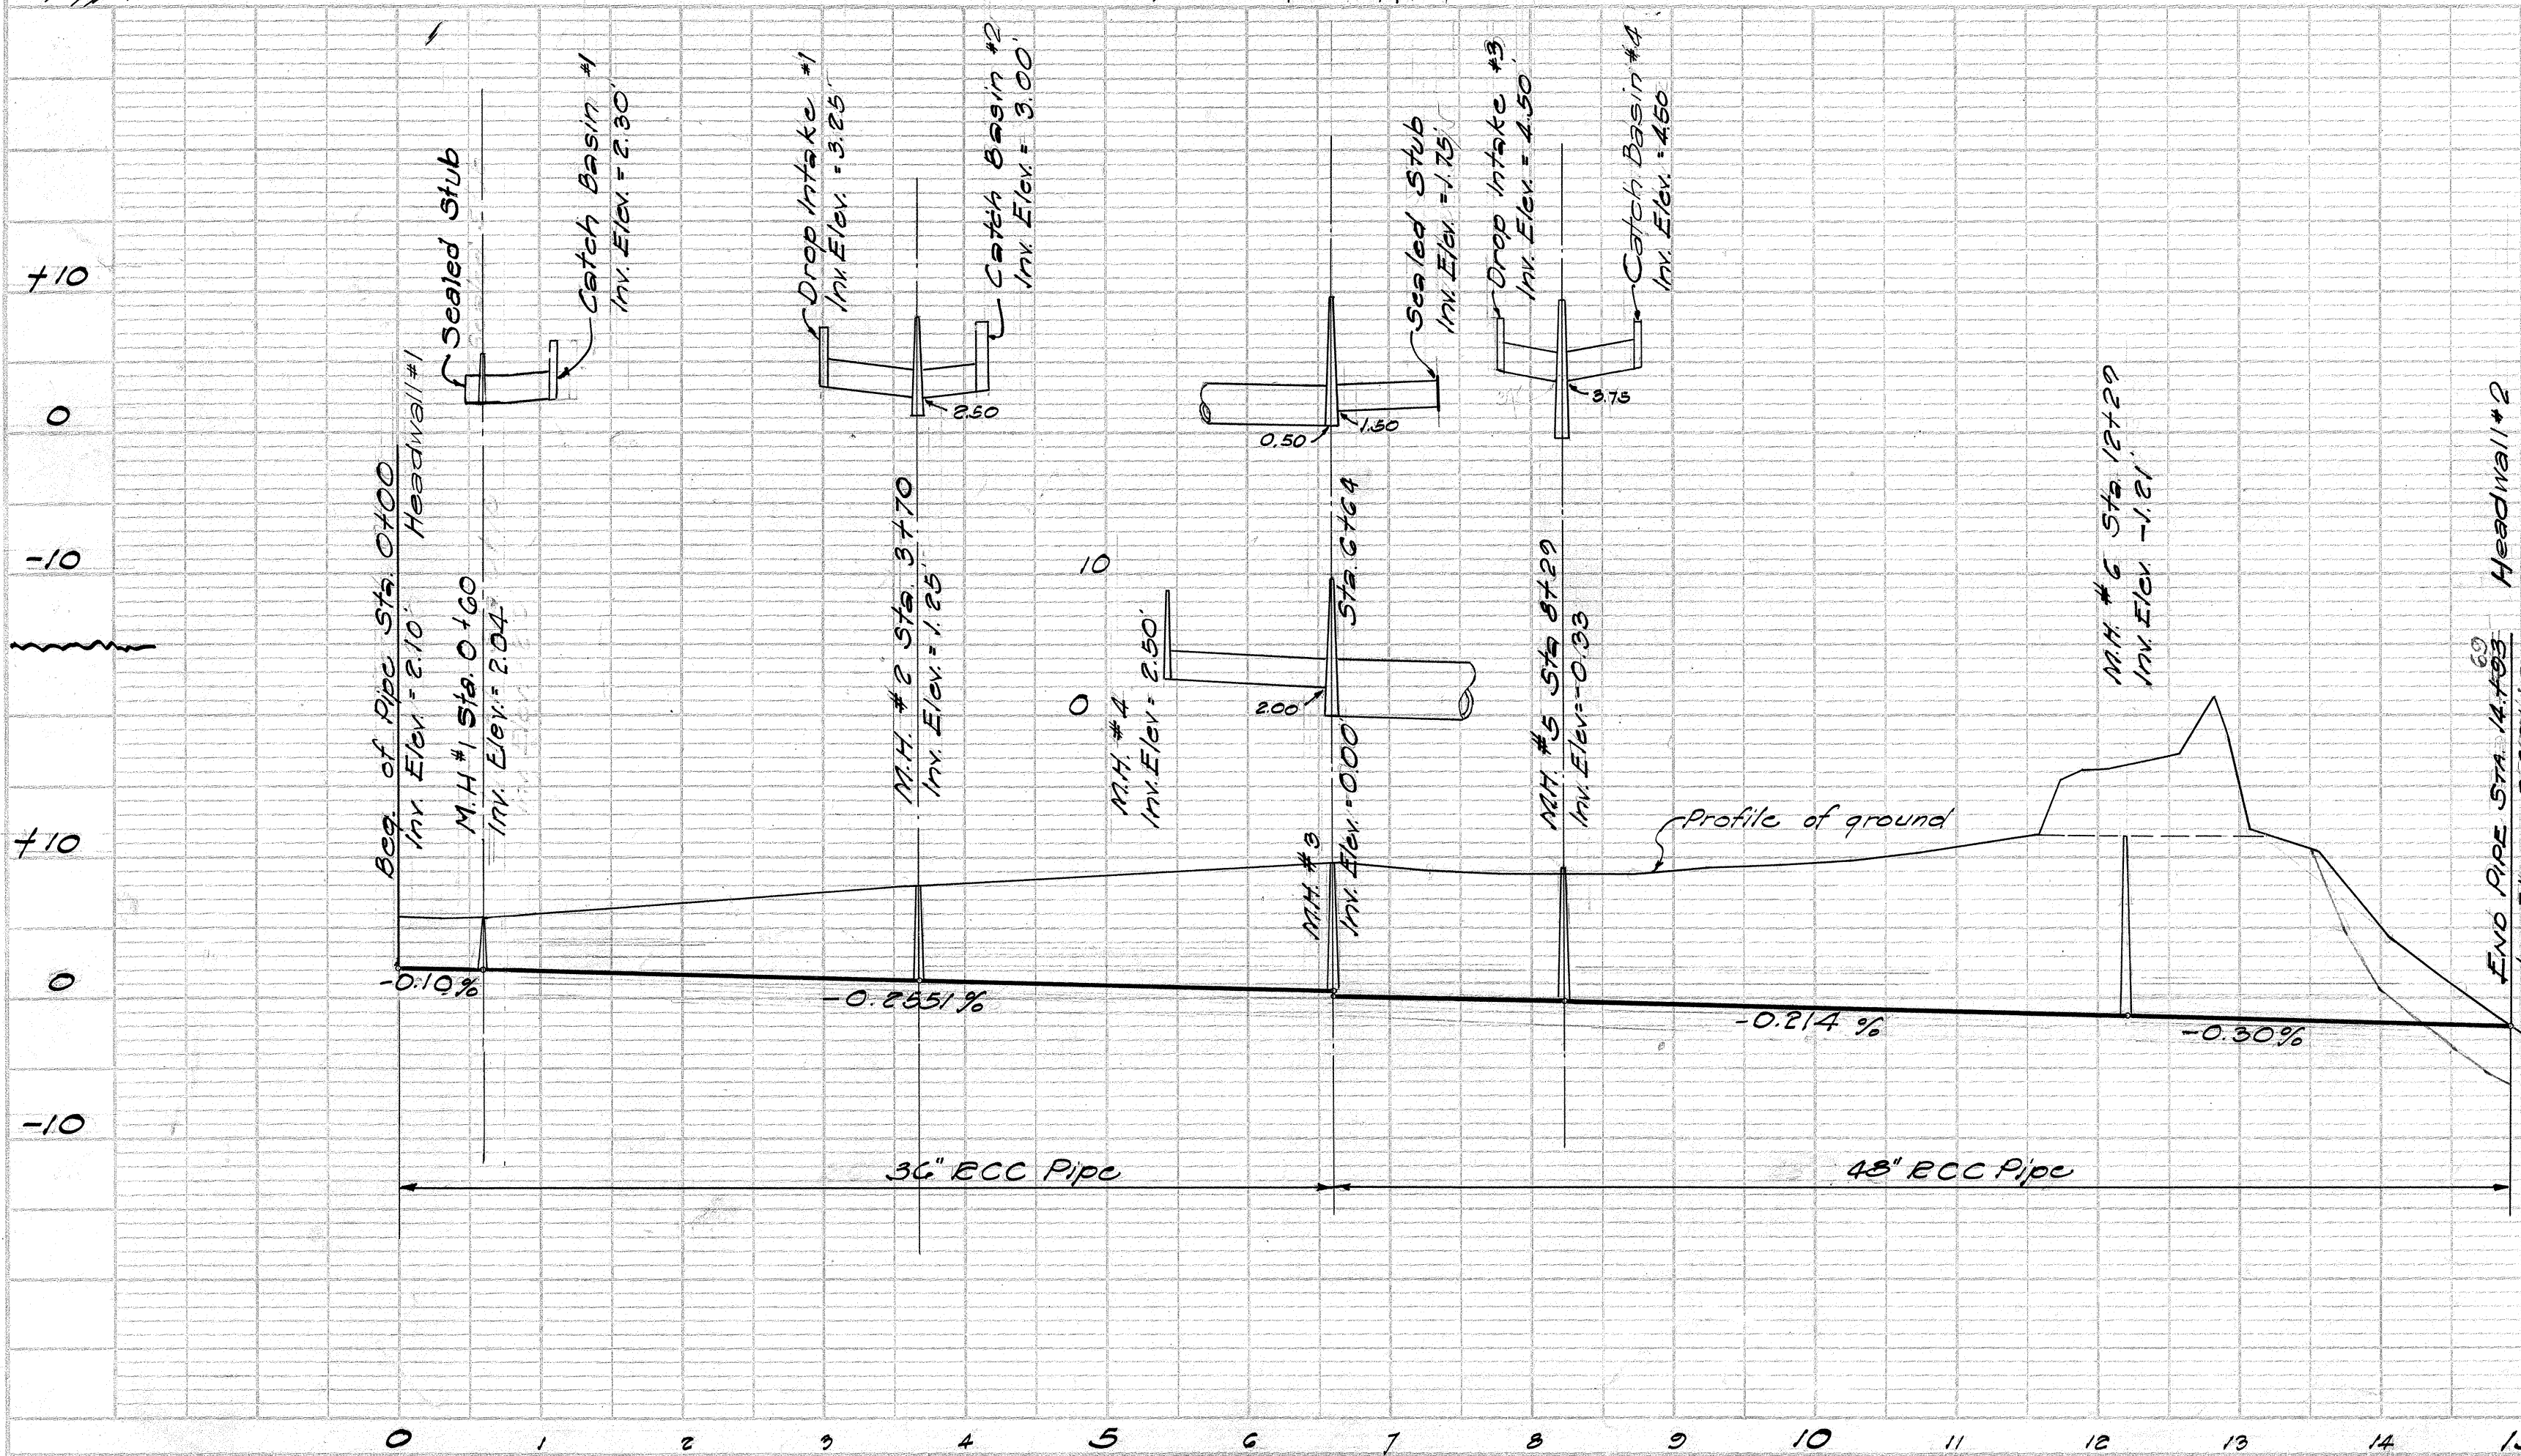


5747.8 5748.8


DATE:
DESIGNED BY:
DRAWN BY:
CHECKED BY:
NOTE BOOK NO.
QUANTITIES CHECKED BY:
ORIGINAL

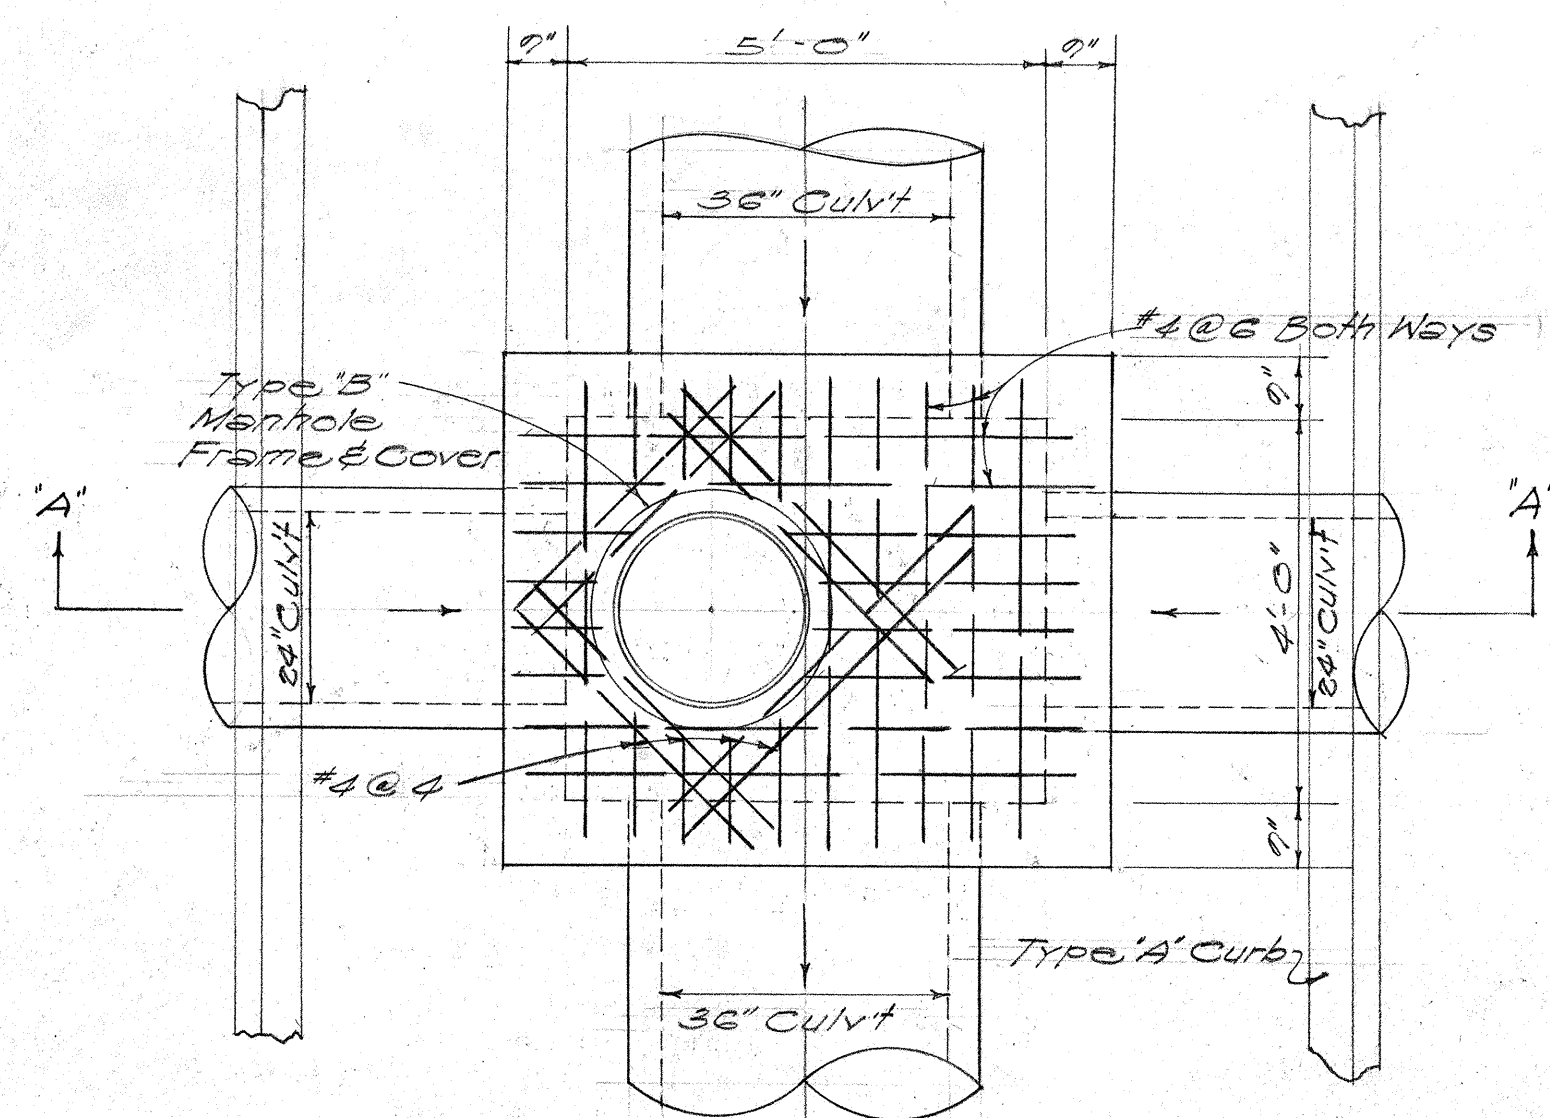


PLAN M.H.#1

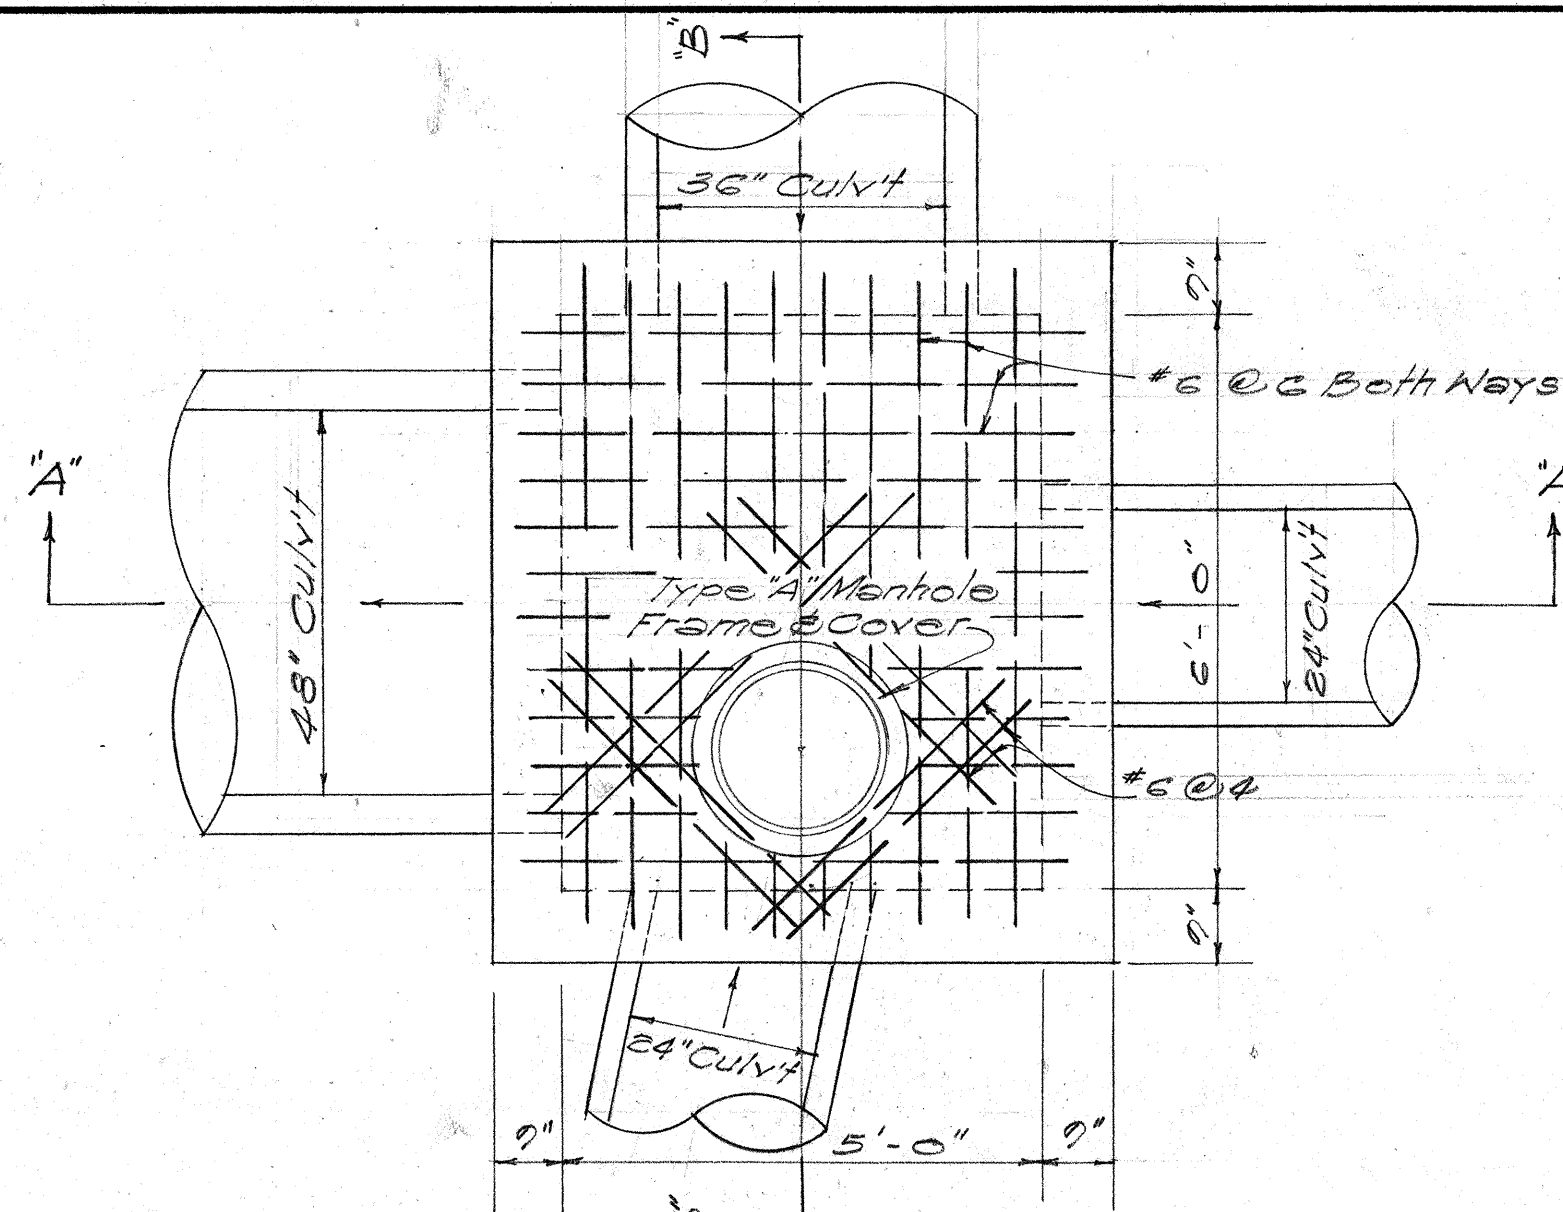


PLAN

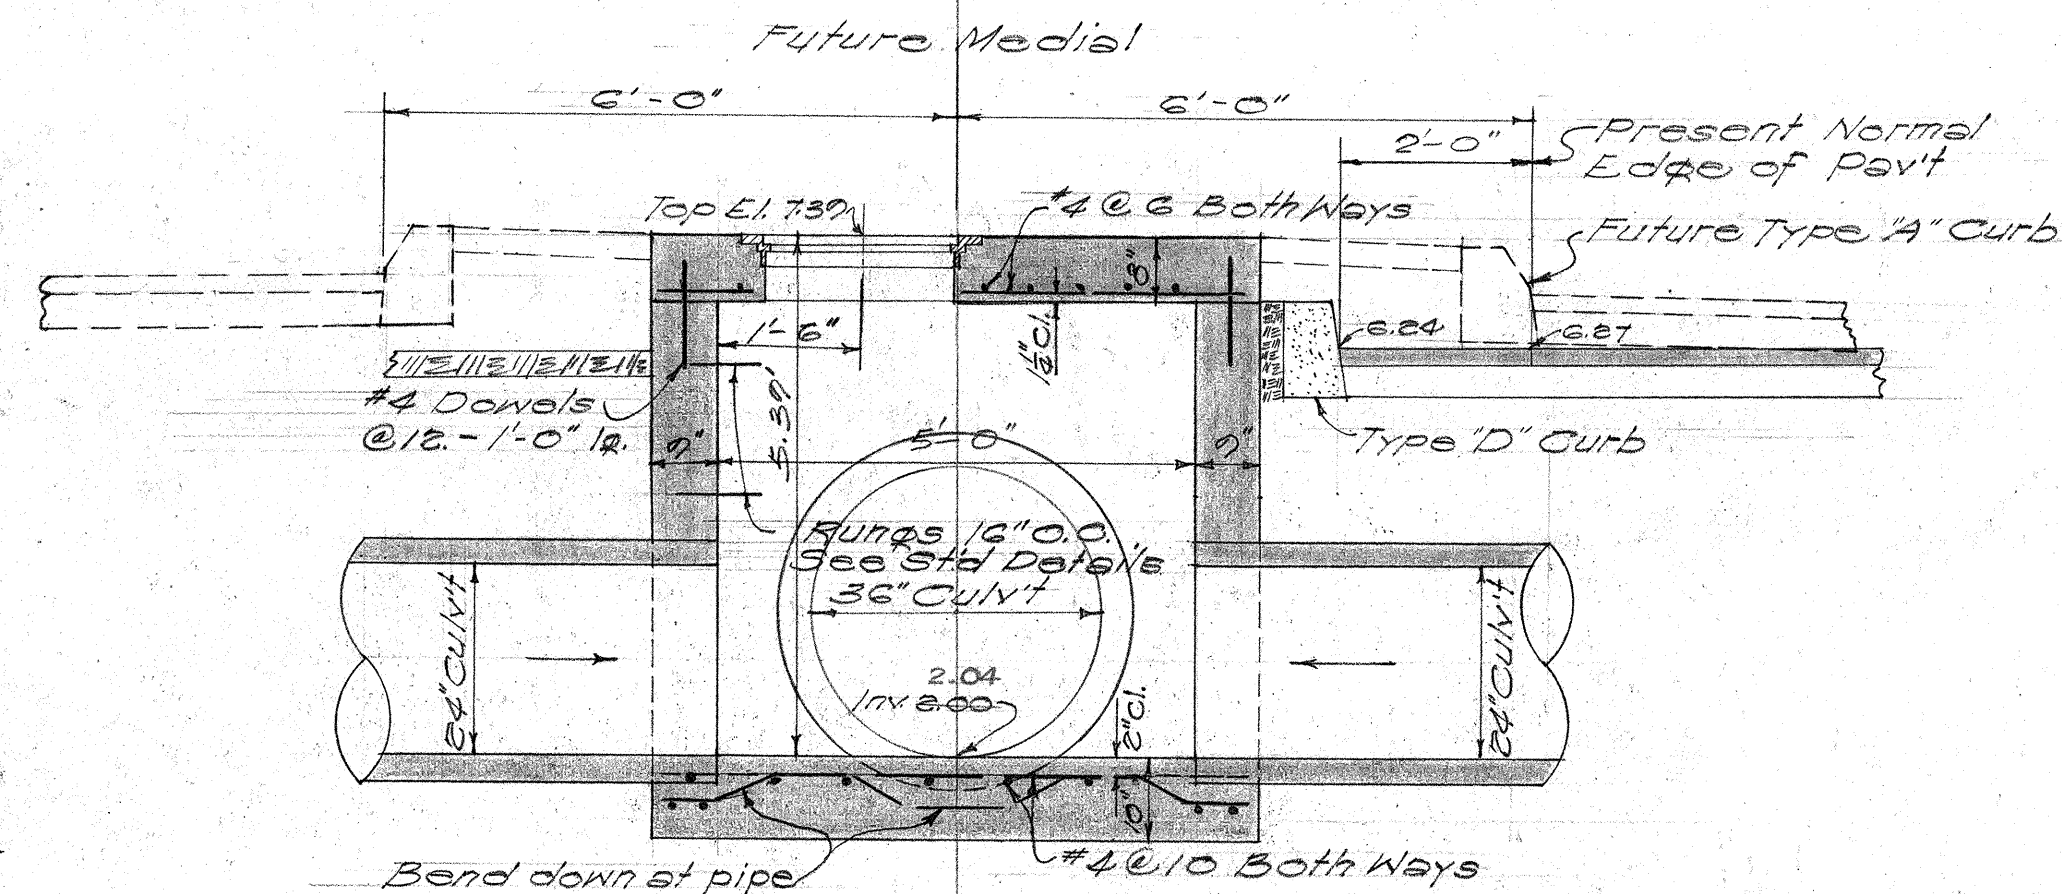


SECTION A-A M.H.#1

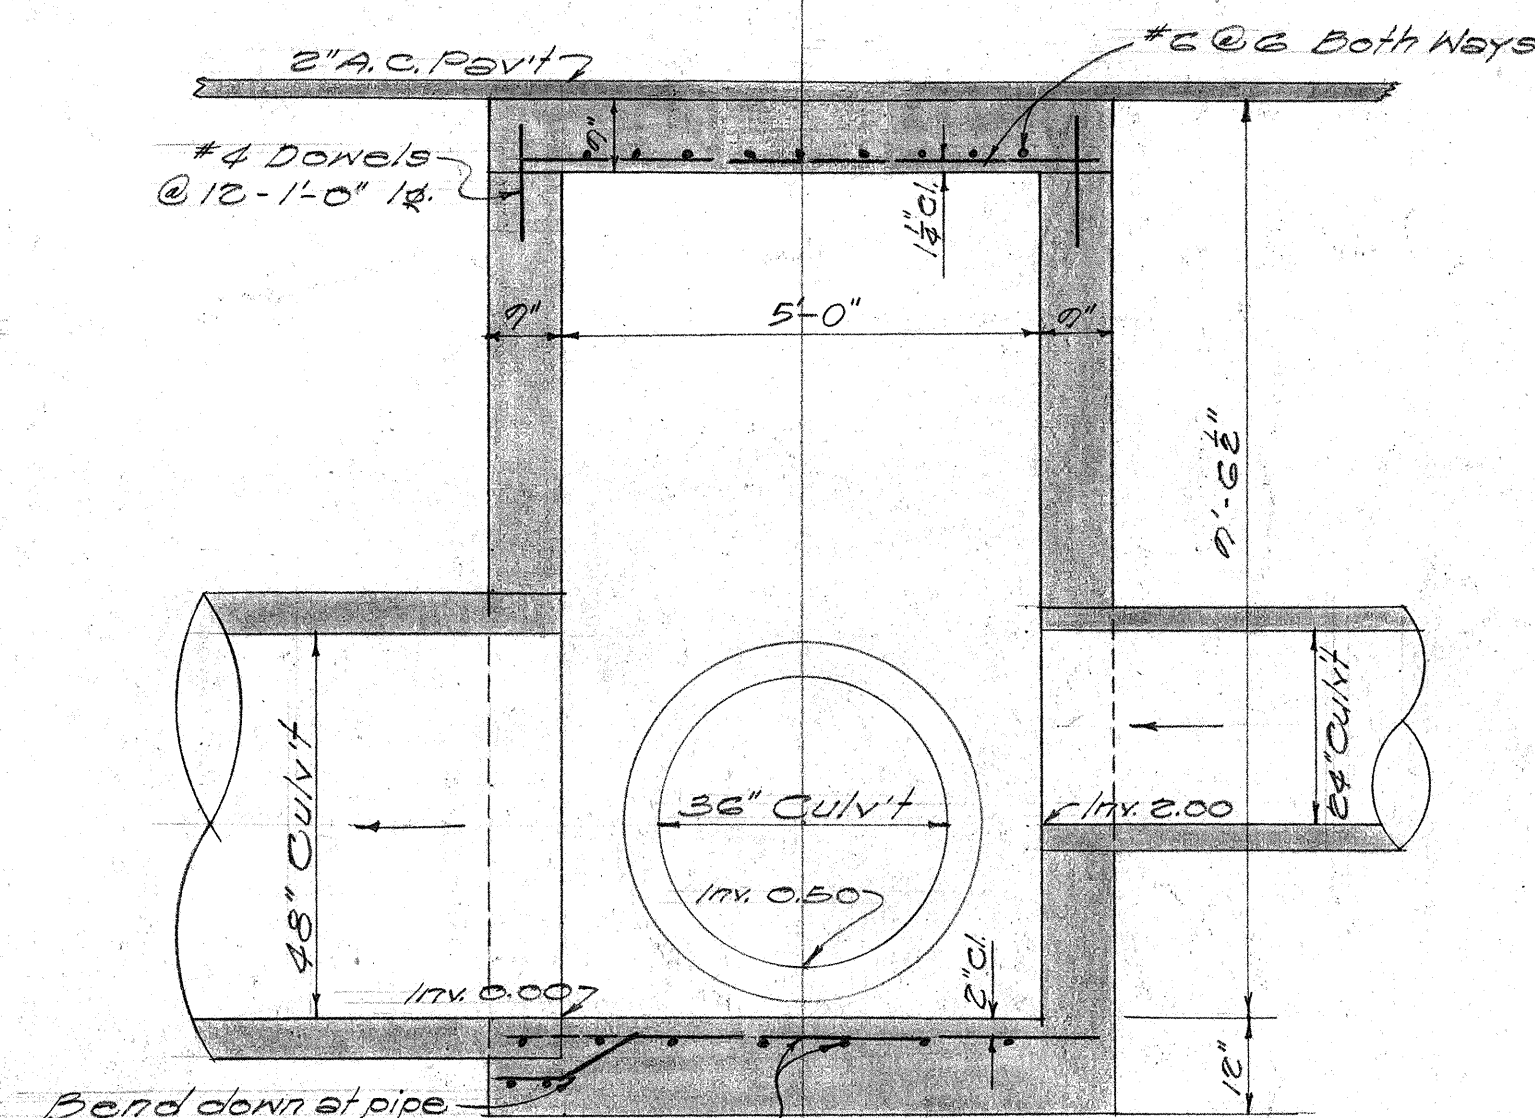

SECTION A-A

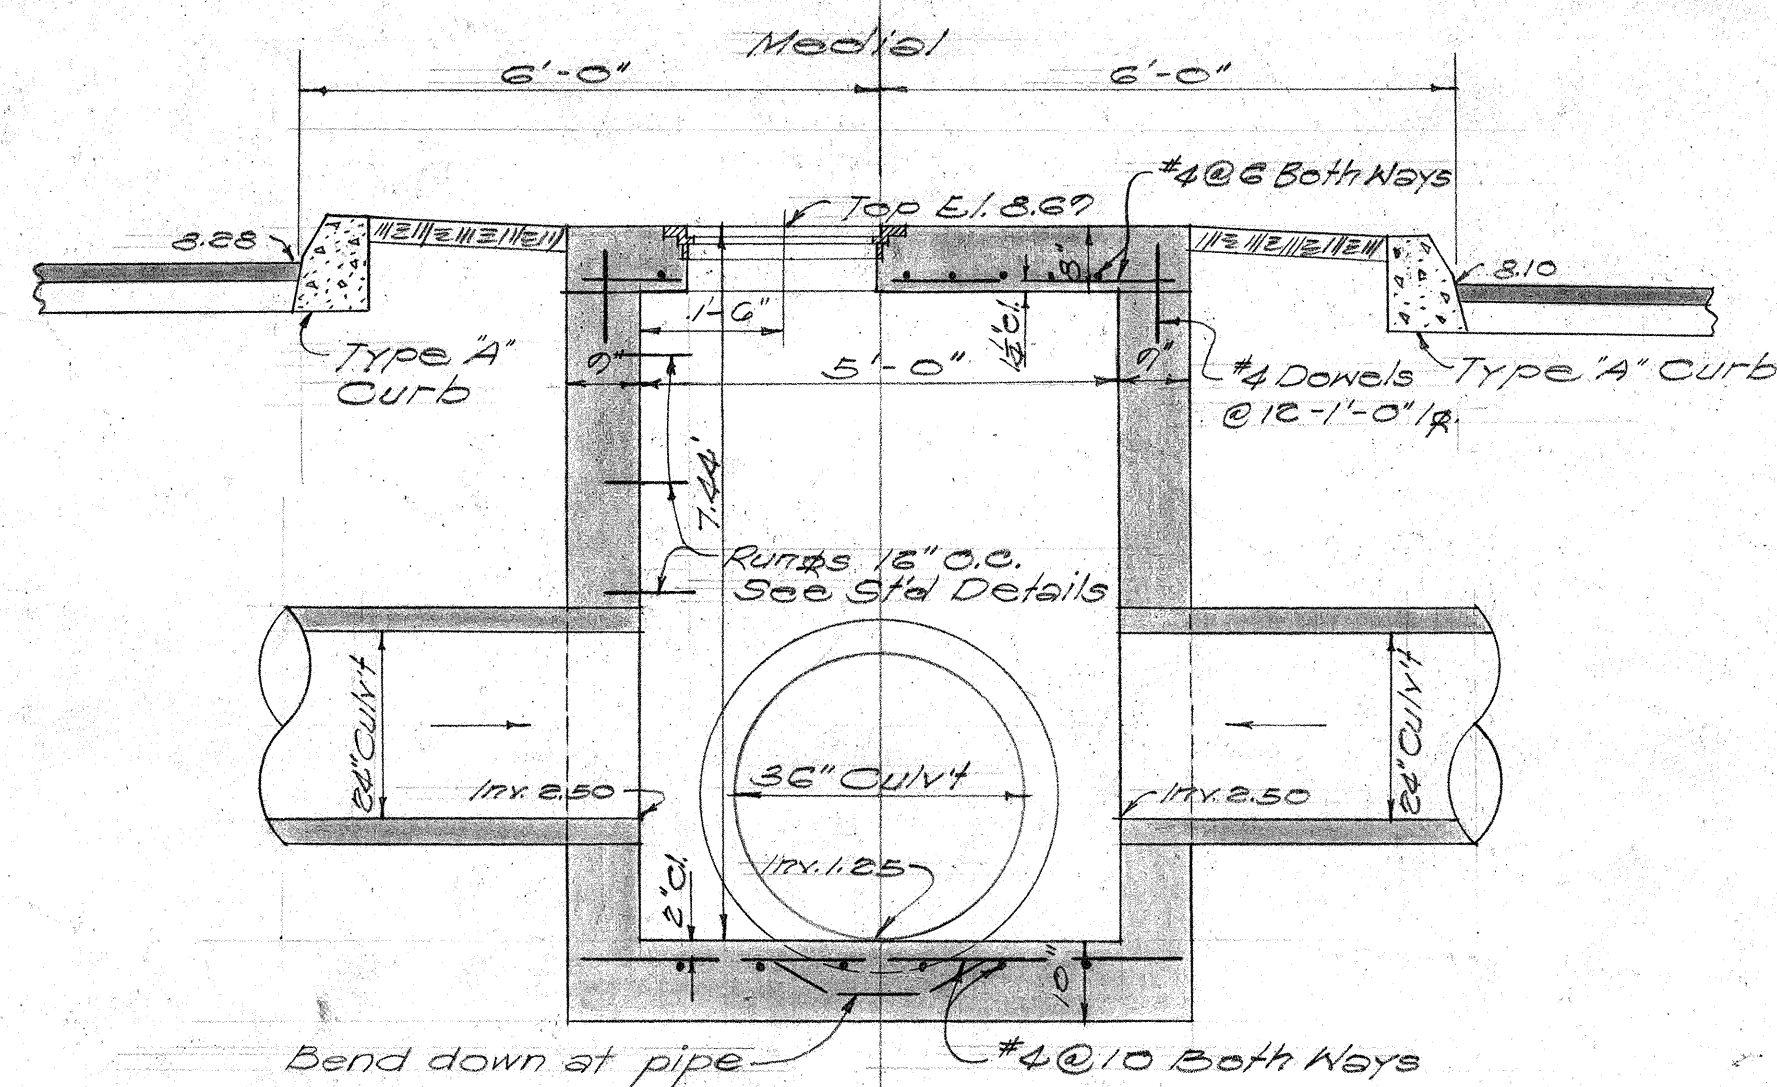


SECTION A-A M.H.#2

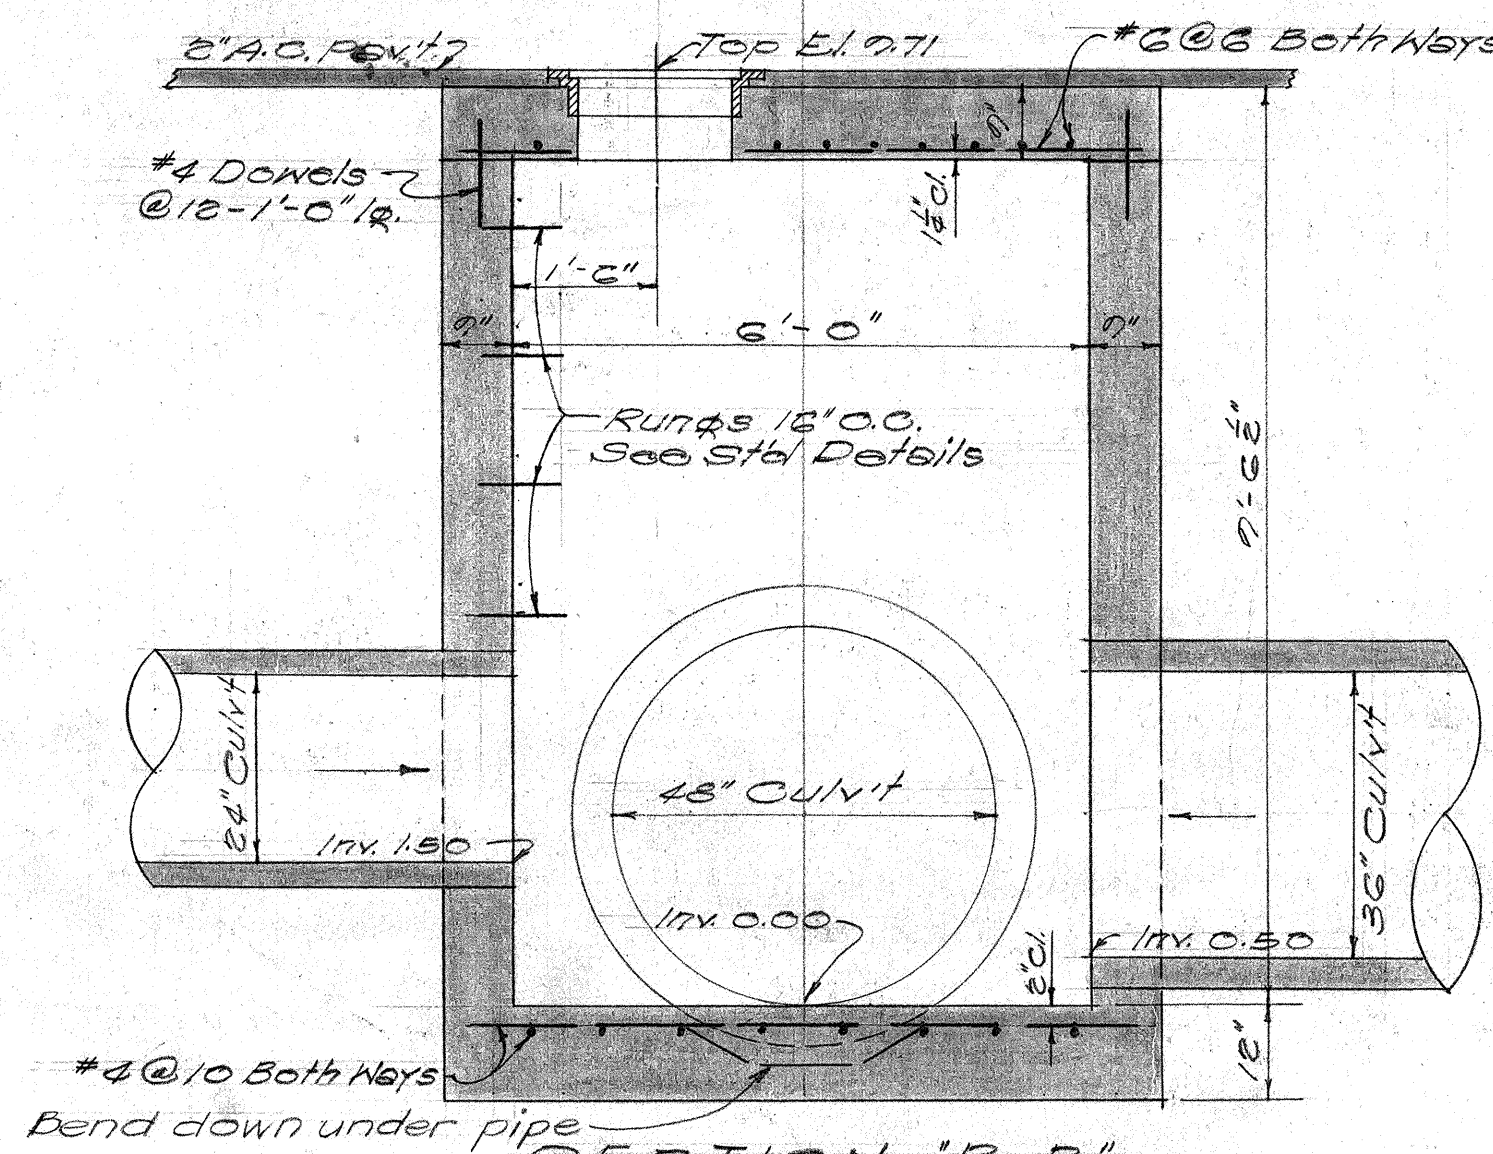


SECTION B-B


DETAIL OF M.H.#3

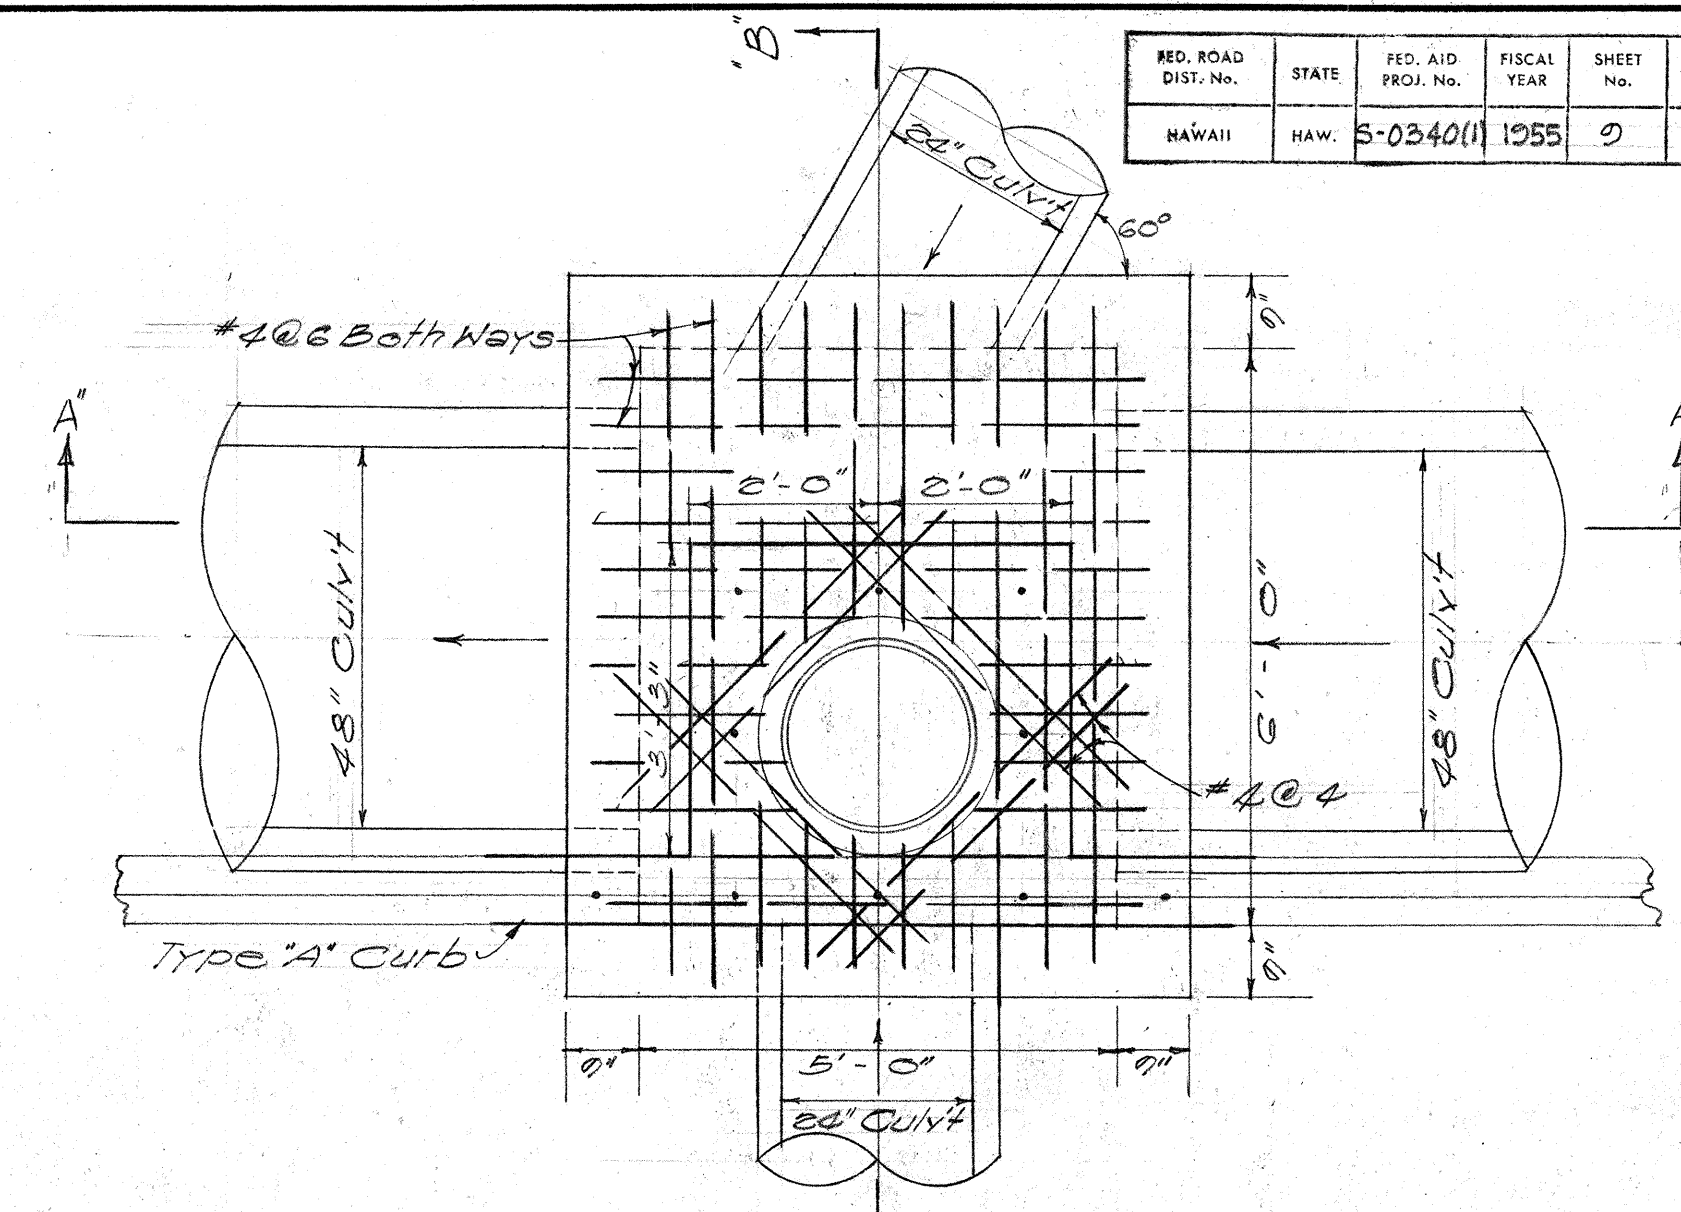

PLAN M.H.#5

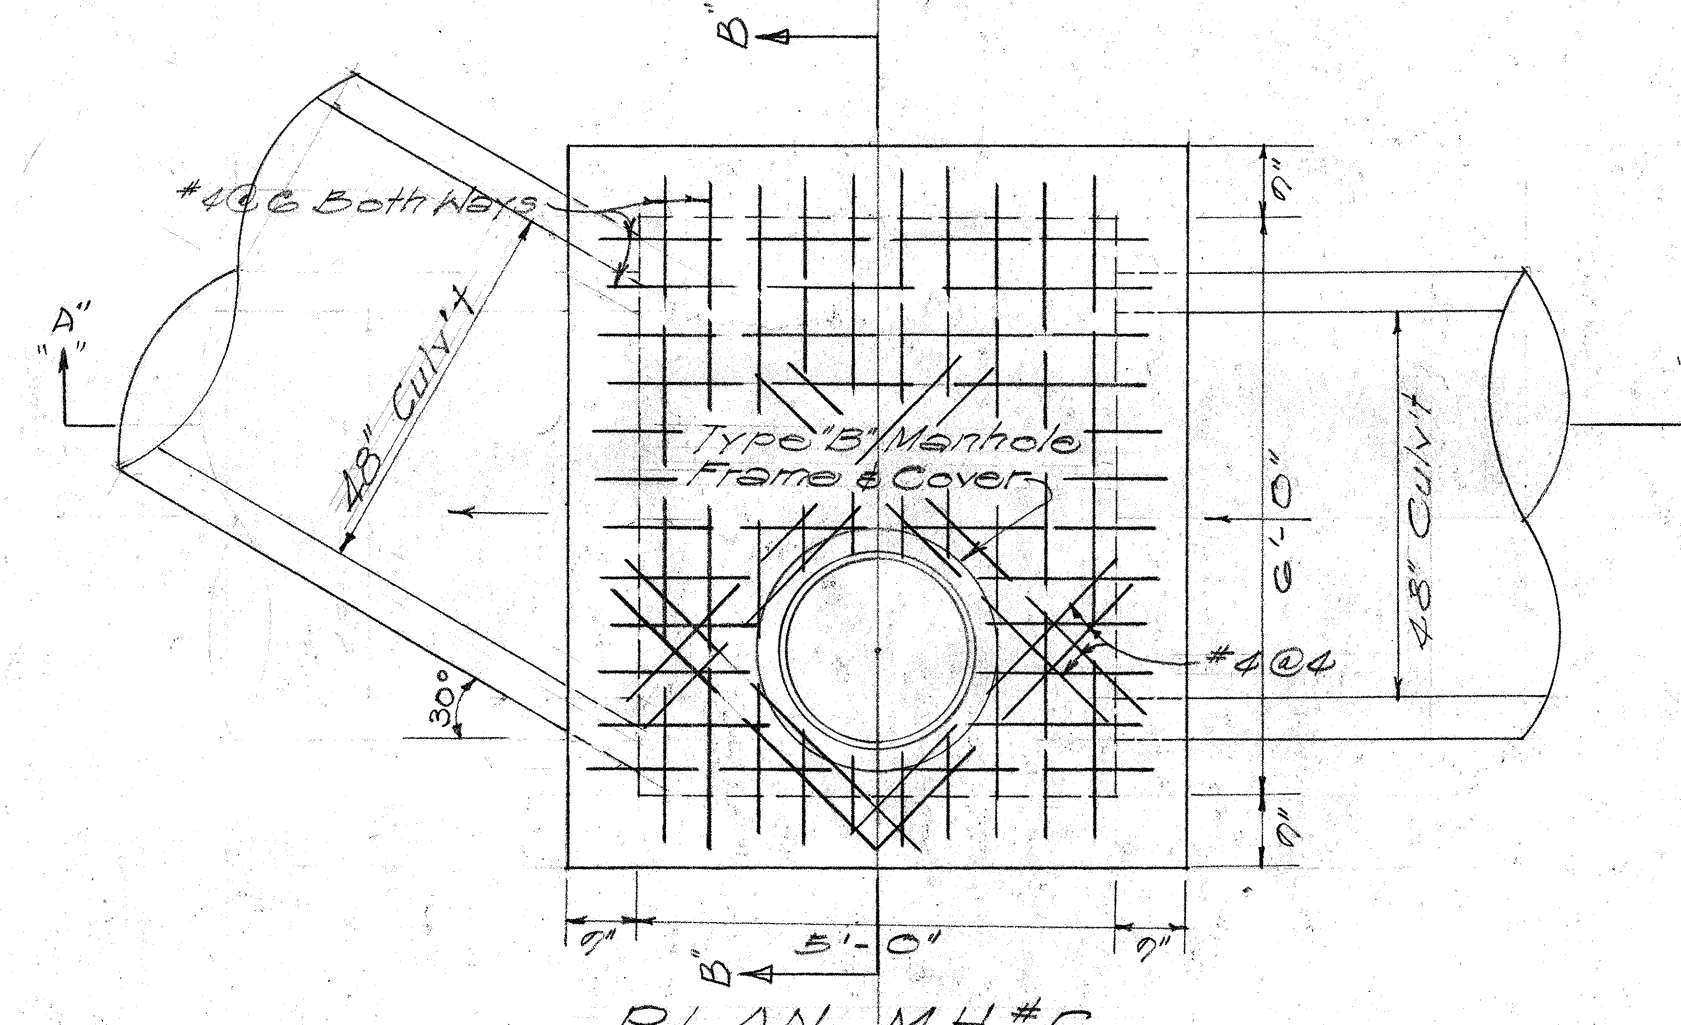

PLAN M.H.#6

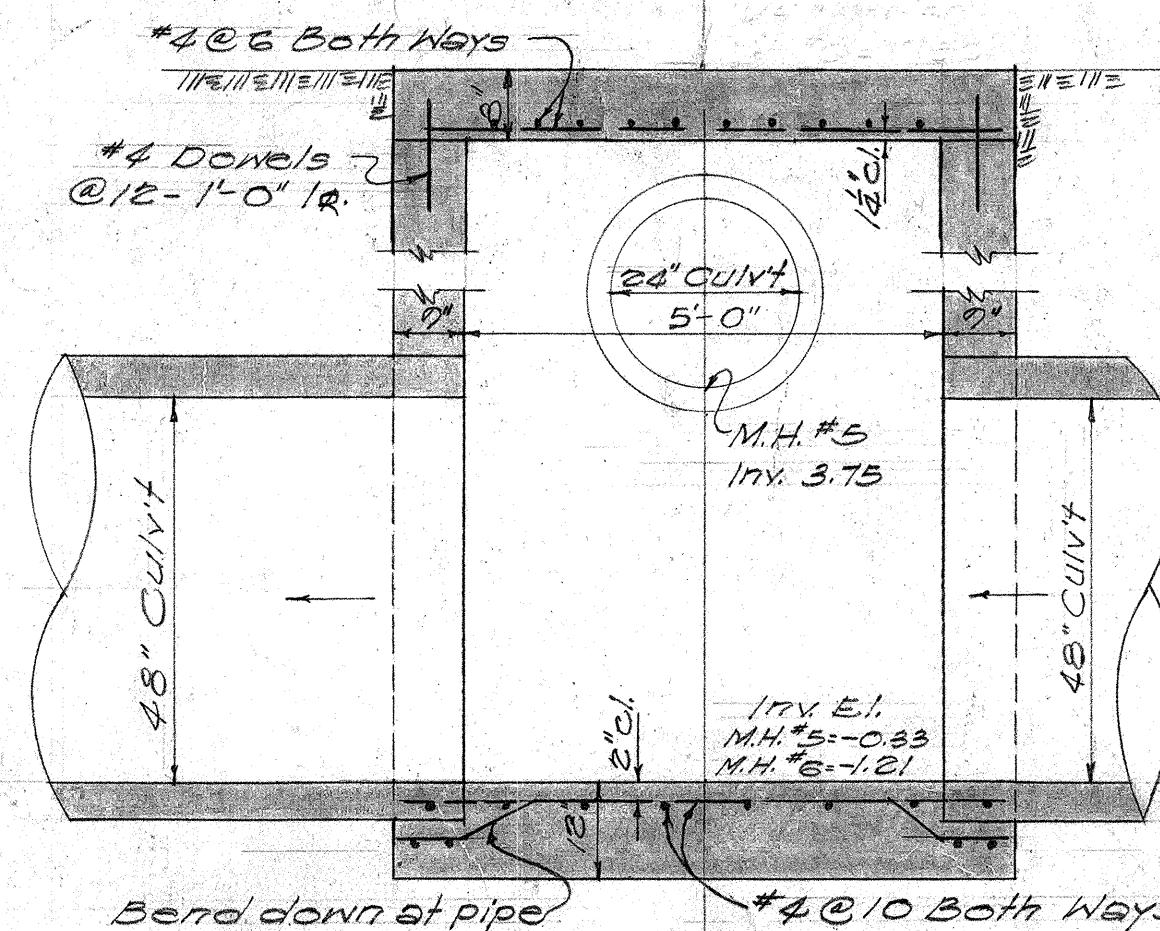

SECTION A-A
M.H.#5 & 6

QUANTITY SUMMARY					
M.H. No.	Struct. Exa.	A-I Conc.	Rein. Steel	M.H. Frame & Cover	
	C.Y.	C.Y.	Lbs.	Type 'A'	Type 'B'
1	38.3	3.8	140		1
2	1816.6	5.0	140		1
3	2731.3	8.1	280	1	
5	2922.7	7.8	190		1
6	4341.3	11.0	185		1

TERRITORIAL HIGHWAY DEPARTMENT
TERRITORY OF HAWAII

S.D. MANHOLES
Nos. 1, 2, 3, 5 & 6
KAHULUI BEACH ROAD
KAAHUMANU AVE. - MAIN ST.
PROJ. NO. S-0340 (1)
PROJ. NO. F-032 (2)
Scale: 1" = 1'-0" May, 1955

SHEET NO. 2 OF 2 SHEETS

5747.9

5748.9