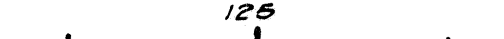
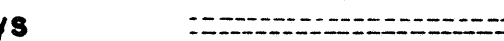
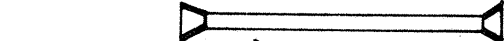
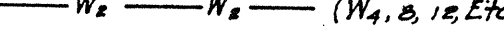
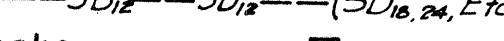
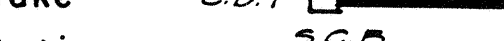
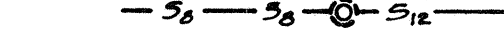


INDEX TO DRAWINGS	
SHEET NO	DESCRIPTION
1	TITLE SHEET
2	TYPICAL SECTION
3	PLAN & PROFILE
4 - 7	INTERSECTION DETAILS
8 - 9	DRAINAGE SYSTEM
10	RAILROAD RELOCATION
11 - 12	TRAFFIC SIGNS & SIGNAL SYSTEM
13	LIGHTING SYSTEM
14 - 21	STANDARD DETAILS
22 - 27	CROSS SECTIONS

CONVENTIONAL SIGNS

Centerline	
Boundary Lines	
Fences (Named)	
Existing Roadways	
Circular Culvert	
Box Culvert	
Bridge	
Telephone Pole	
Electric Power Pole	
Water Main	
Storm Drain	
Concrete Drop Intake	
Standard Catch Basin	
Standard Manhole	
Sewer Manhole	
Telephone Manhole	
Fire Hydrant	
Trees (Named)	
Railroad	

TERRITORY OF HAWAII TERRITORIAL HIGHWAY DEPARTMENT HONOLULU, T. H.


PLANS OF KAAHUMANU AVENUE—MAIN STREET

FEDERAL AID PROJECT NO. F 032 (2)

DISTRICT OF WAILUKU
ISLAND OF MAUI

SCALE

PLAN	1 IN. = 50 FT.
PROFILE	HOR. 1 IN. = 50 FT. VER. 1 IN. = 10 FT.
X-SECTIONS	HOR. 1 IN. = 10 FT. VER. 1 IN. = 10 FT.

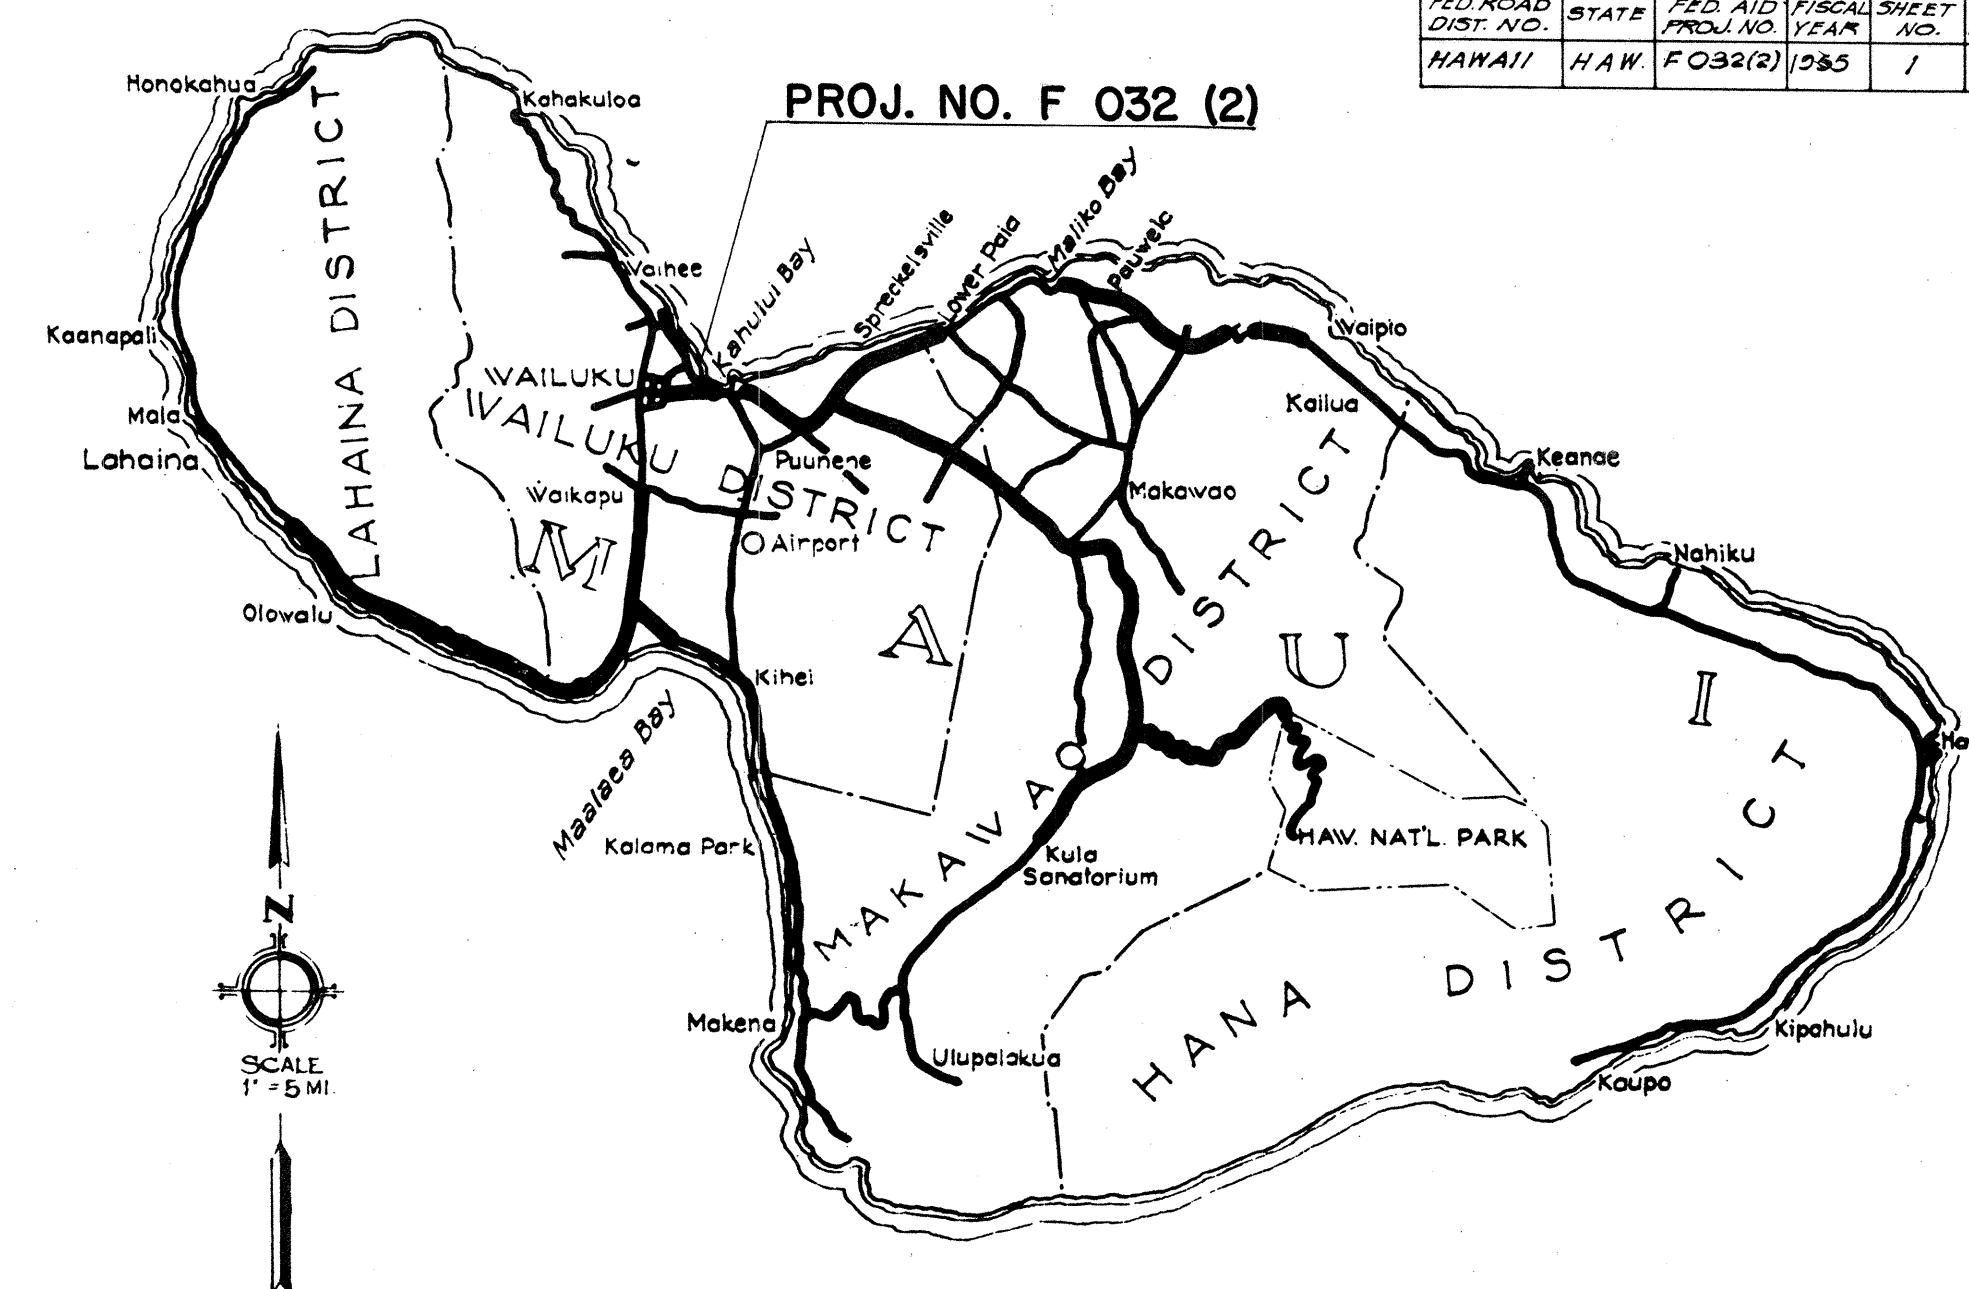

LOCATION MAP

Federal Aid Projects previously constructed or under construction.

NOTE:


ALL CHANGES MADE DURING CONSTRUCTION
HAVE BEEN NOTED IN RED ON THESE
TRACINGS AND CHECKED BY:

R. H. O'Leary
DISTRICT ENGINEER

1/23/57
DATE

APPROVED: _____ DATE _____
R. E. Hutton
TERRITORIAL HIGHWAY ENGINEER

DEPARTMENT OF COMMERCE BUREAU OF PUBLIC ROADS	
APPROVED: _____	
DISTRICT ENGINEER	DATE

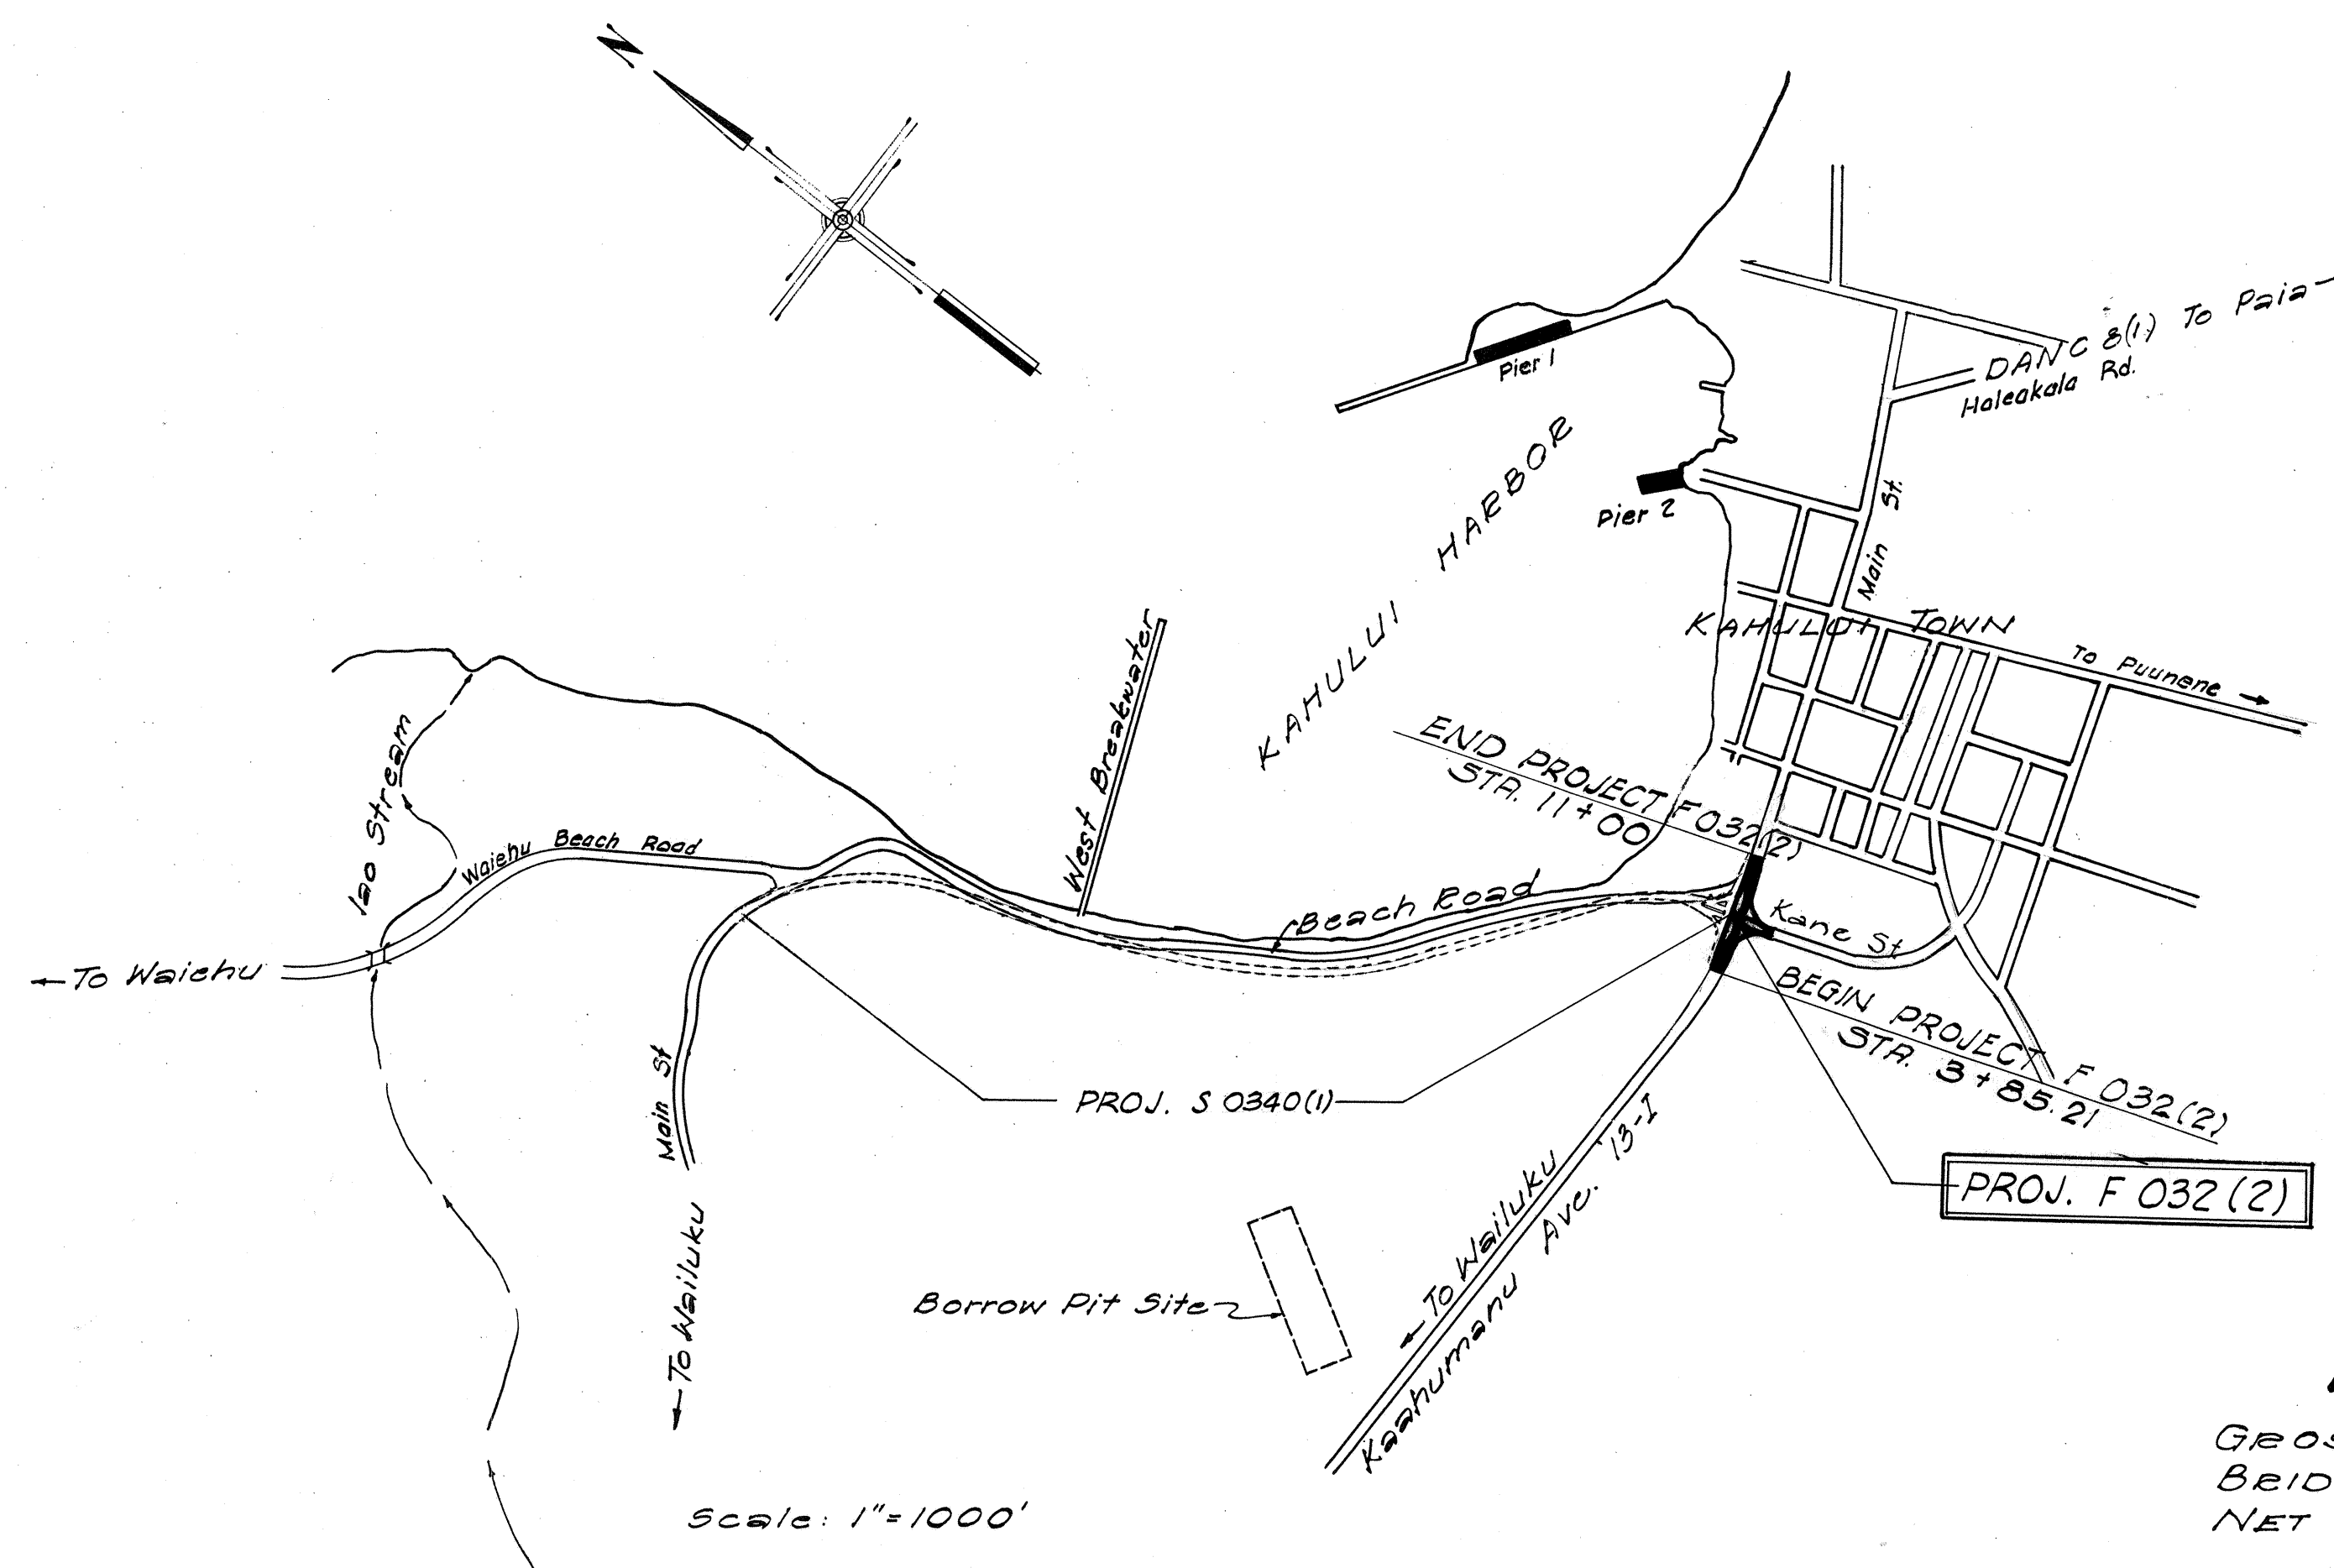

LAYOUT OF PROJECT

GROSS LENGTH OF PROJECT = 0.135 mi.
BRIDGES = 0
NET LENGTH OF PROJECT = 0.135 mi.