

KAHULUI MAIN STREET
IND. RAILROAD TRACK
STA. 10+78-31+76.62

FED. ROAD DIST. No.	STATE	FED. AID PROJ. No.	FISCAL YEAR	SHEET No.	TOTAL SHEETS
HAWAII	HAW.	F032-100	1957	26	33



PLATE 3 CROSS SECTION O. P. R. & R. E. STANDARD.
100% RAB PAPER-MADE AND PRINTED IN U. S. A.
EUGENE DIEZSEN CO.

Exc = 250 c.y.
Emb = 41 c.y.
SB = 104 c.y.

Exc = 416 c.y.
Emb = 88 c.y.
SB = 92 c.y.

Exc = 123 c.y.
Emb = 31 c.y.
SB = 75 c.y.

Exc = 160 c.y.
Emb = 21 c.y.
SB = 66 c.y.

Exc = 142 c.y.
Emb = 1 c.y.
SB = 61 c.y.

Exc = 84 c.y.
Emb = 2 c.y.
SB = 38 c.y.

Exc = 32 c.y.
Emb = 2 c.y.
SB = 13 c.y.

Exc = 28 c.y.
Emb = 1 c.y.
SB = 7 c.y.

Exc = 11 c.y.
Emb = 0 c.y.
SB =

C = 128 f
F = 37 f
SB = 56 f

C = 122 f
F = 10 f
SB = 43 f

C = 72 f
F = 23 f
SB = 37 f

C = 24 f
F = 0 f
SB = 34 f

C = 67 f
F = 1 f
SB = 31 f

C = 24 f
F = 1 f
SB = 10 f

C = 18 f
F = 1 f
SB = 4 f

C = 12 f
F = 0 f
SB = 4 f

C = 0
F = 0

Exc = 102 c.y.
Emb = 44 c.y.
SB = 113 c.y.

Exc = 118 c.y.
Emb = 37 c.y.
SB = 115 c.y.

Exc = 168 c.y.
Emb = 24 c.y.
SB = 123 c.y.

Exc = 210 c.y.
Emb = 8 c.y.
SB = 138 c.y.

Exc = 244 c.y.
Emb = 8 c.y.
SB = 132 c.y.

Exc = 252 c.y.
Emb = 17 c.y.
SB = 115 c.y.

Exc = 212 c.y.
Emb = 42 c.y.
SB = 109 c.y.

Exc = 251 c.y.
Emb = 32 c.y.
SB = 104 c.y.

Exc = 304 c.y.
Emb = 48 c.y.
SB = 104 c.y.

FED. ROAD DIST. No.	STATE	FED. AID PROJ. No.	FISCAL YEAR	SHEET No.	TOTAL SHEETS
HAWAII	HAW.	F032-1(1)	1957	27	33

MAIN STREET
KAHULU

C = 48 f
F = 23 f
SB = 64 f

C = 72 f
F = 17 f
SB = 64 f

C = 102 f
F = 2 f
SB = 69 f

C = 125 f
F = 0 f
SB = 80 f

C = 132 f
F = 2 f
SB = 62 f

C = 141 f
F = 0 f
SB = 62 f

C = 95 f
F = 44 f
SB = 56 f



C = 176 f
F = 45 f
SB = 56 f

C = 152 f
F = 7 f
SB = 56 f

FED. ROAD DIST. No.	STATE	FED. AID PROJ. No.	FISCAL YEAR	SHEET No.	TOTAL SHEETS
HAWAII	HAW.	F032-1(1)	1957	28	33

DATE	BY	SURVEY	PLOTTED	NO. _____
		NOTE BOOK	TEMPLATE	
		AREAS CHECKED		


DATE	BY	ORIGINAL	PLOTTED	NO. _____
		NOTE BOOK	TEMPLATE	
		AREAS CHECKED		

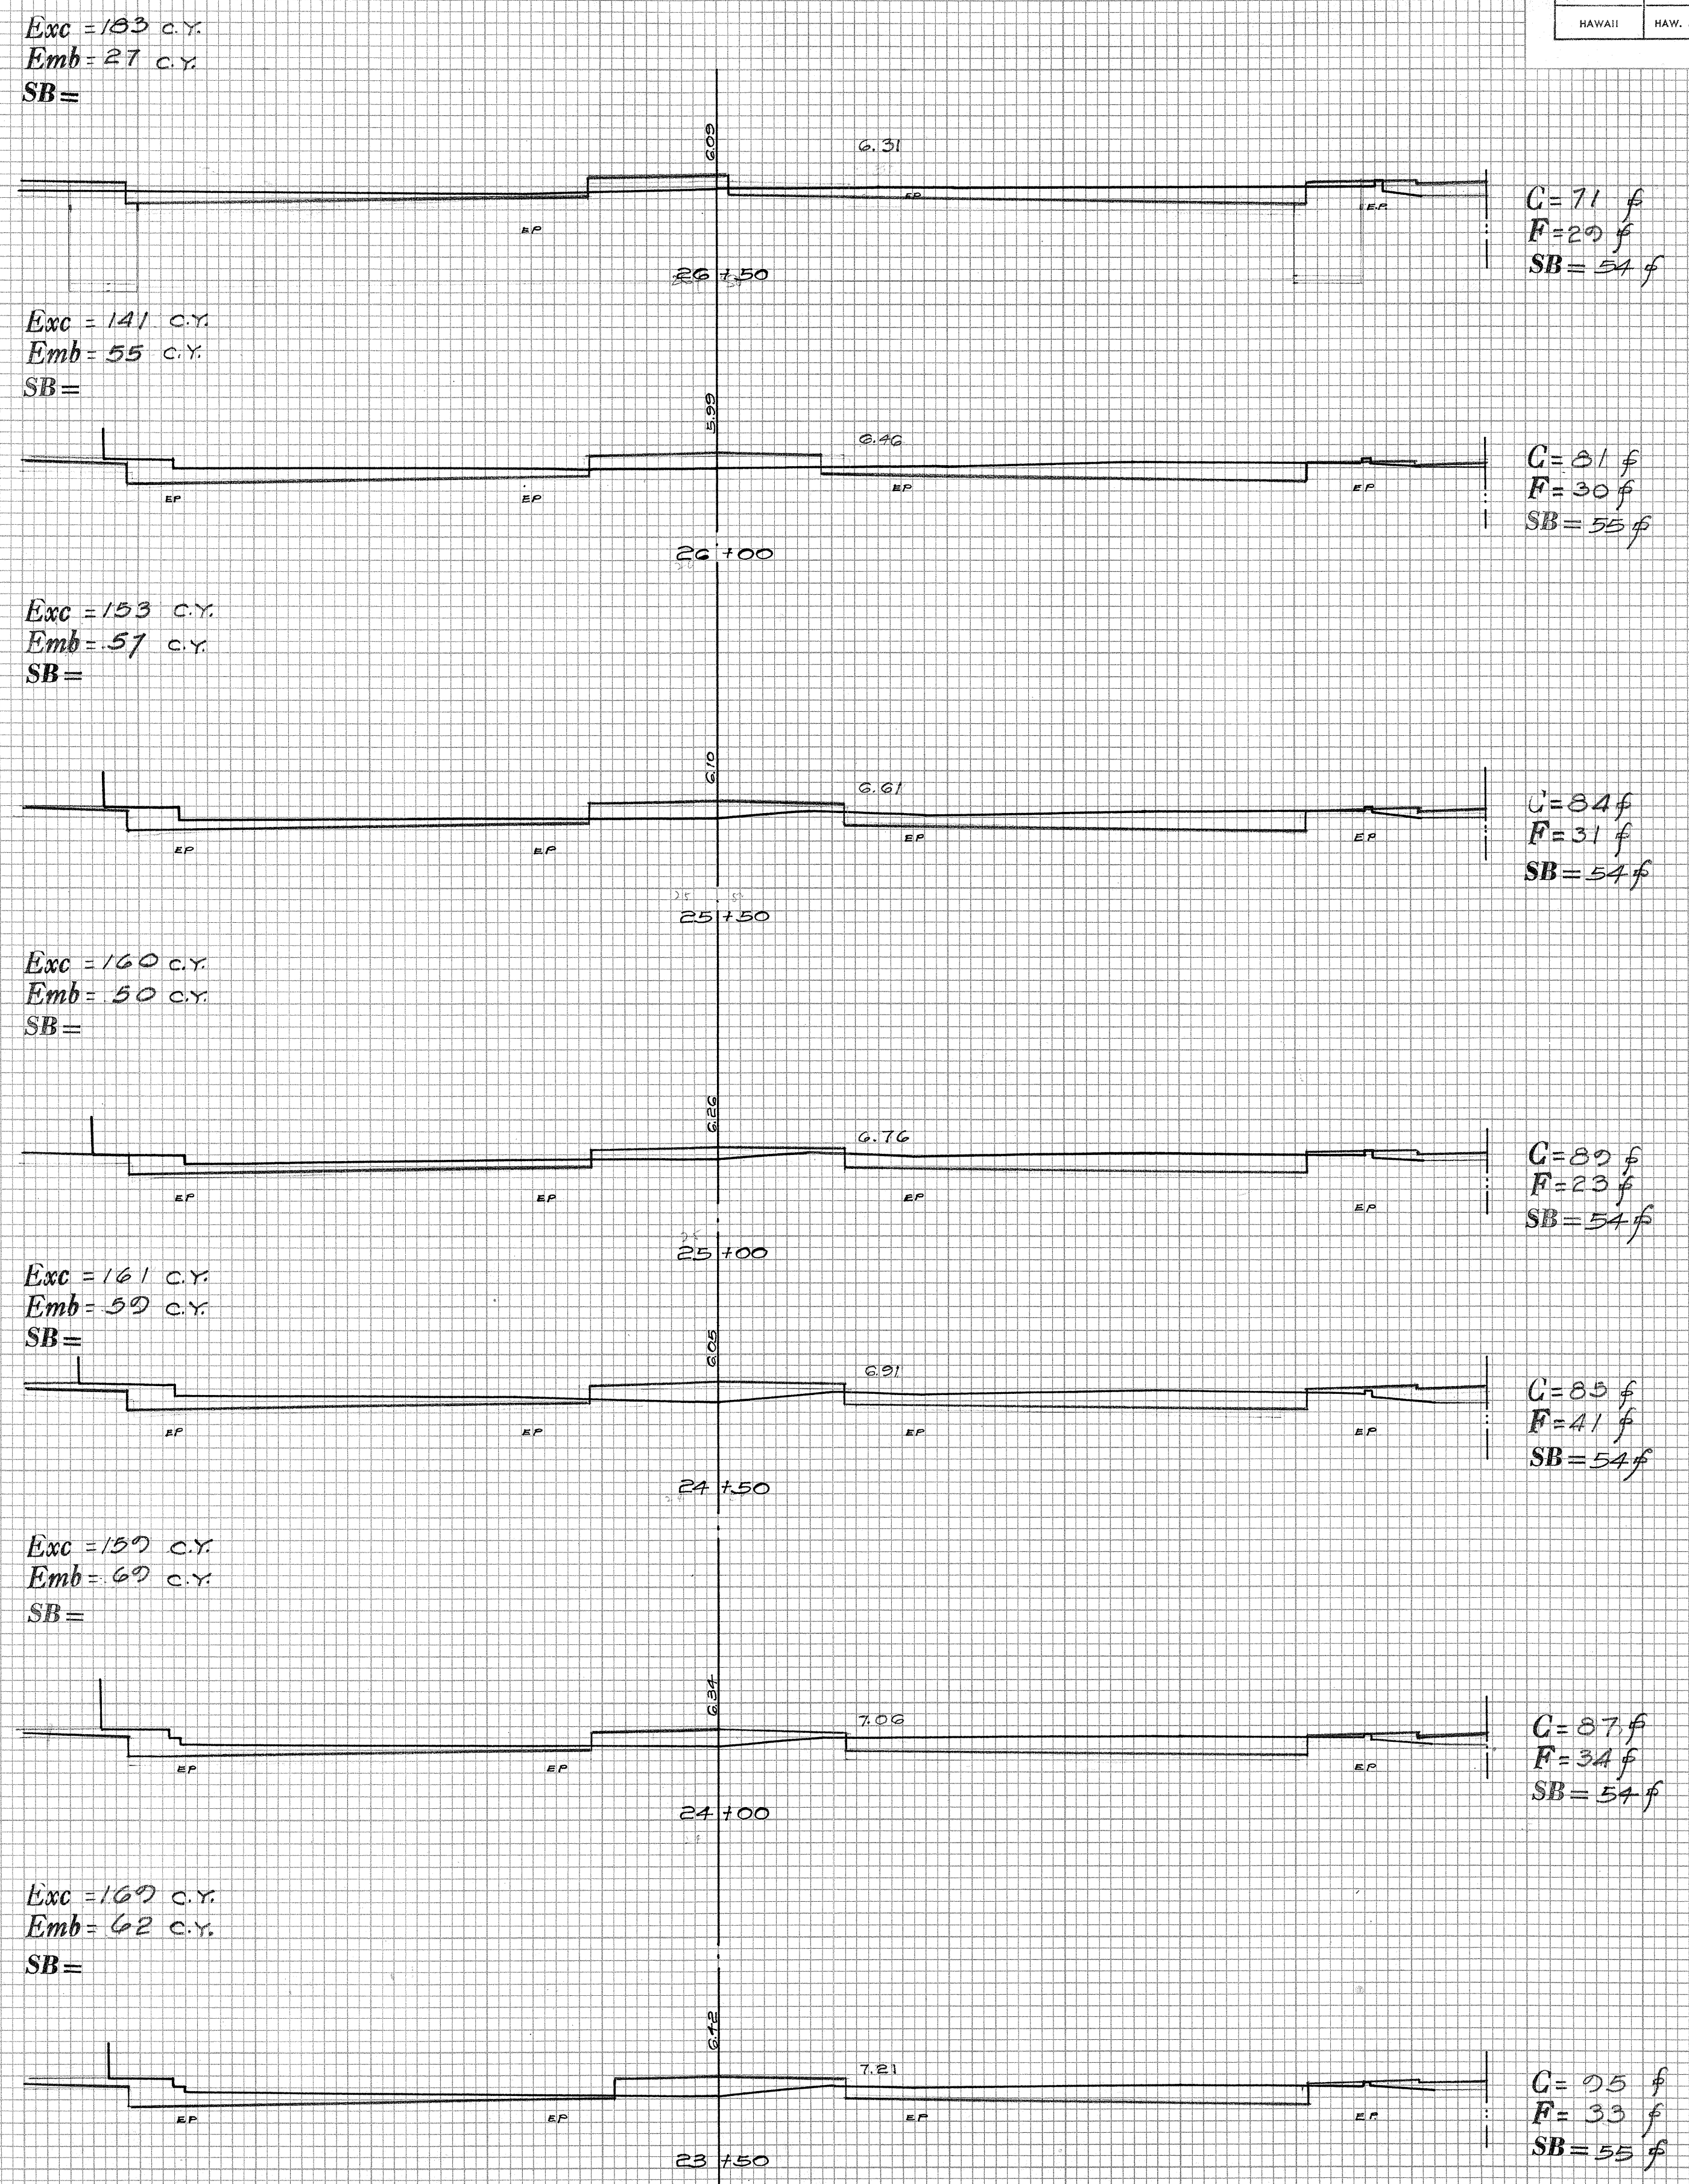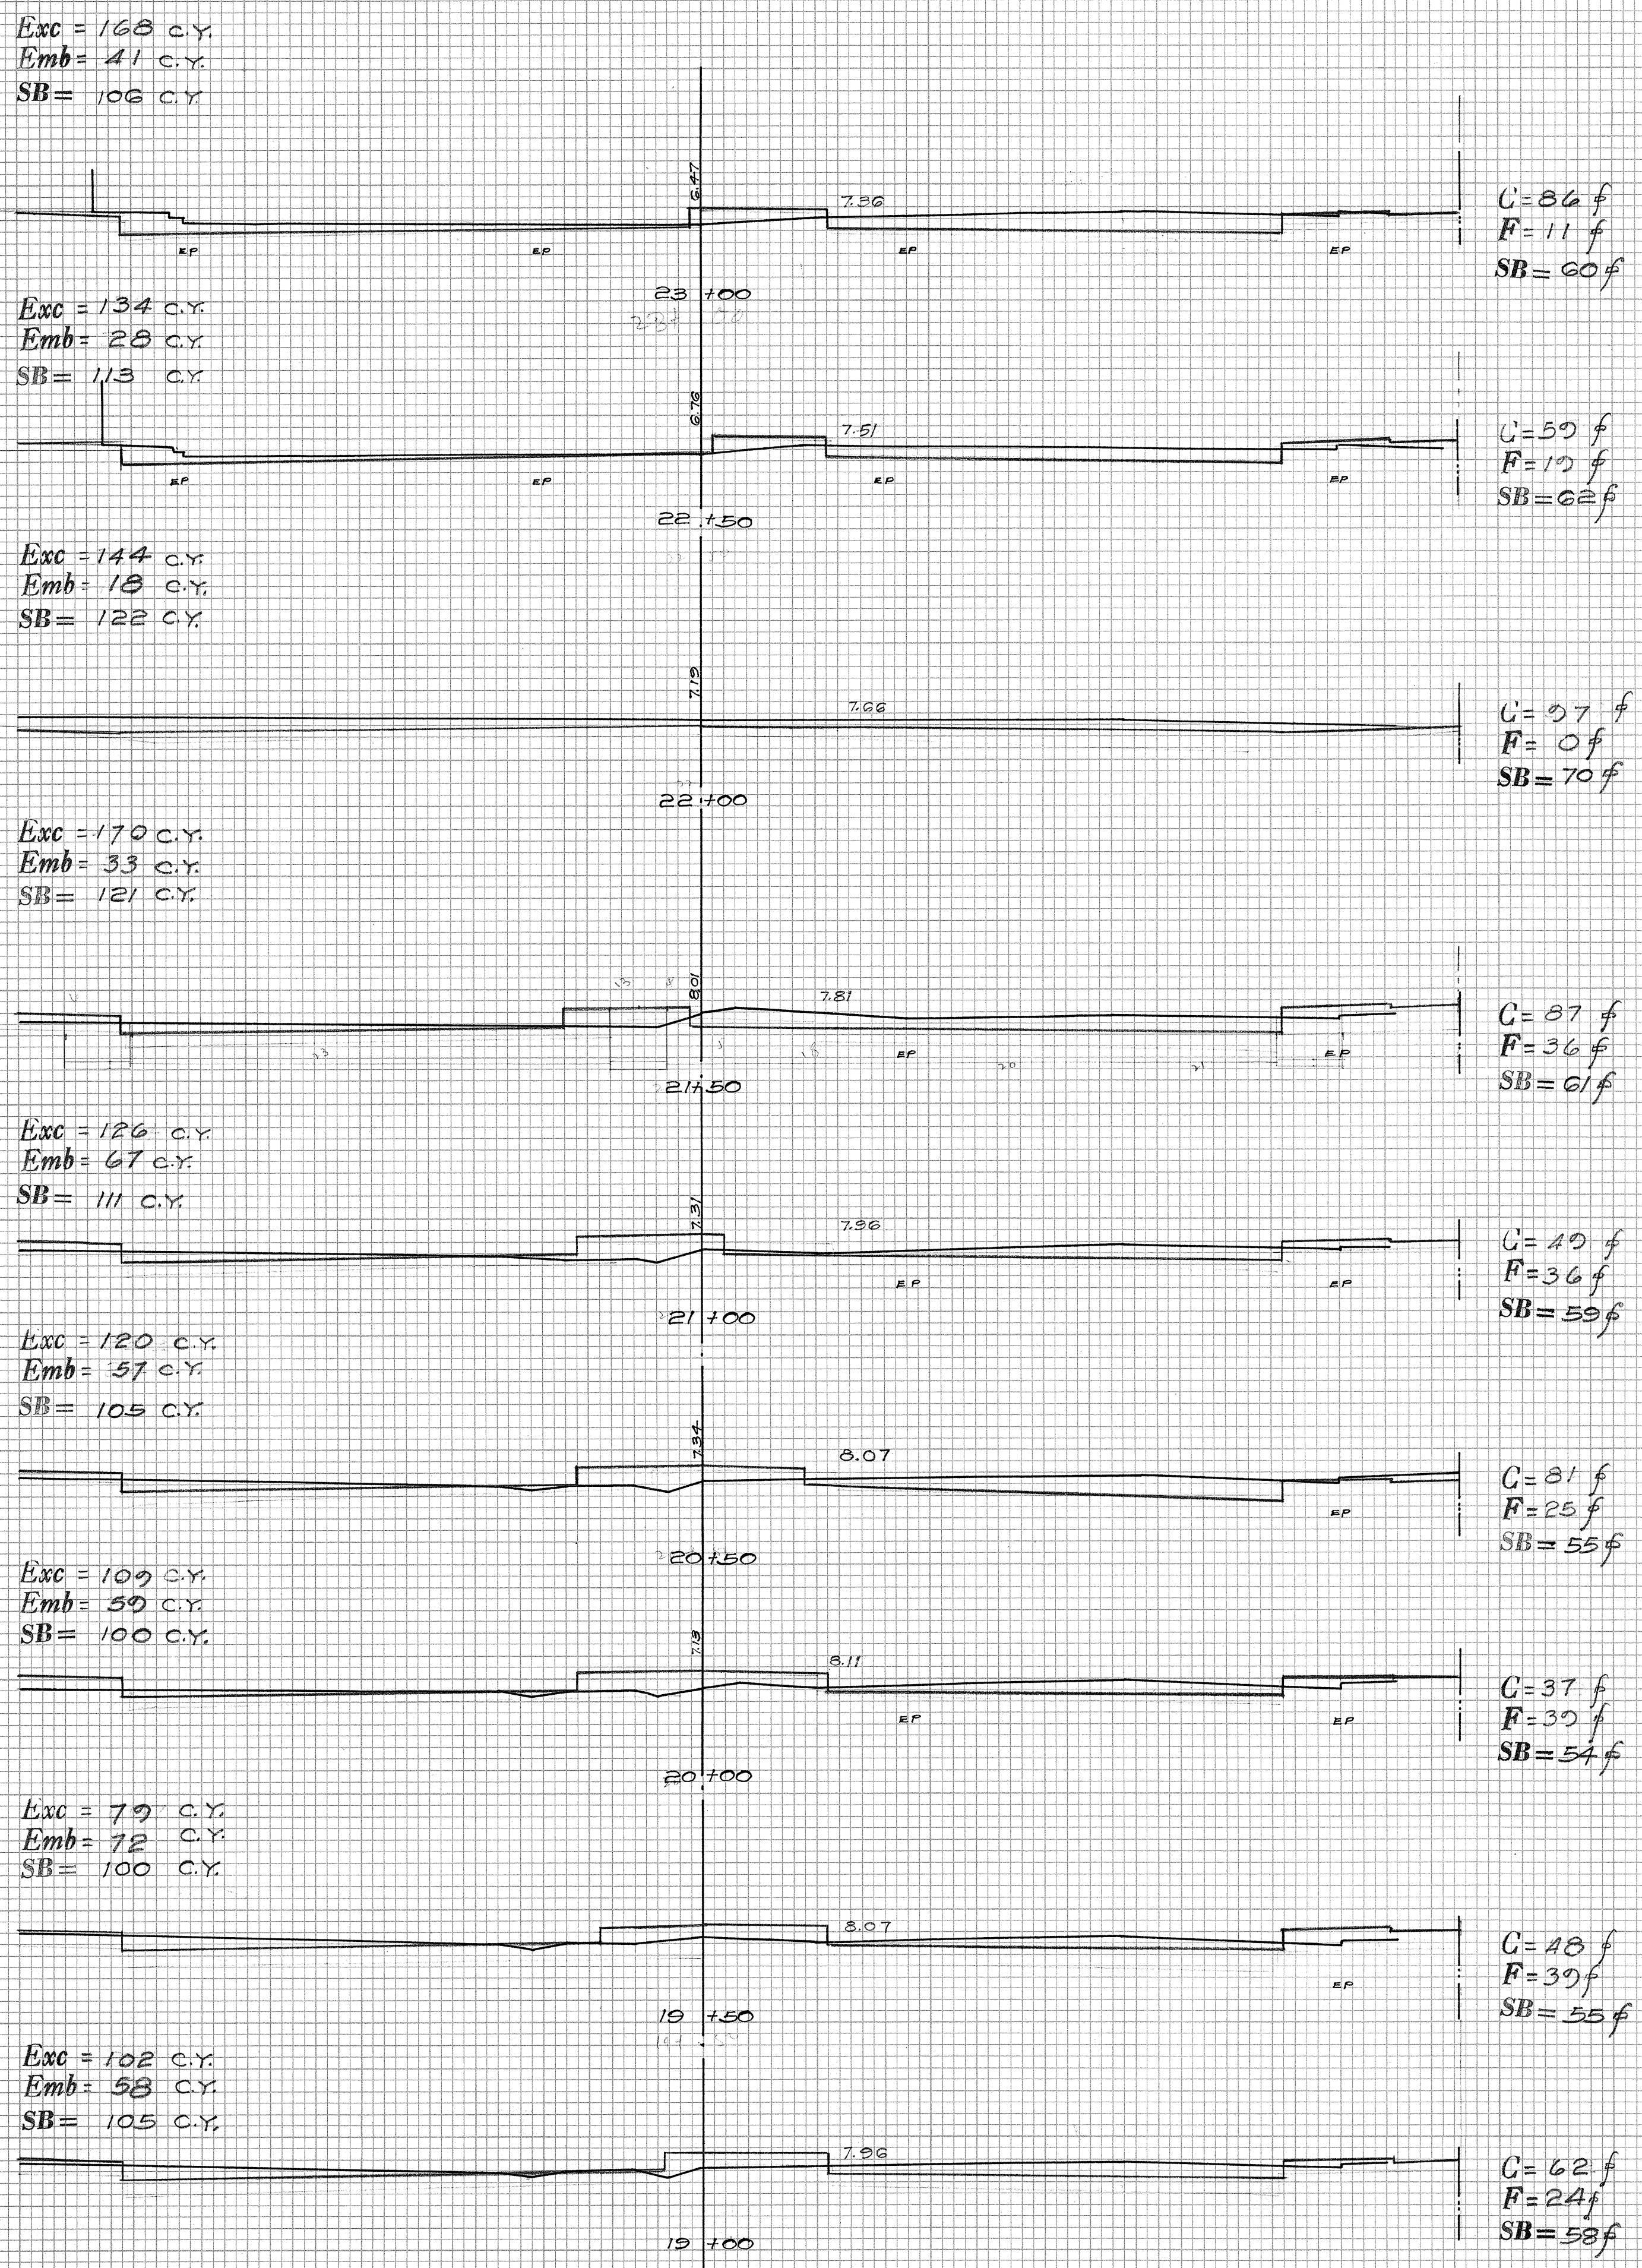

FINAL SURVEY	SURVEYED	DATE
NOTE BOOK	PLOTTED	BY
NO.	REVISION	NO.
AREAS CHECKED		

ORIGINAL SURVEY	SURVEYED	DATE
NOTE BOOK	PLOTTED	BY
NO.	REVISION	NO.
AREAS CHECKED		


FED. ROAD DIST. No.	STATE	FED. AID PROJ. No.	FISCAL YEAR	SHEET No.	TOTAL SHEETS
HAWAII	HAW.	FO32-1(1)	1957	20	33

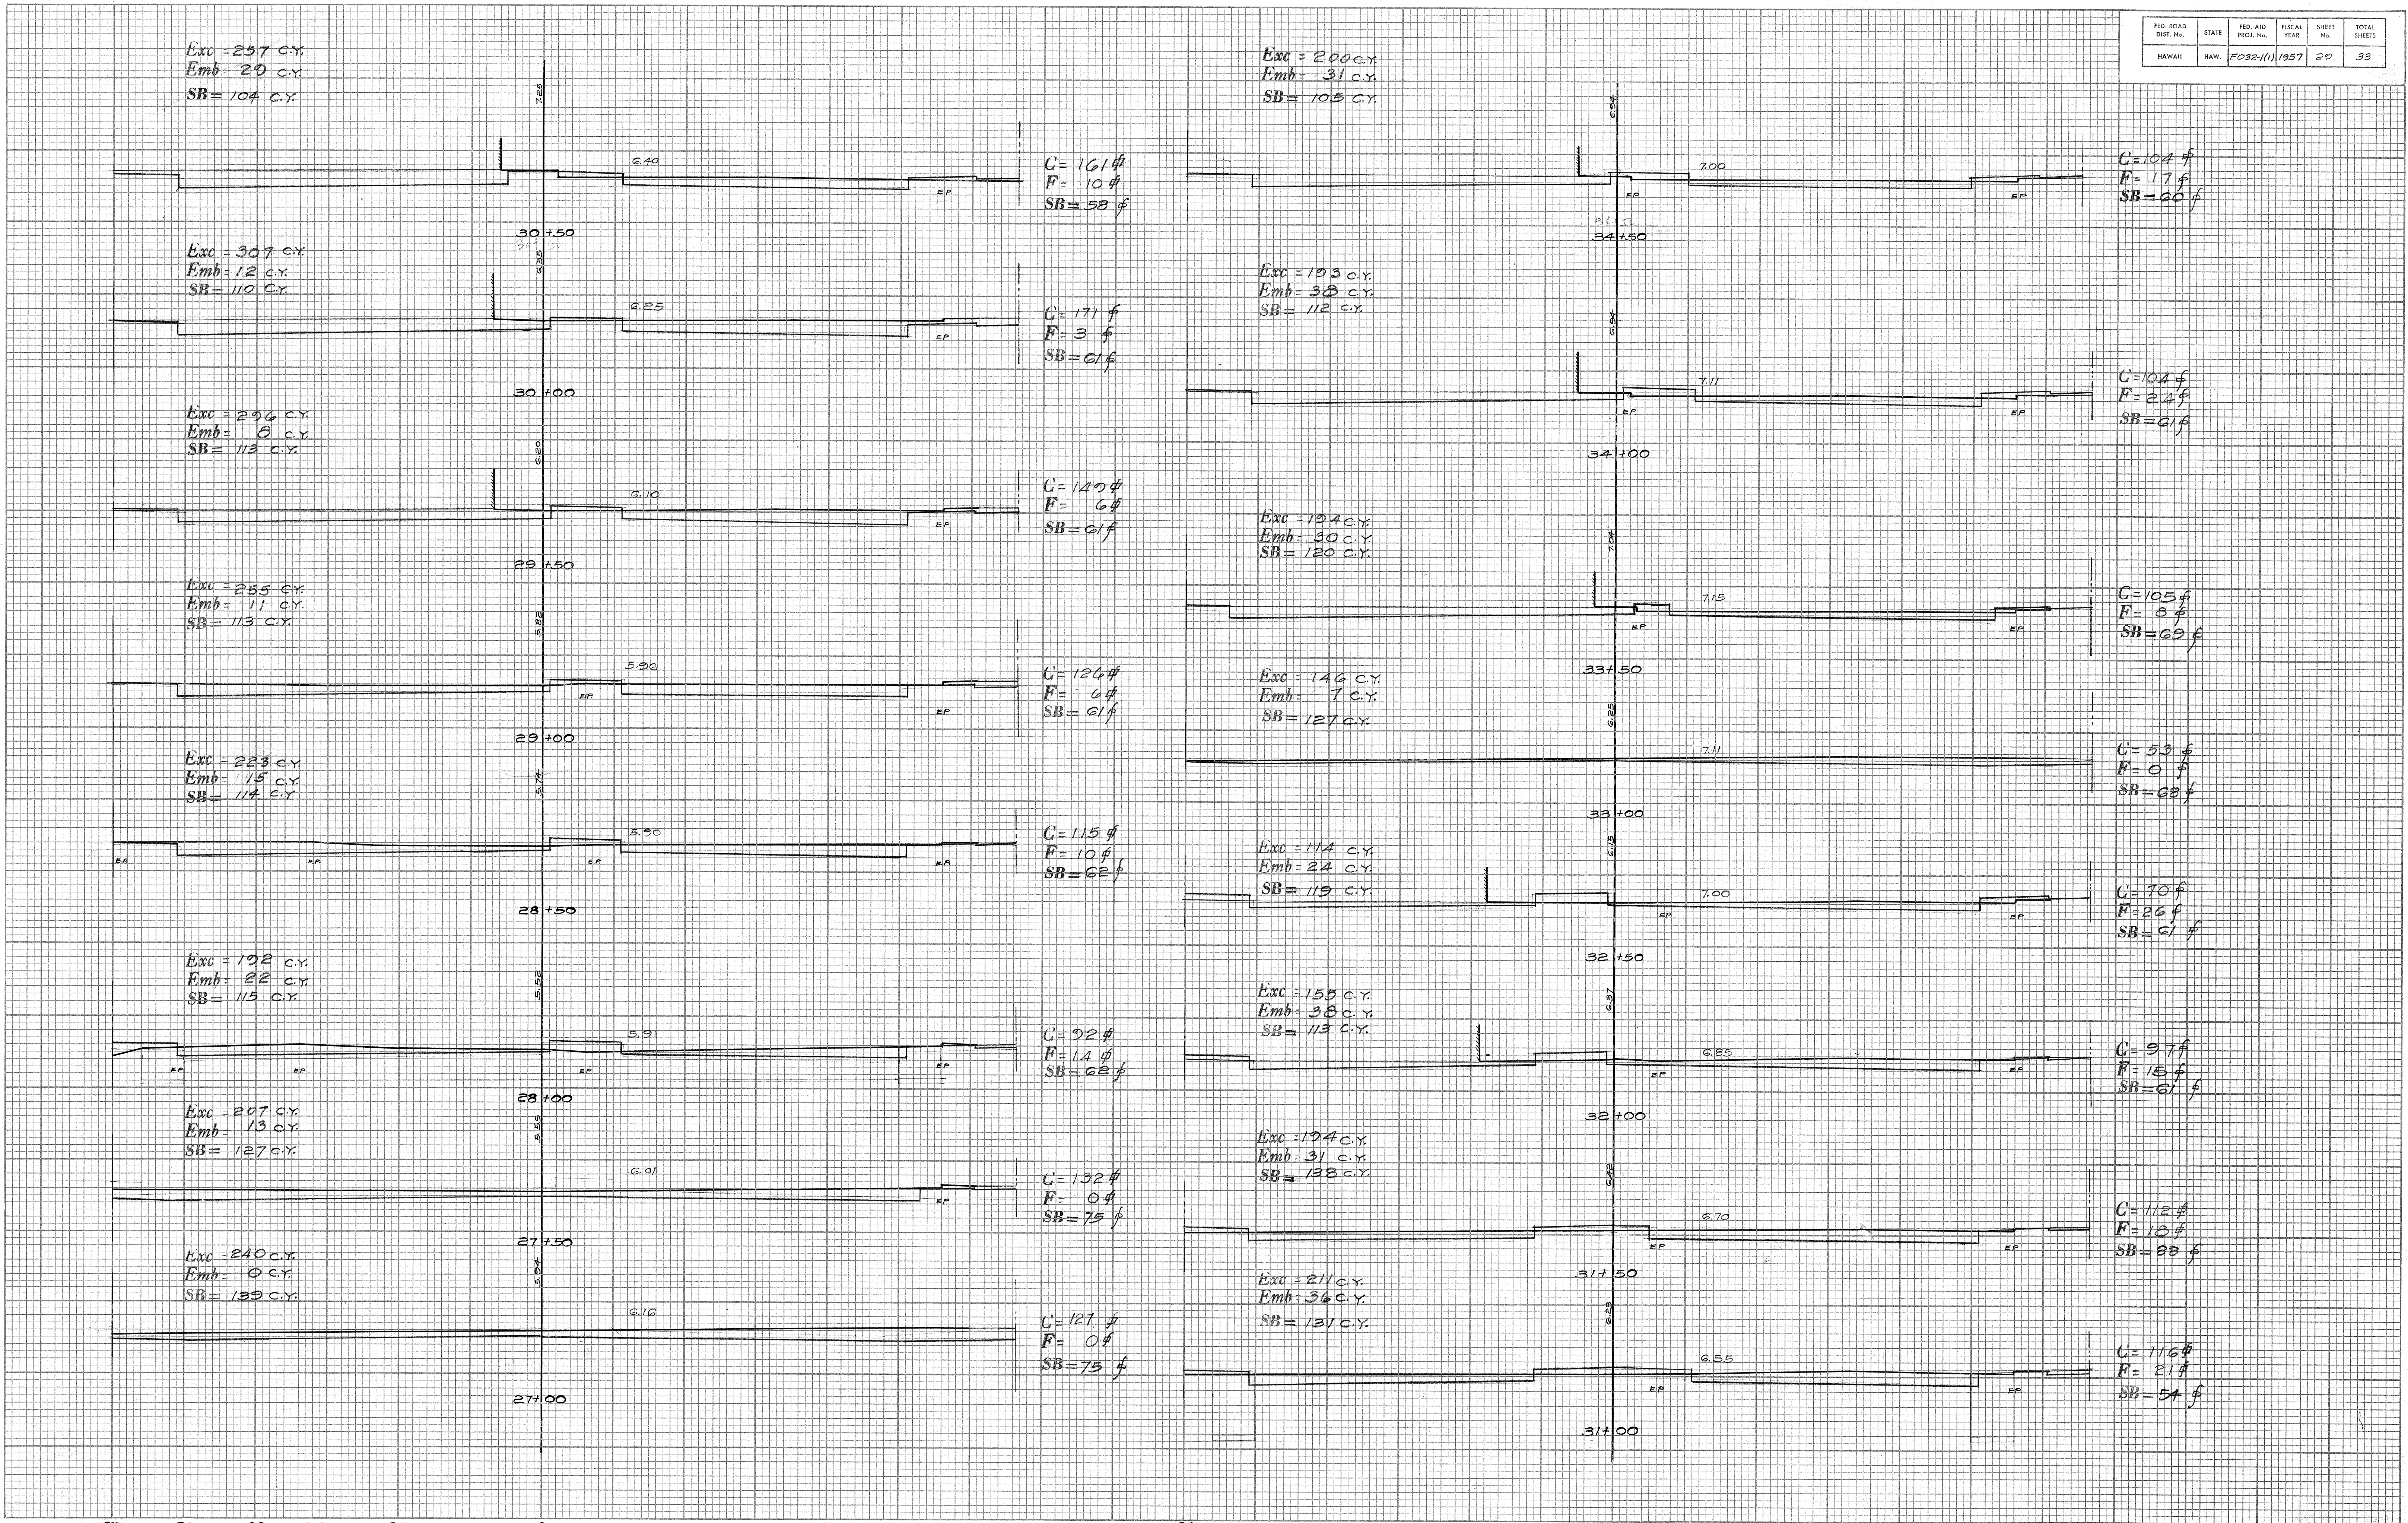

FED. ROAD DIST. No.	STATE	FED. AID PROJ. No.	FISCAL YEAR	SHEET No.	TOTAL SHEETS
HAWAII	HAW.	F032-1(1)	1957	30	33

FINAL SURVEY	BY	DATE
SURVEYED		
PLOTTED		
NOTE BOOK		
AREAS CHECKED		
NO.		

ORIGINAL SURVEY	BY	DATE
SURVEYED		
PLOTTED		
NOTE BOOK		
AREAS CHECKED		
NO.		

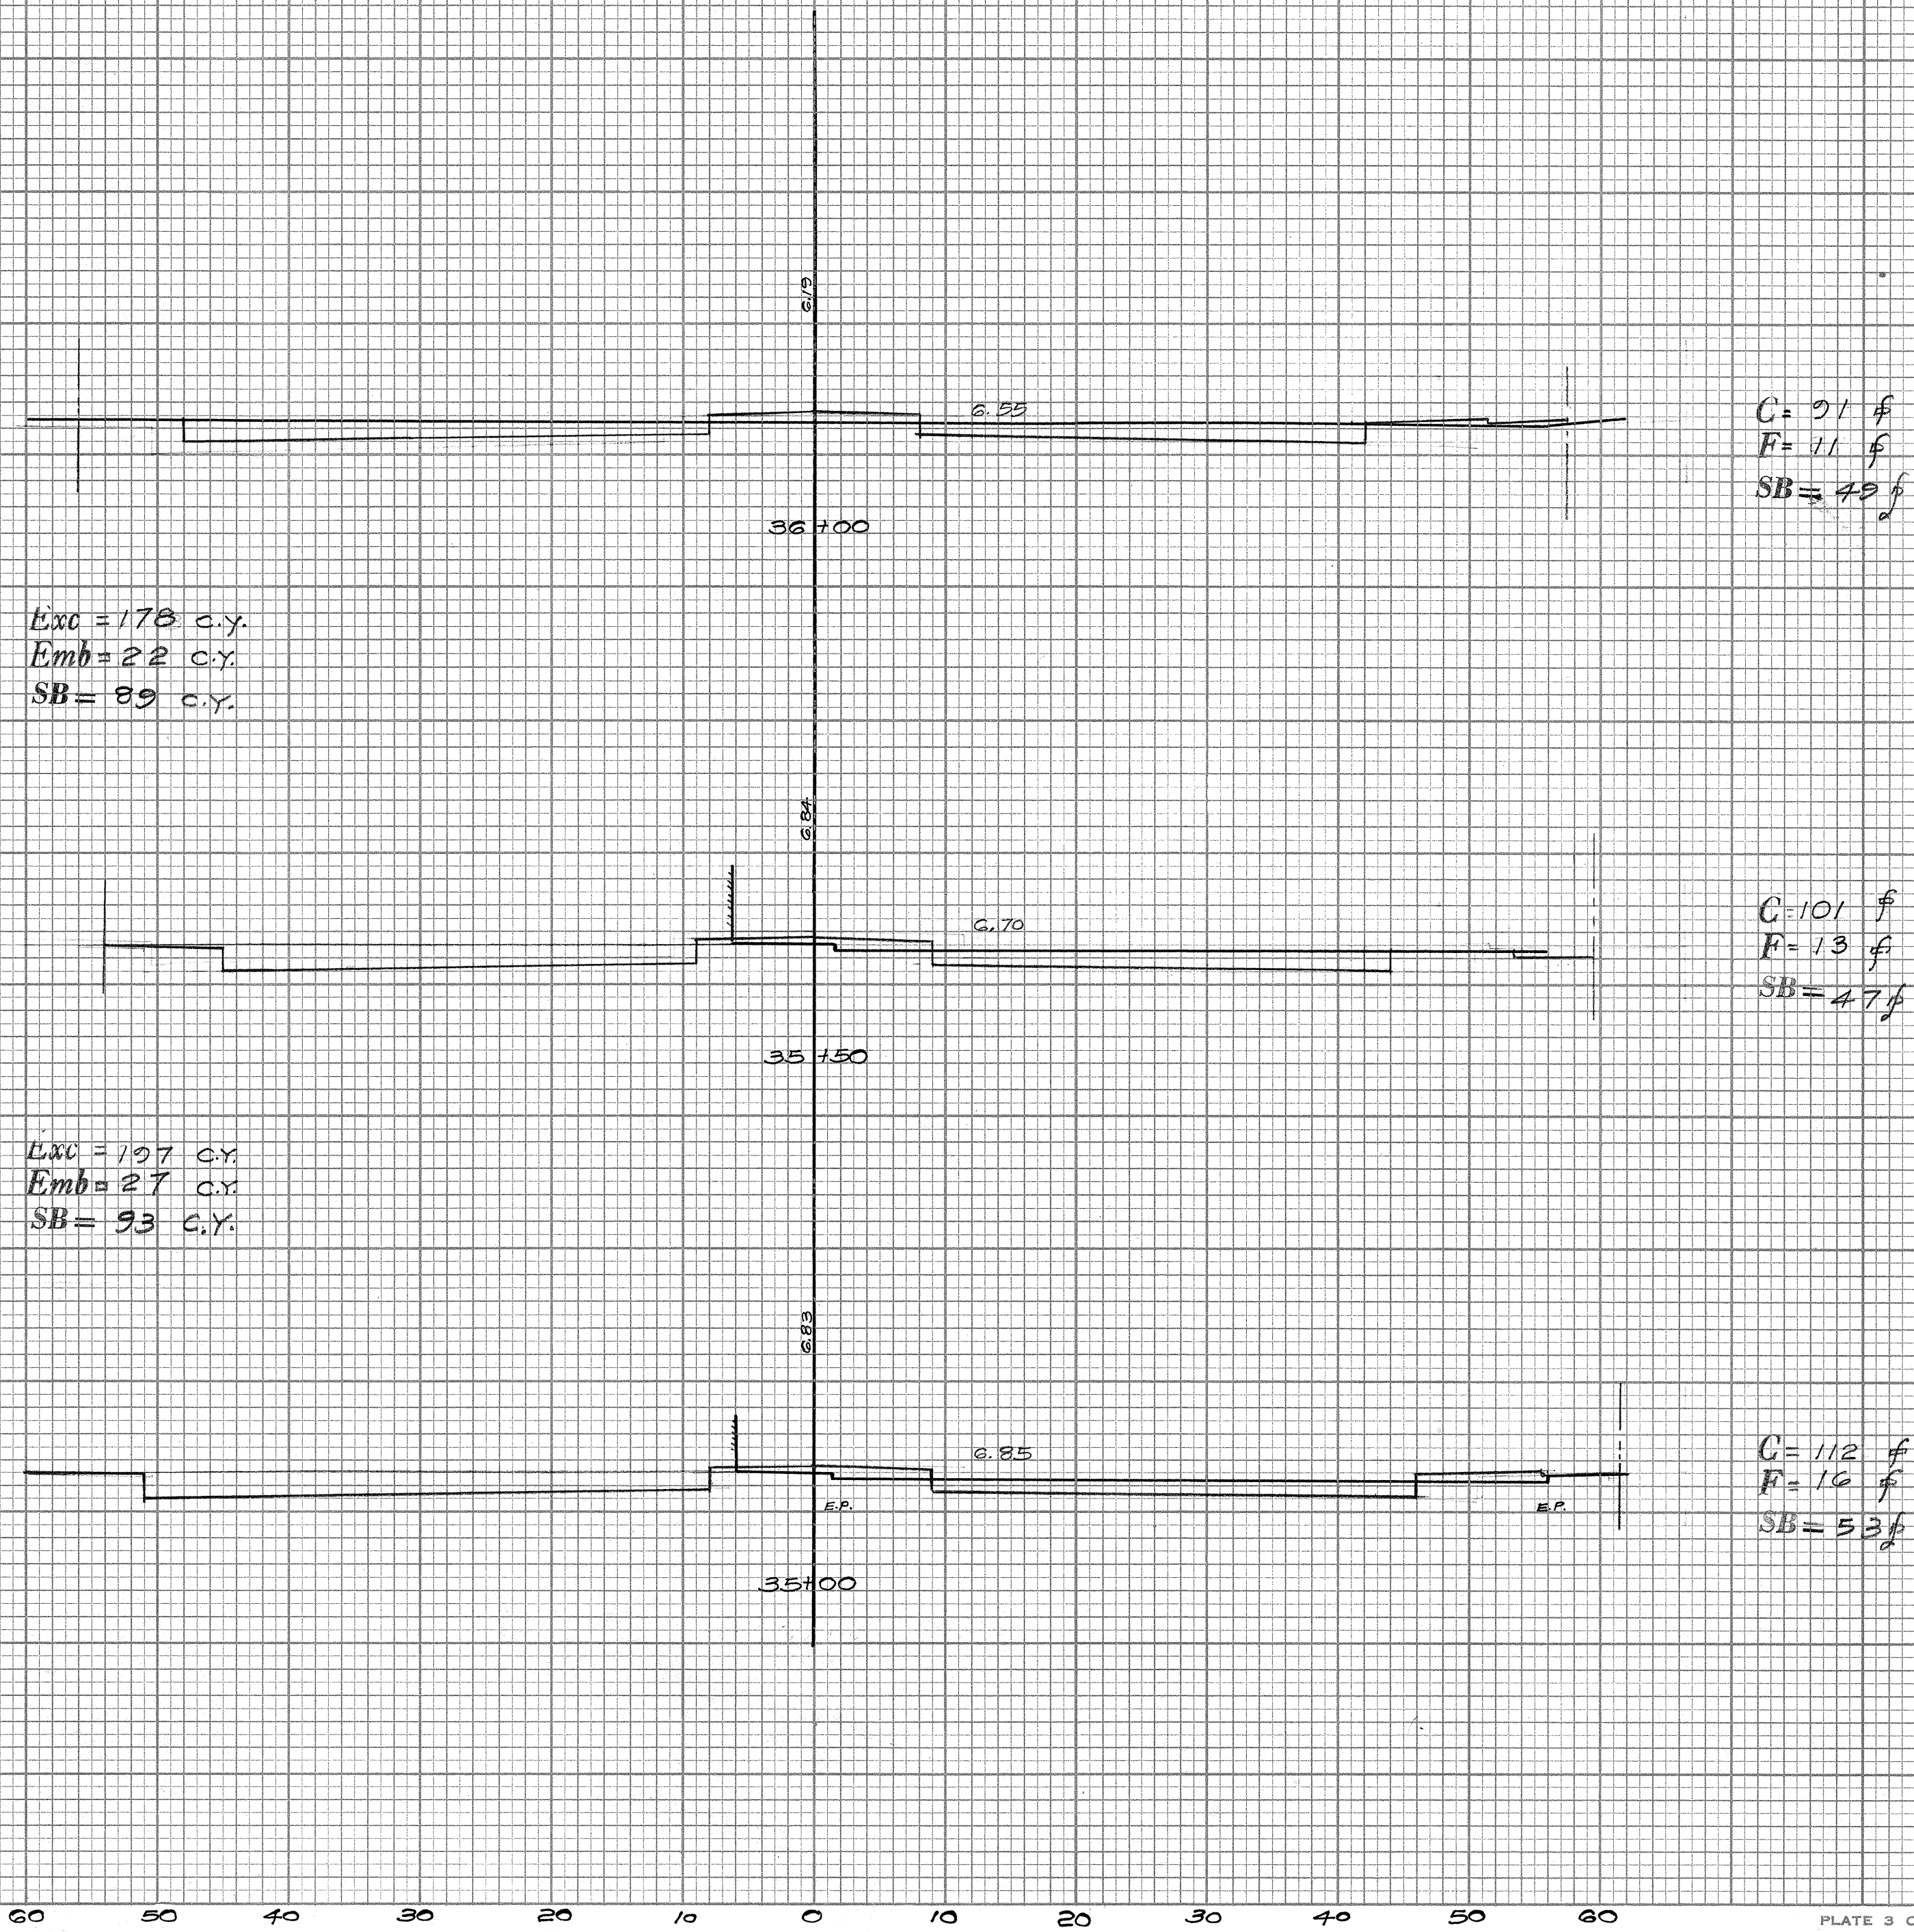

FINAL SURVEY	BY	DATE
SURVEYED		
PLOTTED		
TEMPLATE		
AREAS		
AREAS CHECKED		
NO.		

ORIGINAL SURVEY		SURVEYED _____ PLOTTED _____ TEMPLATE _____ AREAS _____ AREAS CHECKED _____	BY <i>H.G. & W.G.</i> <i>H.G.</i>	DATE <i>9-56</i> "
NOTE BOOK				
NO.				

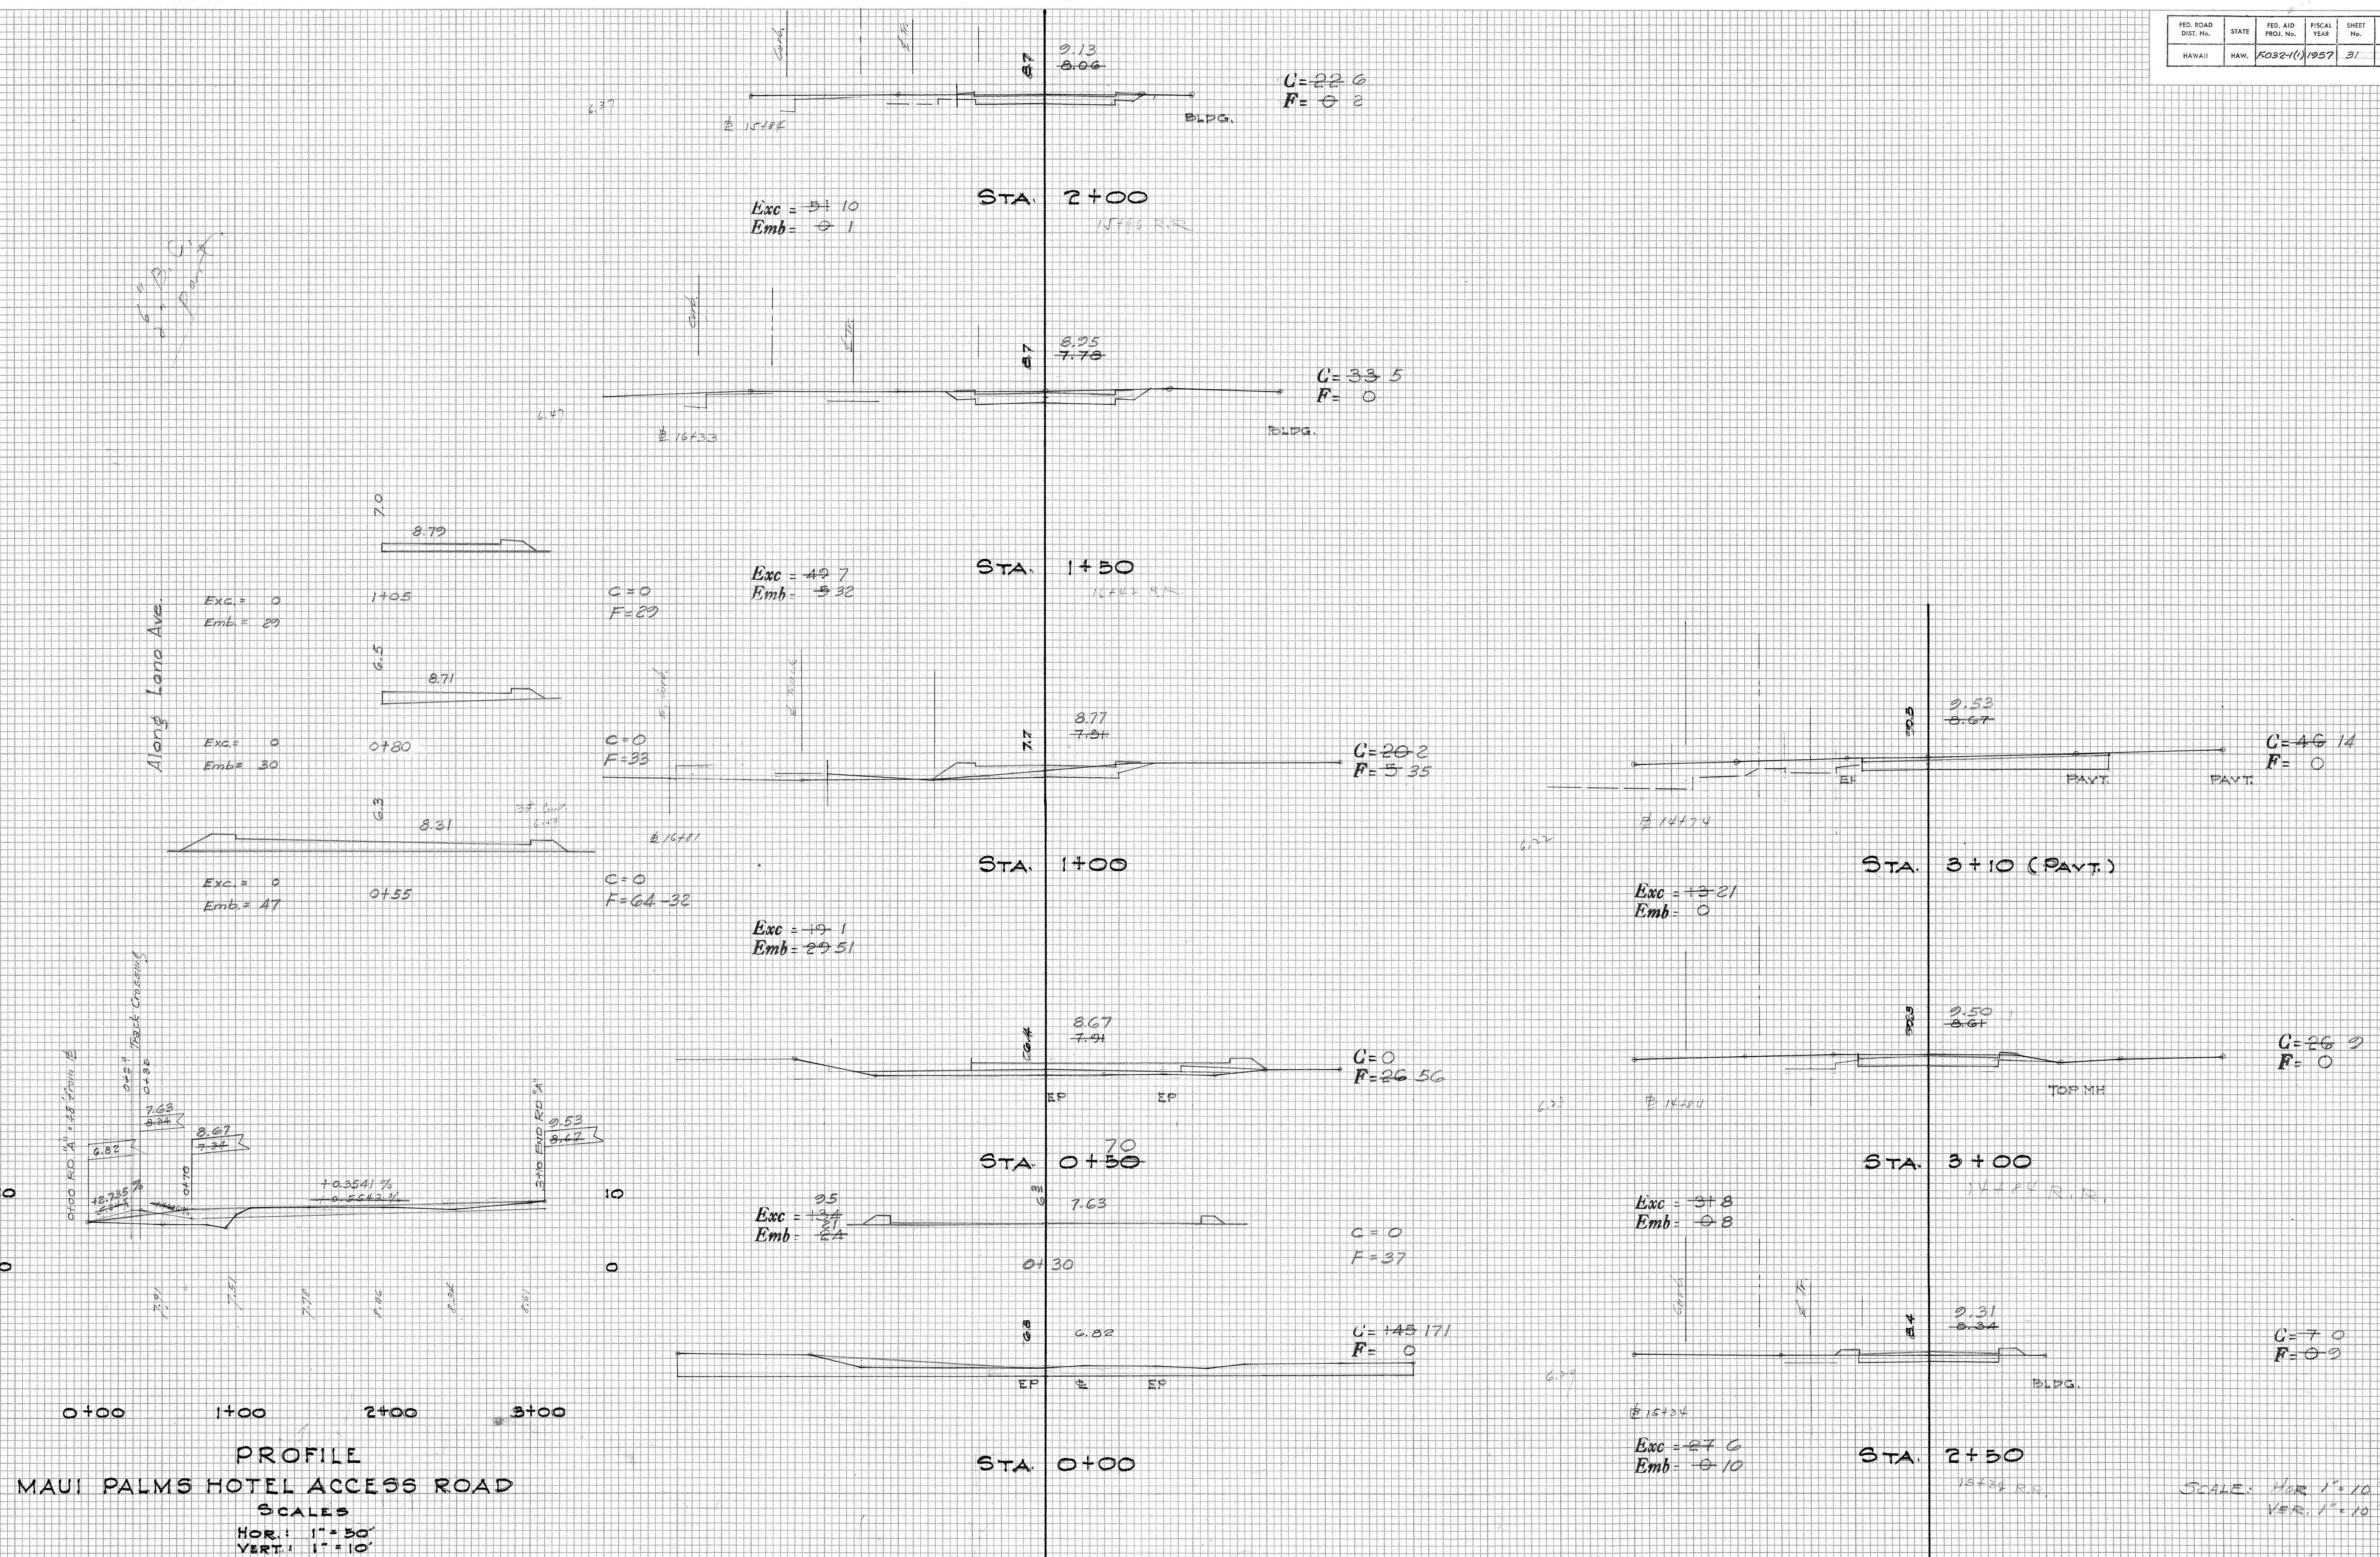


PLATE 3 CROSS SECTION O. P. R. & R. E. STANDARD
100% RAG PAPER-MADE AND PRINTED IN U. S. A.
EUGENE DIETZGEN CO.

5909.31

SHEET No. 162

FINAL SURVEY	SURVED _____	BY _____	DATE _____
	PLOTTED _____		
NOTE BOOK _____	TEMPLATE _____		
	AREAS _____		
NO. _____	AREAS CHECKED _____		

ORIGINAL SURVEY	SURVEYED _____	BY _____	DATE _____
NOTE BOOK	PLOTTED _____	<i>W. G.</i>	<i>10-50</i>
	TEMPLATE _____	<i>H. G.</i>	<i>10-50</i>
	AREAS _____		
NO. _____	AREAS CHECKED _____		





SCALES

X - SECTIONS HOR. 1" = 10'
VERT. 1" = 10'

FED. ROAD DIST. No.	STATE	FED. AID PROJ. No.	FISCAL YEAR	SHEET No.	TOTAL SHEETS
HAWAII	HAW.	F-032-101	1957	33	33

FINAL SURVEY	SURVEYED	DATE
NOTE BOOK	PLOTTED	BY
NO.	TEMPLATE	
	AREAS CHECKED	

ORIGINAL SURVEY	SURVEYED	DATE
NOTE BOOK	PLOTTED	BY
NO.	TEMPLATE	
	AREAS CHECKED	

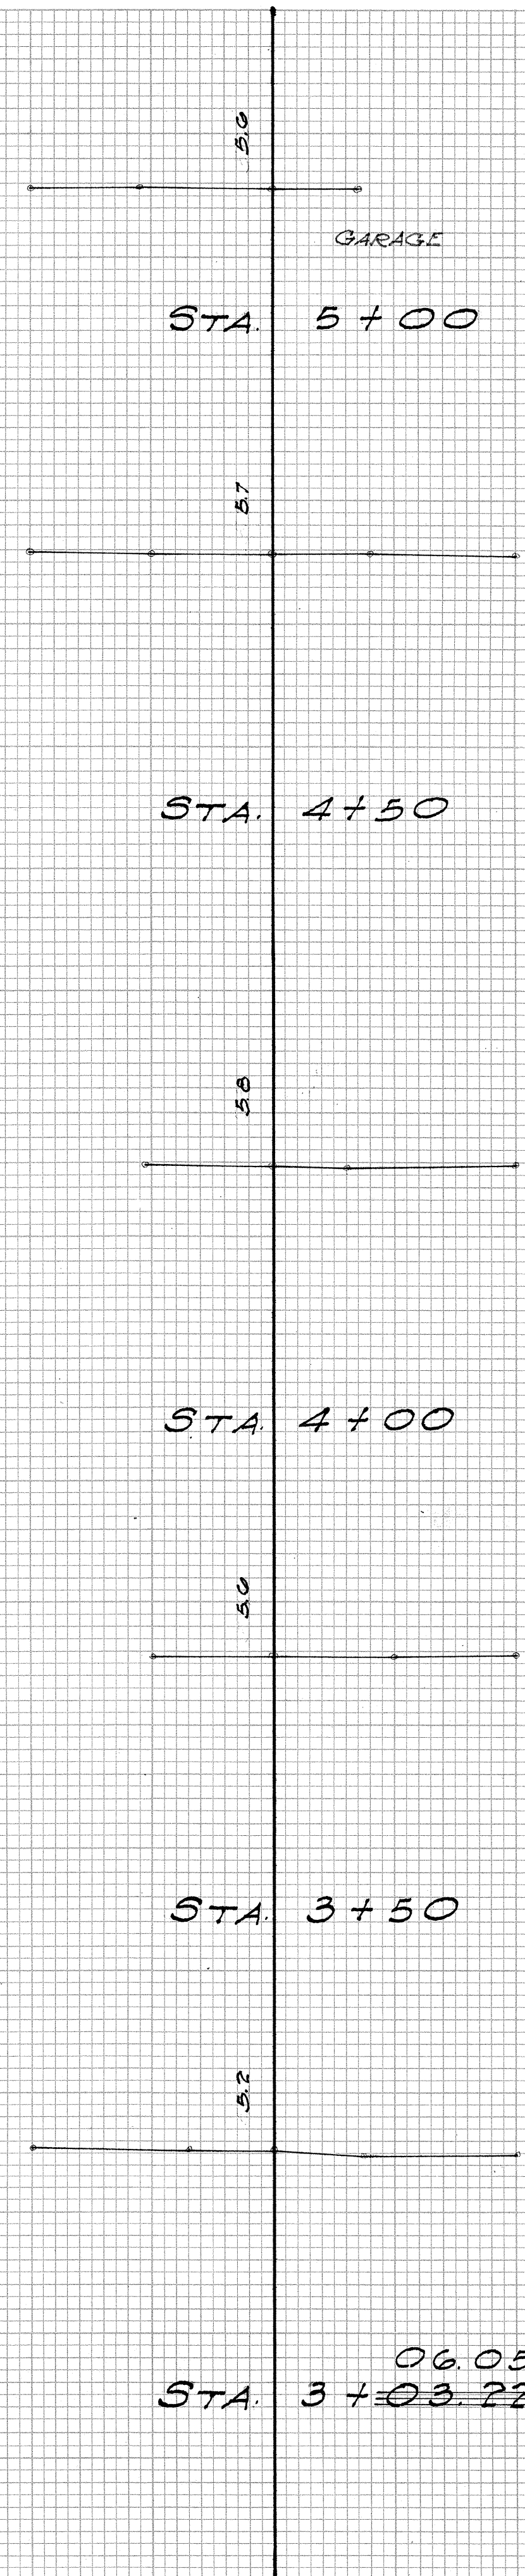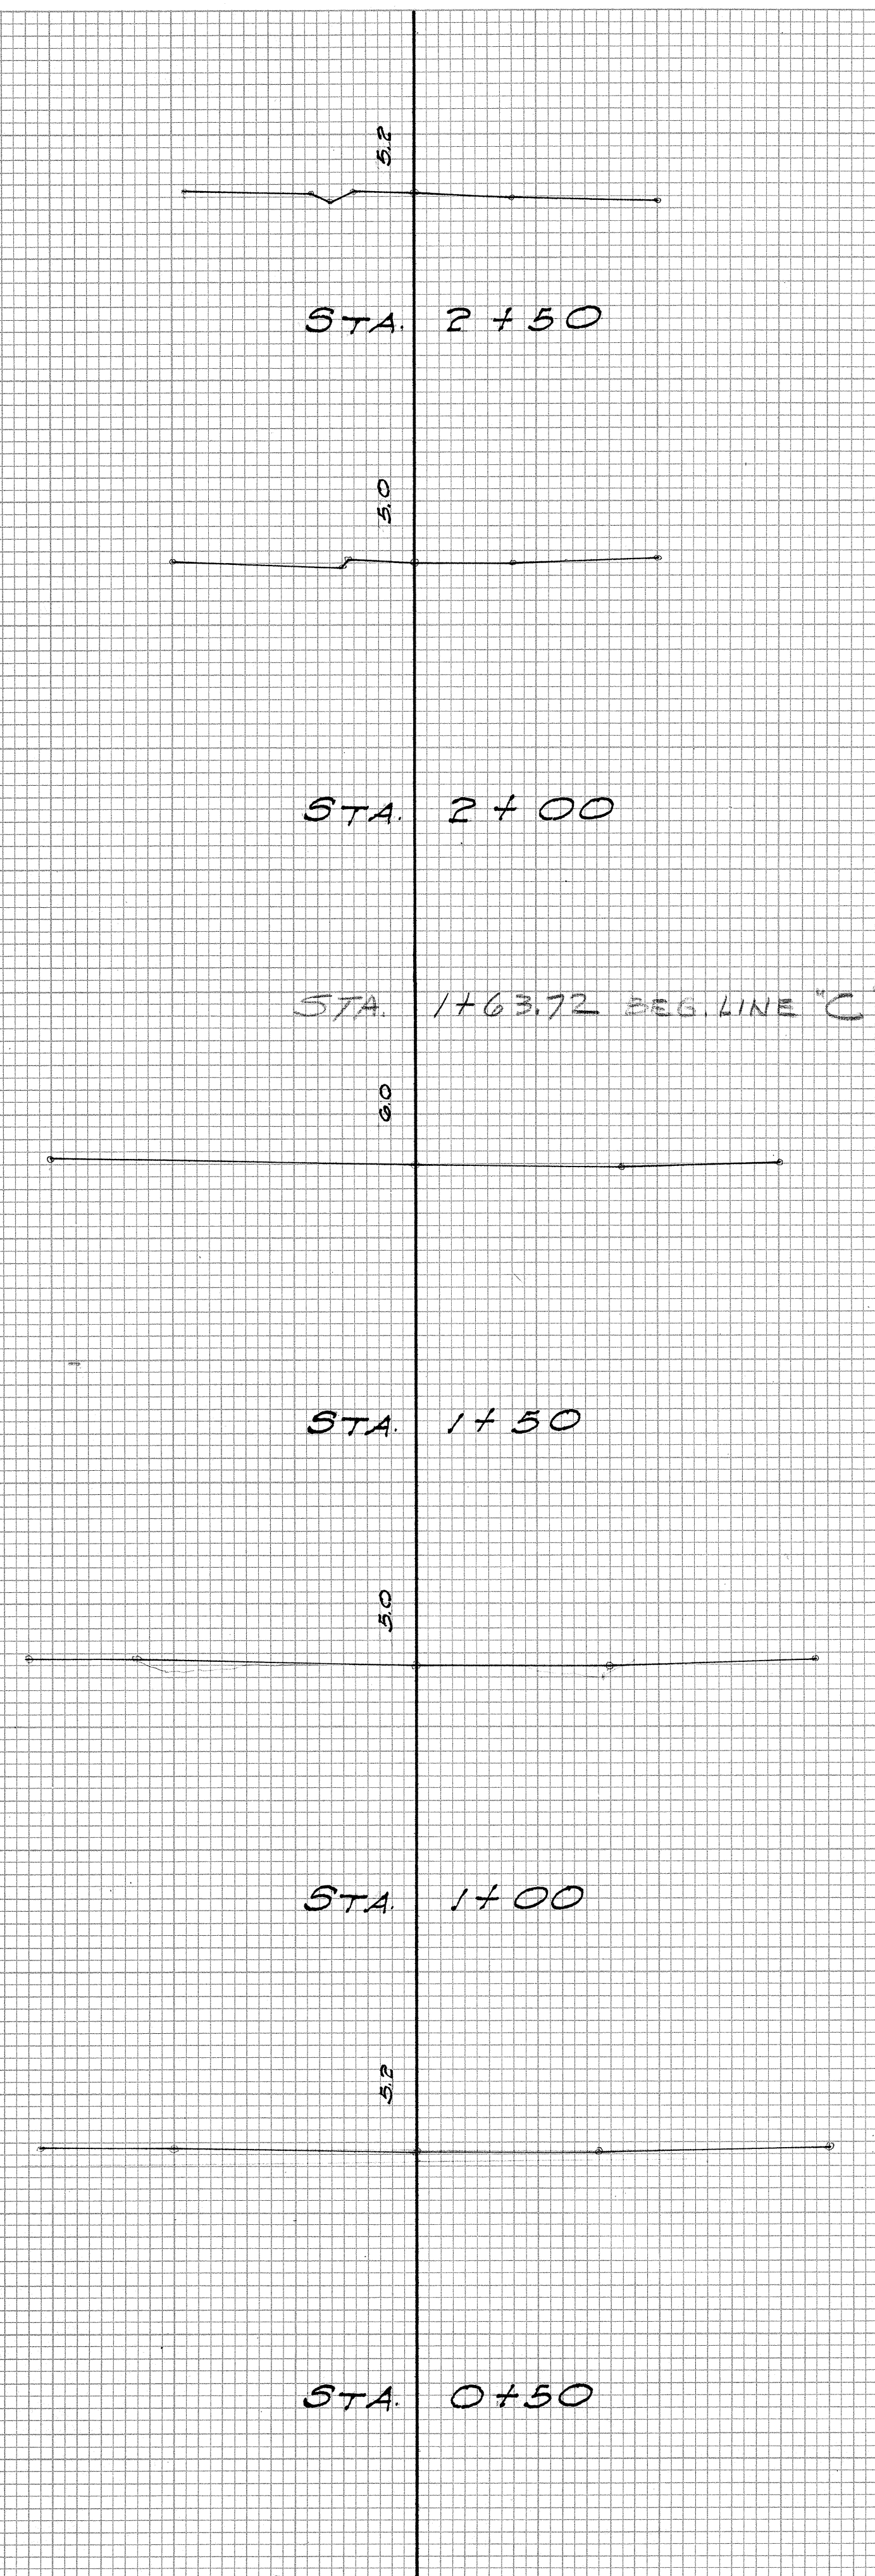

CROSS SECTIONS ALONG TRAVERSE OF DIRT ROAD (LINE "C")

