

NOTE:

Beginning of Project F-032-1(1)
is at Sta. 0+16.68.
Between Sta. 0+16.68 and
11+00 Landscaping and
Sprinkler system only. See
Sheets 5909.18 to 25.

Lath-house "A" to be Relocated
within Maui Palms as directed
by Engineer

Electric & Telephone underground cables

MAUI PALMS ACCESS ROAD

MAUI PALMS ACCESS ROAD

Sta. 14+50 to 17+10 Lt
Const. Approach & Access Road
to Maui Palms Hotel
For const detail see Sheet No. 5909.26

BASILINE CURVE DATA

A = 51.05' 40"
B = 17.34' 50"
C = 5,000.00'
D = 137.96'
E = 275.85'
F = 275.85'

Top of exist. water valve boxes. Main f. one

No. 5 Elev. 7.09
No. 6 Elev. 7.13
No. 7 Elev. 7.13
No. 8 Elev. 7.14
No. 9 Elev. 7.16

Buildings B, C, D, E, F, G & H to
be demolished

Sta. 14+25 & 14+55 Left
Lava Rock Walls to be removed & stockpiled
as directed by Engineer (Incidental to
roadway excavation)

Sta. 17+10 Lt
Reset M.H. Frame & Cover (Park)

Sta. 19+50 & 21+00 Lt
Reset M.H. Frame & Cover

Sta. 24+53 Lt
Reset M.H. Frame & Cover

Exist. pole and
light to be moved

El. 8.32

Exist. precast conc. curbs to be
reconstructed

Install new F.A. Marker
at Sta. 0+16.68


Sta. 13+00 to 17+00 Lt
Large Trees to be removed

Sta. 13+76 to 17+54
Install 36" ESRCCP
378 Lin Ft. 330 ccy.
Struc. Exc. 330 ccy.

Sta. 15+55 Rt
Const. Conc. Driveway for
Ingress only. For details
see Sheet No. 5909.26

Sta. 15+05 Rt
Const. Conc. Driveway for Ingress
and Egress. Right turns only.

Base Line Az. referred to "Luke"
Datum Mean Sea Level

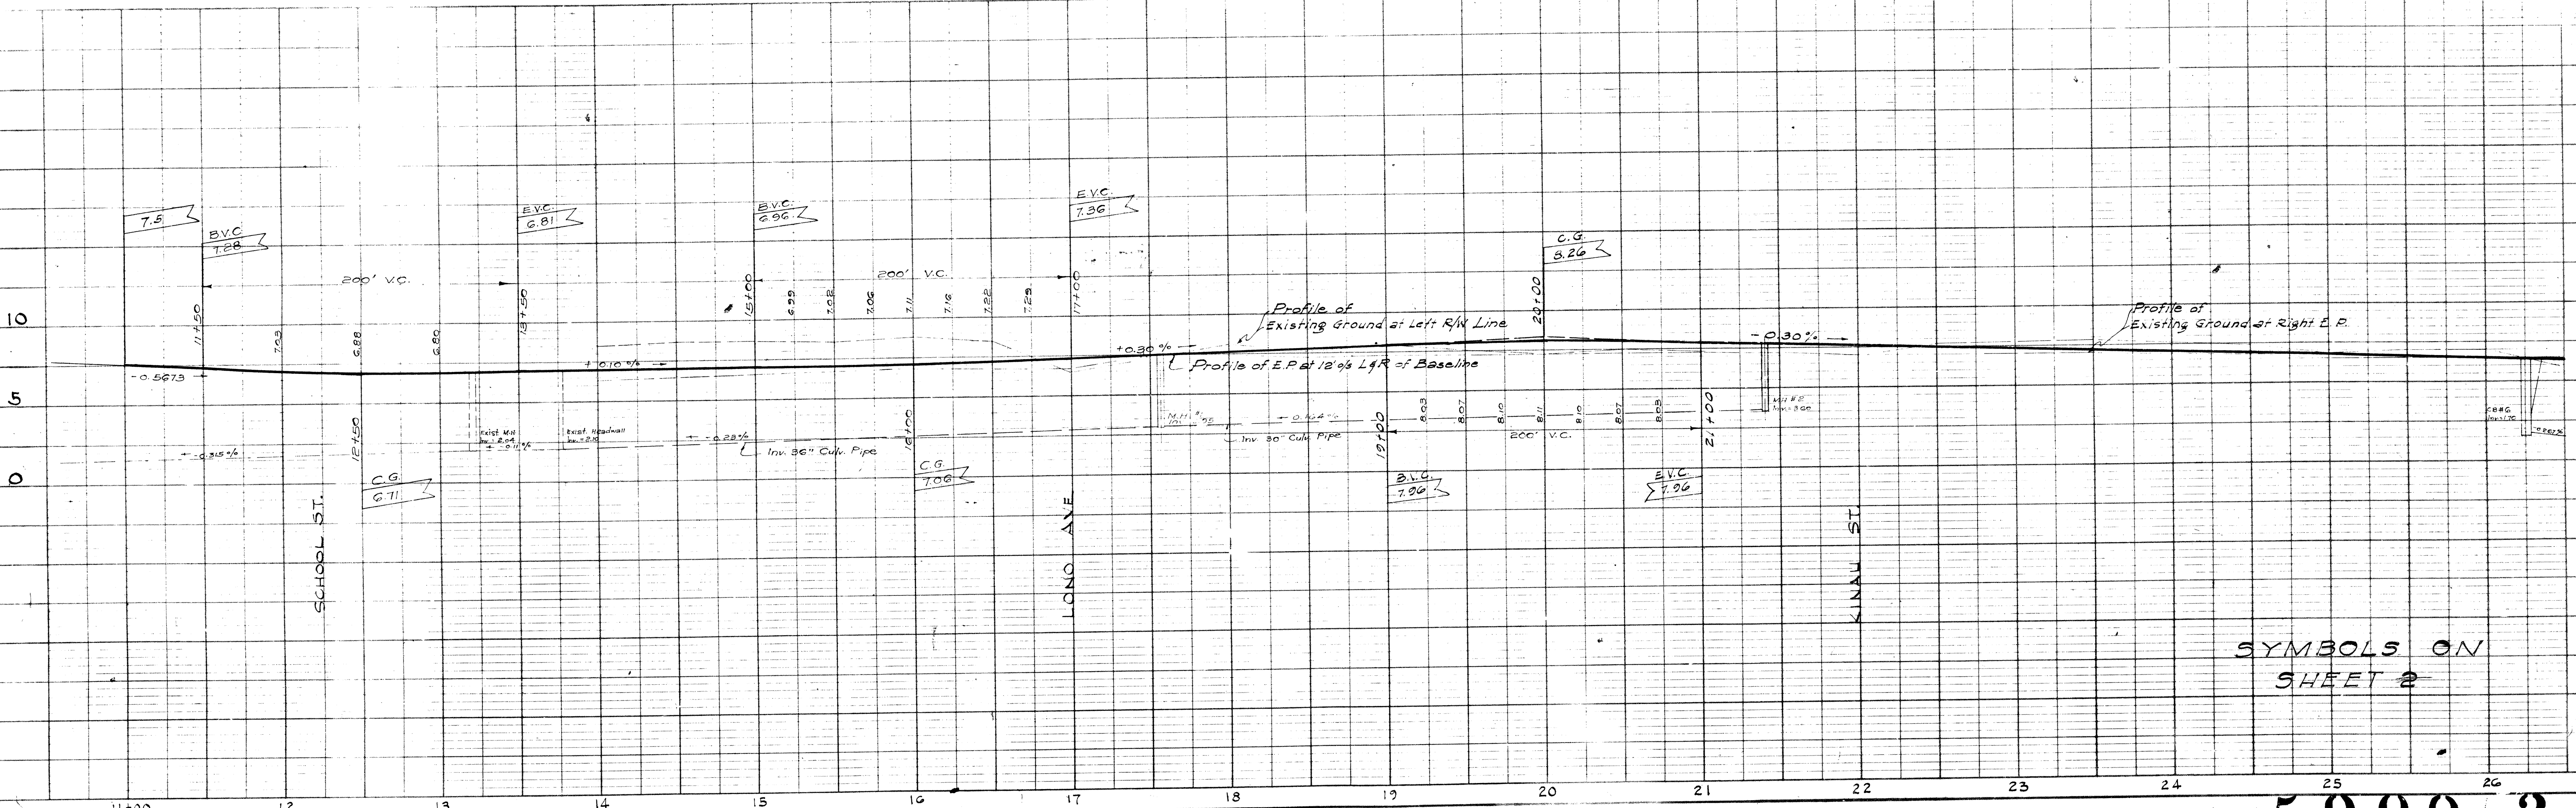

SYMBOLS ON
SHEET 2

5909.3

SHEET No 1 OF 2 SHEETS

