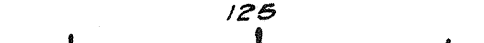
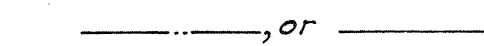
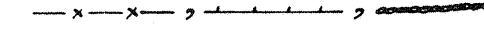
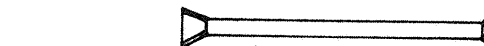
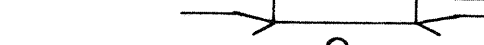
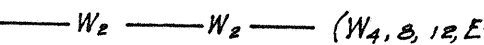
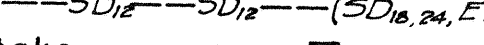
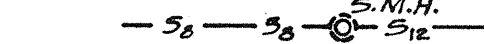




INDEX TO DRAWINGS	
SHEET NO	DESCRIPTION
1	TITLE SHEET
2-3	TYPICAL SECTION
4-5	PLAN & PROFILE
10-12	DETAIL
13	SPRINKLER SYSTEM
14-16	LANDSCAPING
17-19	CROSS SECTION

CONVENTIONAL SIGNS	
Centerline	
Boundary Lines	
Fences (Named)	
Existing Roadways	
Circular Culvert	
Box Culvert	
Bridge	
Telephone Pole	
Electric Power Pole	
Water Main	
Storm Drain	
Concrete Drop Intake	
Standard Catch Basin	
Standard Manhole	
Sewer Manhole	
Telephone Manhole	
Fire Hydrant	
Trees (Named)	
Railroad	

TERRITORY OF HAWAII
TERRITORIAL HIGHWAY DEPARTMENT
HONOLULU, T. H.

PLANS OF
KAAHUMANU AVENUE
FEDERAL AID PROJECT No. DF 032-1(4)
DISTRICT OF WAILUKU
ISLAND OF MAUI

SCALE
PLAN 1 IN. = 50 FT.
PROFILE HOR. 1 IN. = 50 FT.
VER. 1 IN. = 5 FT.
X-SECTIONS HOR. 1 IN. = 10 FT.
VER. 1 IN. = 10 FT.

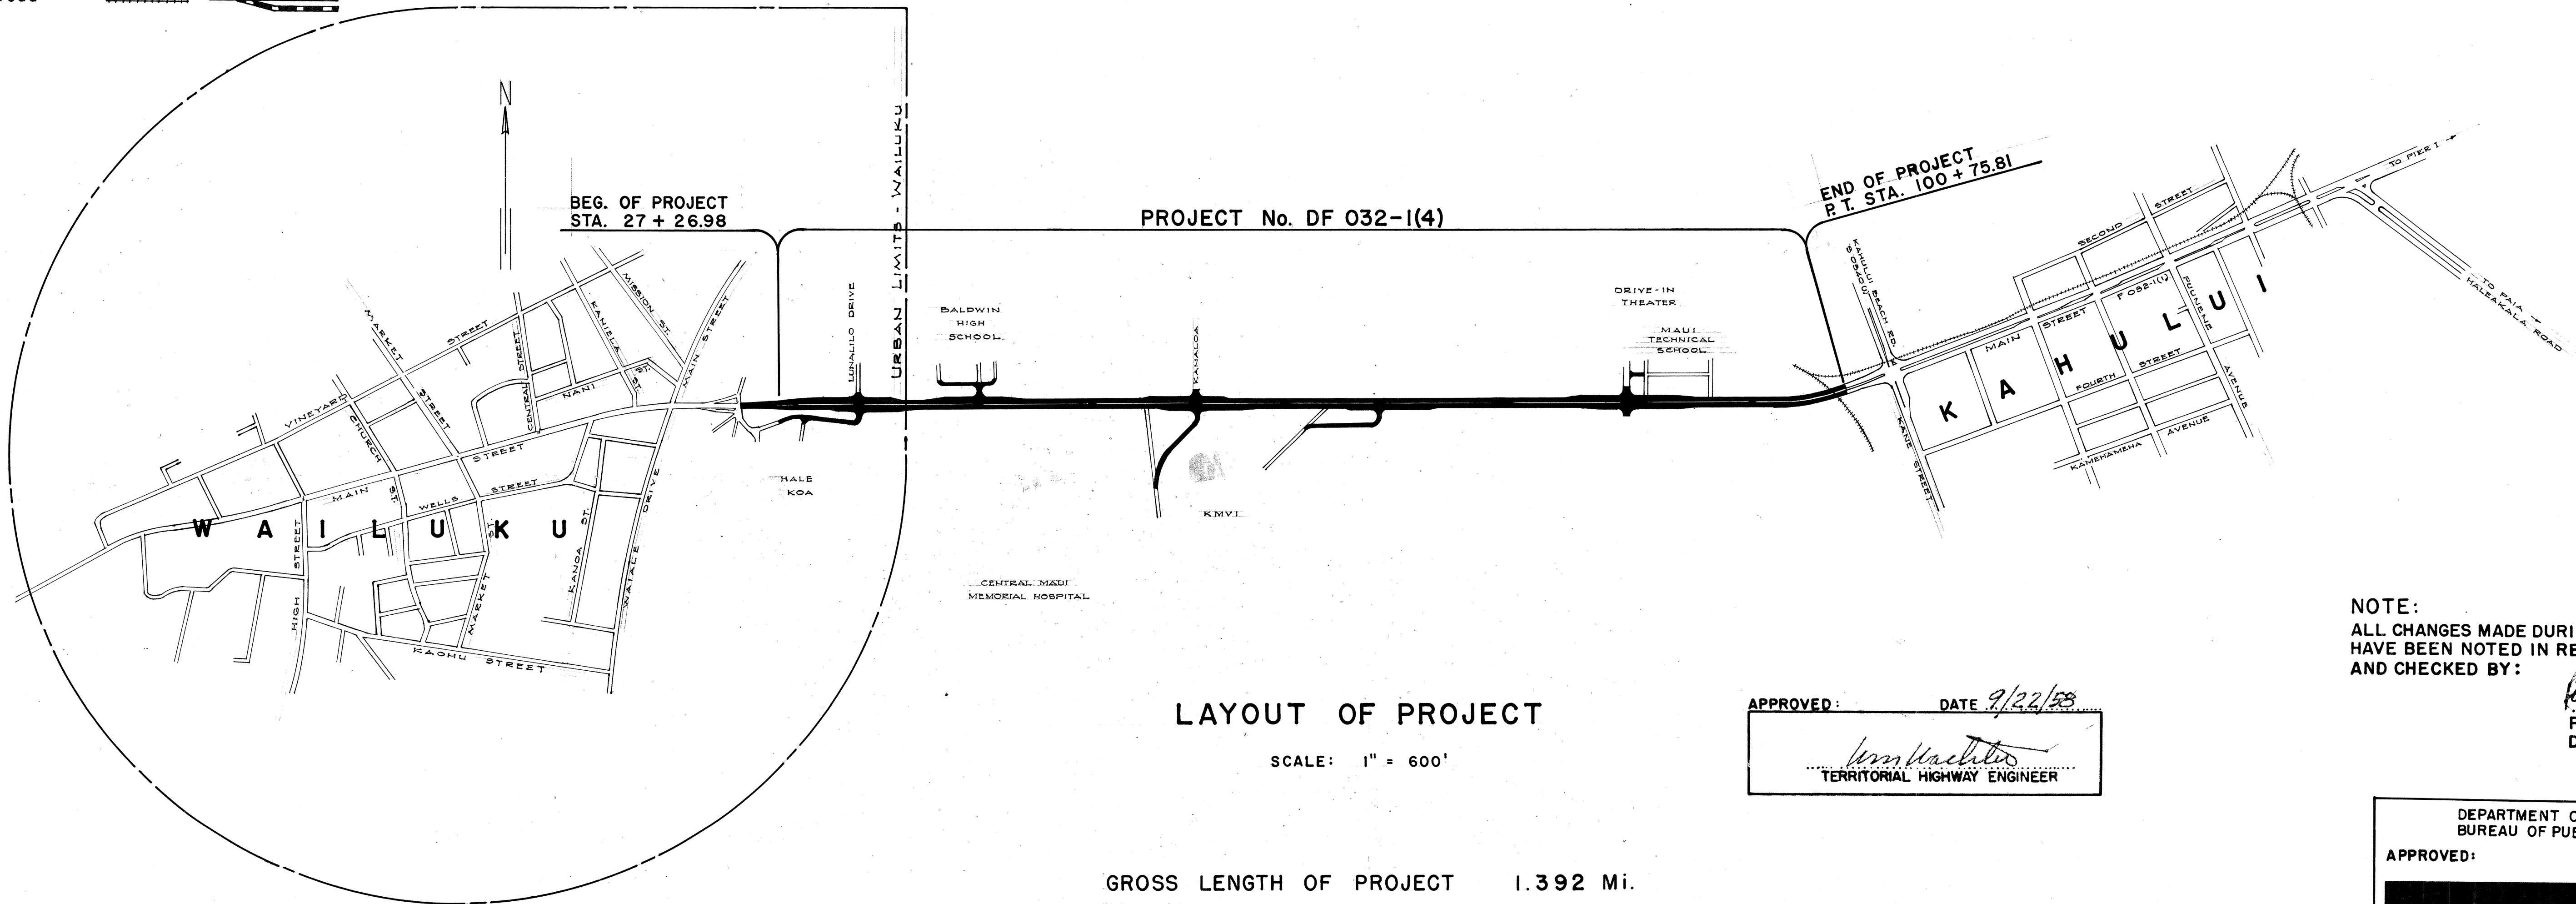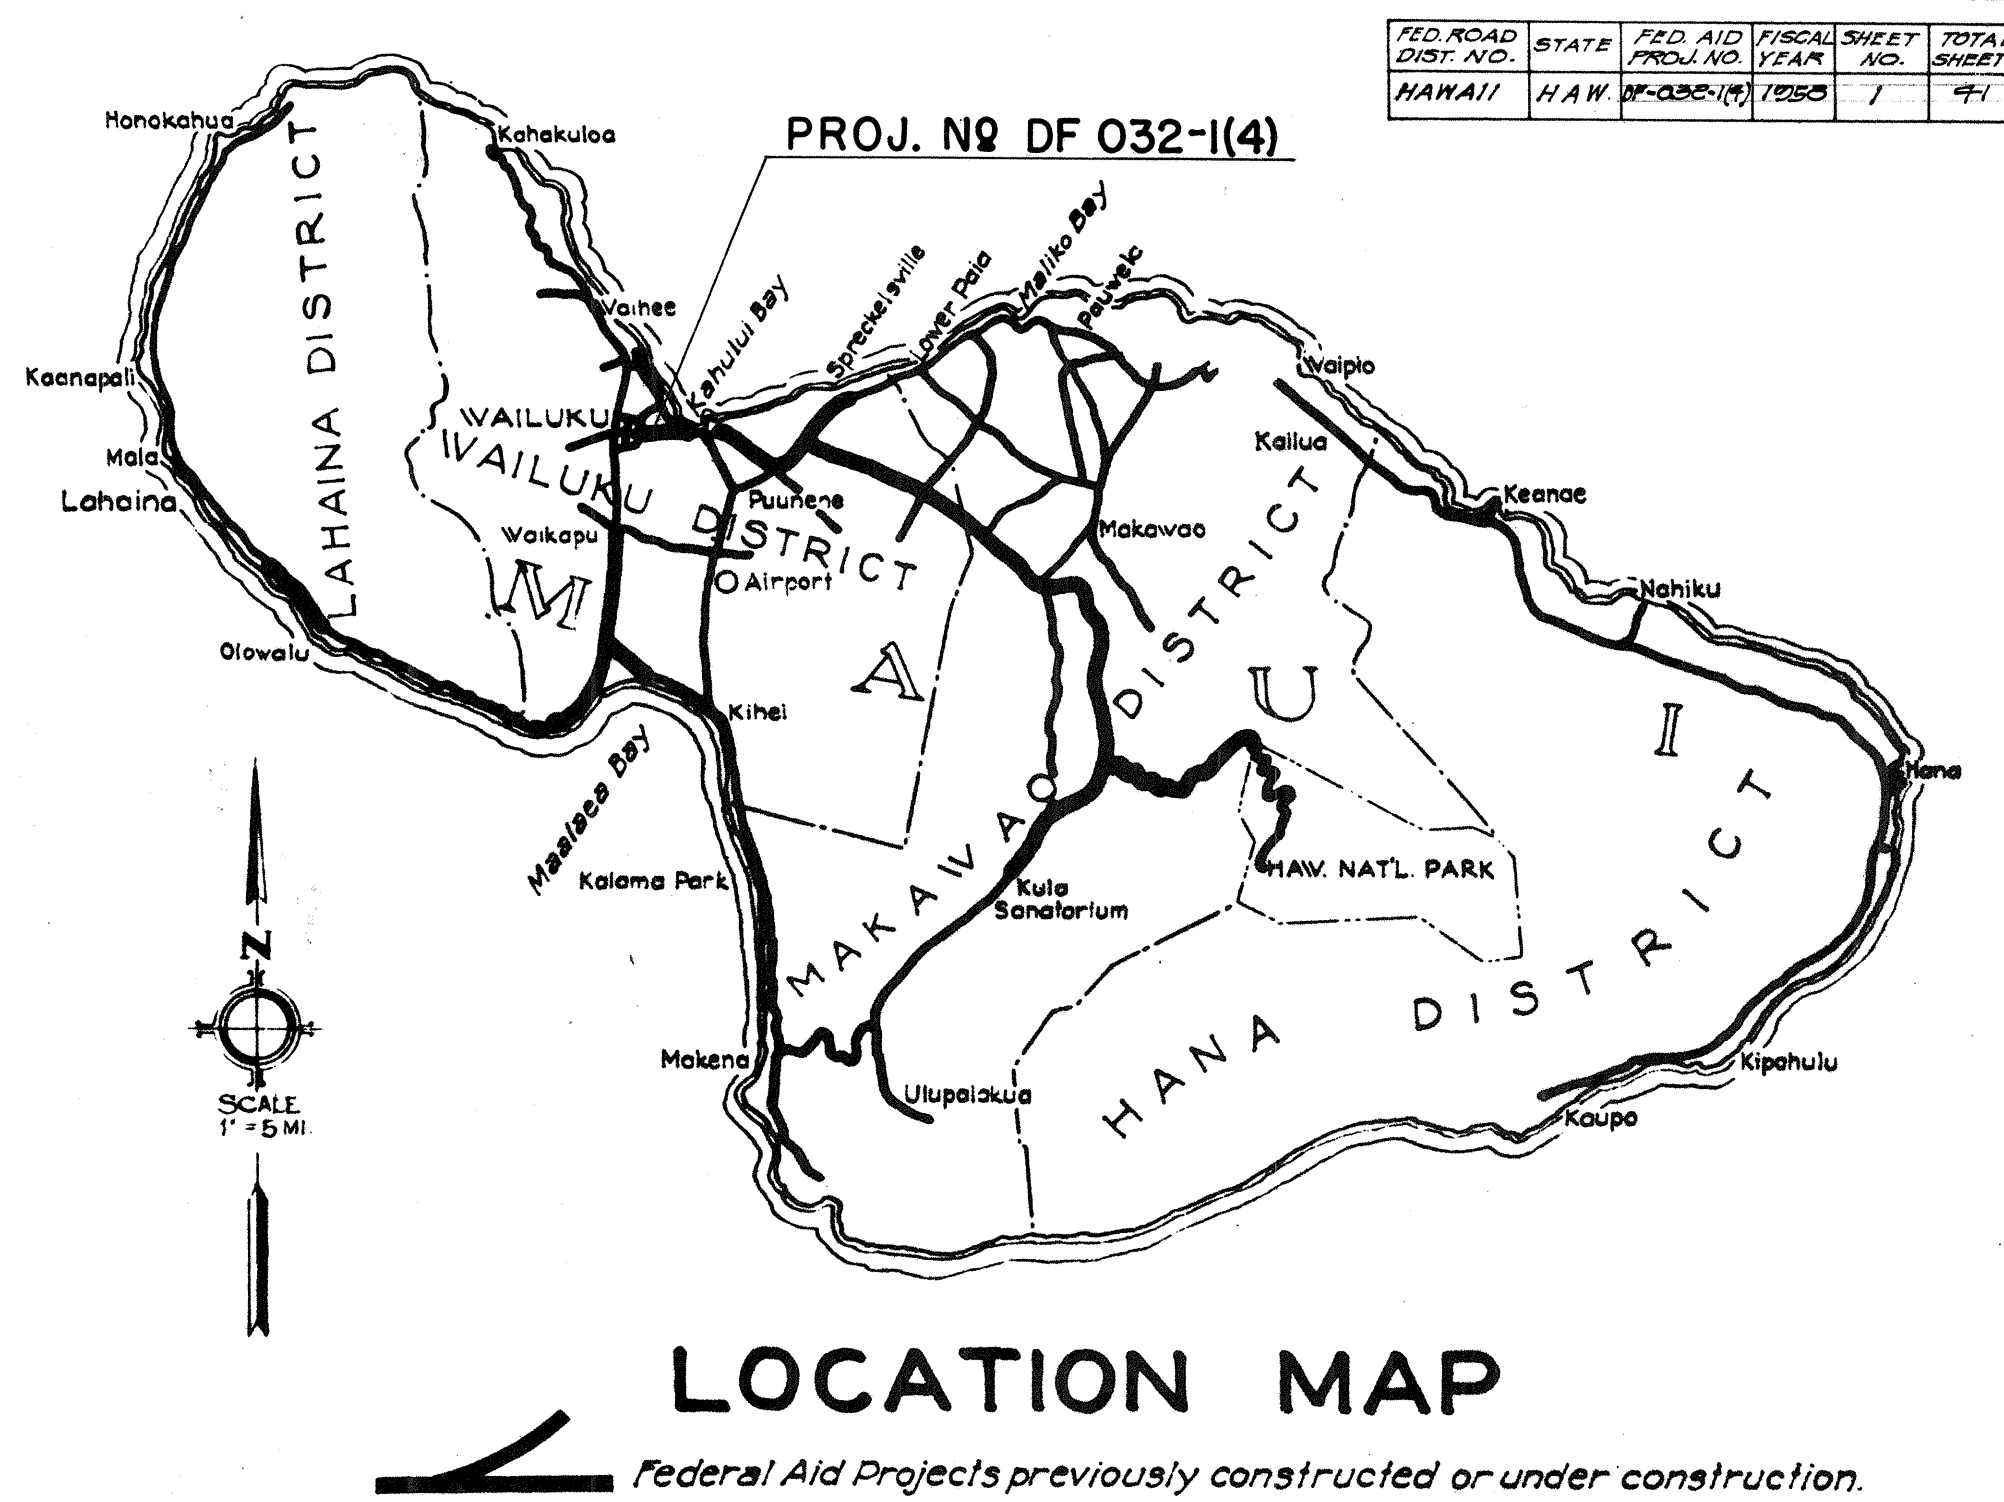

GROSS LENGTH OF PROJECT 1.392 Mi.
 BRIDGES 0.000 Mi.
 NET LENGTH OF PROJECT 1.392 Mi.

APPROVED: *[Signature]* DATE 9/22/58
 TERRITORIAL HIGHWAY ENGINEER

NOTE:
 ALL CHANGES MADE DURING CONSTRUCTION
 HAVE BEEN NOTED IN RED IN THESE TRACINGS
 AND CHECKED BY: *[Signature]*
 PROJECT ENGINEER
 DATE 9/22/58

DEPARTMENT OF COMMERCE
 BUREAU OF PUBLIC ROADS
 APPROVED: _____
 DIVISION ENGINEER DATE