


1A-1
1B

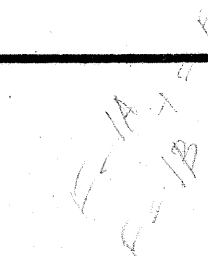

APPROVED									
		NO.	DATE	DESCRIPTION				APPROVED	
		REVISIONS							
		L. FREDERICK PACK ASSOCIATES OF HAWAII, LTD. CIVIL ENGINEERING · LAND PLANNING · AERIAL MAPPING							
		SPRINKLER SYSTEM FOR KAAHUMANU AVENUE COUNTY OF MAUI, WAILUKU, MAUI, HAWAII							
		GENERAL LAYOUT AND INDEX							
		APPROVED <i>Charles Yoon</i> REG. PROF. ENGR., CERT. NO. /037						JOB NO: <i>G478</i> DATE: <i>3/5/63</i>	