
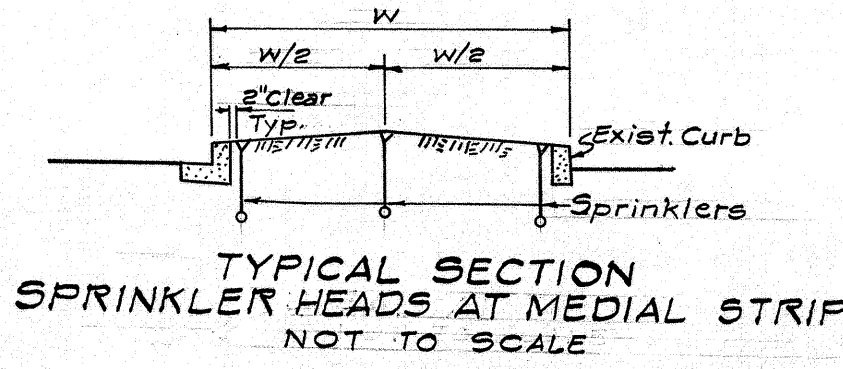
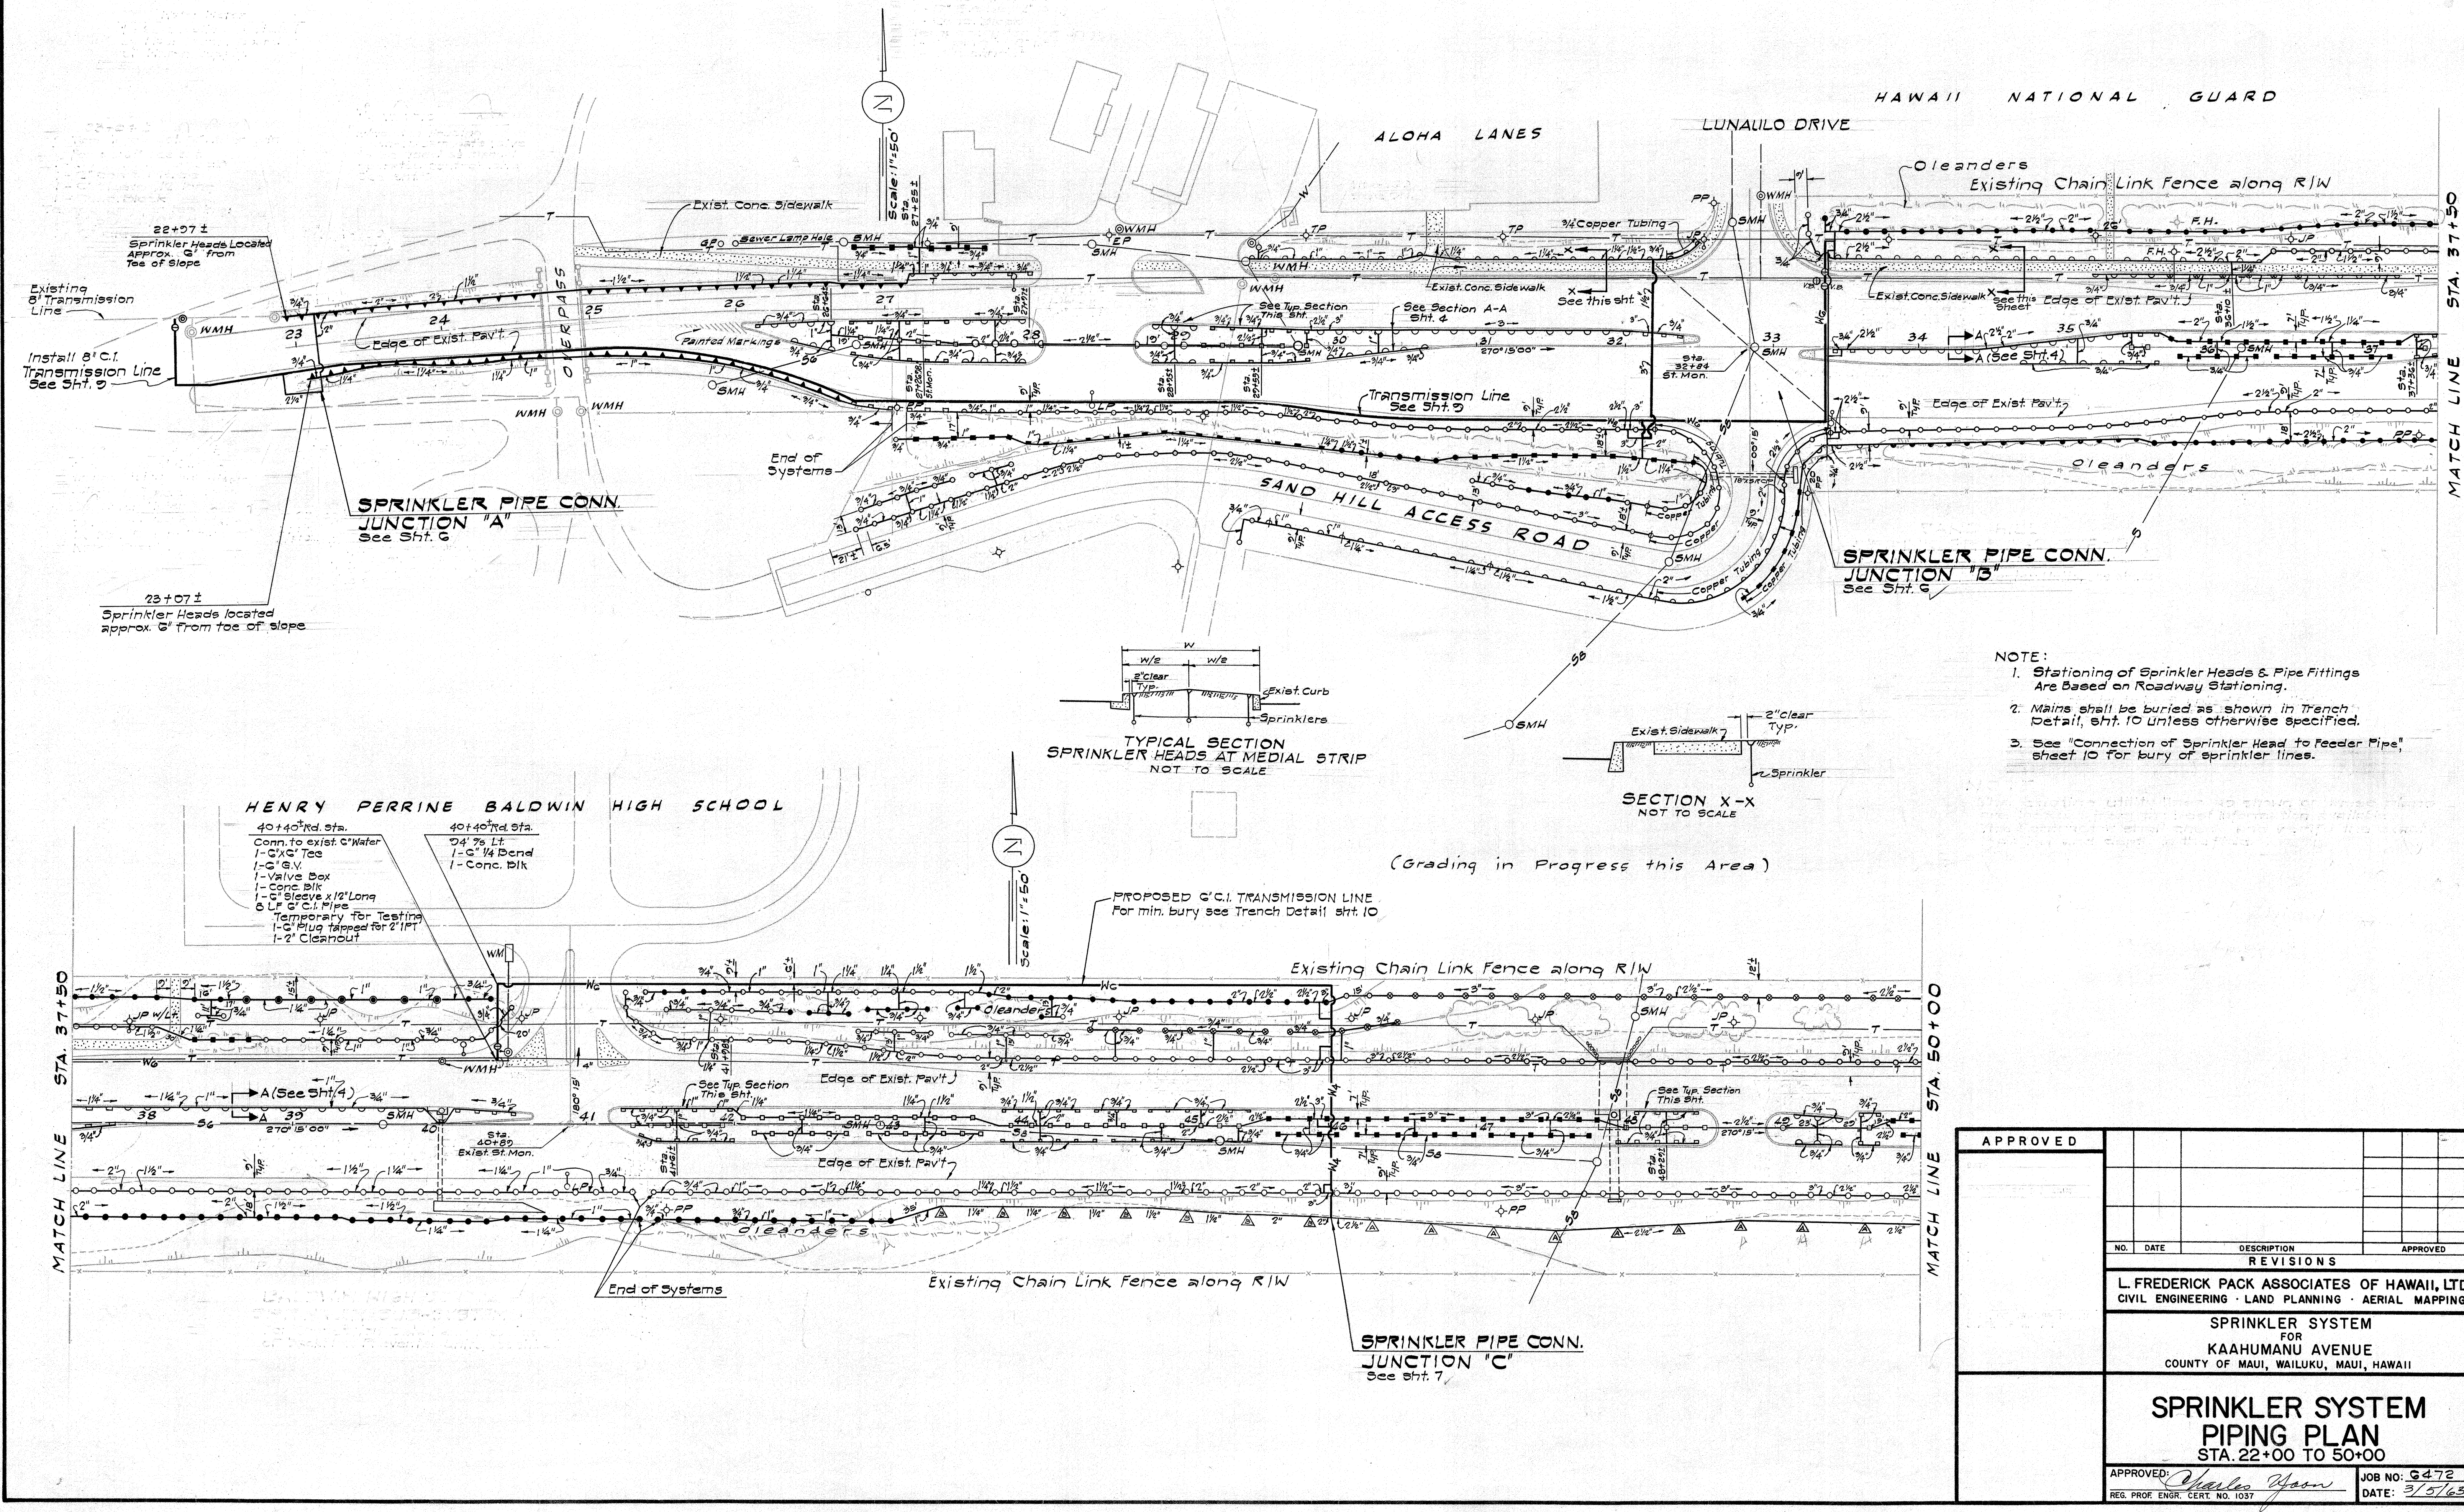
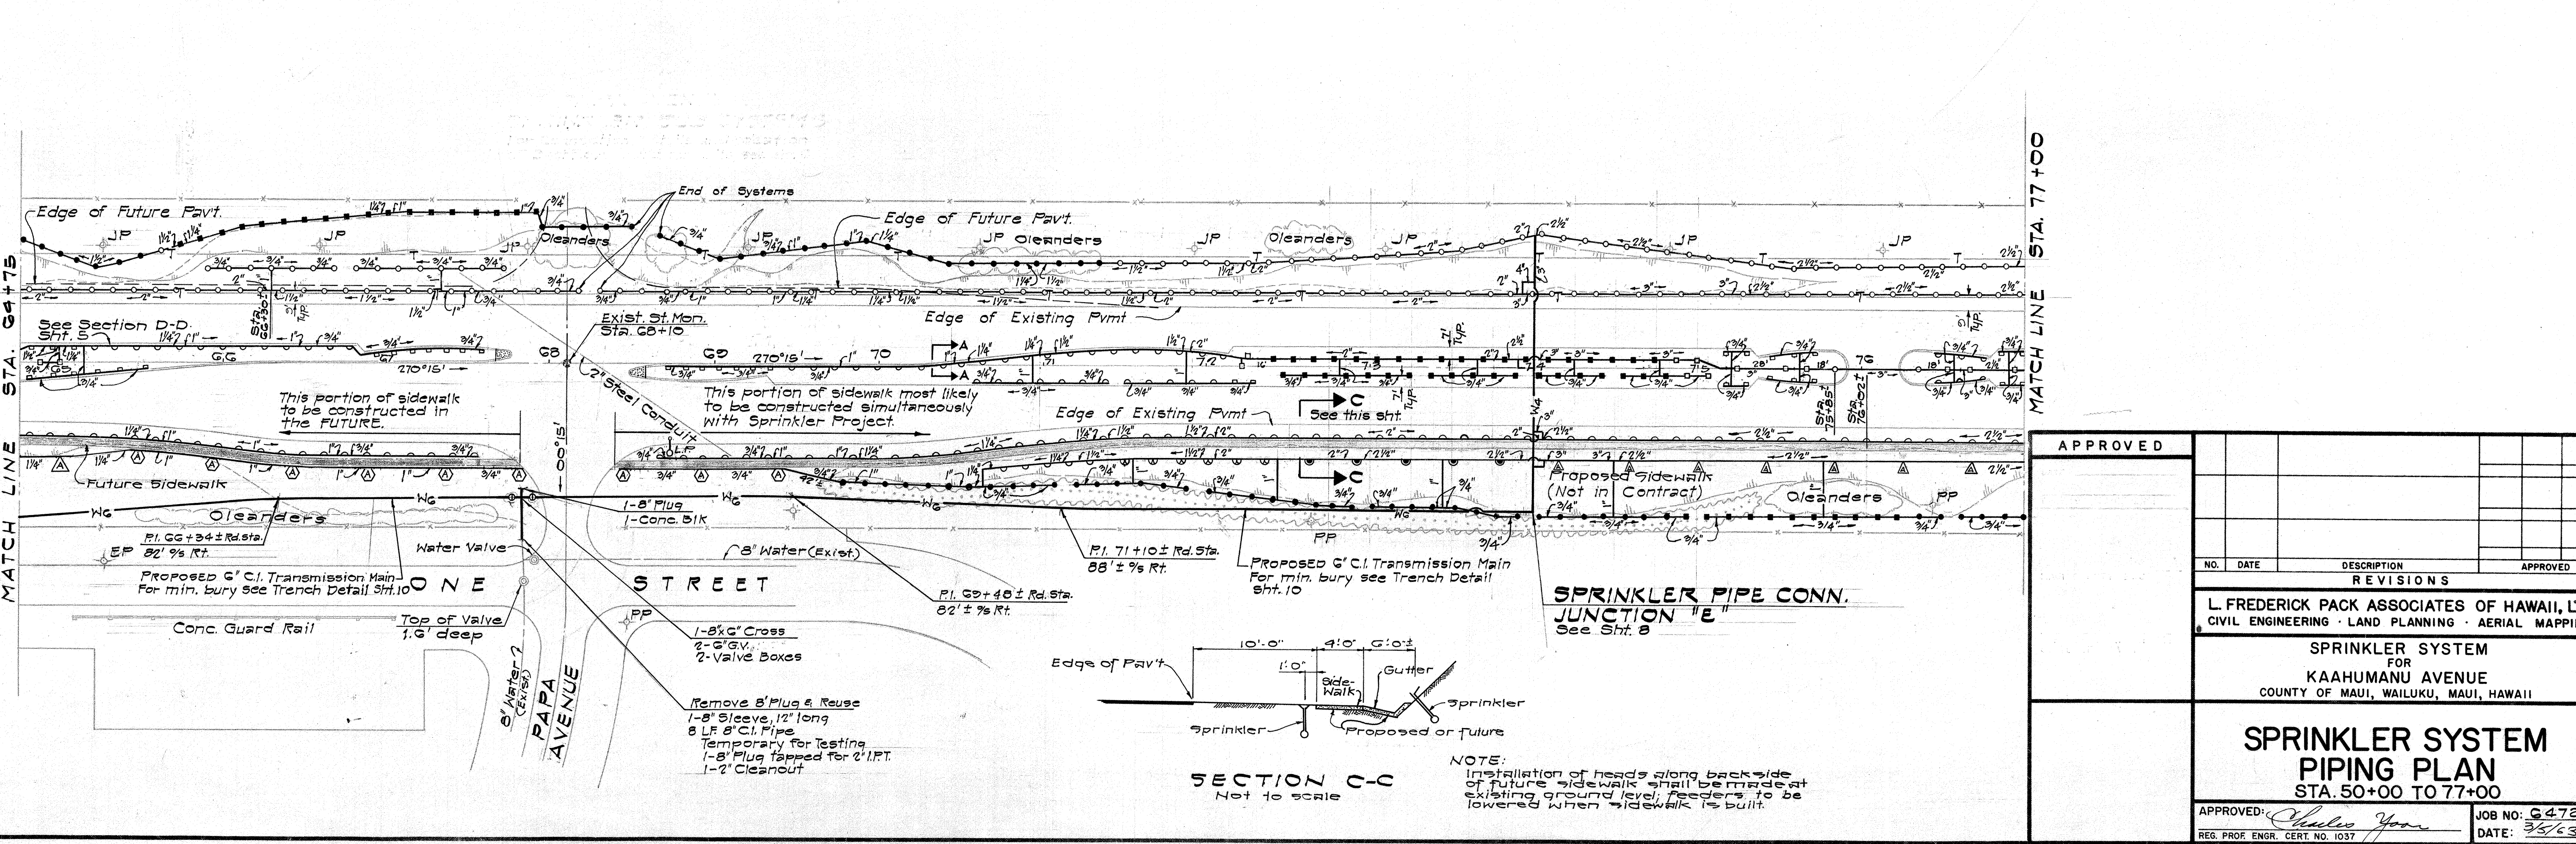


- NOTE:
1. Stationing of Sprinkler Heads & Pipe Fittings Are Based on Roadway Stationing.
 2. Mains shall be buried as shown in Trench Detail, Sht. 10 Unless Otherwise Specified.
 3. See "Connection of Sprinkler Head to Feeder Pipe," sheet 10 for bury of sprinkler lines.

- HENRY PERRINE BALDWIN HIGH SCHOOL
- | | |
|-----------------------------|--------------------|
| 40' x 40' Rd. Sta. | 40' x 40' Rd. Sta. |
| Conn. to exist. C' Water | 24' 3/4" Lt. |
| 1-6" x 6" Tee | 1-6" 1/4 Bend |
| 1-6" G.V. | 1-Conc. Blk |
| 1-Valve Box | |
| 1-Conc. Blk | |
| 6" x 6" x 12' Long | |
| 6" x 6" x 12' Long | |
| Temporary for Testing | |
| 1-6" Plug tapped for 2" IPT | |
| 1-2" Clearout | |

APPROVED			
NO.	DATE	DESCRIPTION	APPROVED
REVISIONS			
L. FREDERICK PACK ASSOCIATES OF HAWAII, LTD.			
CIVIL ENGINEERING · LAND PLANNING · AERIAL MAPPING			
SPRINKLER SYSTEM			
FOR			
KAAHUMANU AVENUE			
COUNTY OF MAUI, WAILUKU, MAUI, HAWAII			
SPRINKLER SYSTEM			
PIPING PLAN			
STA. 22+00 TO 50+00			
APPROVED: Charles Yoon		JOB NO: 6472	
REG. PROF. ENGR. CERT. NO. 1037		DATE: 3/5/63	

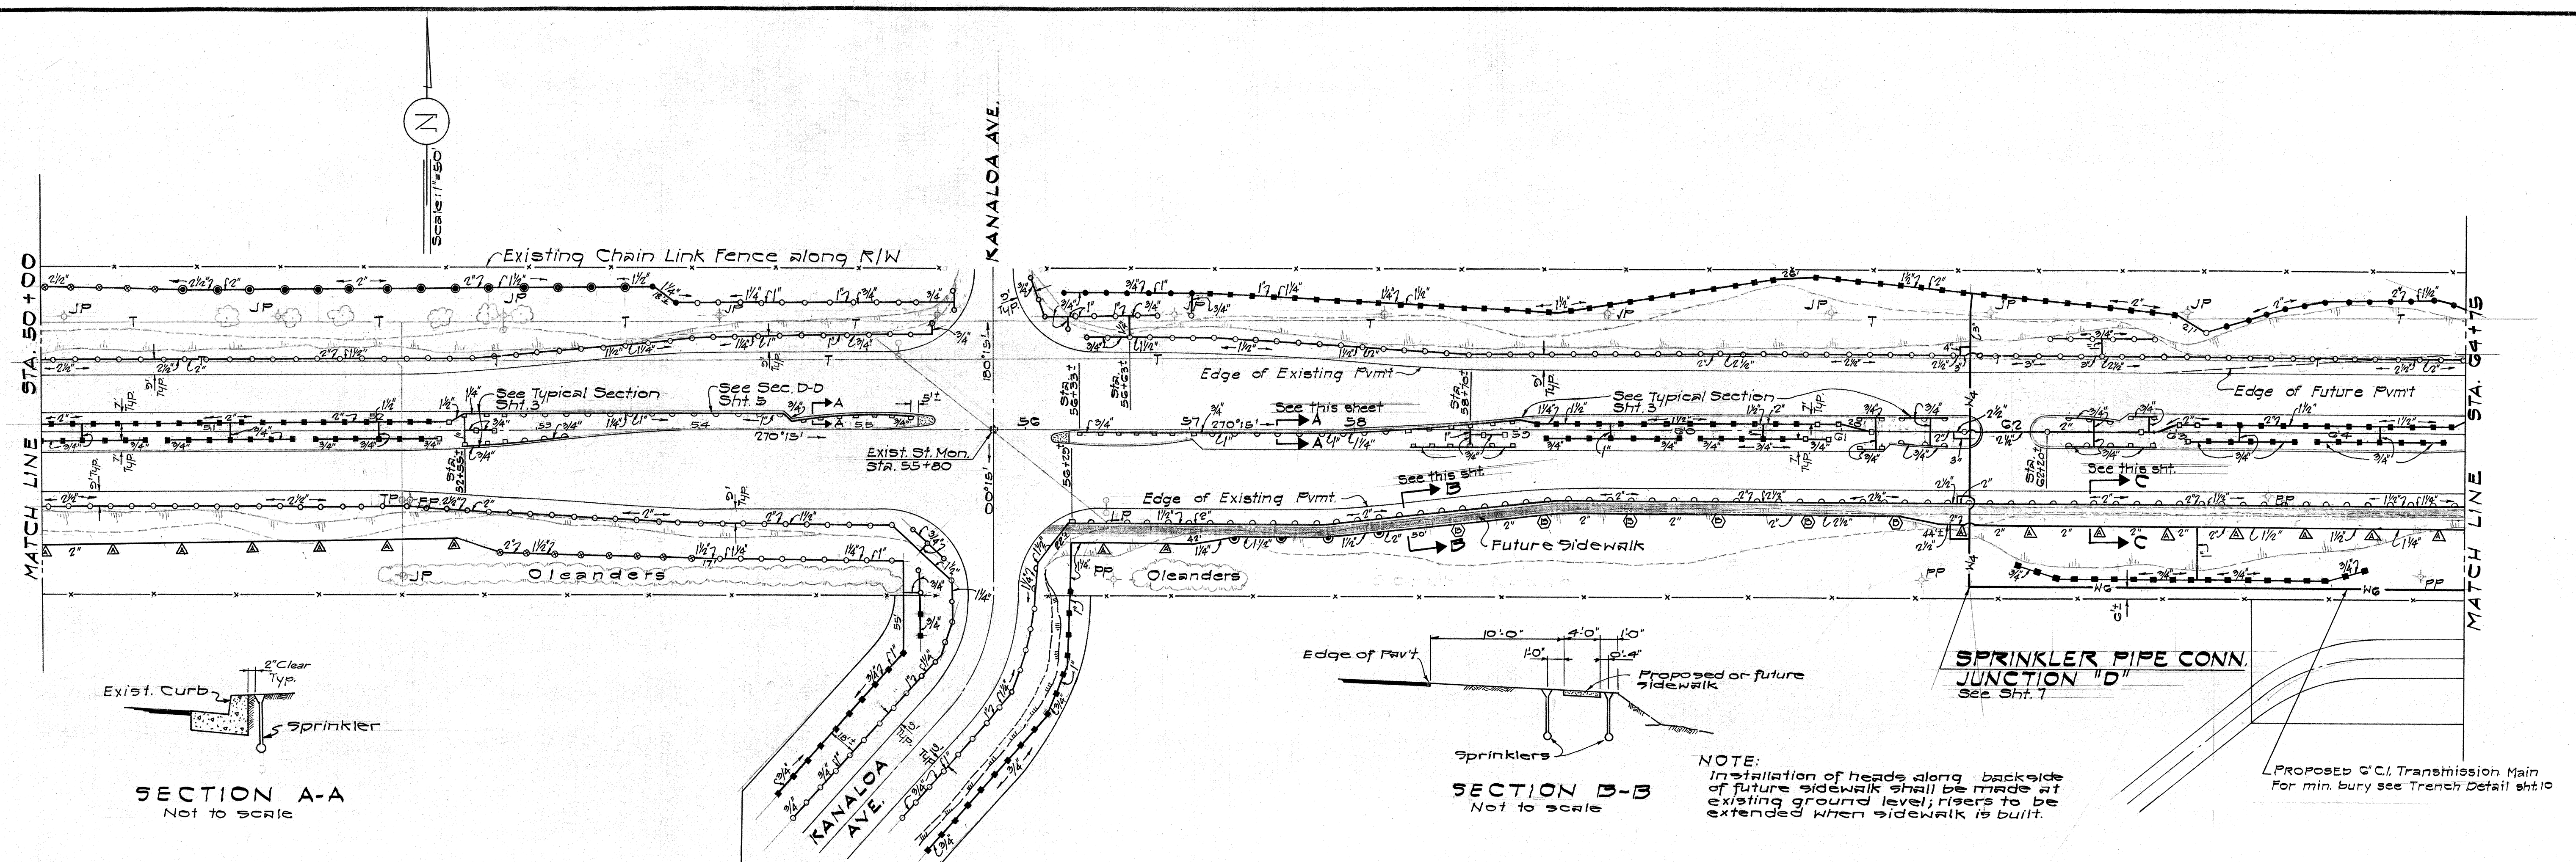

APPROVED					

