


INDEX TO DRAWINGS	
SHEET NO.	DESCRIPTION
1	TITLE SHEET
2	TYPICAL SECTION
3-5	PLAN & PROFILE
6-8	CROSS SECTIONS

STATE OF HAWAII
DEPARTMENT OF TRANSPORTATION
HIGHWAYS DIVISION


PLANS OF
**KAAHUMANU AVENUE
SIDEWALK**
PROJECT NO. B-32-02-63
DISTRICT OF WAILUKU
ISLAND OF MAUI

SCALE
PLAN 1 IN. = 50 FT.
PROFILE HOR. 1 IN. = 50 FT.
VER. 1 IN. = 5 FT.
X-SECTIONS HOR. 1 IN. = 10 FT.
VER. 1 IN. = 10 FT.

FED. ROAD DIST. No.	STATE	PROJ. No.	FISCAL YEAR	SHEET No.	TOTAL SHEETS
HAWAII	MAUI	B-32-02-63	1963	1	6

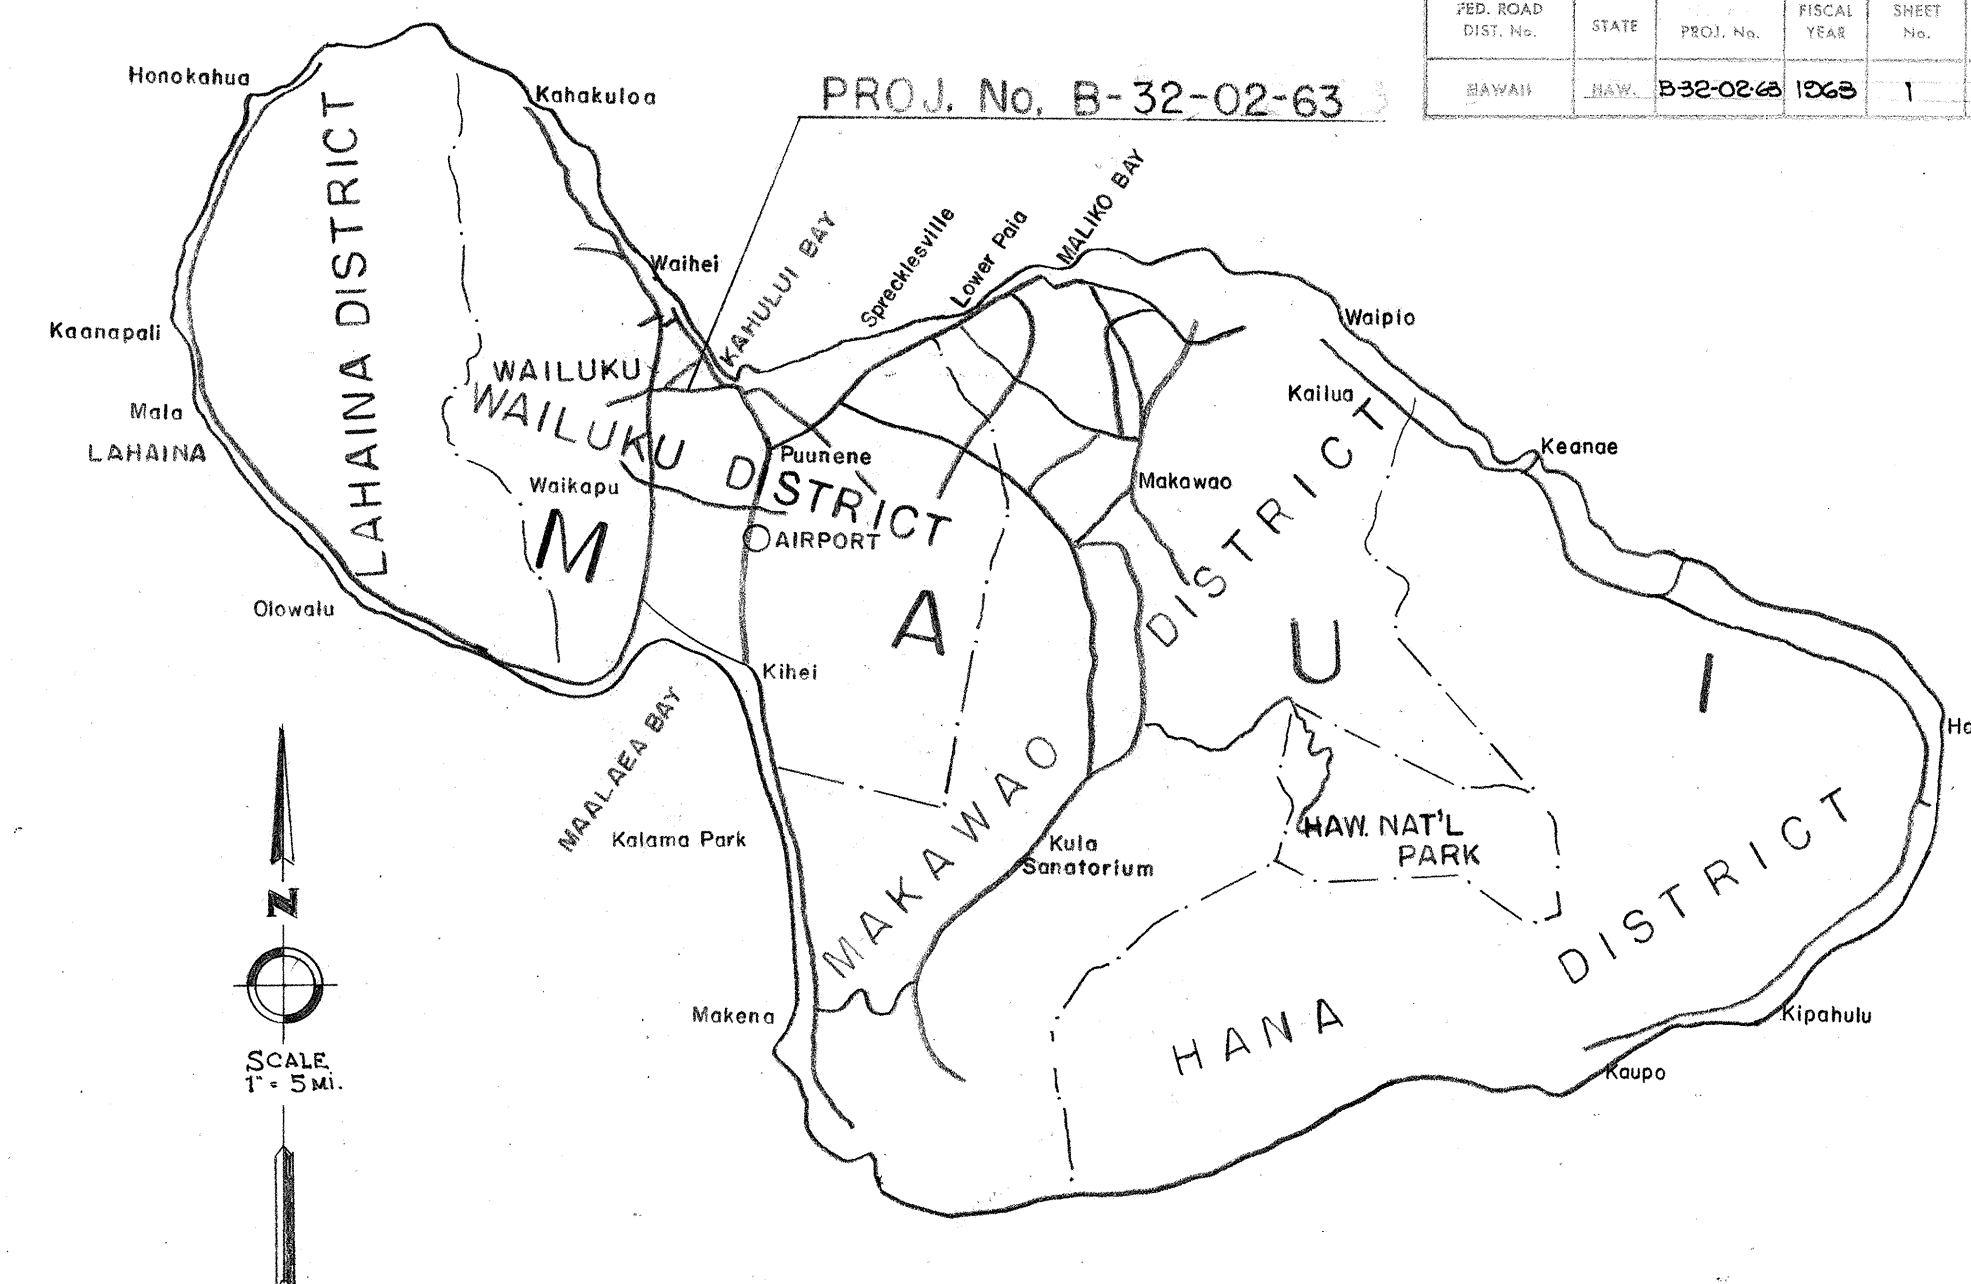

LOCATION MAP

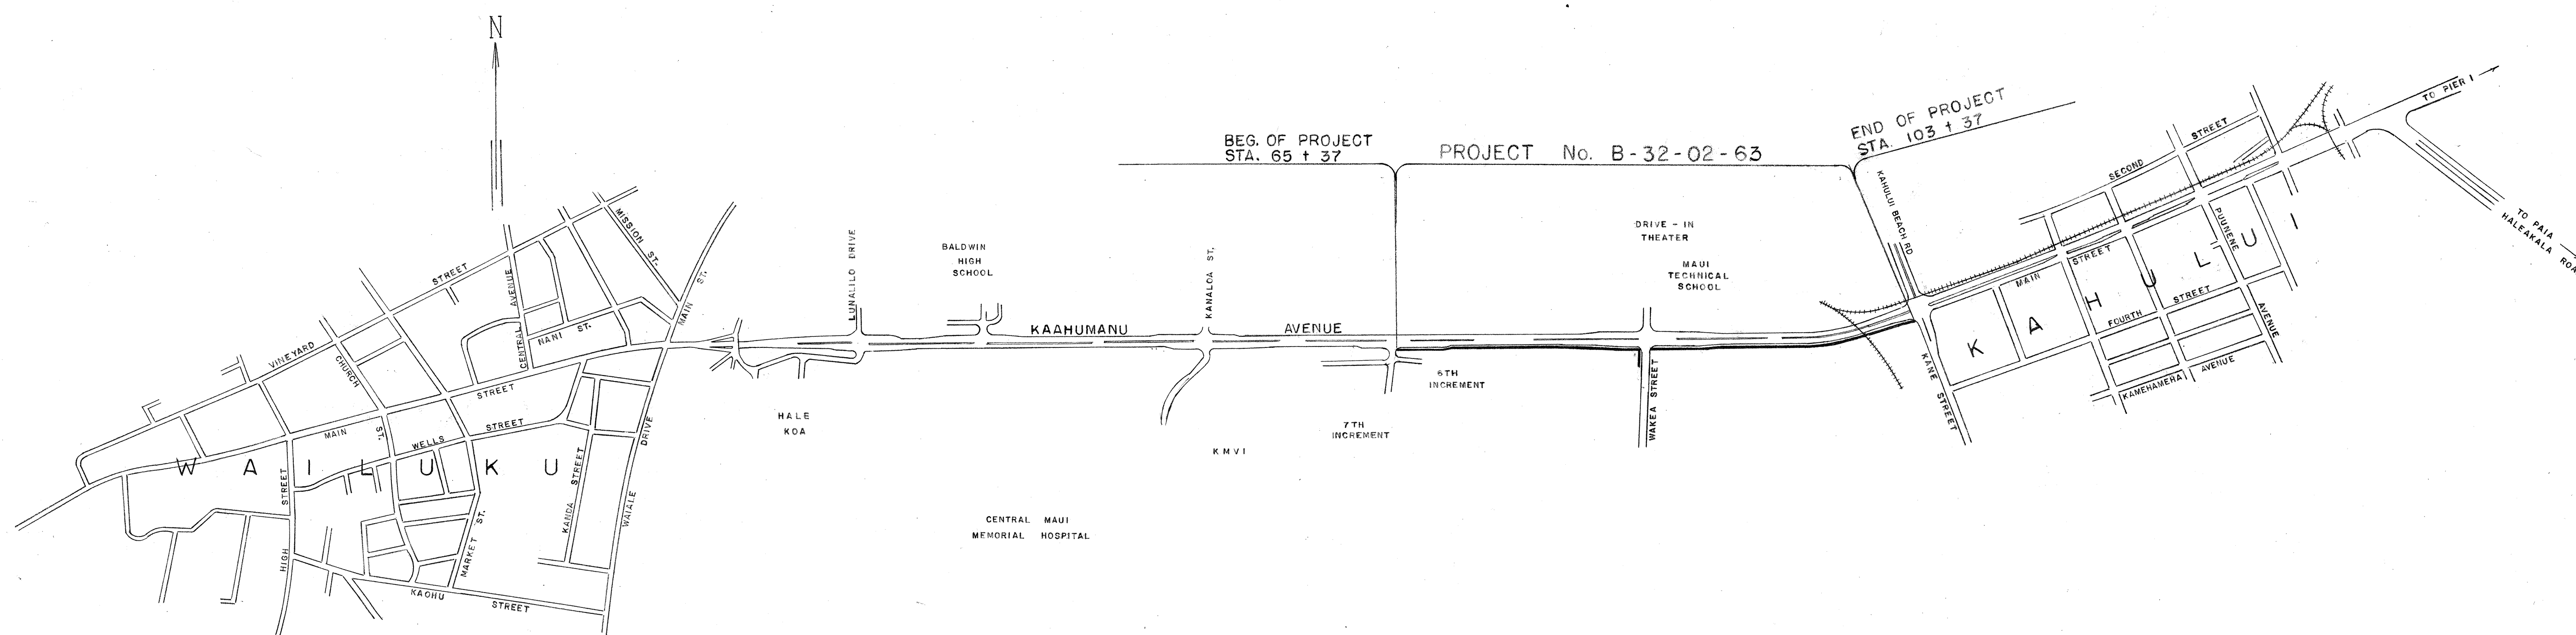

LAYOUT OF PROJECT
LENGTH OF PROJECT 0.720 MI.
SCALE: 1" = 600'

APPROVED: DATE 3 May 63
Fujio Matsuda
DIRECTOR OF TRANSPORTATION