



FED. ROAD DIST. NO.	STATE	PROJ. NO.	FISCAL YEAR	SHEET NO.	TOTAL SHEETS
HAWAII	HAW.	B-32-02-63	1963	2	8


Note:
Where Concrete Gutter is called for,
Sta. 84+32 to 84+30, widen Gutter
Section from 3'-0" to 3'-6"

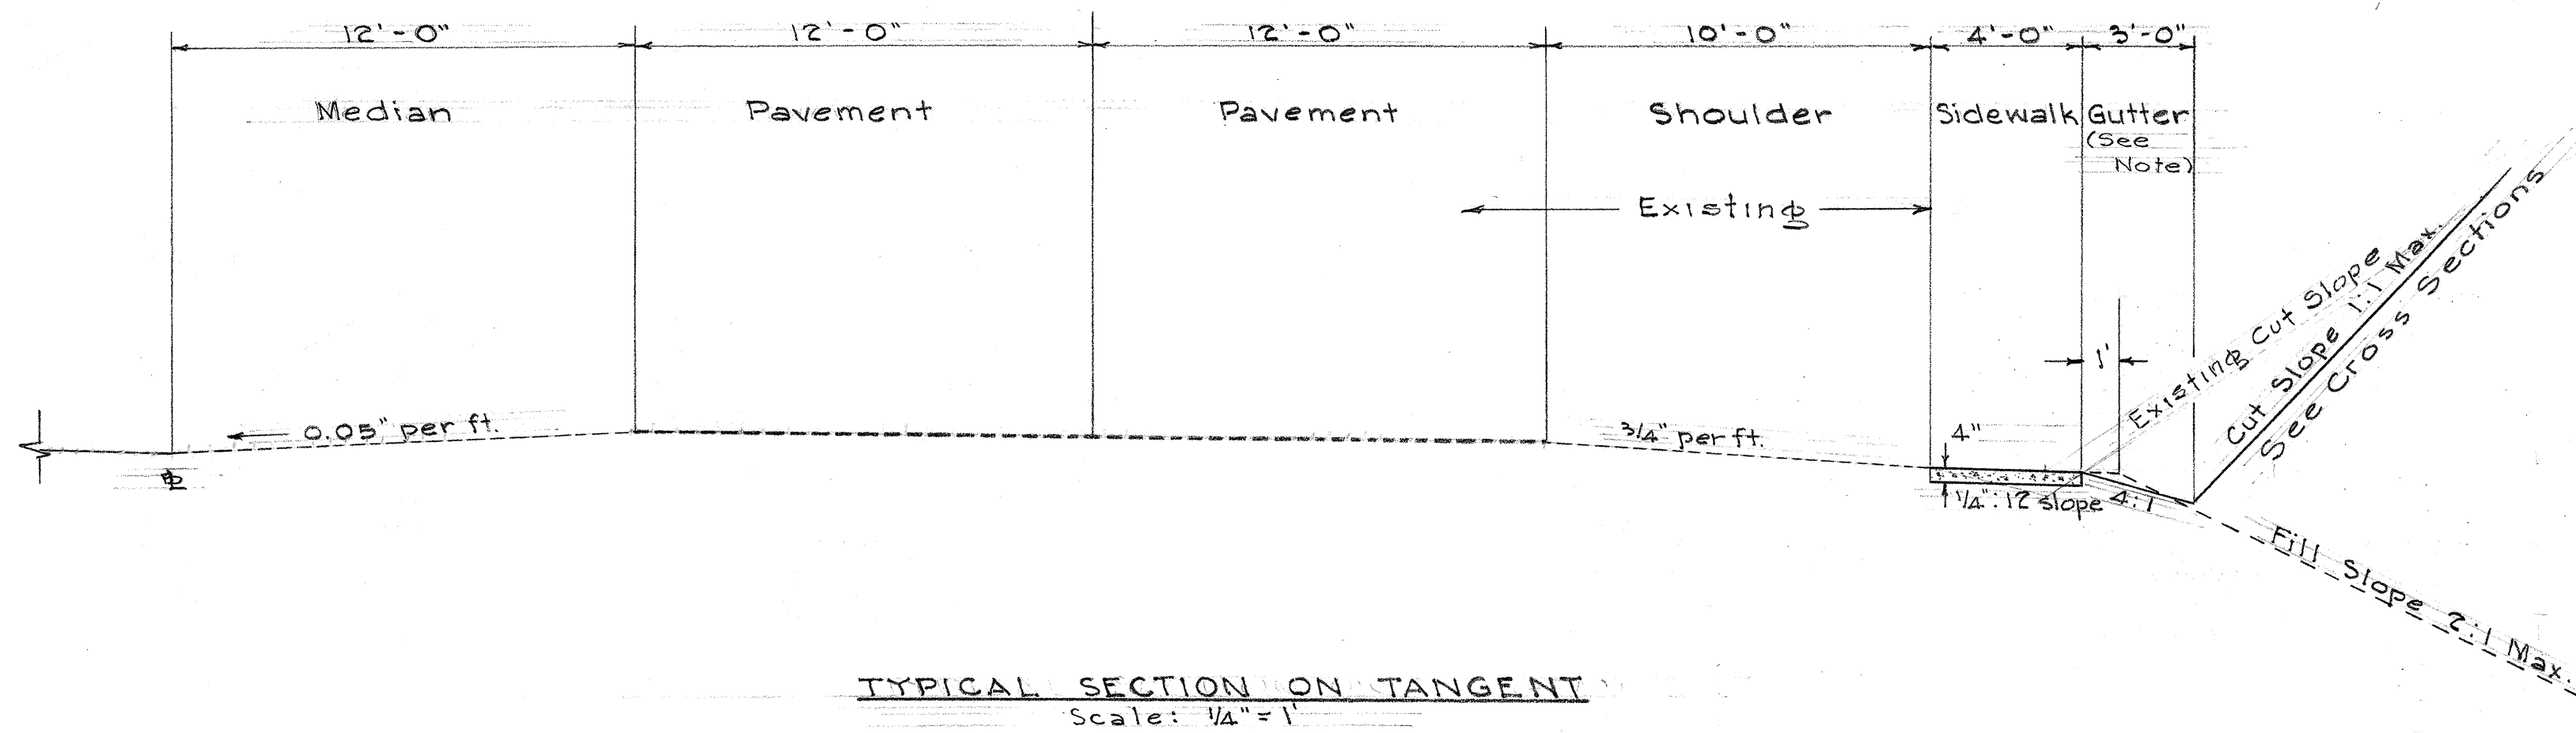


TYPICAL SECTION ON TANGENT
Scale: 1/4" = 1'

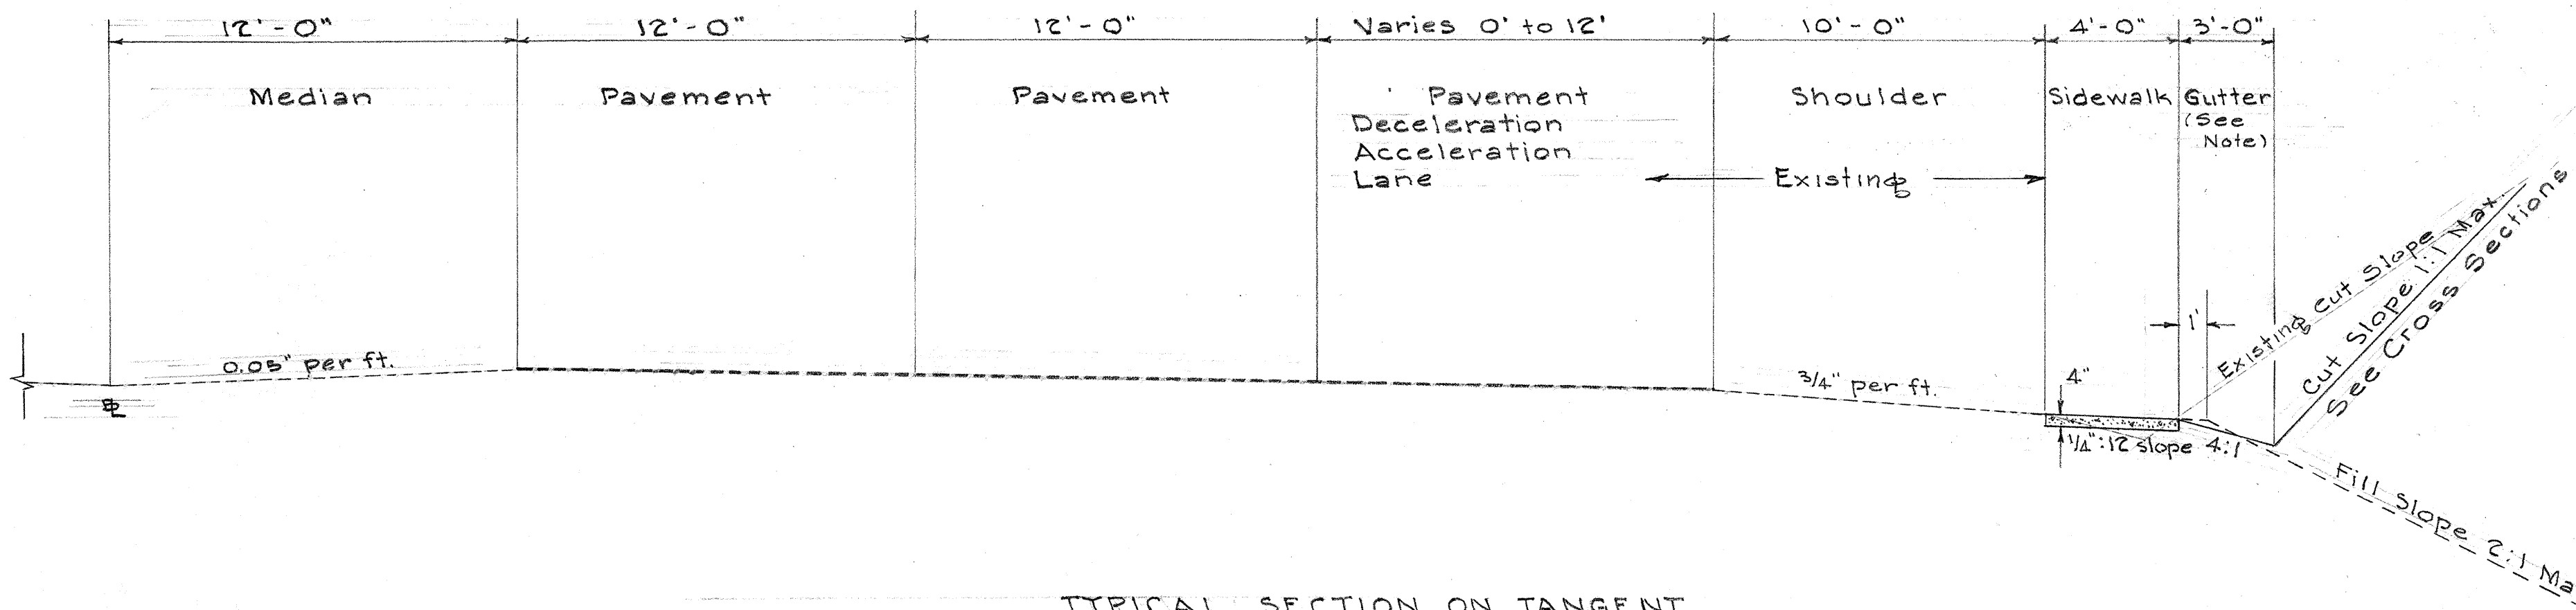


TYPICAL SECTION ON TANGENT
AT DECELERATION AND ACCELERATION LANES
Scale: 1/4" = 1'

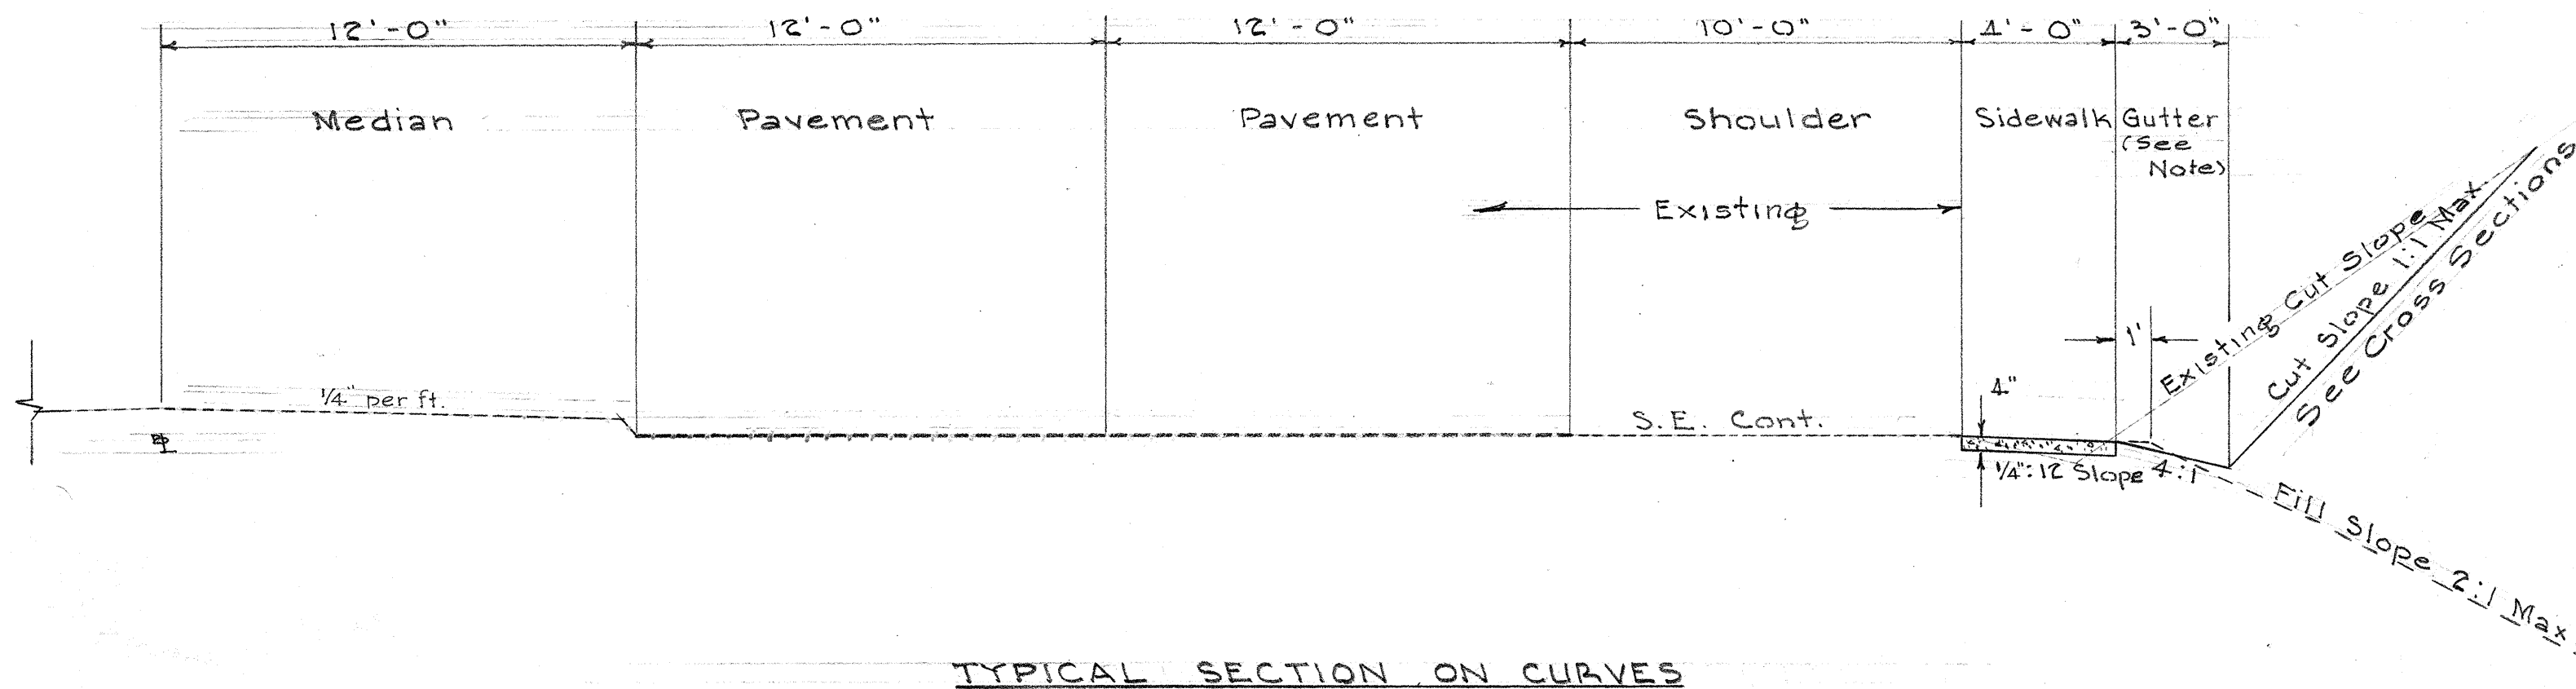

TYPICAL SECTION ON CURVES
Scale: 1/4" = 1'

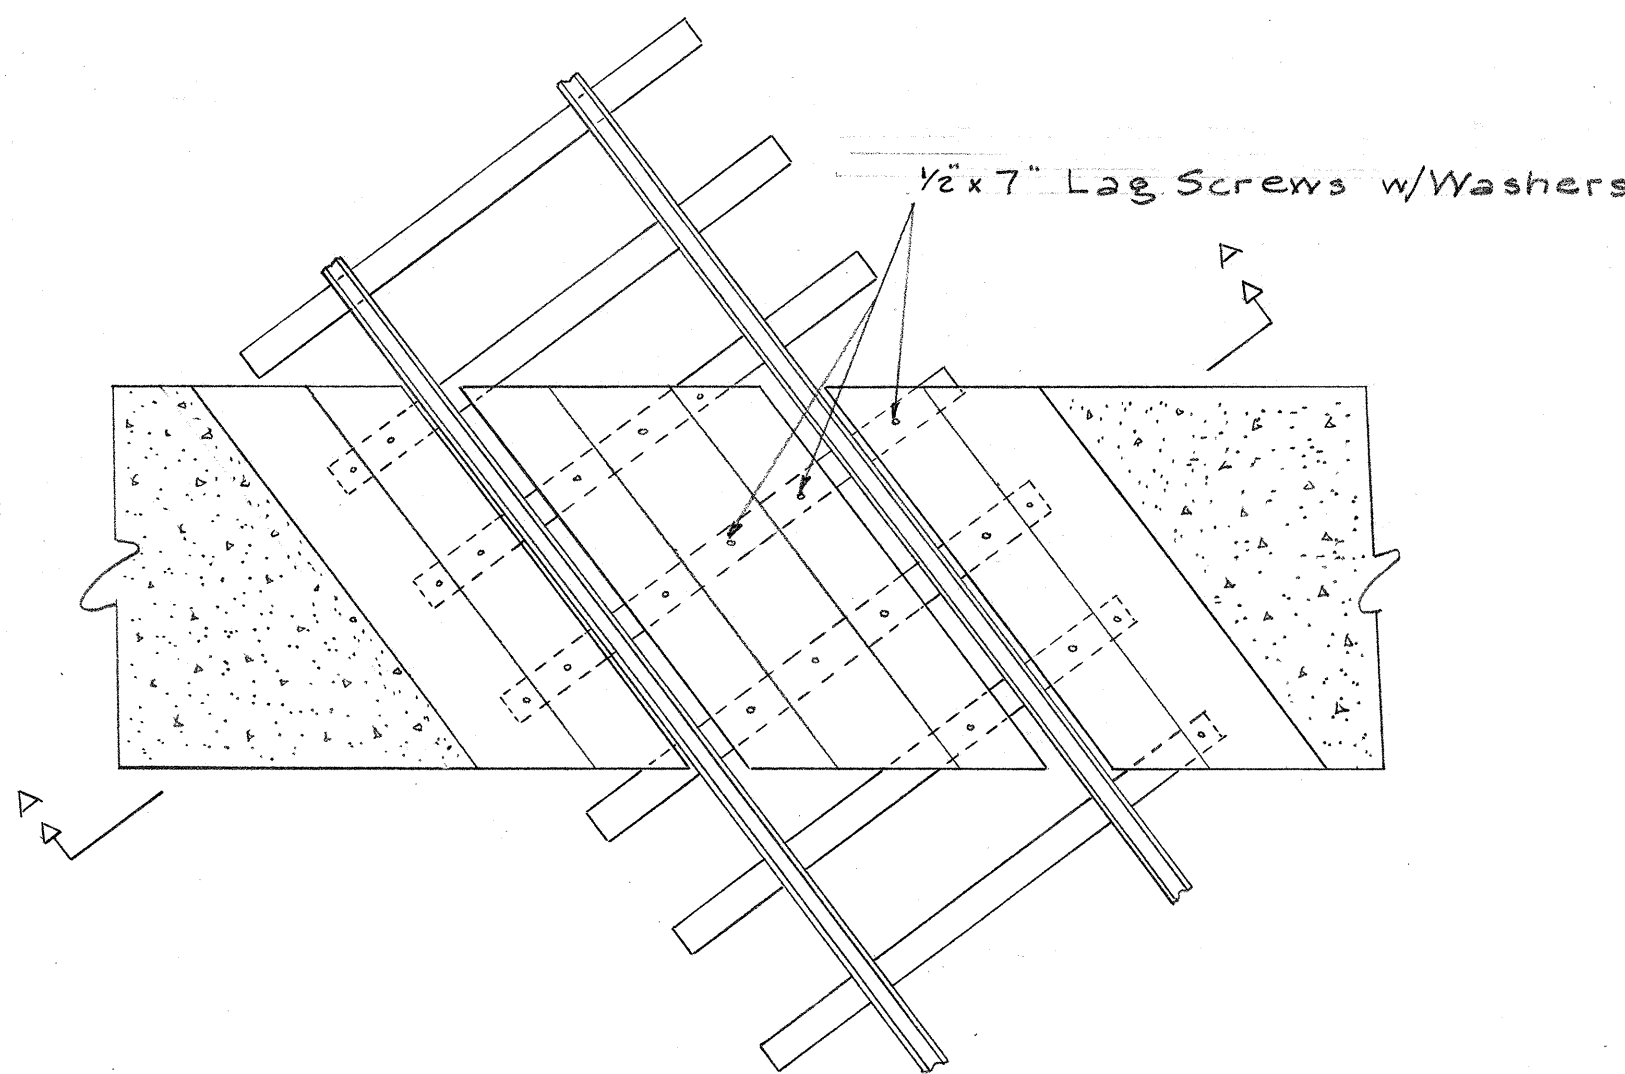


PLAN
Scale: 1/2" = 1'

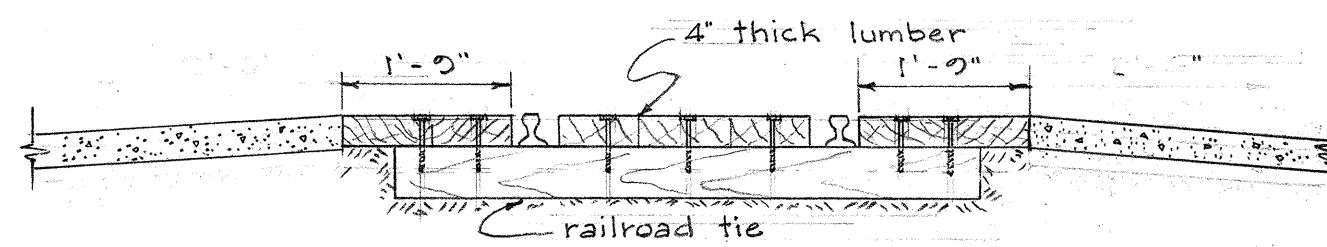

SECTION A-A
Scale: 1/2" = 1'

DETAIL OF RAILROAD TRACK CROSSING

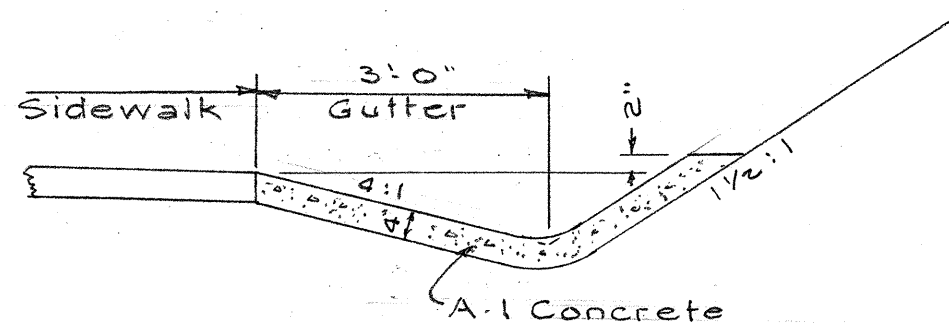

DETAIL OF CAST-IN-PLACE
CONCRETE GUTTER
Scale: 1/2" = 1'-0"

DEPARTMENT OF TRANSPORTATION HIGHWAYS DIVISION STATE OF HAWAII
TYPICAL SECTIONS DETAILS
KAAHUMANU AVE. SIDEWALK
Proj. No. B-32-02-63

DESIGNED BY	DATE
DRAWN BY	
CHECKED BY	
QUANTITIES CHECKED BY	
NOTE BOOK	
No.	