

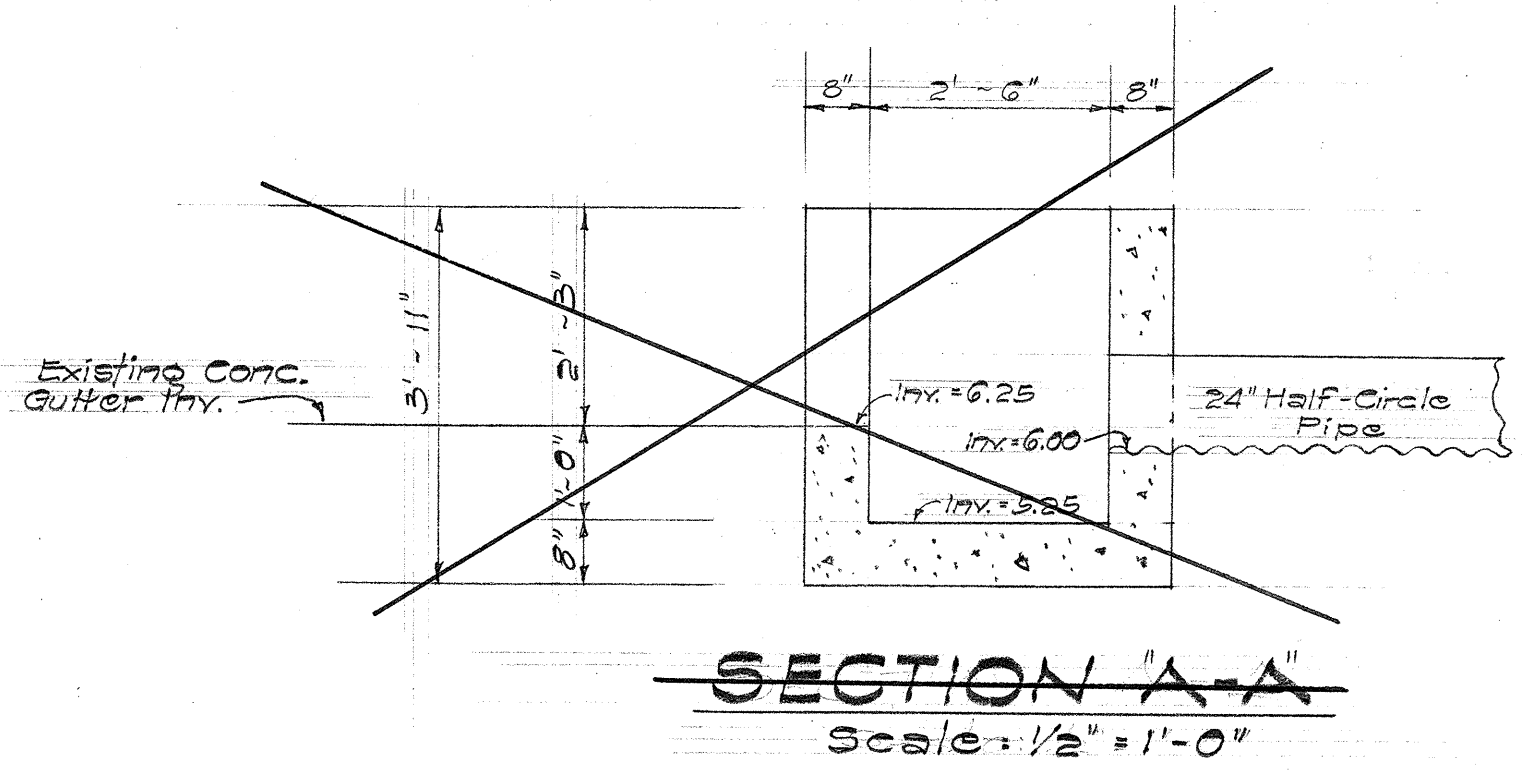
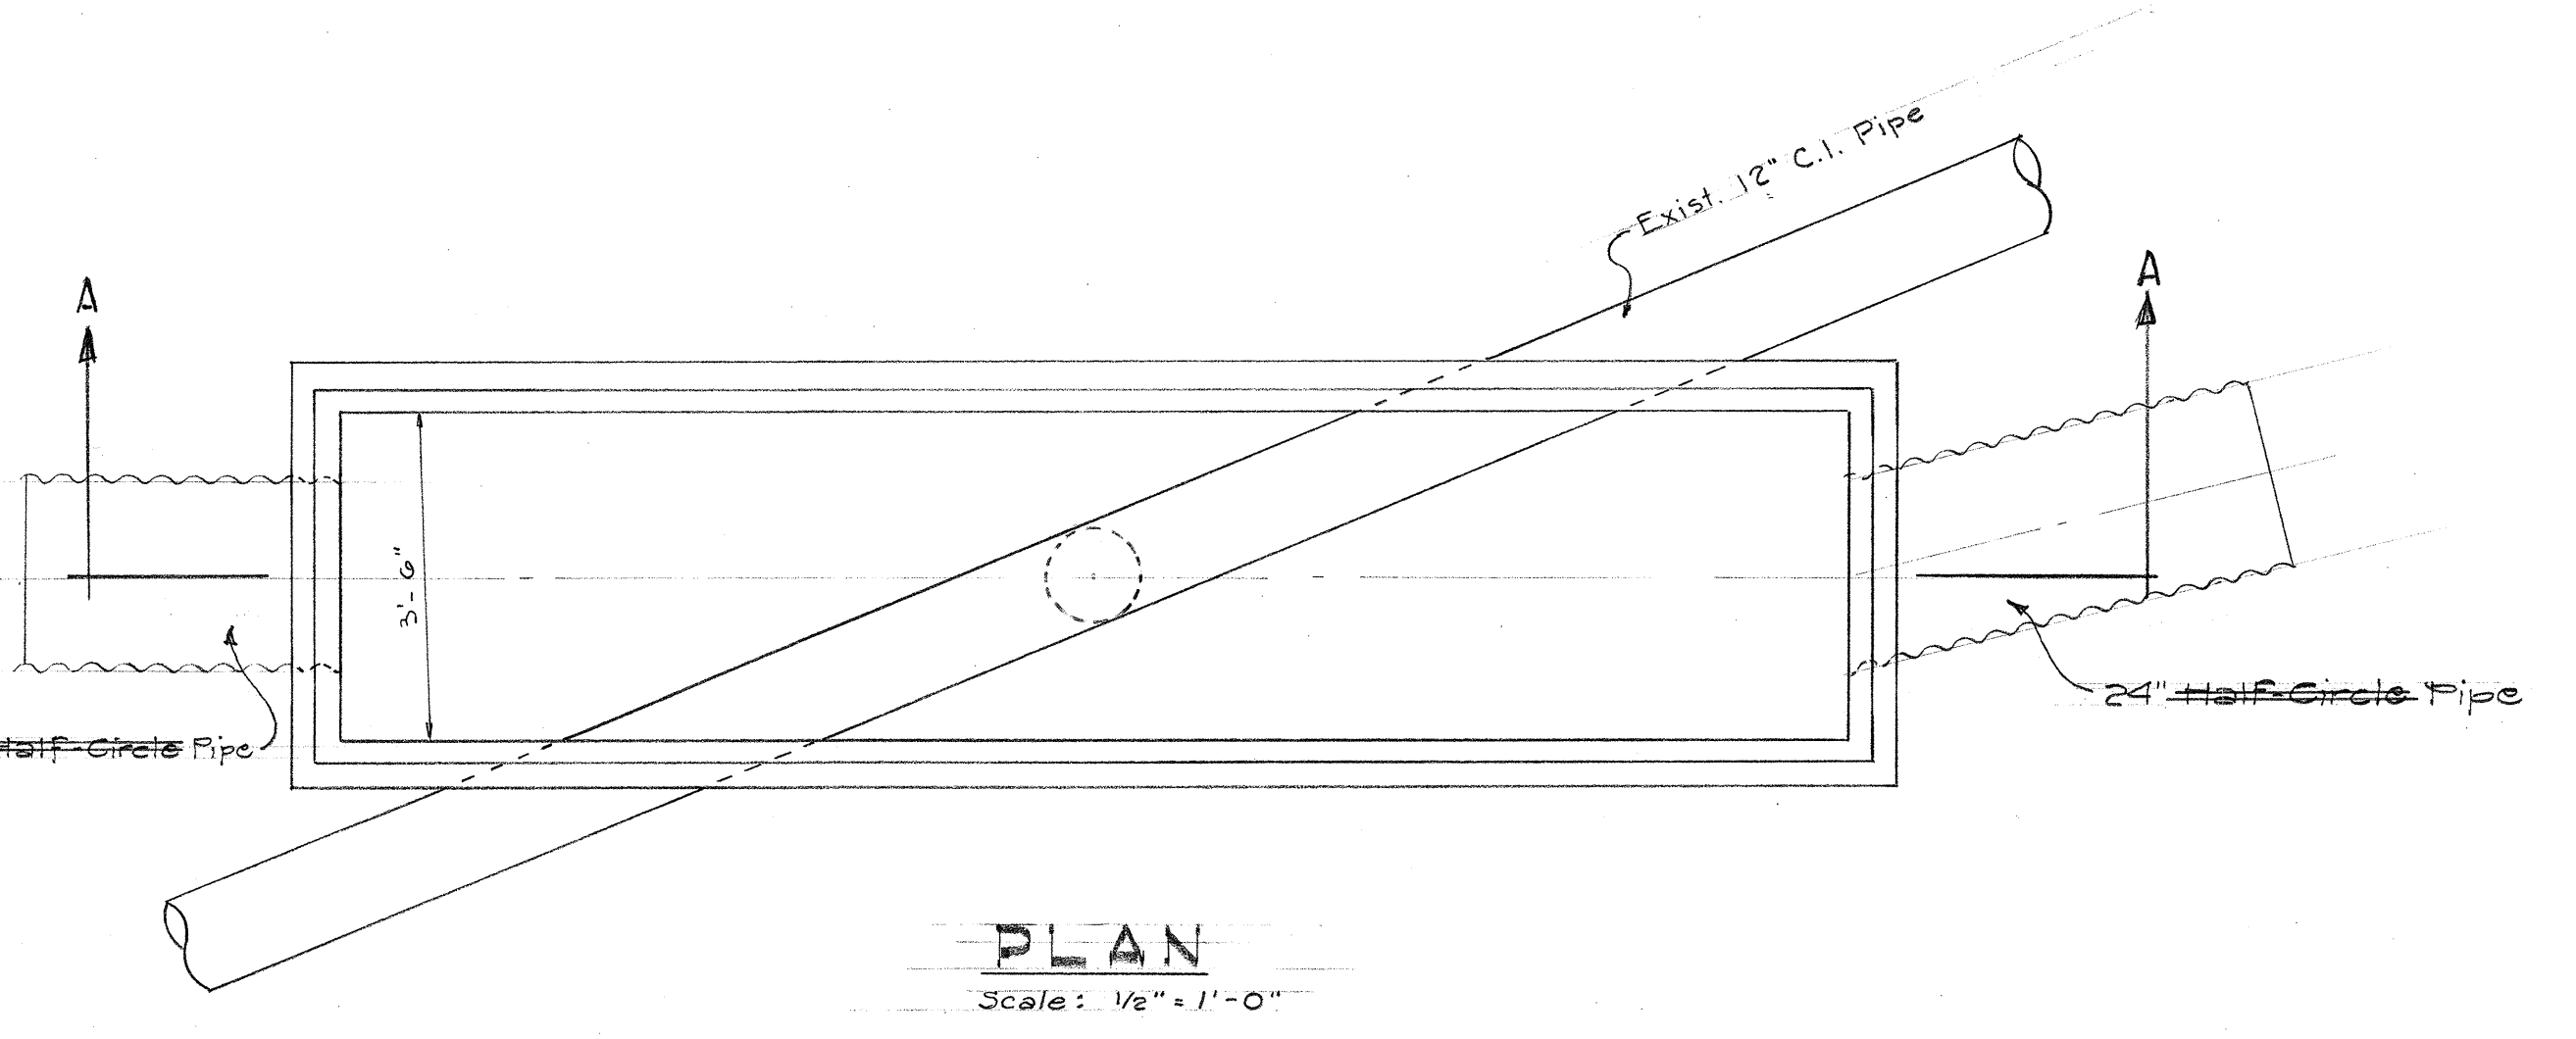
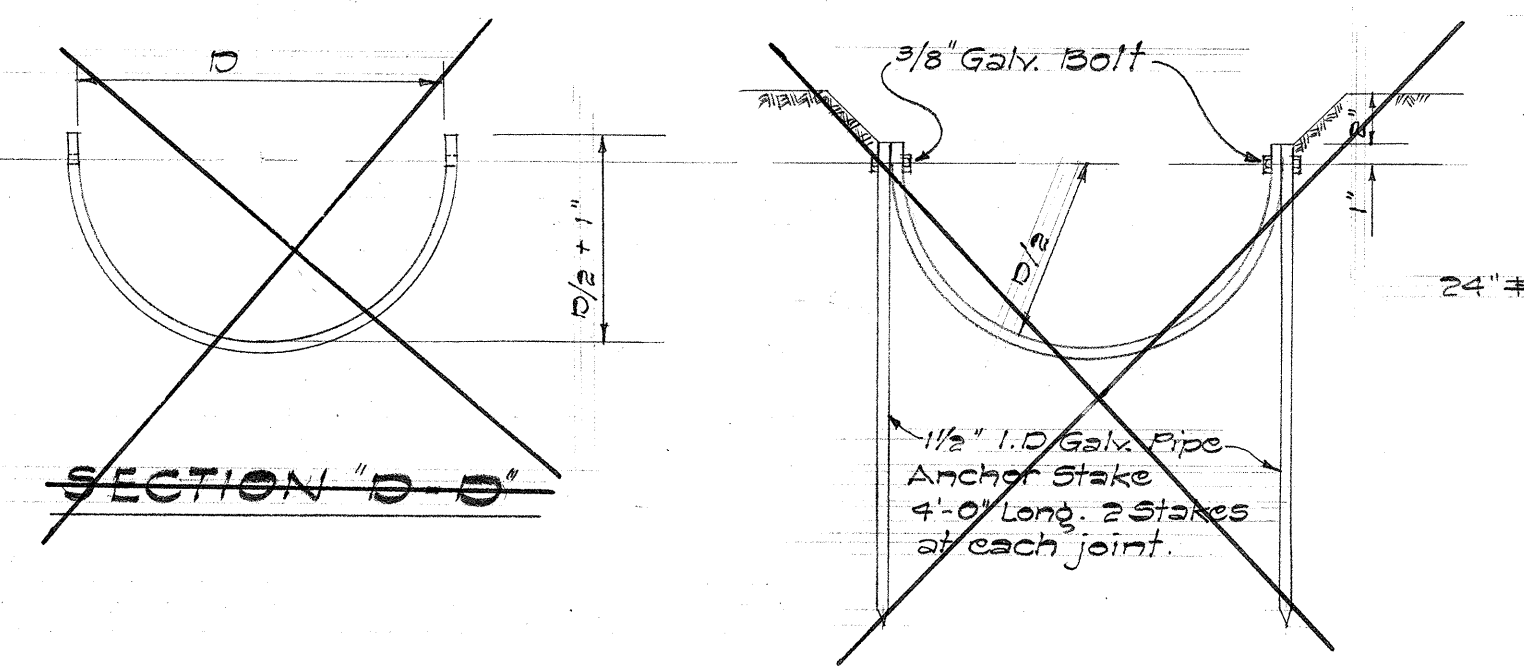
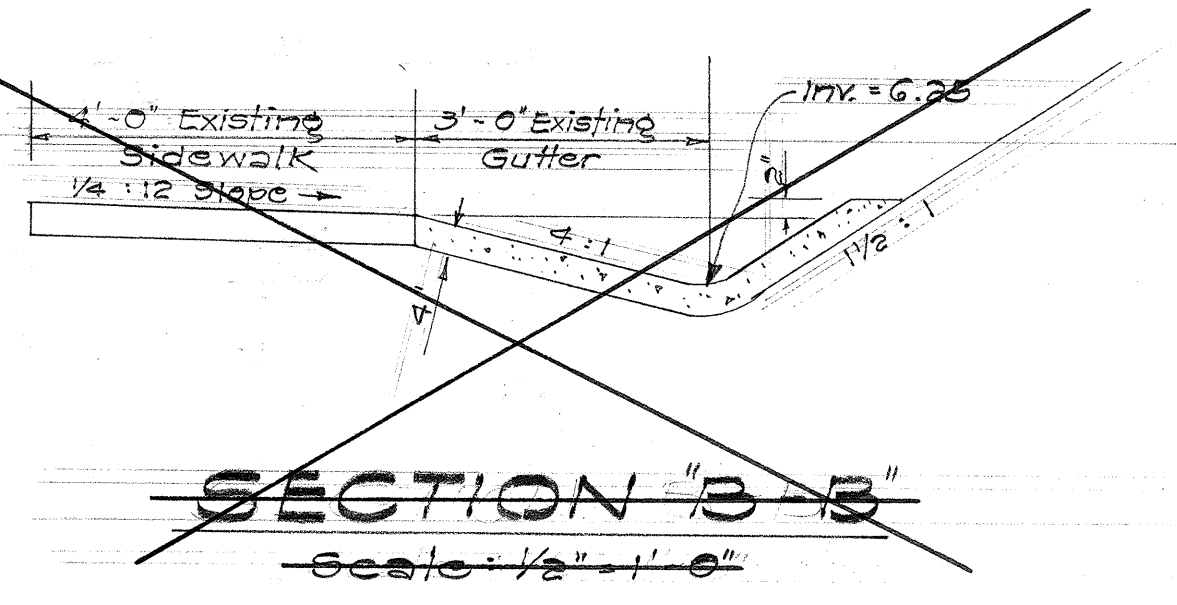



FED. ROAD DIST. NO.	STATE	FED. AID PROJ. NO.	FISCAL YEAR	SHEET NO.	TOTAL SHEETS
HAWAII	HAW.	5-32-01-65	1965	4	5

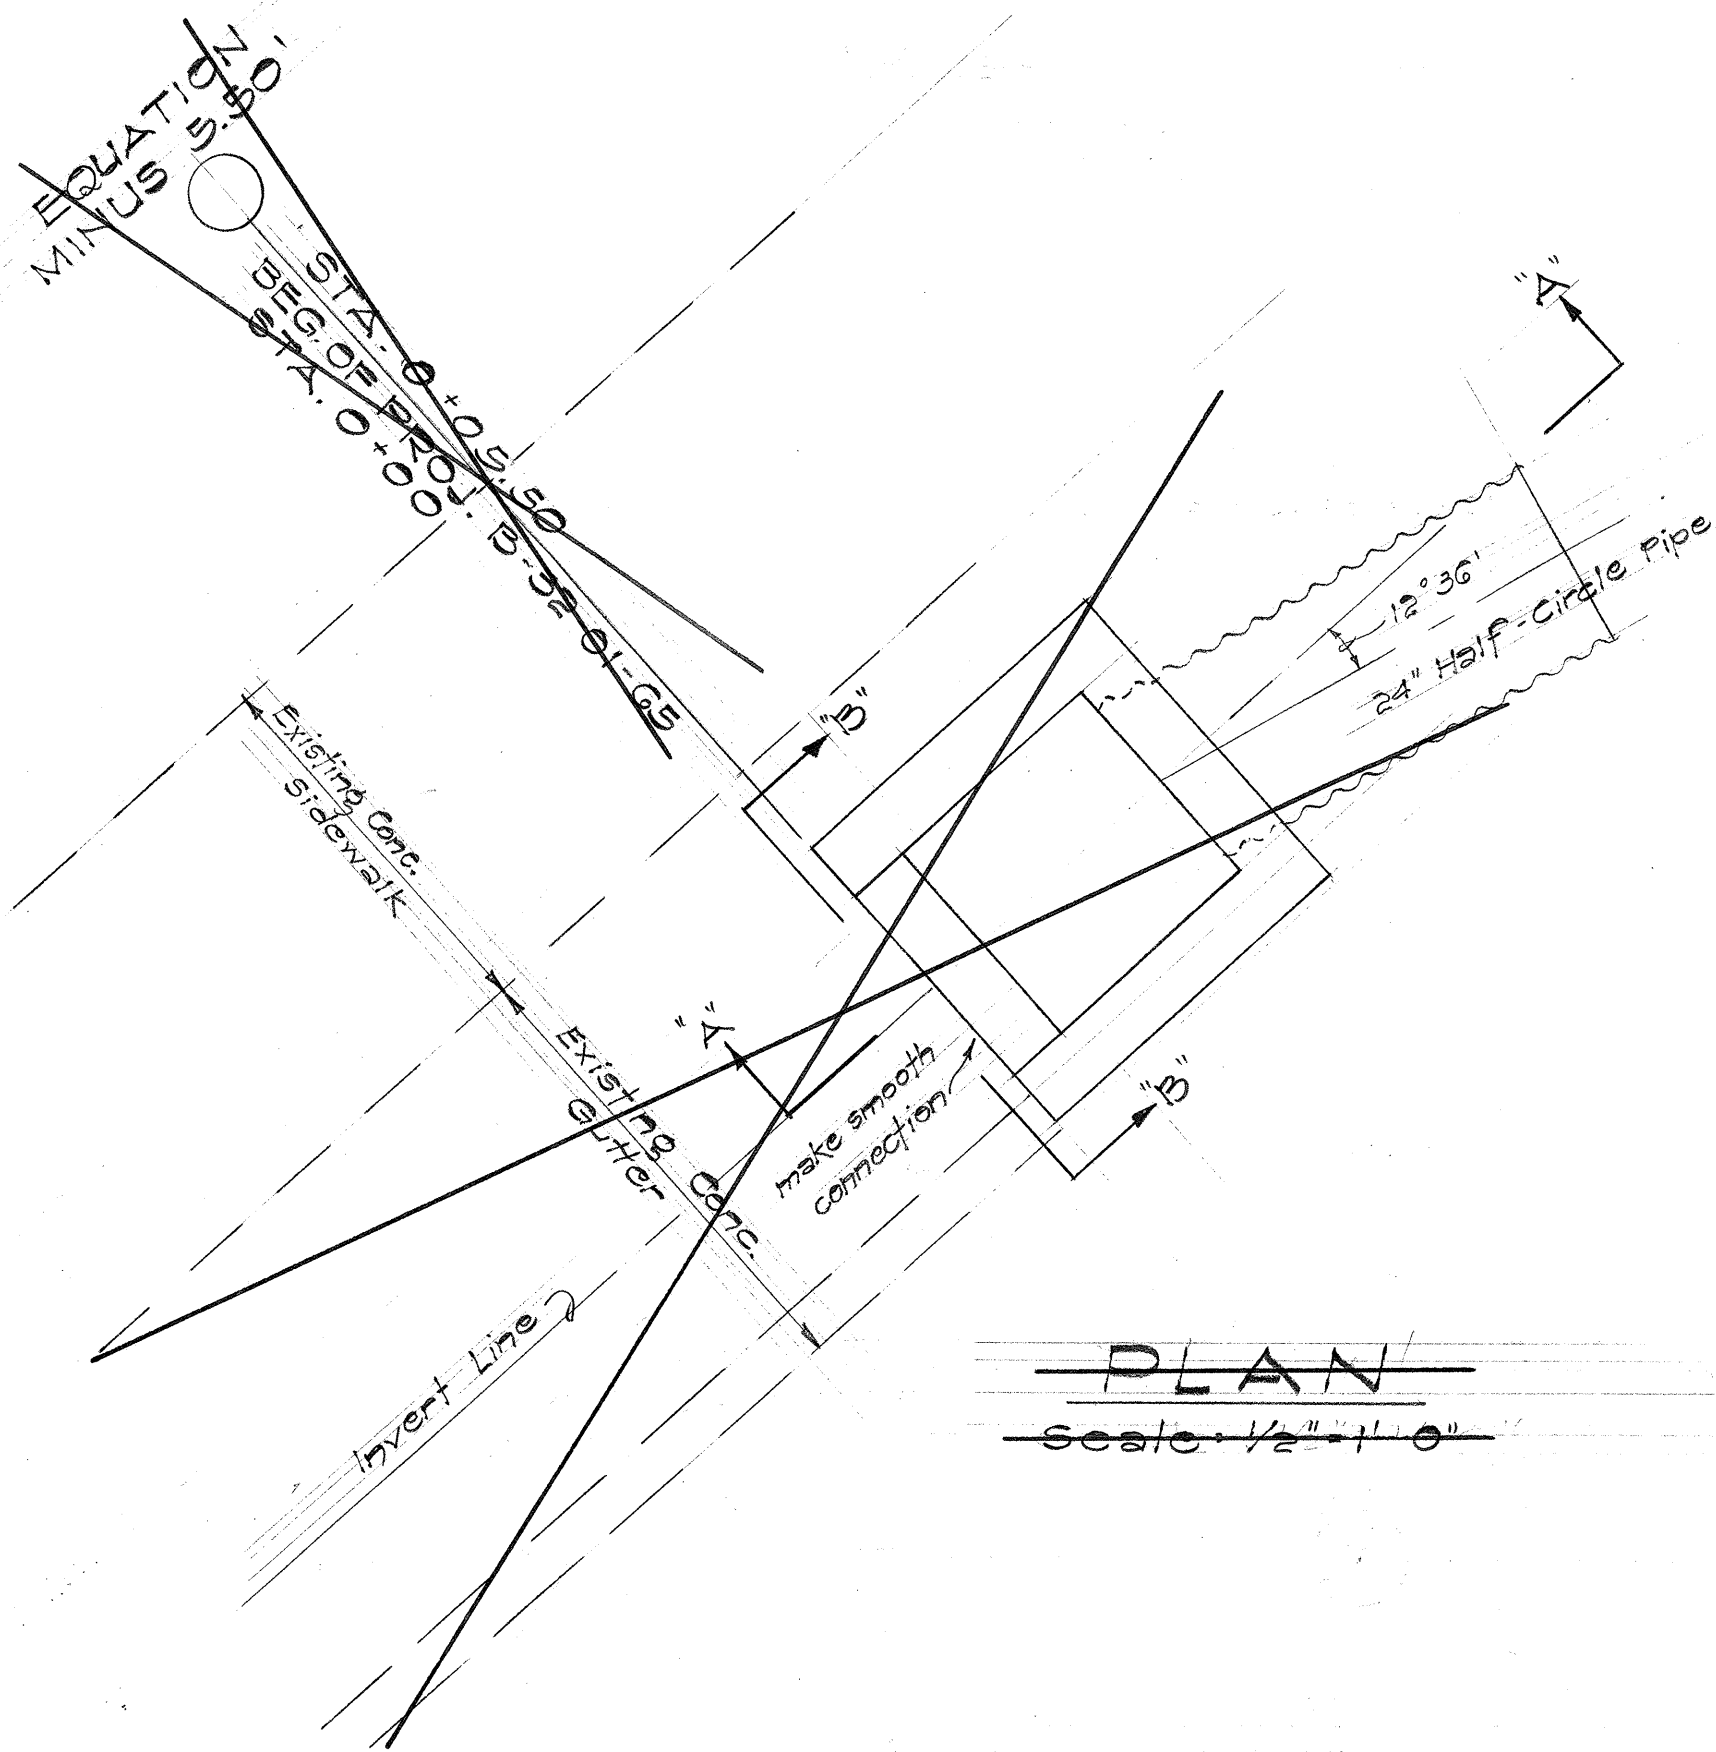

DETAIL OF CONC. DROP INTAKE
AT STA. 0+00 = STA. 0+05.50
 Scale: 1/2" = 1'-0"

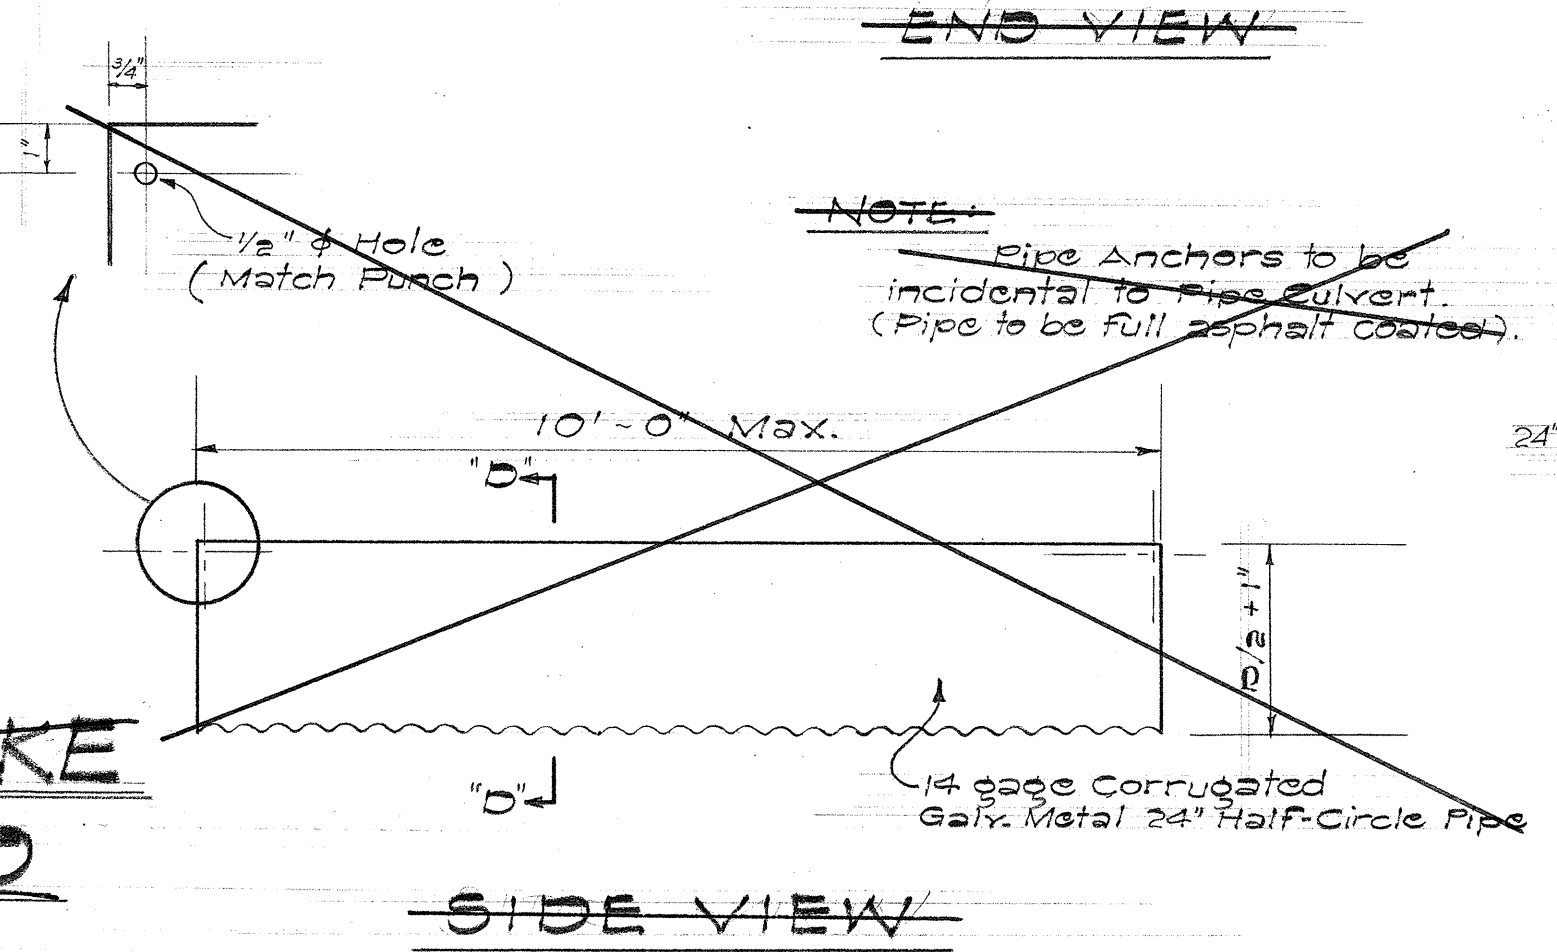

DETAIL OF 24" HALF-CIRCLE CORR. GALV. PIPE CULVERT
 Not to Scale

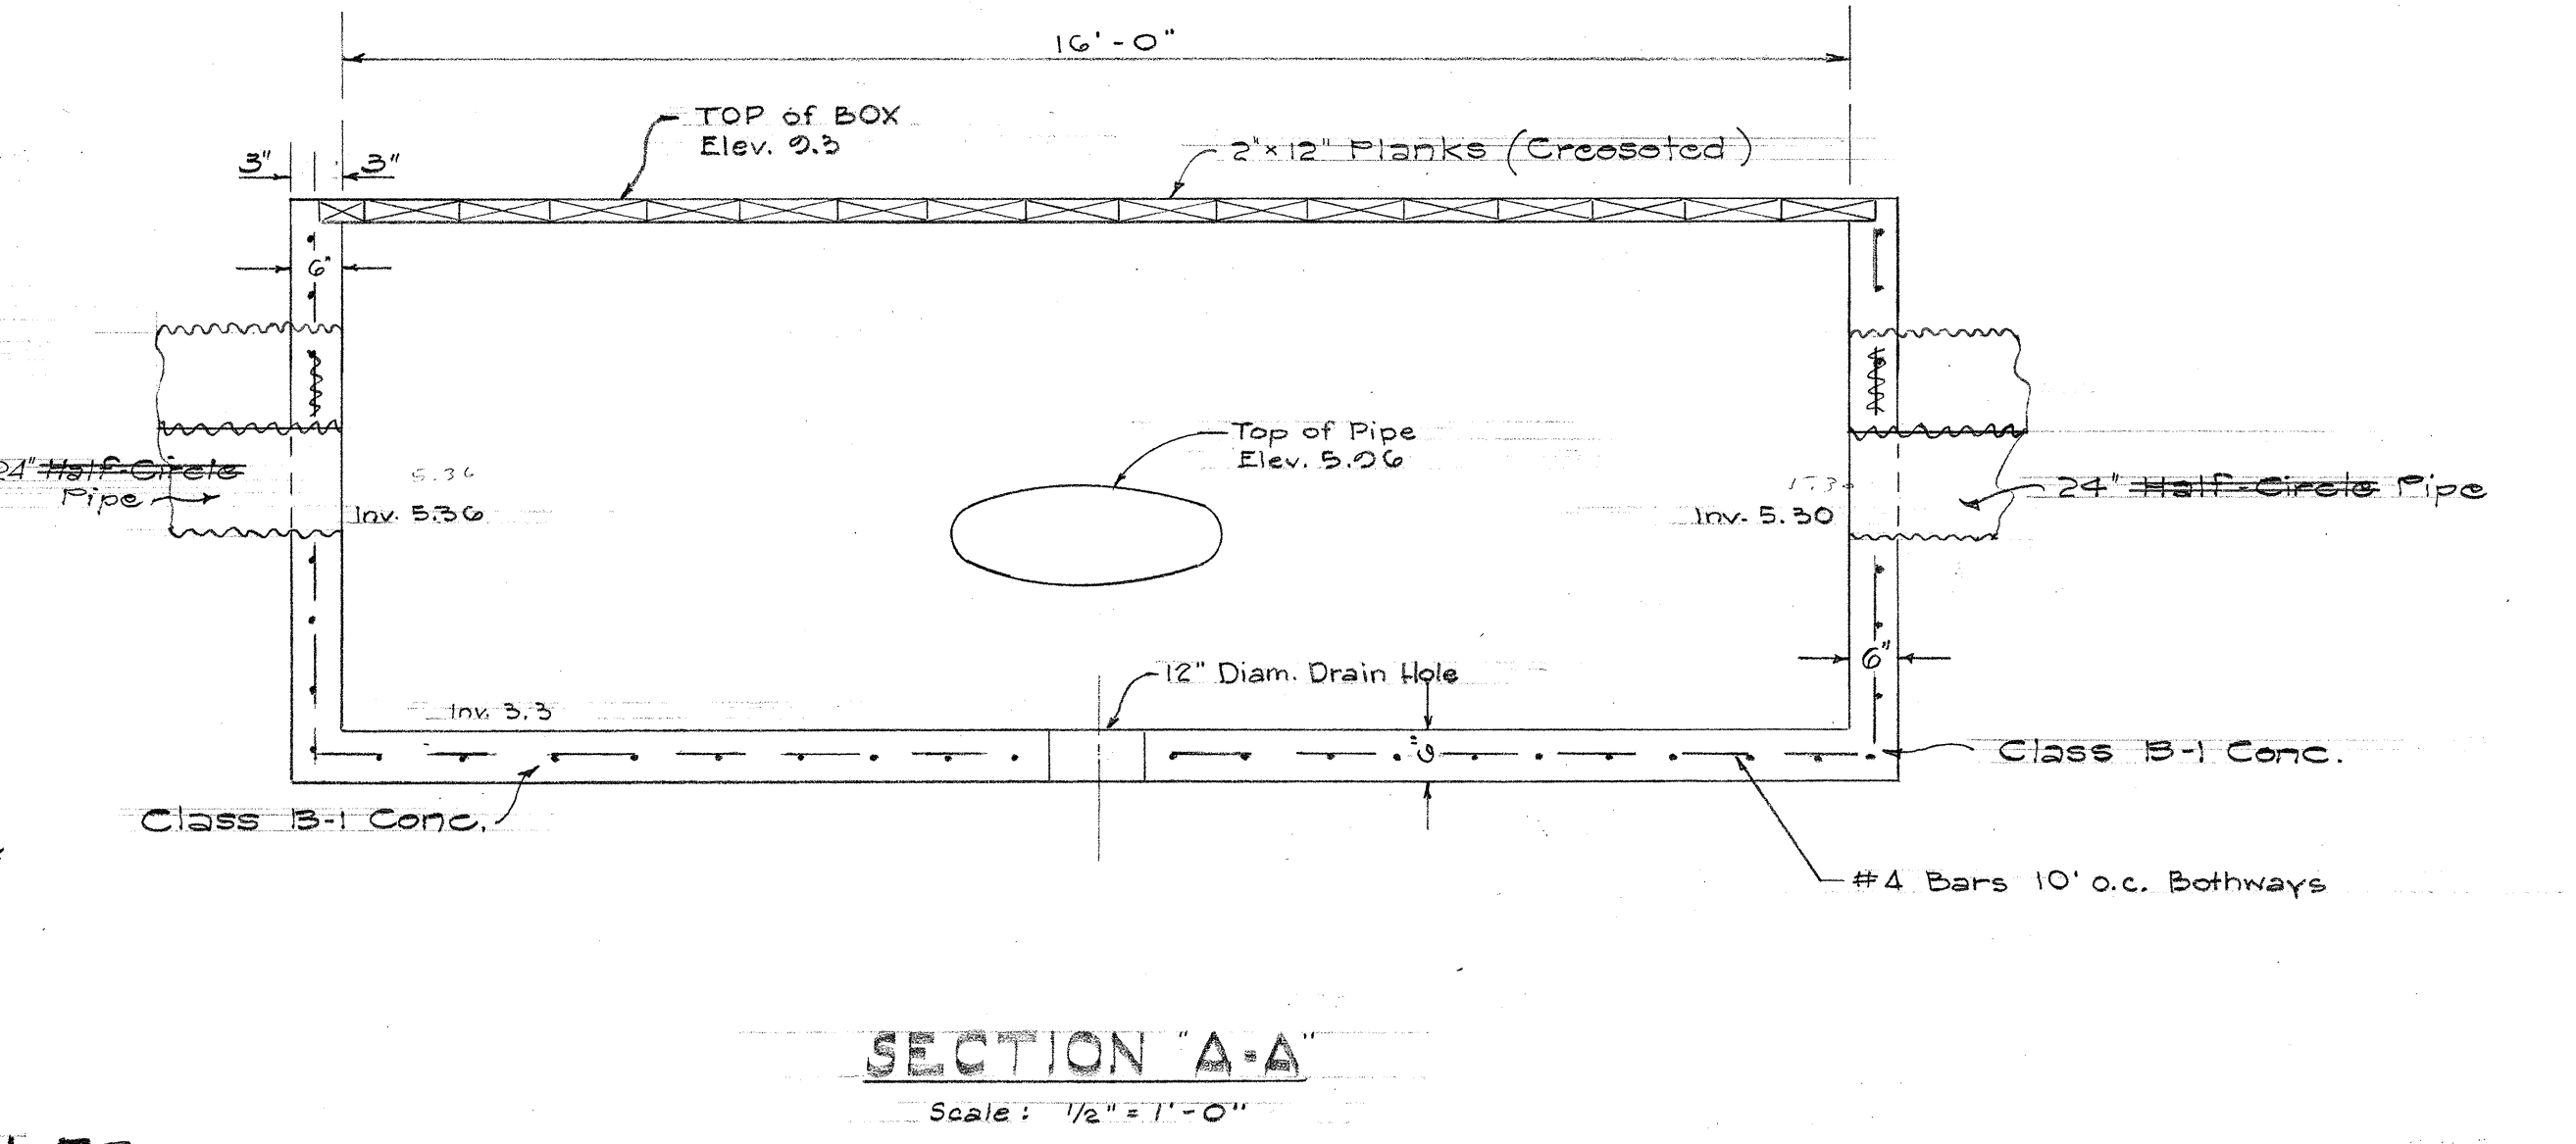

SIPHON BOX

STATE OF HAWAII
 DEPARTMENT OF TRANSPORTATION
 HIGHWAYS DIVISION

DETAILS OF
KAAHUMANU AVENUE
STORM DRAIN
 PROJ. NO. 13-32-01-65

Scale: As Shown Date: Jan., 1965

SHEET No. 4 OF 5 SHEETS

ORIGINAL PLAN	DATE
DESIGNED BY	
CHECKED BY	
NOTED BY	
NO.	

