


INDEX TO DRAWINGS	
SHEET NO	DESCRIPTION
1	TITLE SHEET
2-3	PLAN & PROFILE
4-5	DRAINAGE DETAILS

CONVENTIONAL SIGNS	
Centerline	
Boundary Lines	
Fences (Named)	
Existing Roadways	
Circular Culvert	
Box Culvert	
Bridge	
Telephone Pole	
Electric Power Pole	
Water Main	
Storm Drain	
Concrete Drop Intake	
Standard Catch Basin	
Standard Manhole	
Sewer Manhole	
Telephone Manhole	
Fire Hydrant	
Trees (Named)	
Railroad	

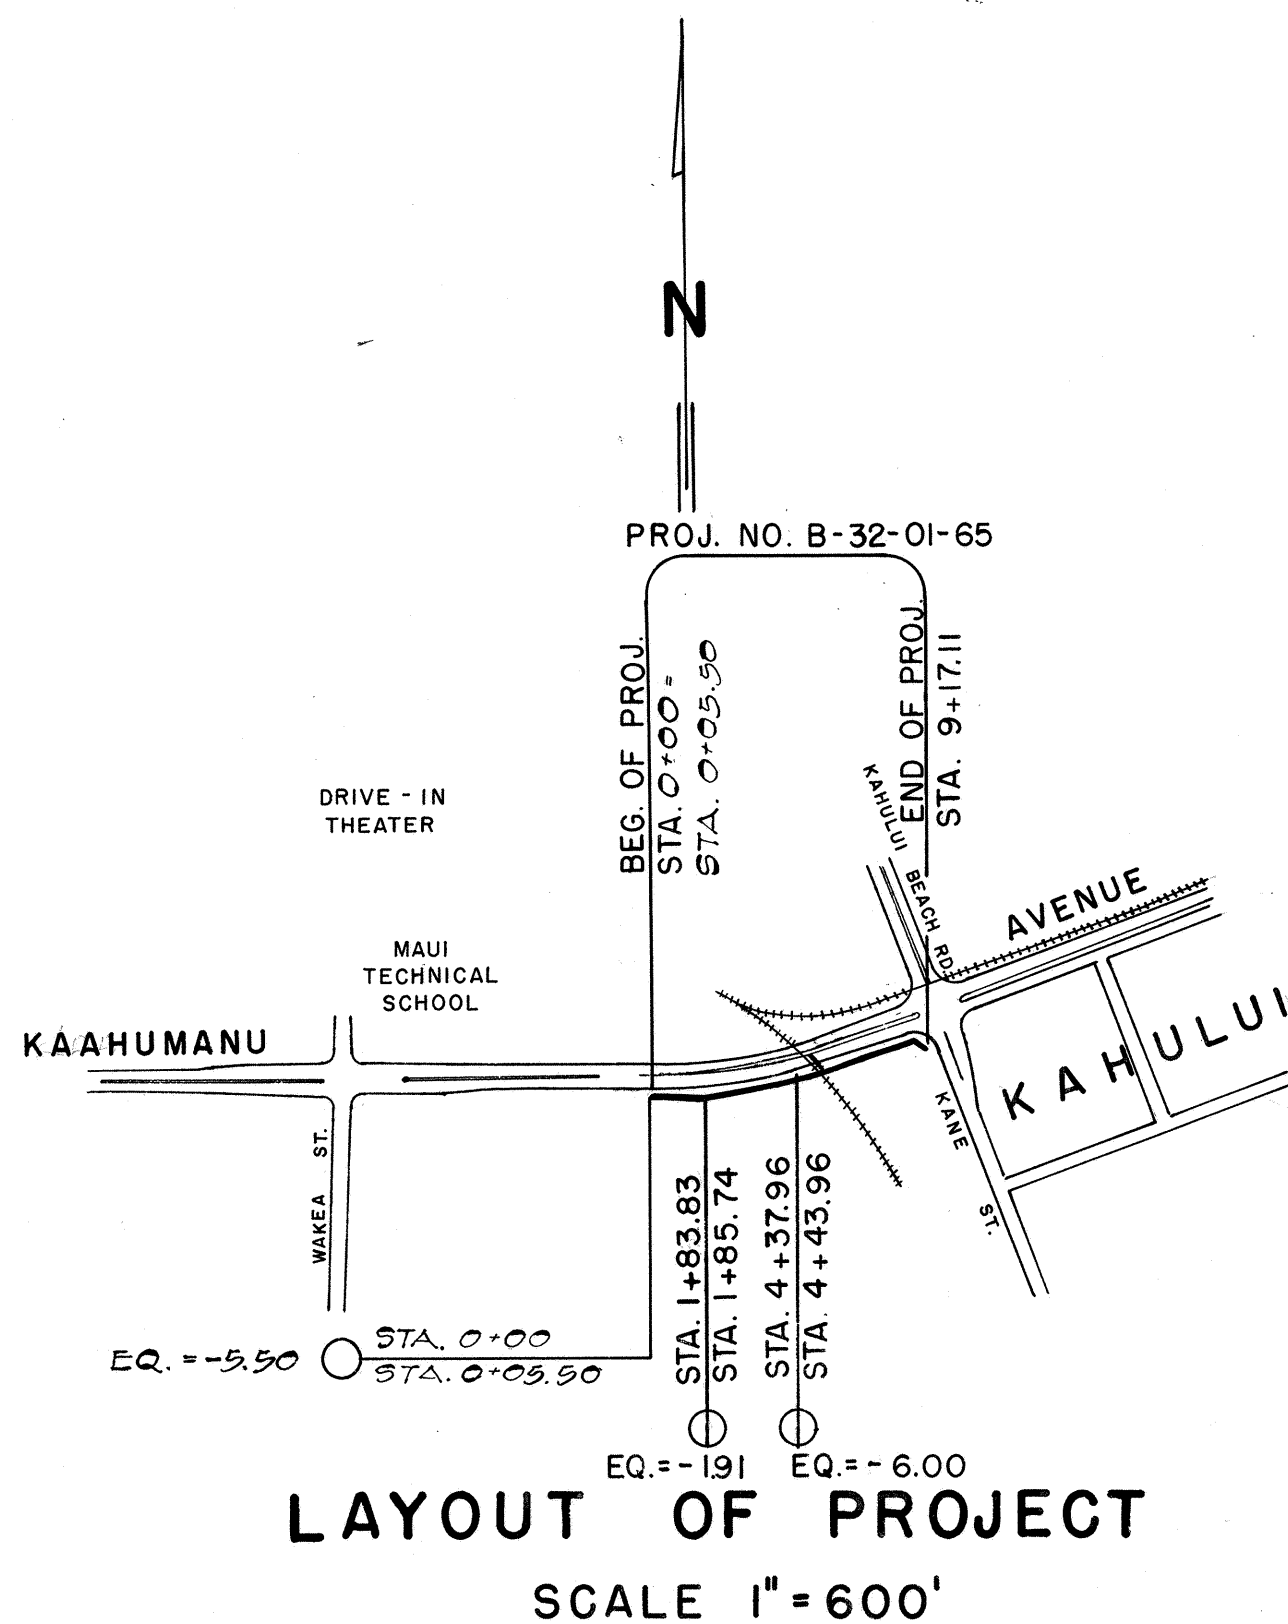


NET LENGTH OF PROJECT 0.171 MI.

STATE OF HAWAII
DEPARTMENT OF TRANSPORTATION
HIGHWAYS DIVISION
HONOLULU, HAWAII

"AS BUILT"
PLANS OF
KAAHUMANU AVENUE
STORM DRAIN
PROJECT NO. B-32-01-65
DISTRICT OF WAILUKU
ISLAND OF MAUI

SCALE
PLAN 1 IN. = 20 FT.
PROFILE HOR. 1 IN. = 20 FT.
VER. 1 IN. = 2 FT.

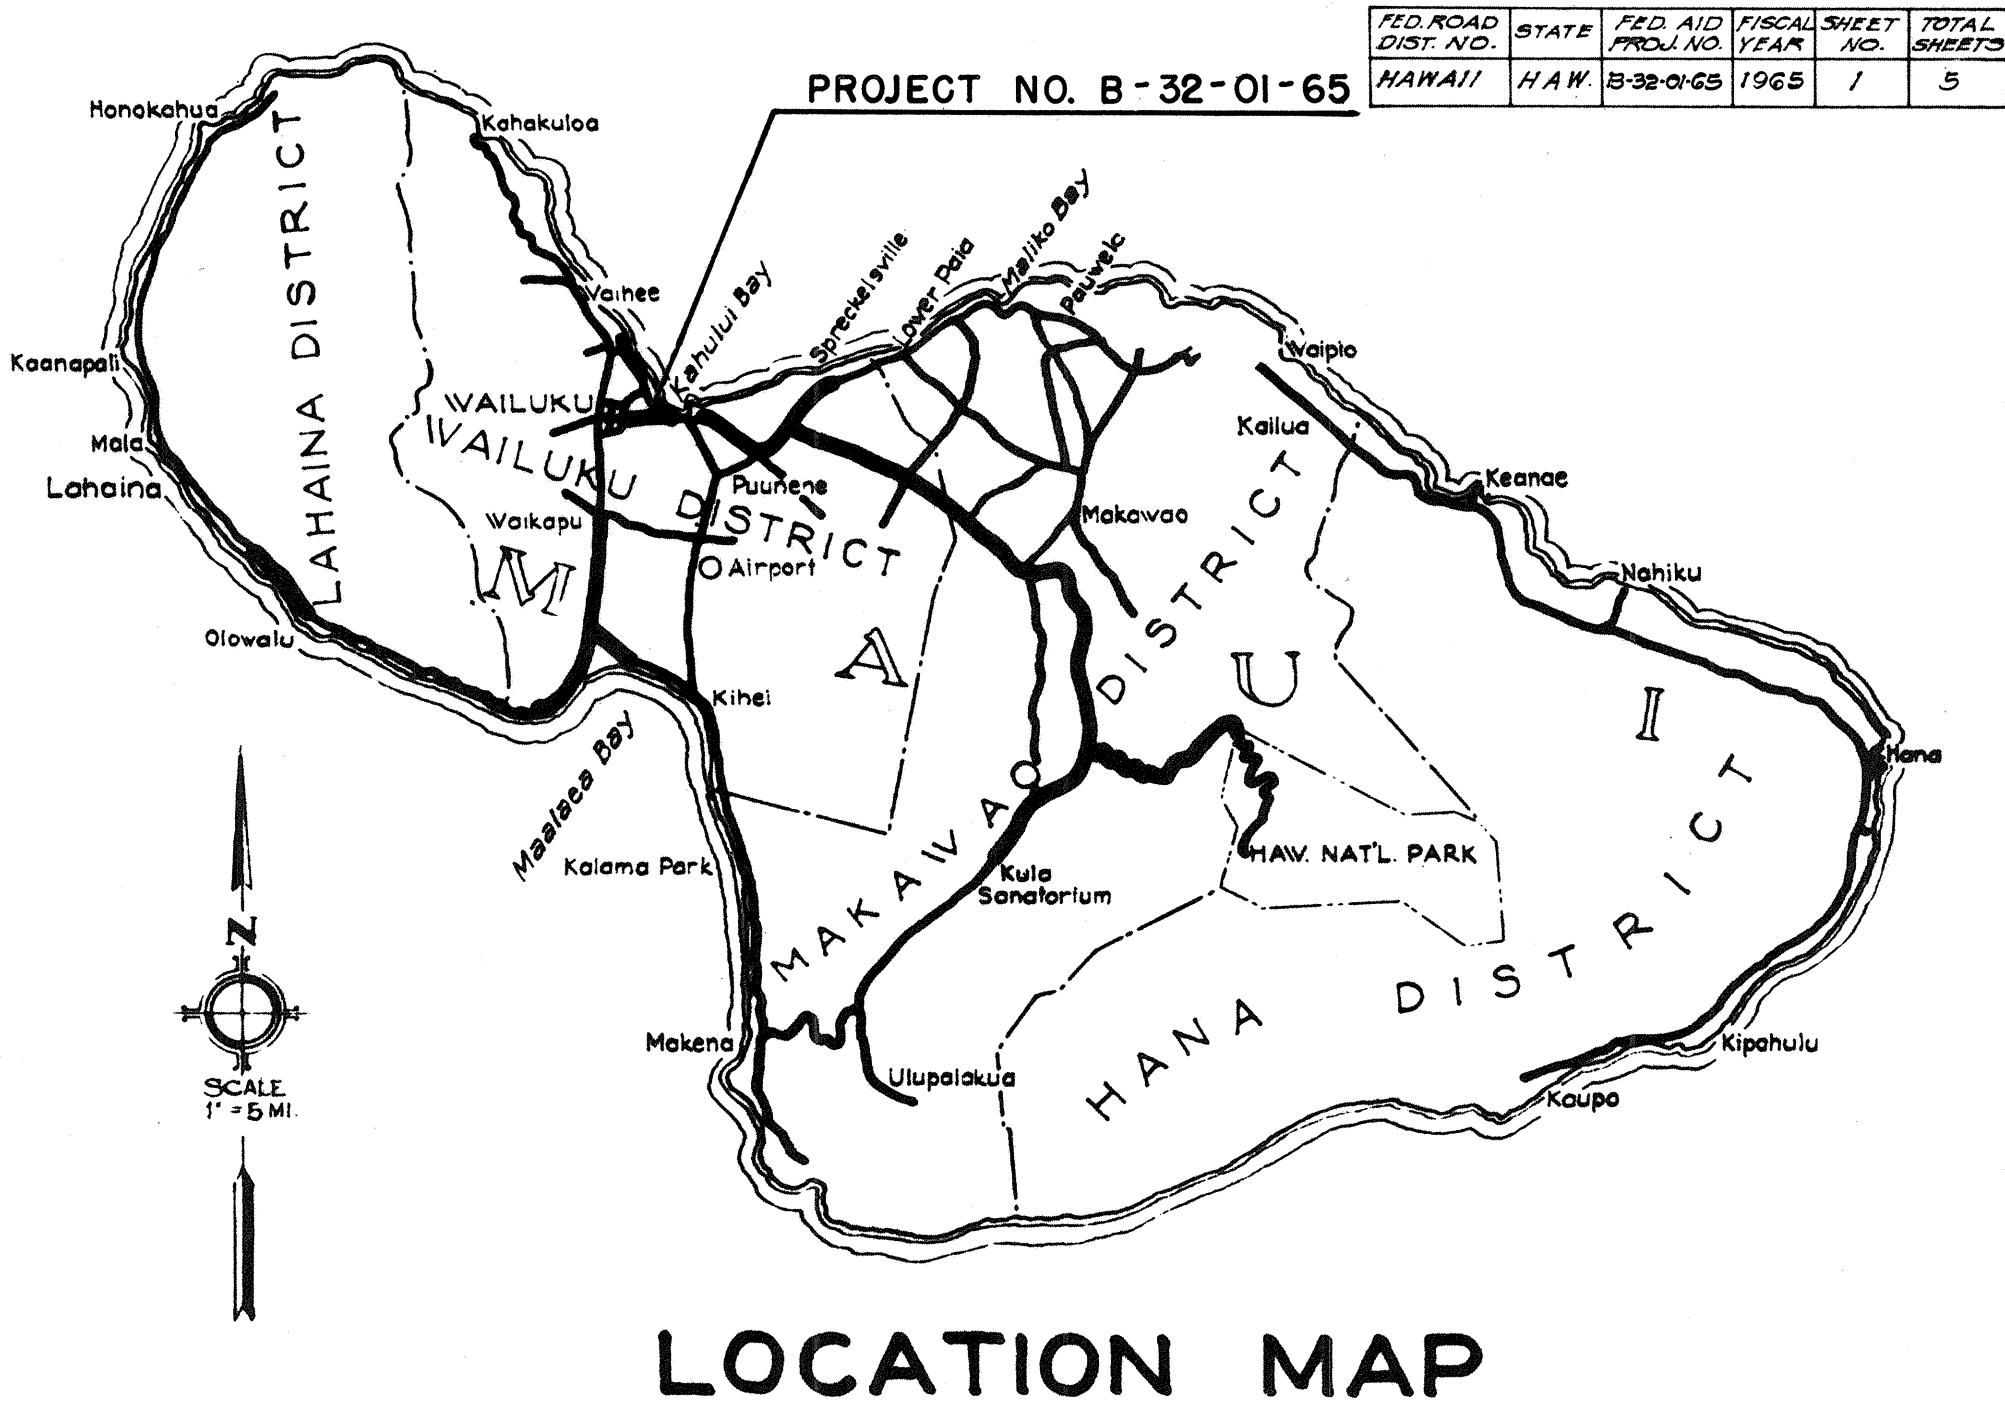

NOTE:
ALL CHANGES MADE DURING
CONSTRUCTION HAVE BEEN
NOTED IN RED ON THESE
SHEETS & CHECKED BY.

Jorge Obach
PROJECT ENGINEER
Mar. 28, 1967
DATE

APPROVED: *Jorge Obach* DATE *11 Feb 65*
DIRECTOR OF TRANSPORTATION