

INDEX TO DRAWINGS	
SHEET NO	DESCRIPTION
1	TITLE SHEET
2	TRAFFIC SIGNAL SYSTEM
3-5	MISCELLANEOUS DETAILS

STATE OF HAWAII

DEPARTMENT OF TRANSPORTATION

HIGHWAYS DIVISION

HONOLULU, HAWAII

"AS BUILT" PLANS FOR

INSTALLATION OF TRAFFIC SIGNALS

ON

KAAHUMANU AVENUE

AT


LONO AVENUE

FEDERAL AID PROJECT NO.

F-032-1(5)

DISTRICT OF WAILUKU


ISLAND OF MAUI

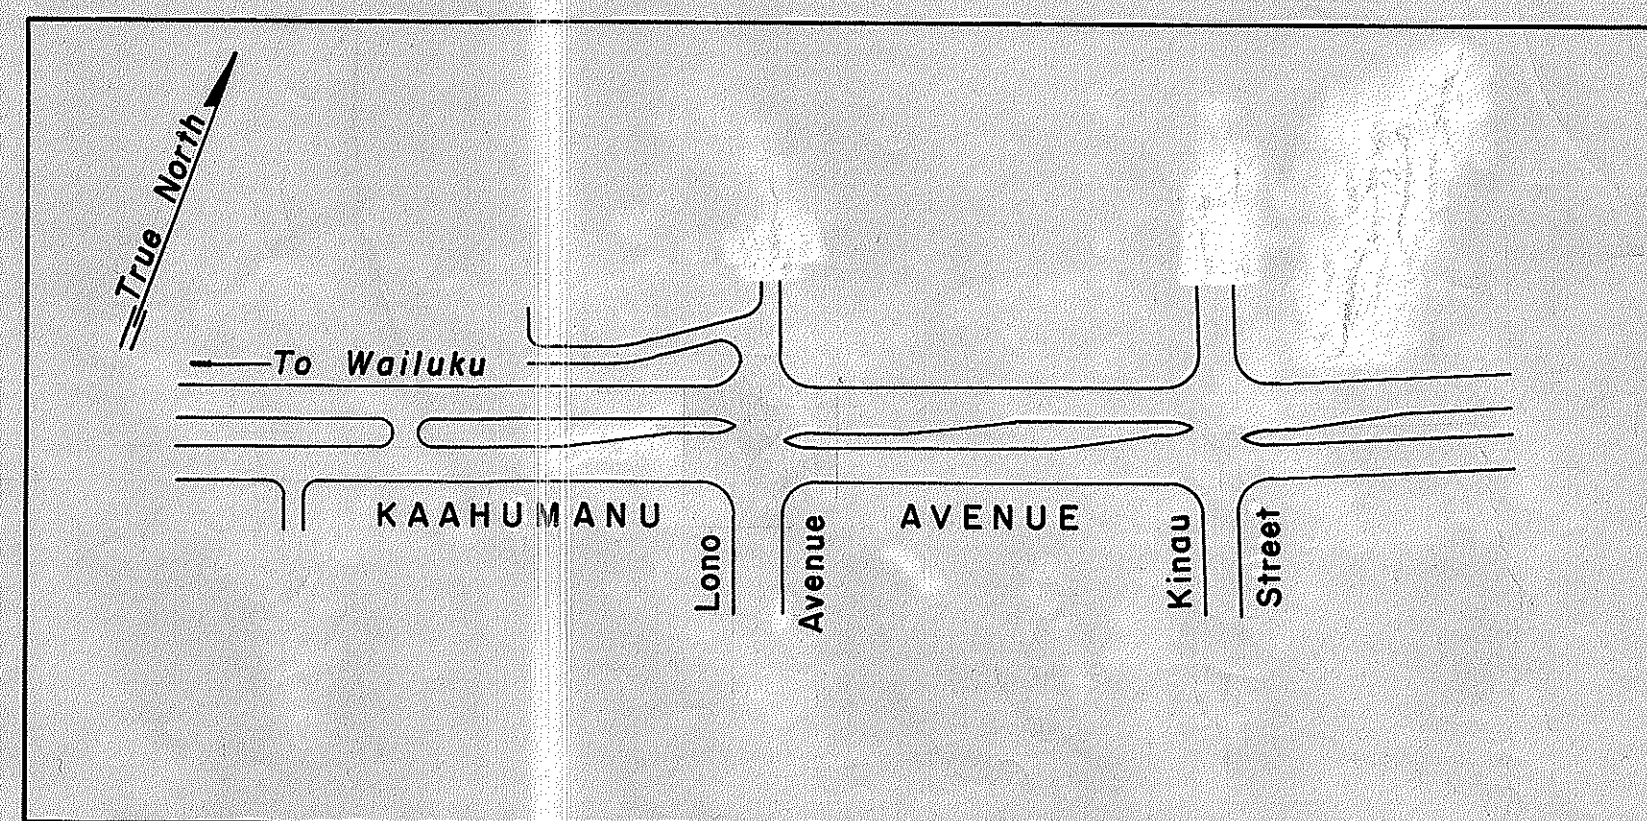

LAYOUT PLAN

200 0 200 400

SCALE IN FEET

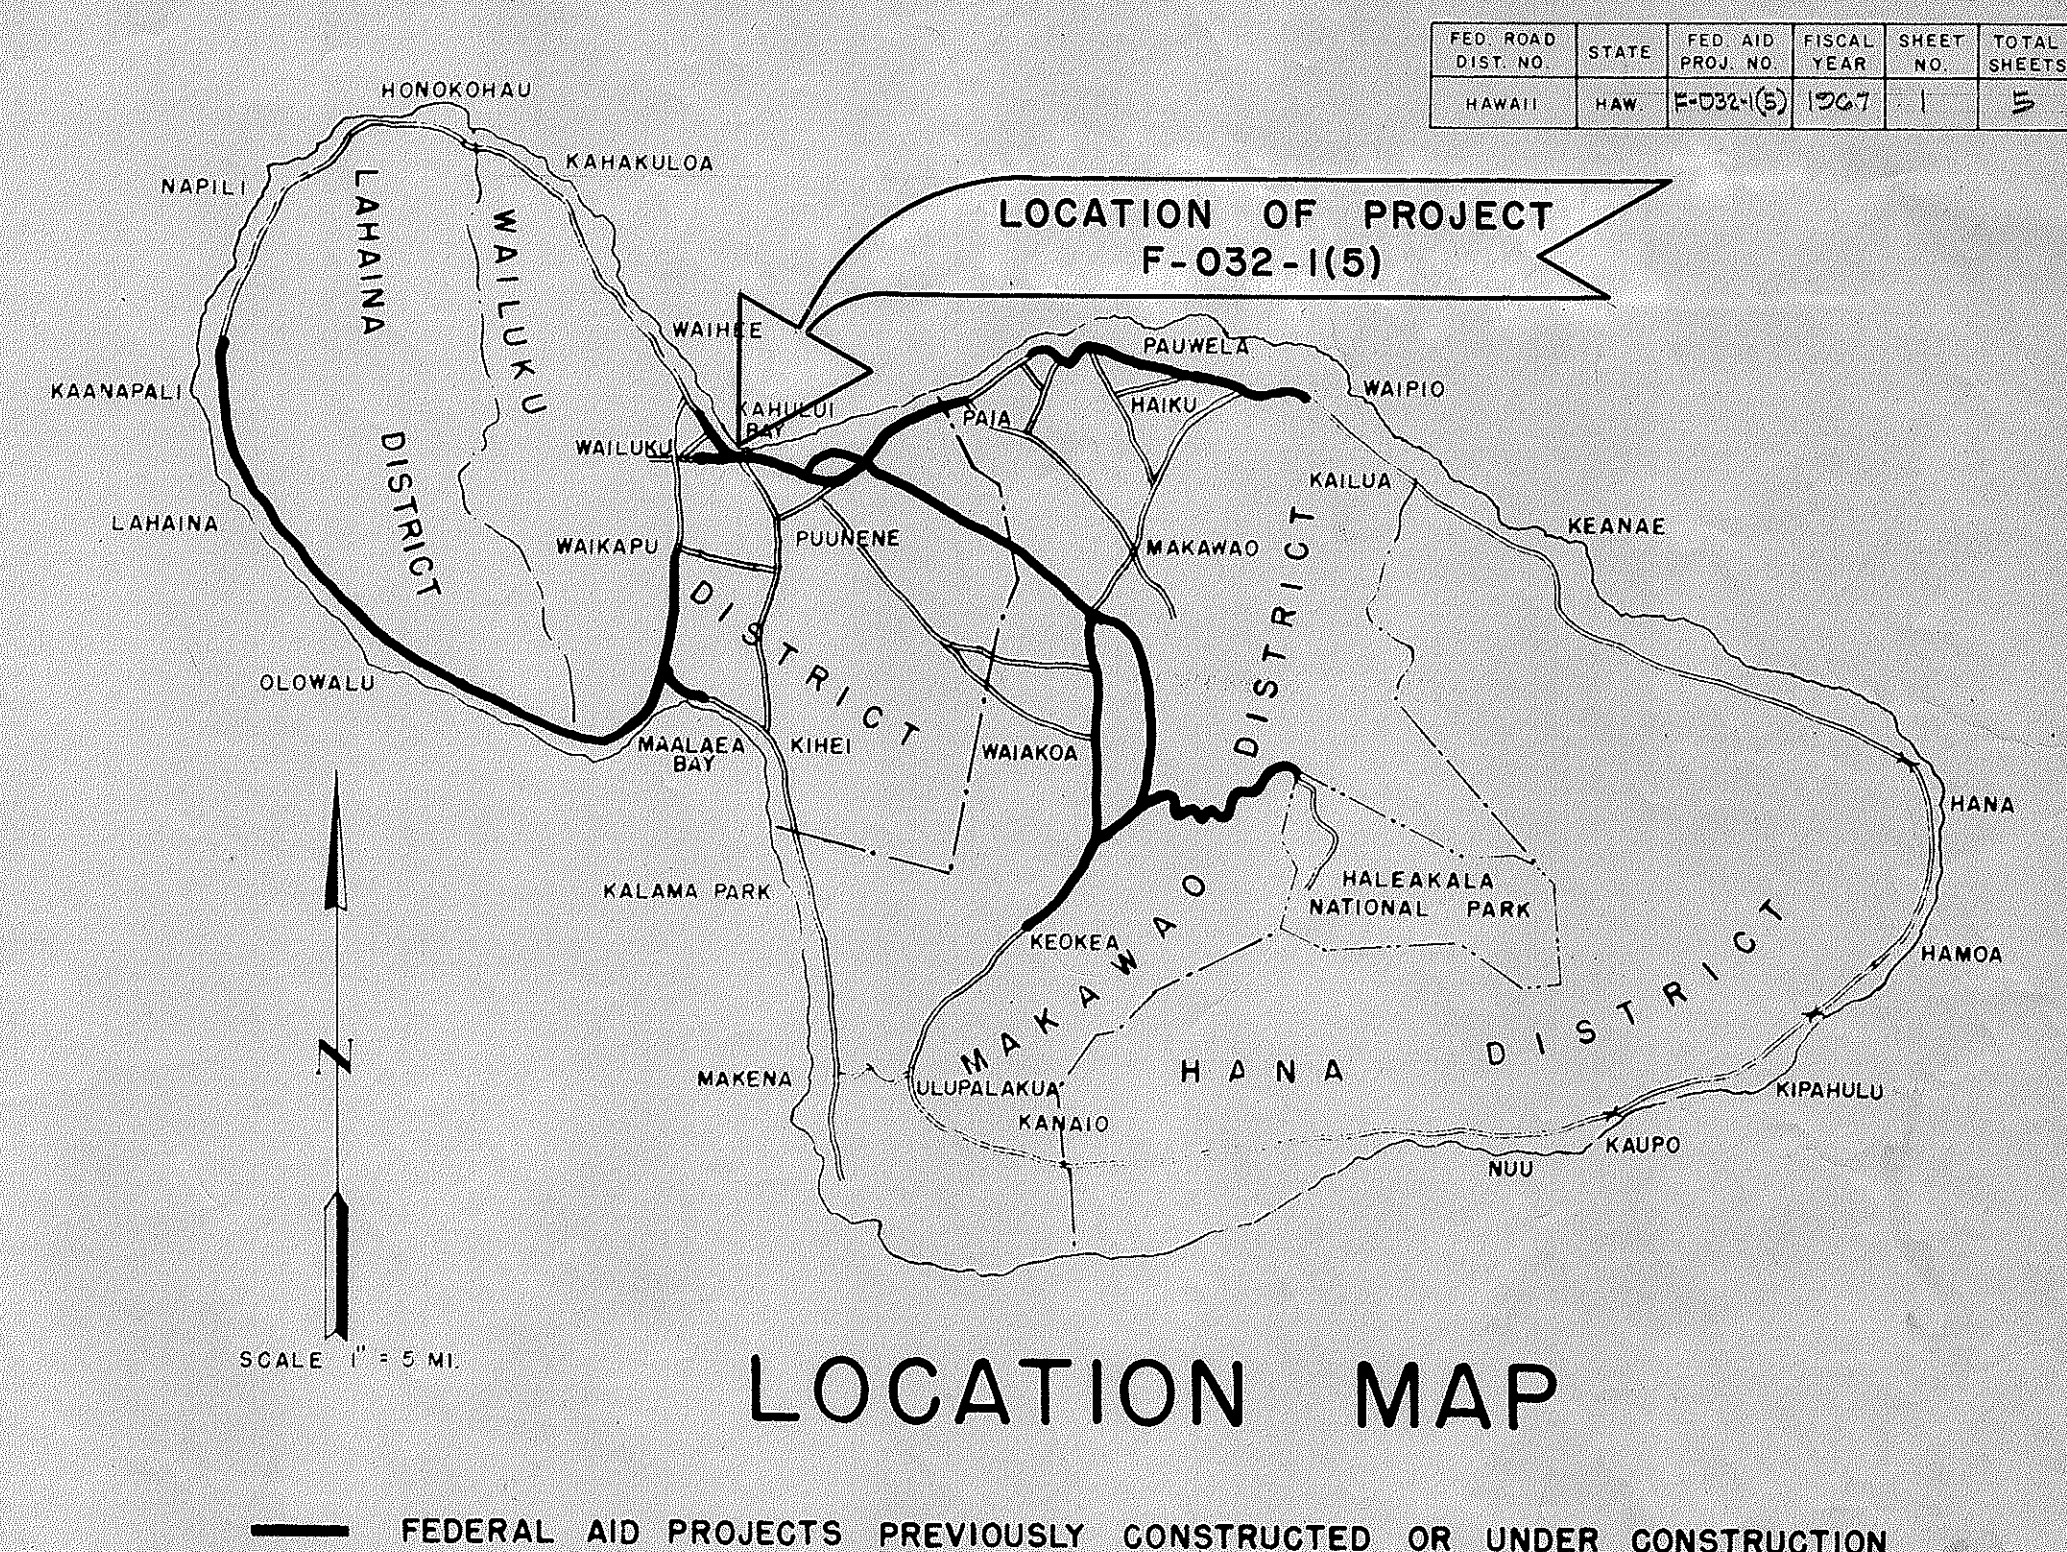

NOTE:

ALL CHANGES MADE DURING CONSTRUCTION

HAVE BEEN NOTED IN RED ON THESE TRACINGS

AND CHECKED BY:

Shawen S. Unemori

PROJECT ENGINEER

5-20-68

DATE

DEPARTMENT OF TRANSPORTATION

STATE OF HAWAII

APPROVED:

John M. Lee

for DIRECTOR

11-7-68

DATE

DEPARTMENT OF COMMERCE

BUREAU OF PUBLIC ROADS

APPROVED:

John B. Williams

DIVISION ENGINEER

1-10-69

DATE