
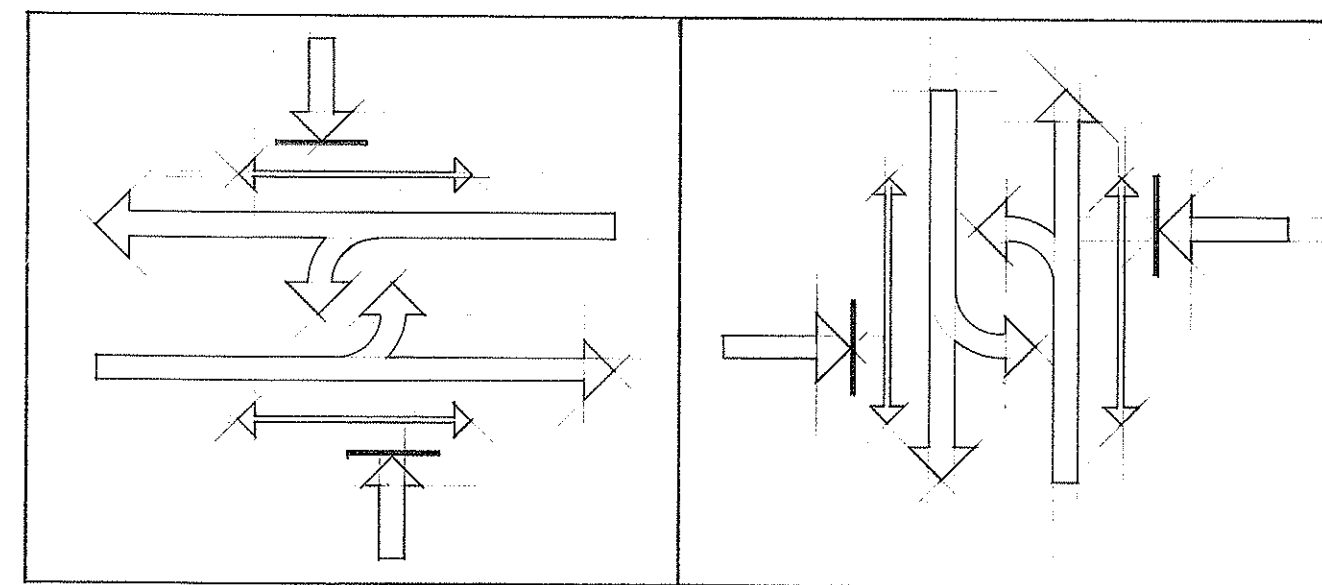


FED. ROAD DIST. NO.	STATE	FED. AID PROJ. NO.	FISCAL YEAR	SHEET NO.	TOTAL SHEETS
HAWAII	HAW.	F-032-1(5)	1967	2	5

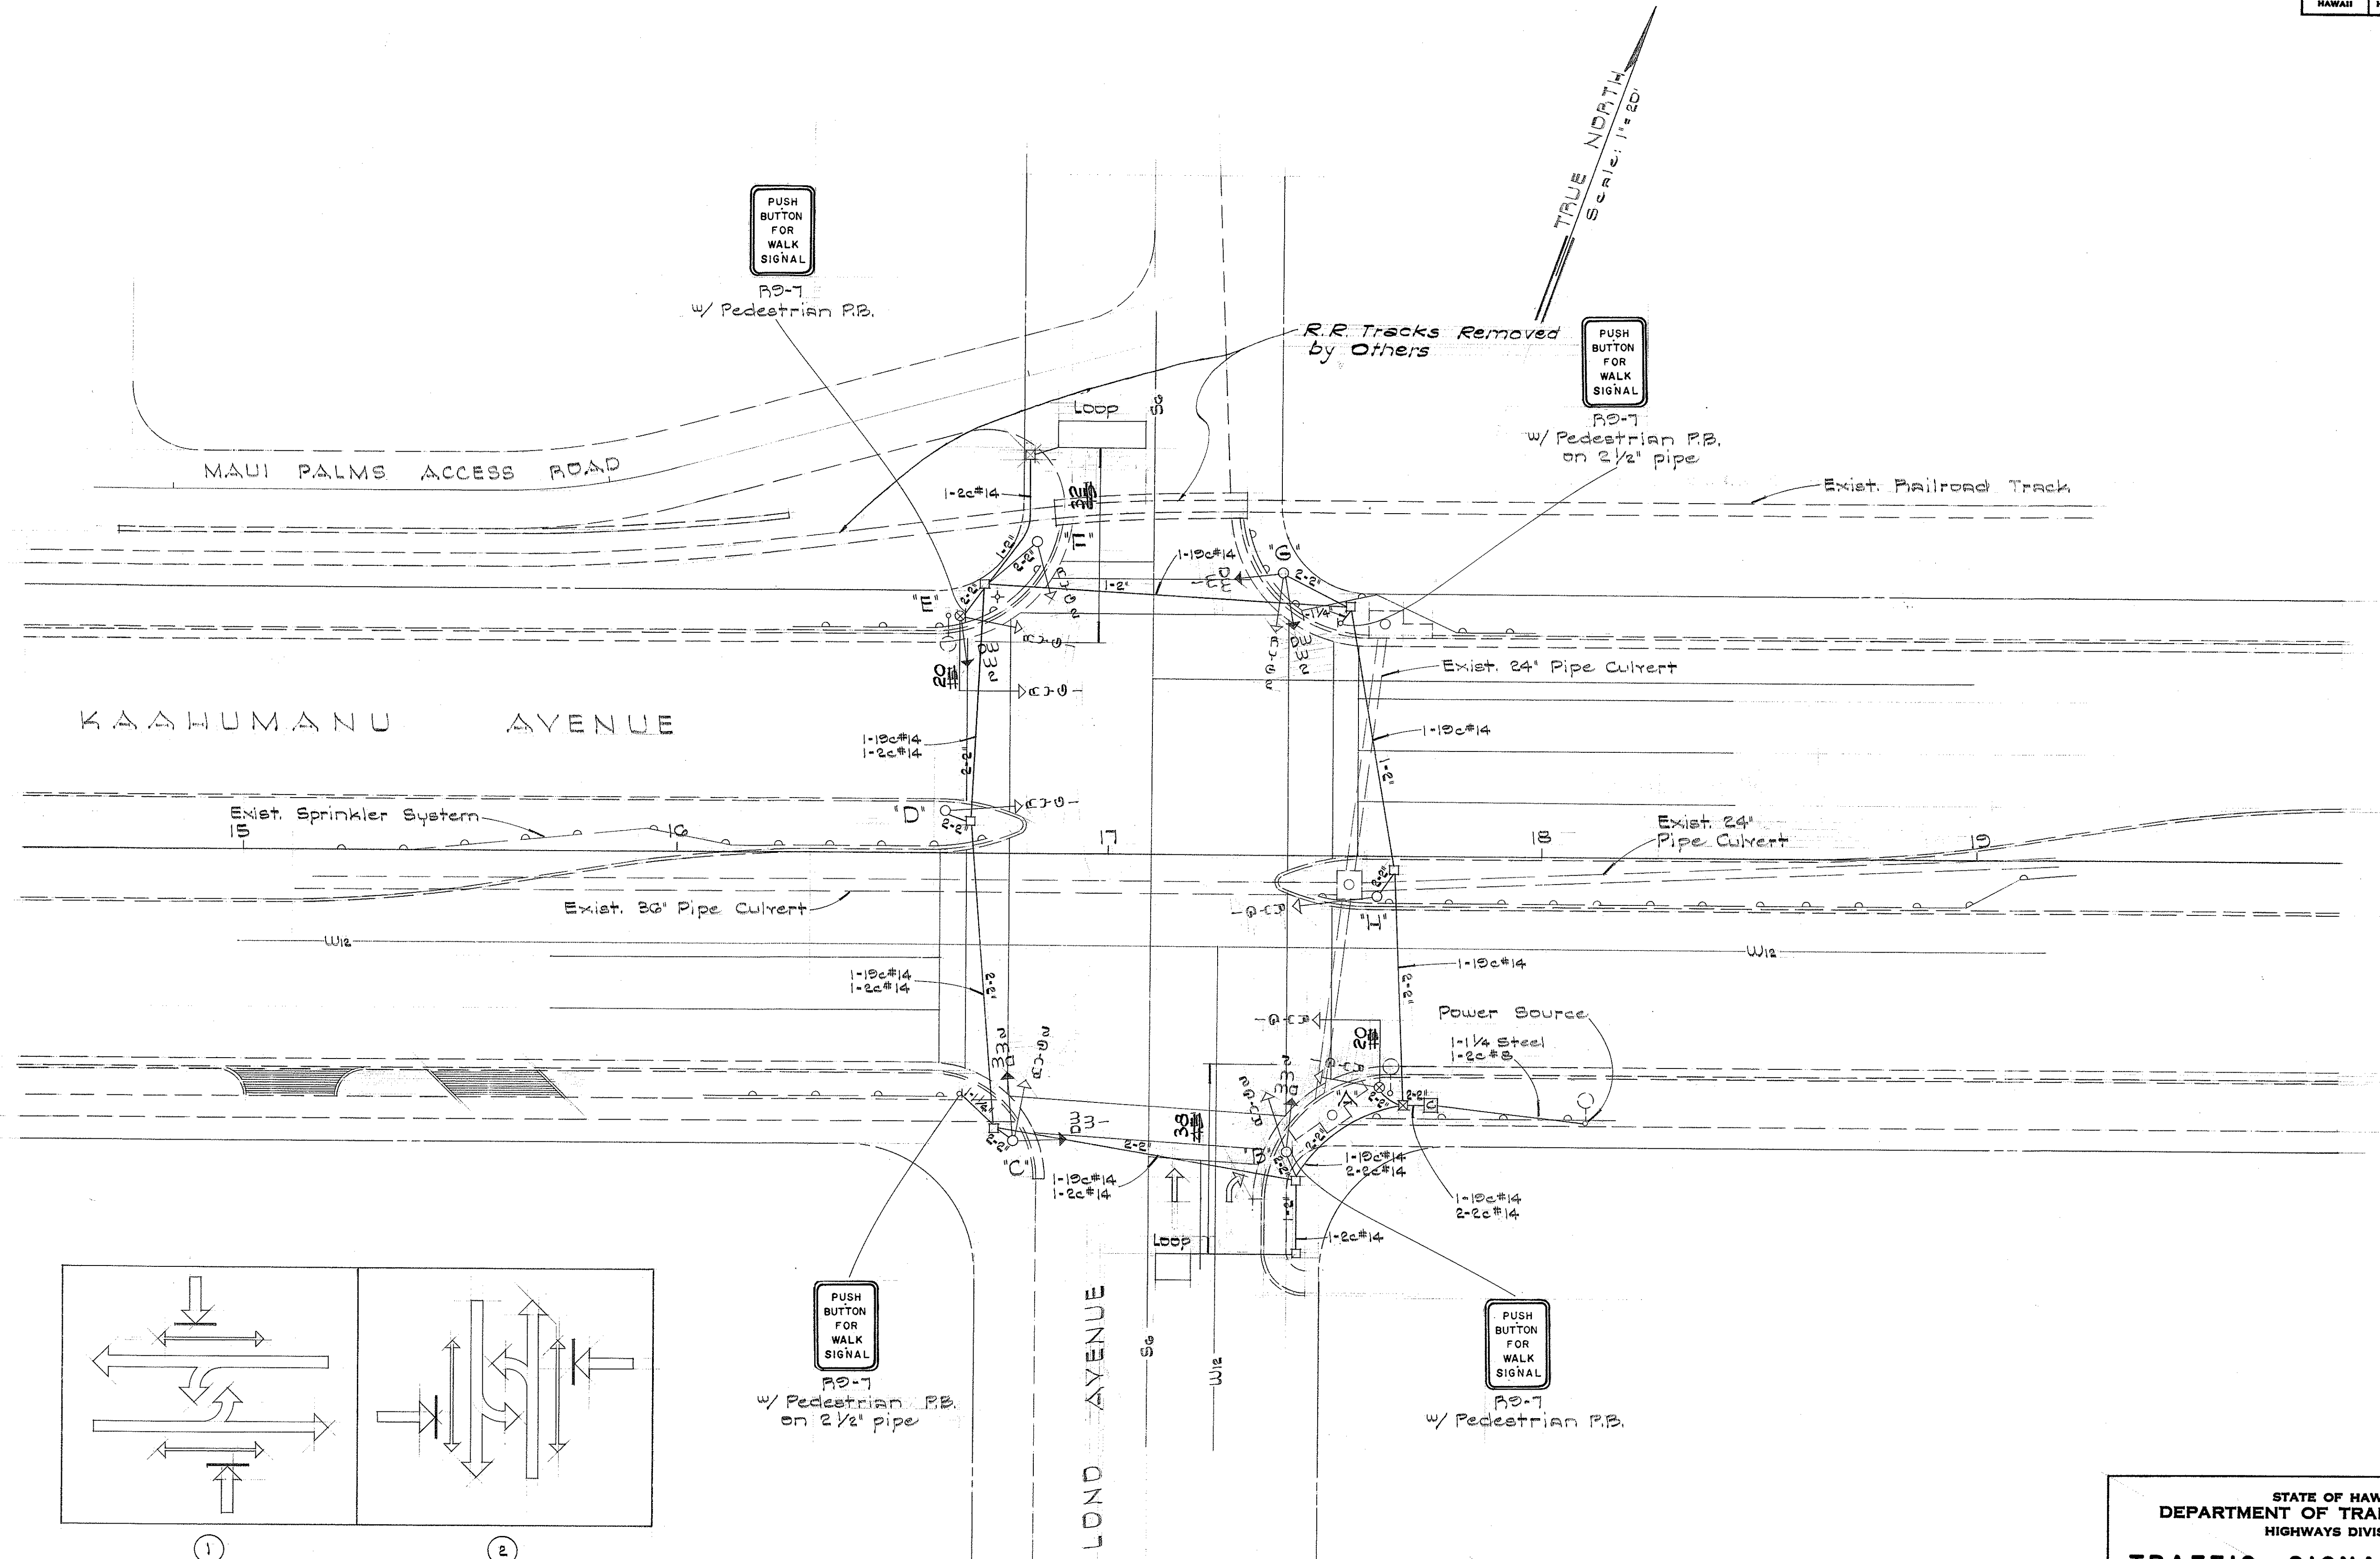

PHASE DIAGRAMS

DATE	_____
DESIGNED BY	_____
CHECKED BY	_____
NO.	_____

STATE OF HAWAII
DEPARTMENT OF TRANSPORTATION
HIGHWAYS DIVISION

TRAFFIC SIGNAL SYSTEM

KAAHUMANU AVENUE

AT

LONO AVENUE

Project No. F-032-1(5)
Scale: 1" = 20' Rev. March 1967

SHEET No. OF SHEETS