

INDEX TO DRAWINGS	
SHEET NO	DESCRIPTION
1	Title Sheet
2	Typical Section
3	Layout Plan
4	Cross Section

STATE OF HAWAII

DEPARTMENT OF TRANSPORTATION

HIGHWAYS DIVISION

HONOLULU, HAWAII

AS BUILT PLANS FOR

CONSTRUCTION OF

KAAHUMANU AVENUE SIDEWALK

BALDWIN HIGH SCHOOL TO PAPA AVENUE



PROJECT NO. 32B-03-68

DISTRICT OF WAILUKU

ISLAND OF MAUI

SCALES

PLAN		1 IN. = 50 FT.
PROFILE	HOR.	1 IN. = FT.
	VER.	1 IN. = FT.
X-SECTIONS	HOR.	1 IN. = 10 FT.
	VER.	1 IN. = 10 FT.

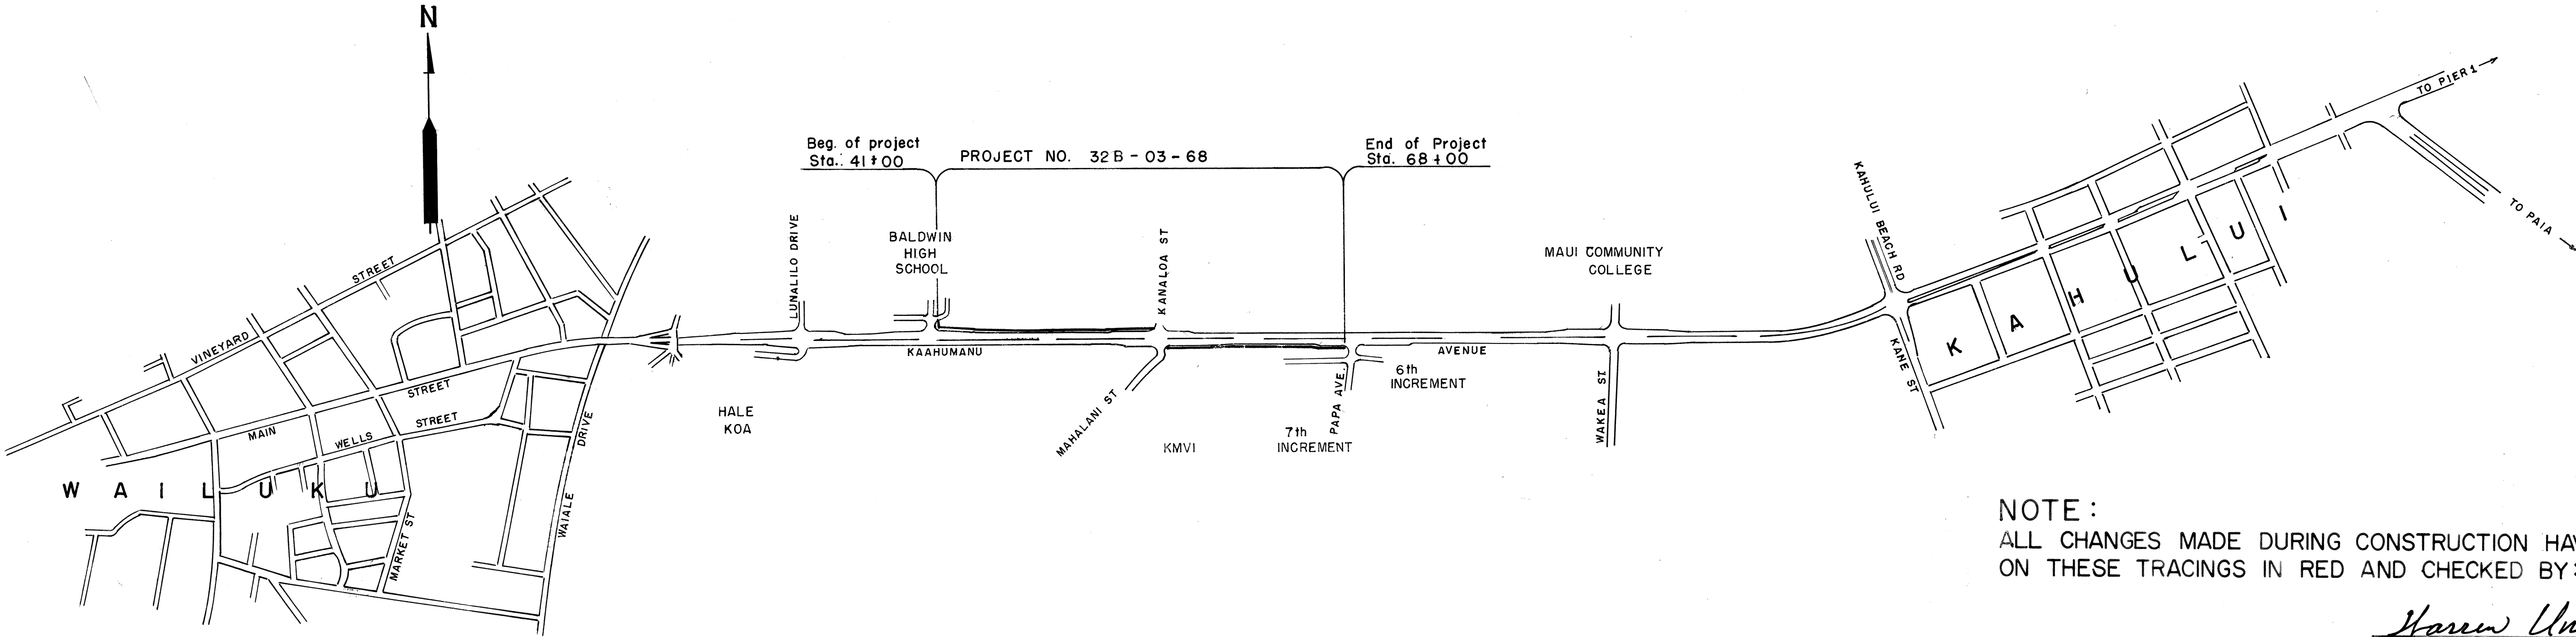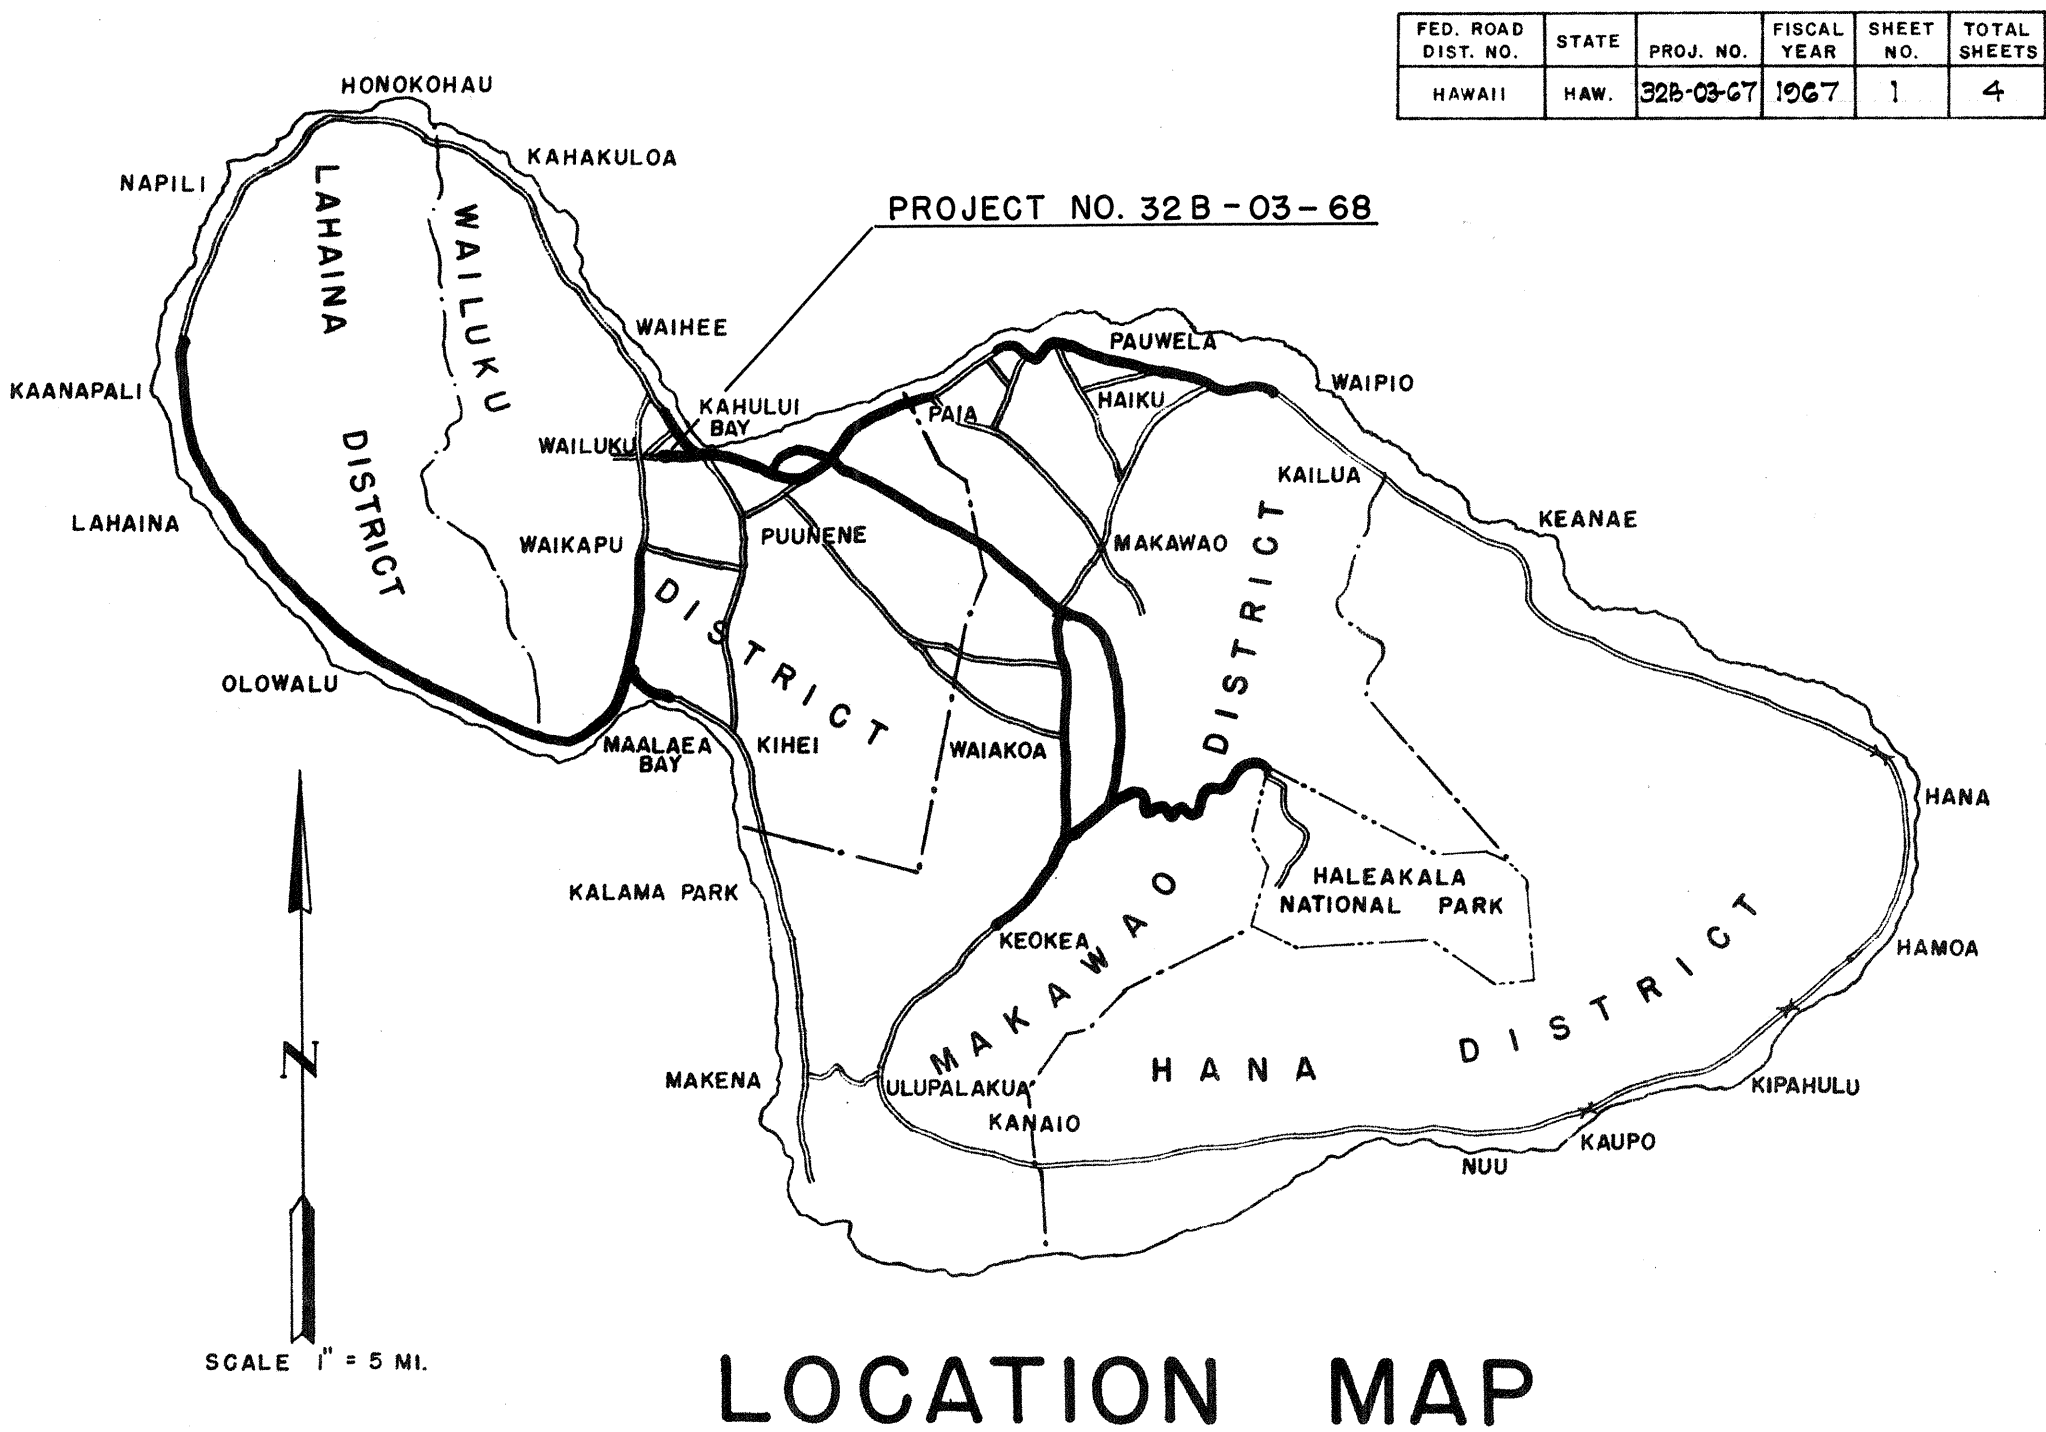

LAYOUT OF PROJECT

LENGTH OF PROJECT

SCALE: 1" = 600'

NOTE:

ALL CHANGES MADE DURING CONSTRUCTION HAVE BEEN NOTED

ON THESE TRACINGS IN RED AND CHECKED BY:

Haruo Unemori

PROJECT ENGINEER

7-10-68

DATE

APPROVED:

DATE 11-8-67

John M. Antle

DIRECTOR OF TRANSPORTATION

FED. ROAD DIST. NO.	STATE	PROJ. NO.	FISCAL YEAR	SHEET NO.	TOTAL SHEETS
HAWAII	HAW.	32B-03-67	1967	1	4