

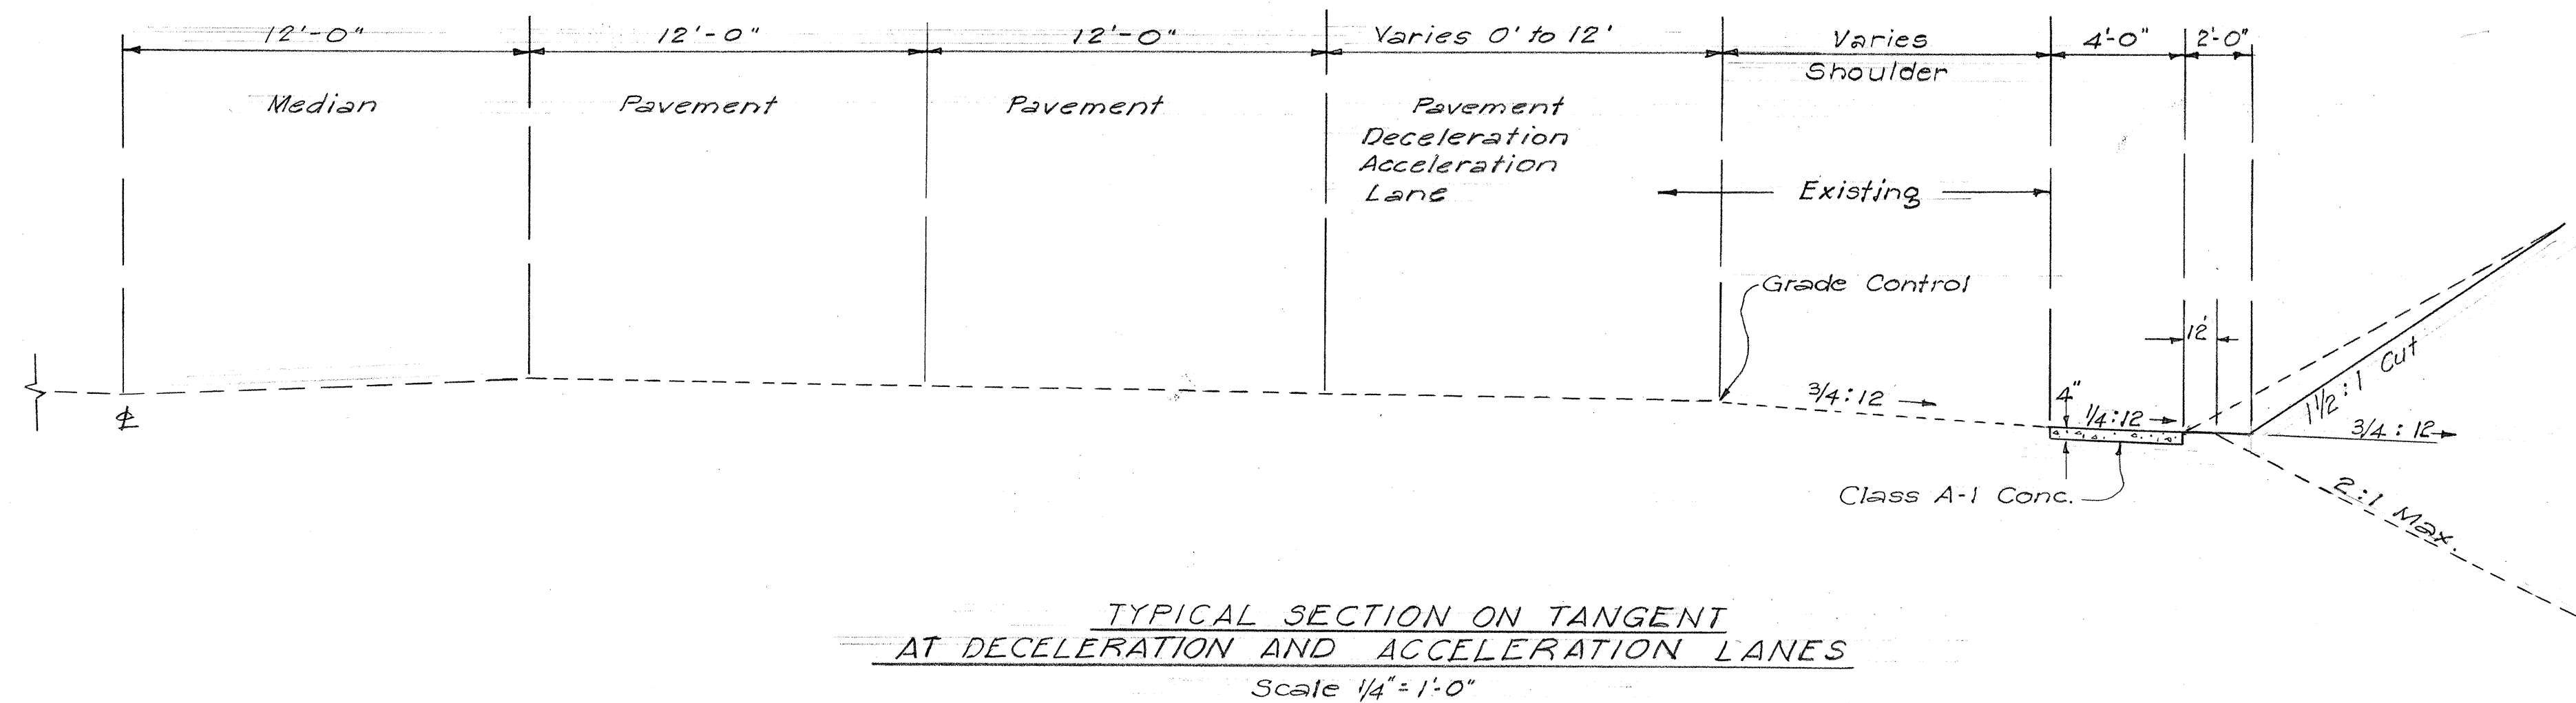


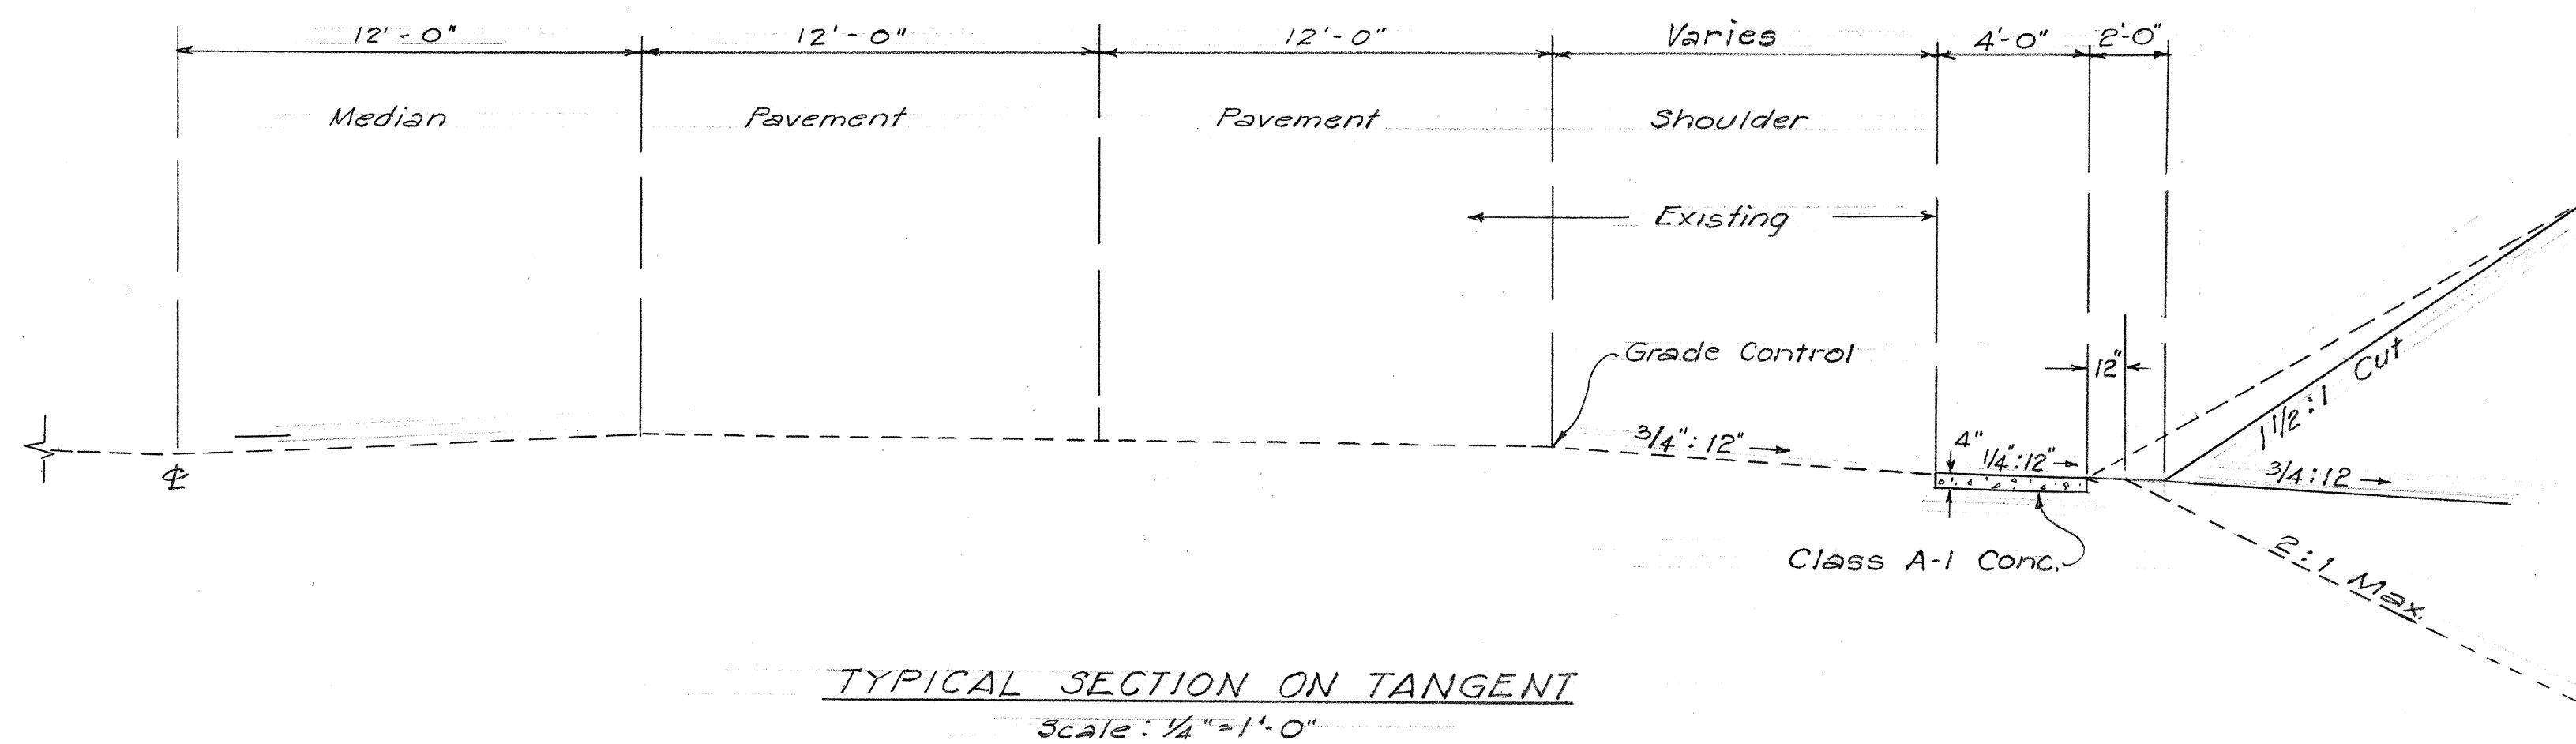

GENERAL NOTES

- Sta. 41+00 to 46+00
Existing Sprinkler at 10'-0" from E.P.
Construct sidewalk at 10'-6" from E.P.
- Sta. 46+00 to 47+00
Distance of sprinkler at sidewalk varies
- Sta. 47+00 to 55+00 ±
Relocate sprinkler to 6'-6" from E.P.
Construct sidewalk at 7'-6" from E.P.
- Sta. 56+00 to ~~64+50~~
Existing sprinkler at 9'-0" from E.P.
Construct sidewalk at 10'-0" from E.P.
Sta. 65+50 to 68+00 - 9'-6" from E.P.
- In areas where existing shoulder width is too narrow; embankment shall be widened to the required dimensions in accordance with the provisions of Sections 13 and 18 of the Specifications.
- Route marker signs to be relocated by Contractor.
Payment incidental to various contract items
- Sta. ~~61+40~~ to 65+00
Relocate sprinkler to 17'-0" min. from E.P.
- Sta. 41+00 to 55+50
All sprinkler nozzles along sidewalk shall be replaced by half circle lawn spray, Buckner #400H
- Top of sidewalk shall match top of Cattle Underpass deck.
- Any damage to existing sprinkler system (not requiring relocation) caused by the Contractor's operations shall be repaired at his expense.
- Certain existing cut areas shall be widened (see cross sections) and the excavated material shall be used to fill depressions and widen embankments. Waste or unsuitable material shall be disposed of outside the highway right of way.

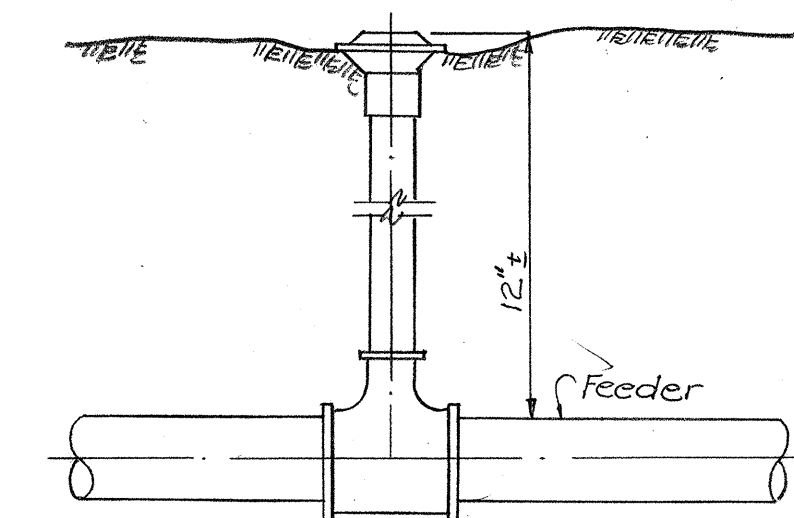

CONNECTION OF SPRINKLER HEAD TO FEEDER PIPE
NOT TO SCALE

STATE OF HAWAII
DEPARTMENT OF TRANSPORTATION
HIGHWAYS DIVISION

TYPICAL SECTION

KAAHUMANU AVE. SIDEWALK

BALDWIN HIGH SCHOOL TO PAPA AVE.

PROJ. NO. 32B-03-68

Date: Nov. 2, 1967

SHEET NO. OF SHEETS

ORIGINAL	SURVEY PLOTTED BY	DATE
PLAN	DRAWN BY	"
NOTE BOOK	DESIGNED BY	"
No.	CHECKED BY	"