

STATE OF HAWAII
DEPARTMENT OF TRANSPORTATION
HIGHWAYS DIVISION
HONOLULU, HAWAII
"AS BUILT"

RESURFACING A PORTION OF
KAAHUMANU AVENUE
(CENTRAL AVENUE TO WAILUKU OVERPASS)
Proj. No. 32B - 04 - 69


NOTE:

ALL CHANGES MADE DURING
CONSTRUCTION HAVE BEEN NOTED
IN RED ON THESE TRACINGS AND
CHECKED BY:

GROSS LENGTH OF PROJECT 0.265 MI.

PROJECT ENGINEER

DATE

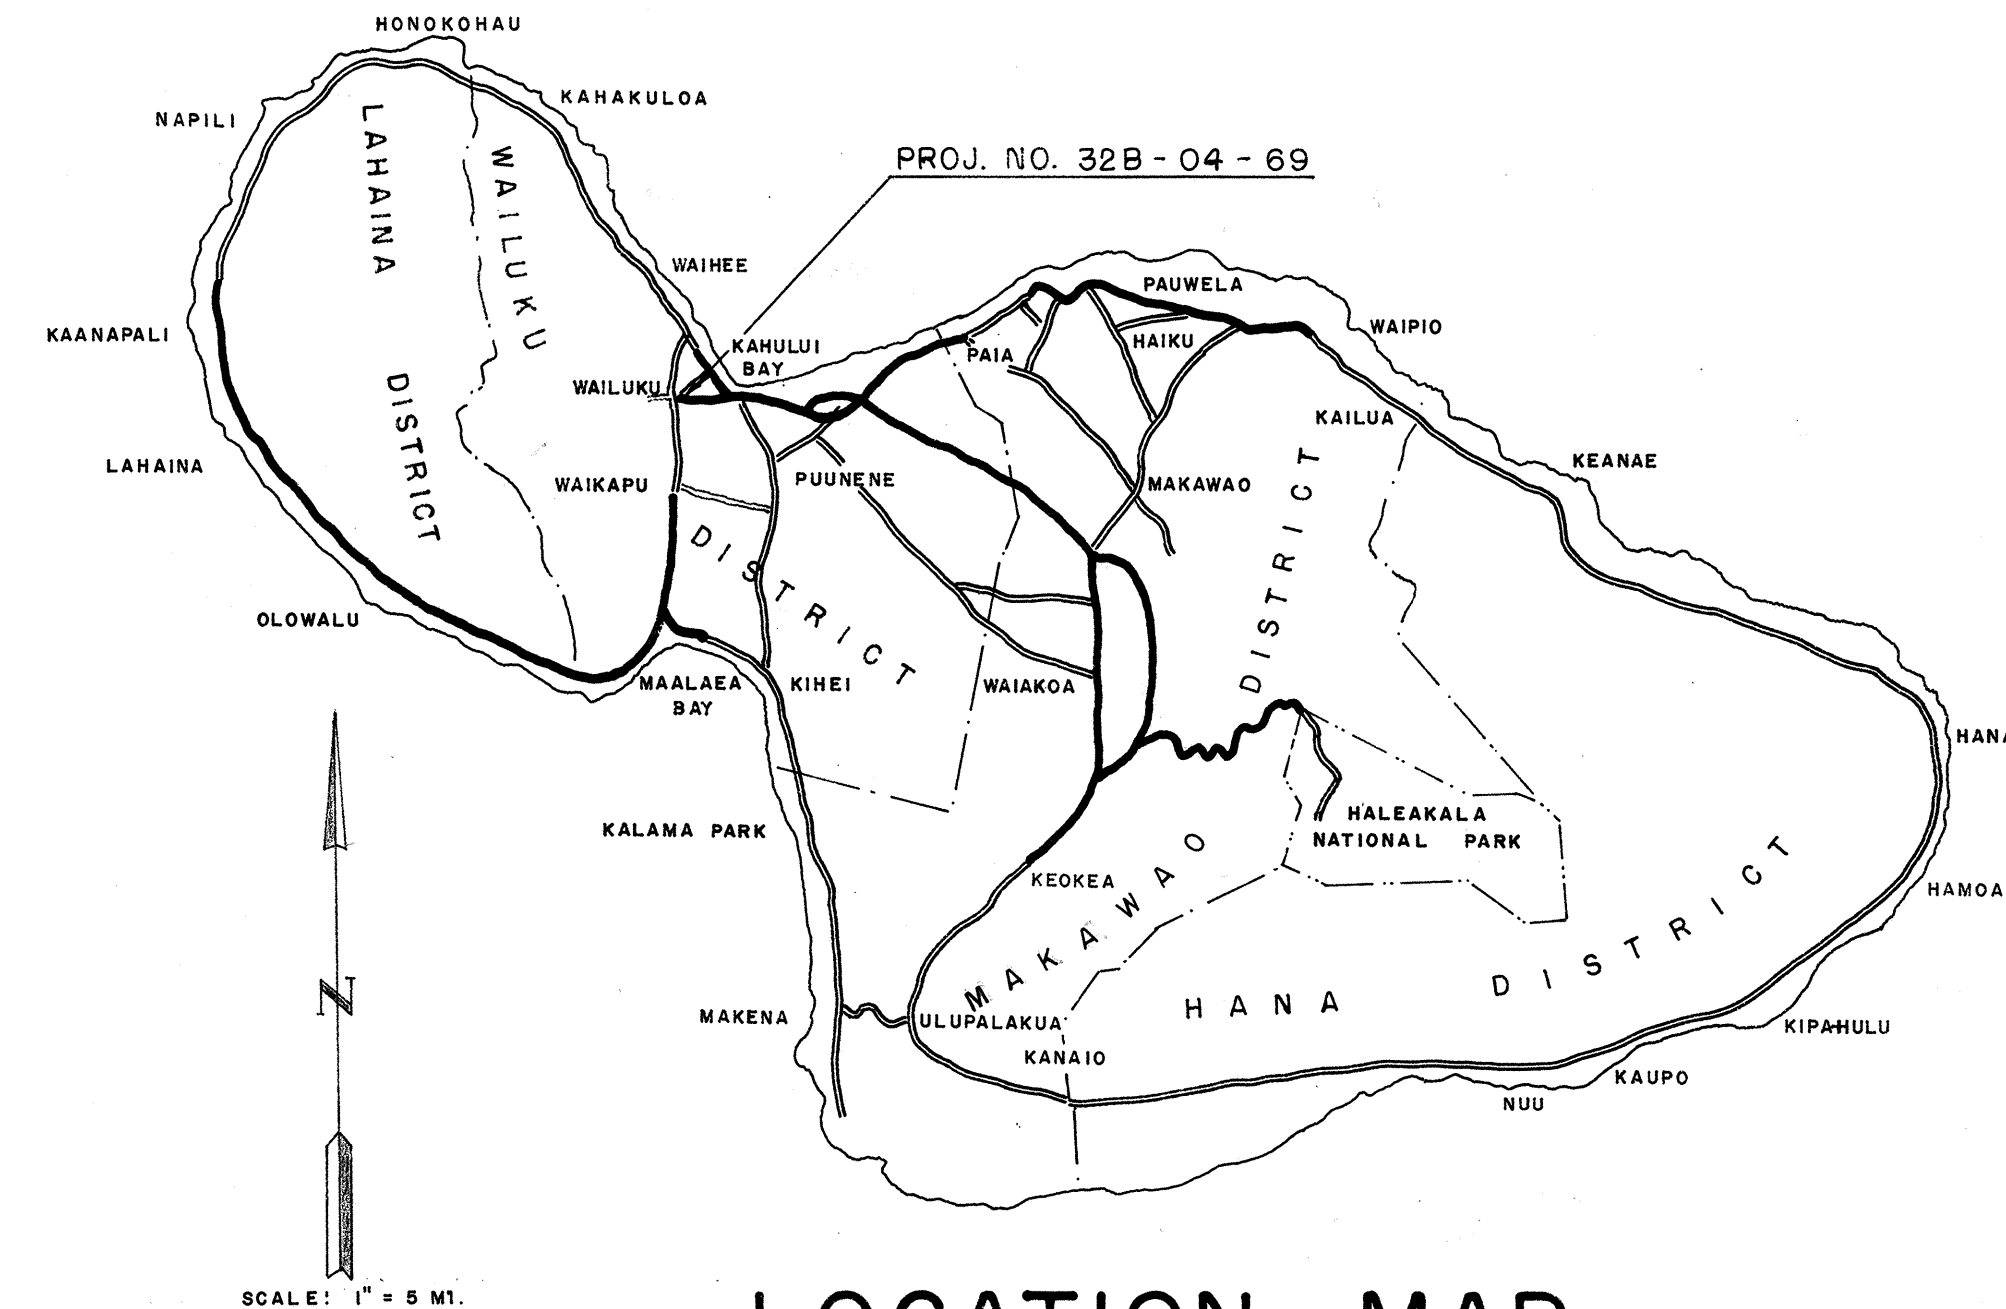


LOCATION MAP

— FEDERAL AID PROJECTS PREVIOUSLY CONSTRUCTED OR UNDER CONSTRUCTION

APPROVED:

DATE

E. Olvey Wright
for DIRECTOR OF TRANSPORTATION

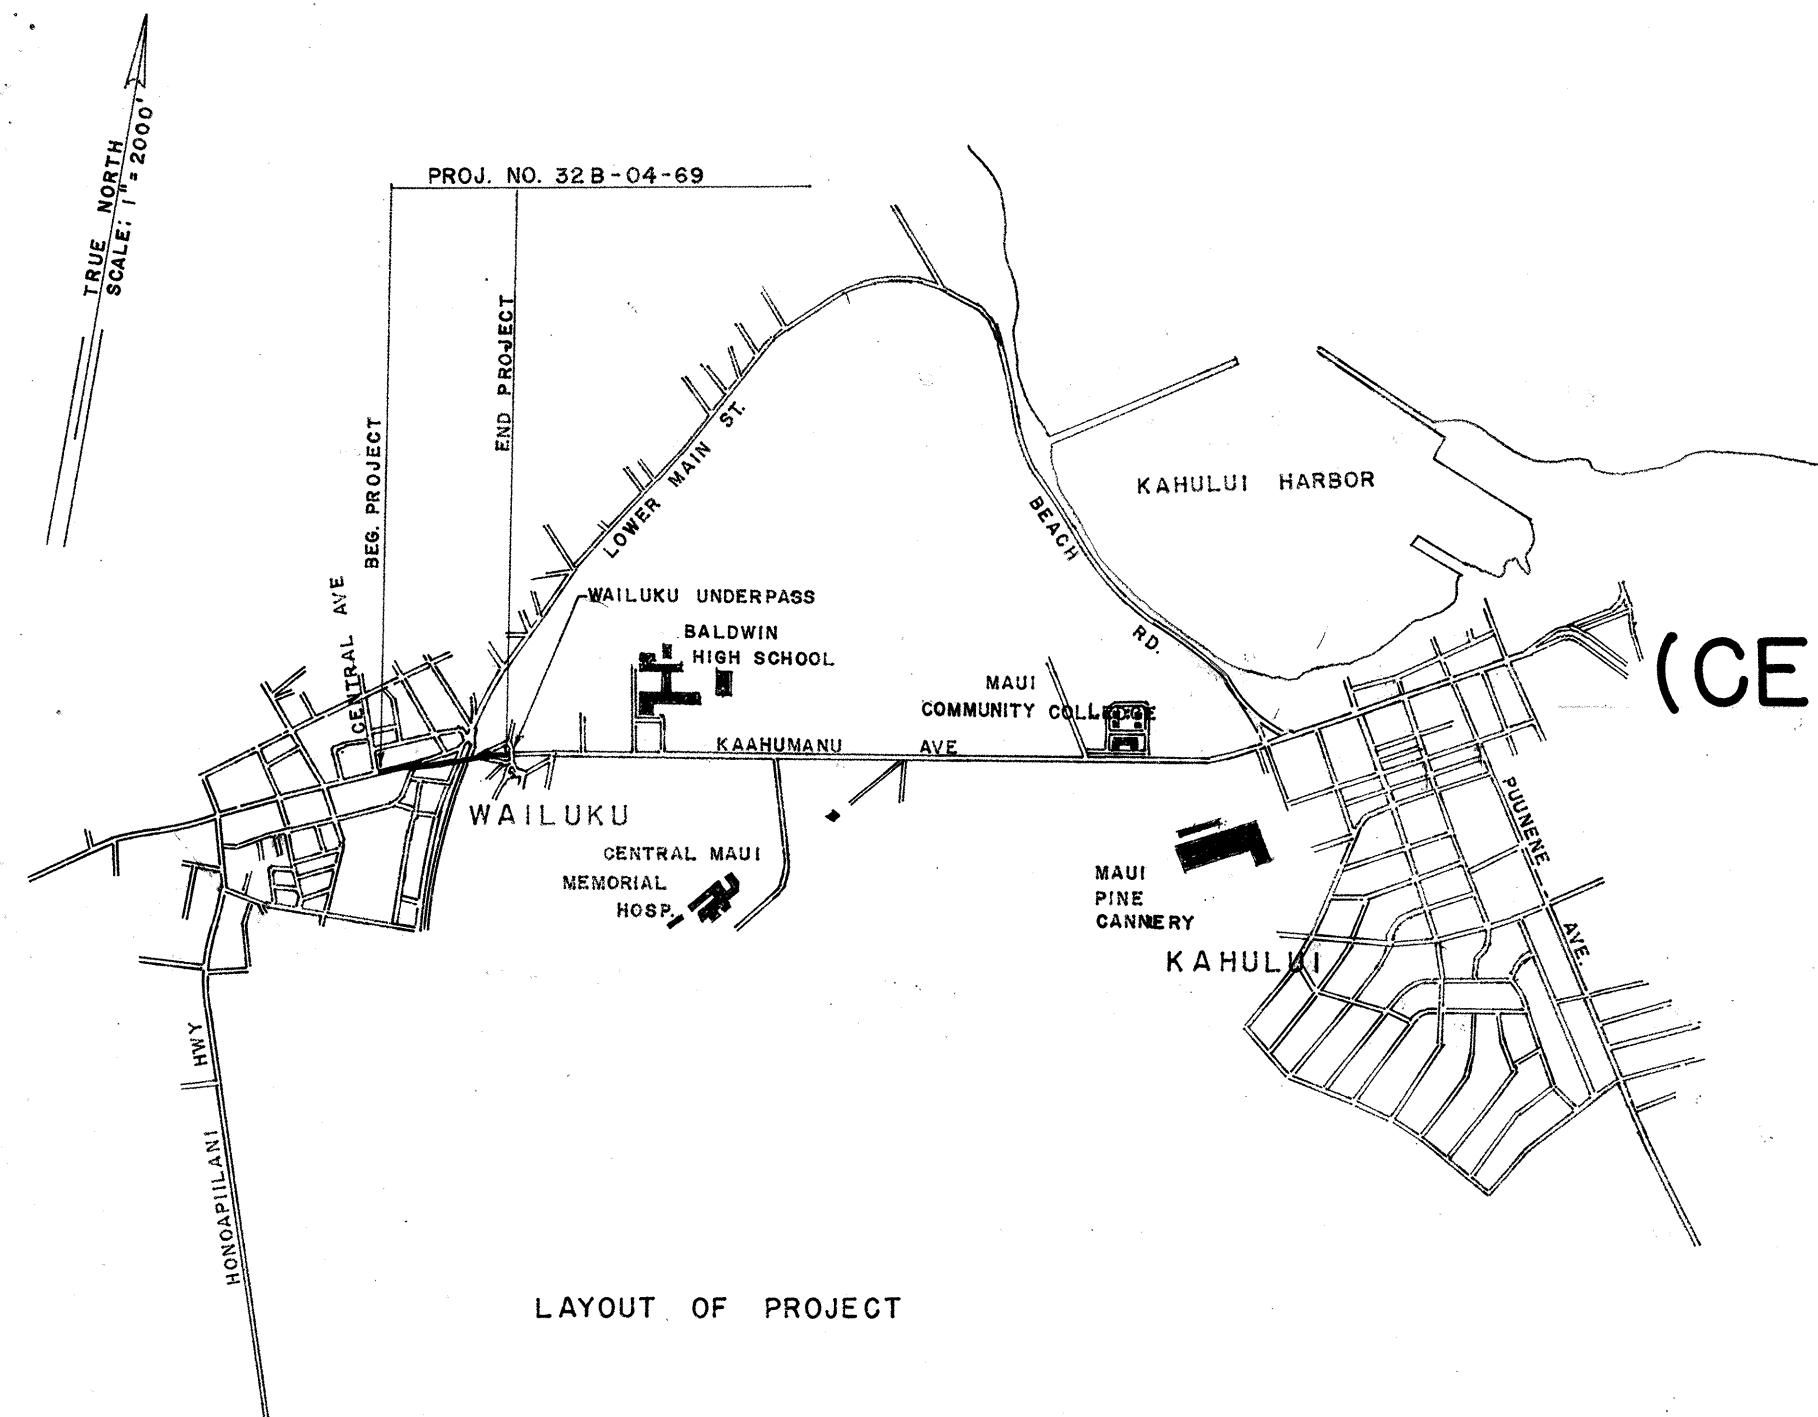

LAYOUT OF PROJECT

R. Terada September 1968

C-4-9