




FED. ROAD DIST. NO.	STATE	PROJ. NO.	FISCAL YEAR	SHEET NO.	TOTAL SHEETS
HAWAII	HAW.	32A-02-71	1972	6	6

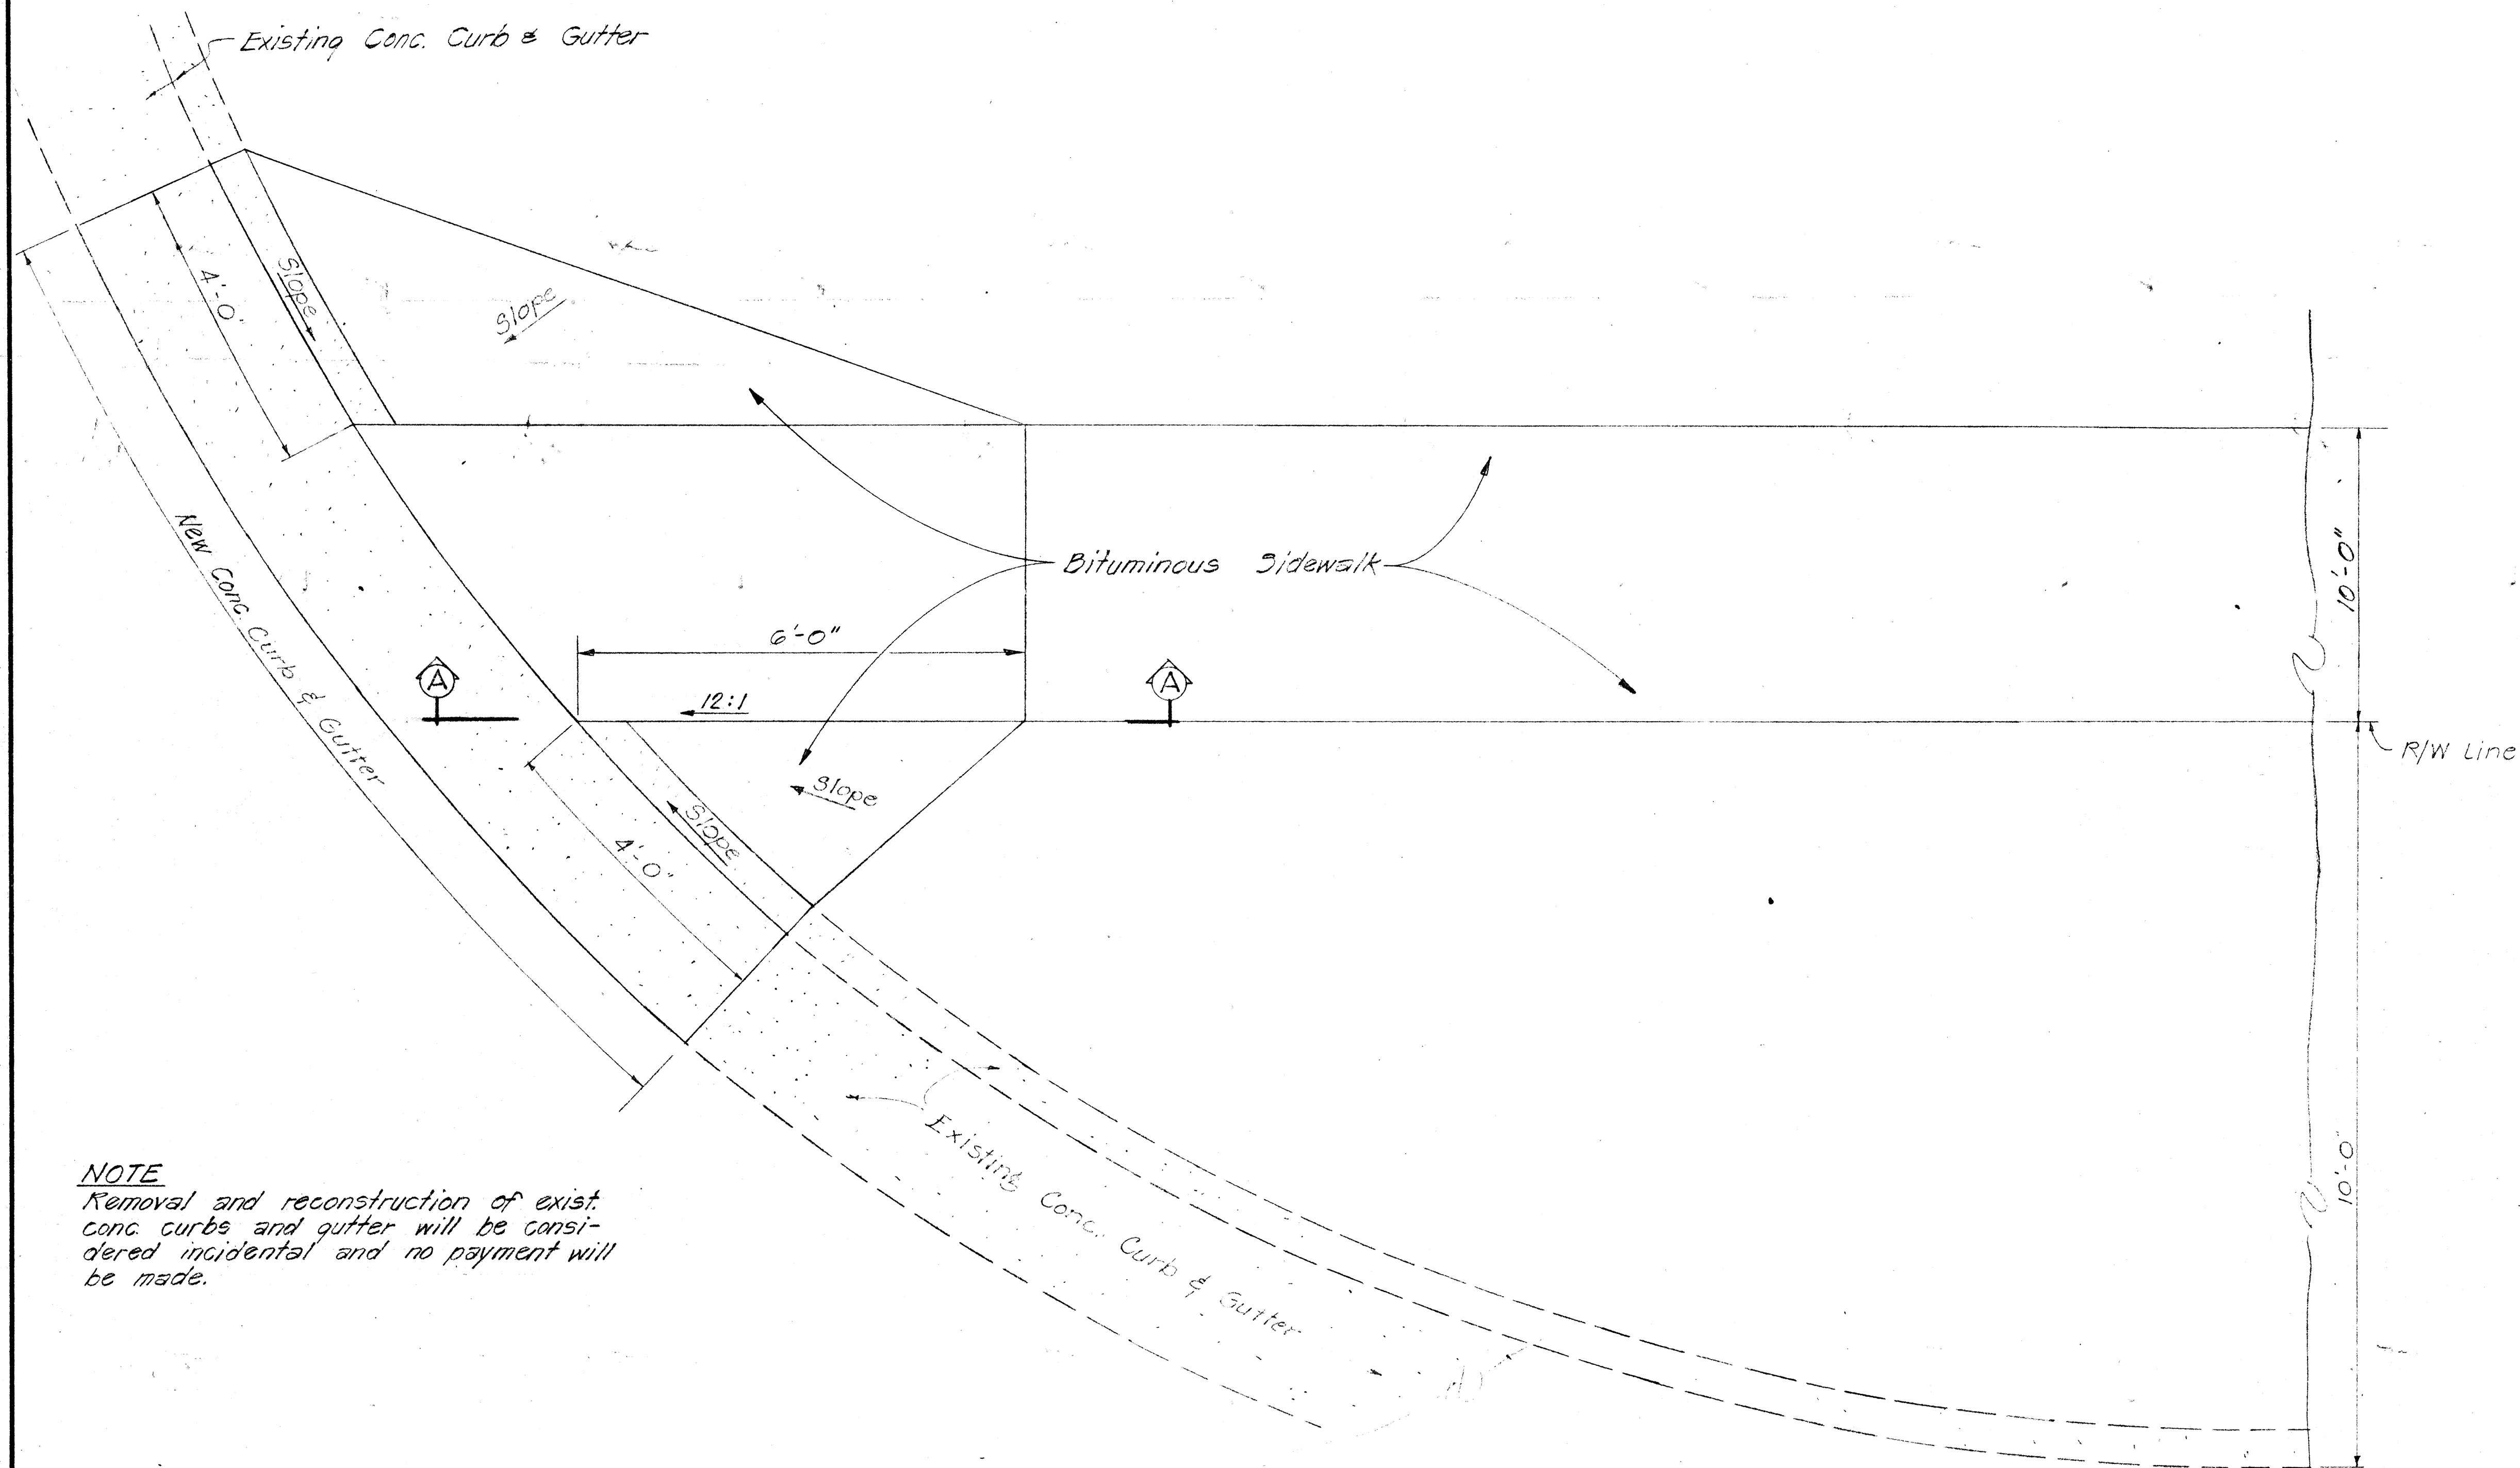

NOTE
Removal and reconstruction of exist. conc curbs and gutter will be considered incidental and no payment will be made.

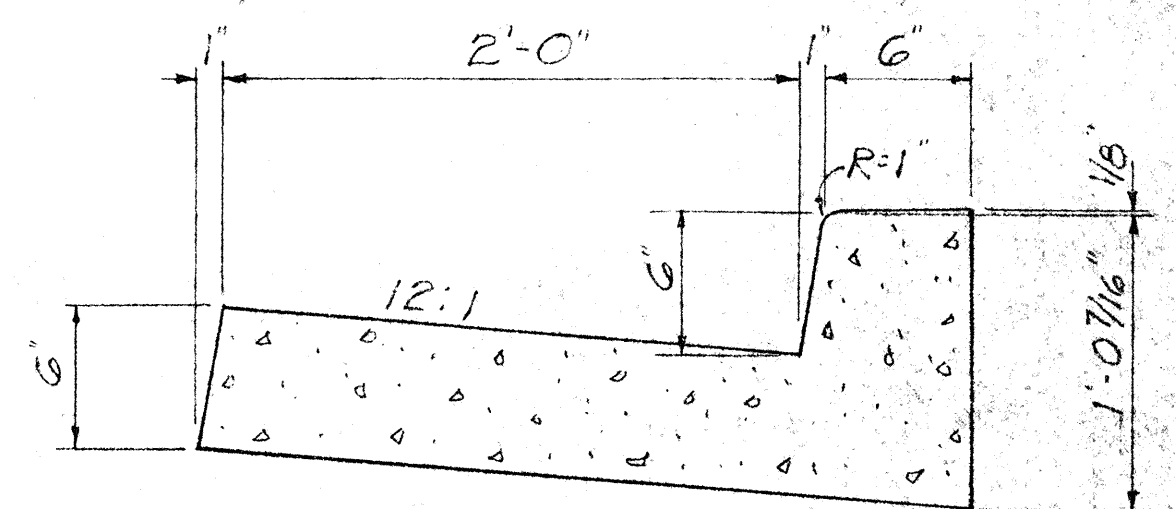

**EXISTING
TYPICAL CURB & GUTTER**
SCALE: 1 1/2" = 1'-0"

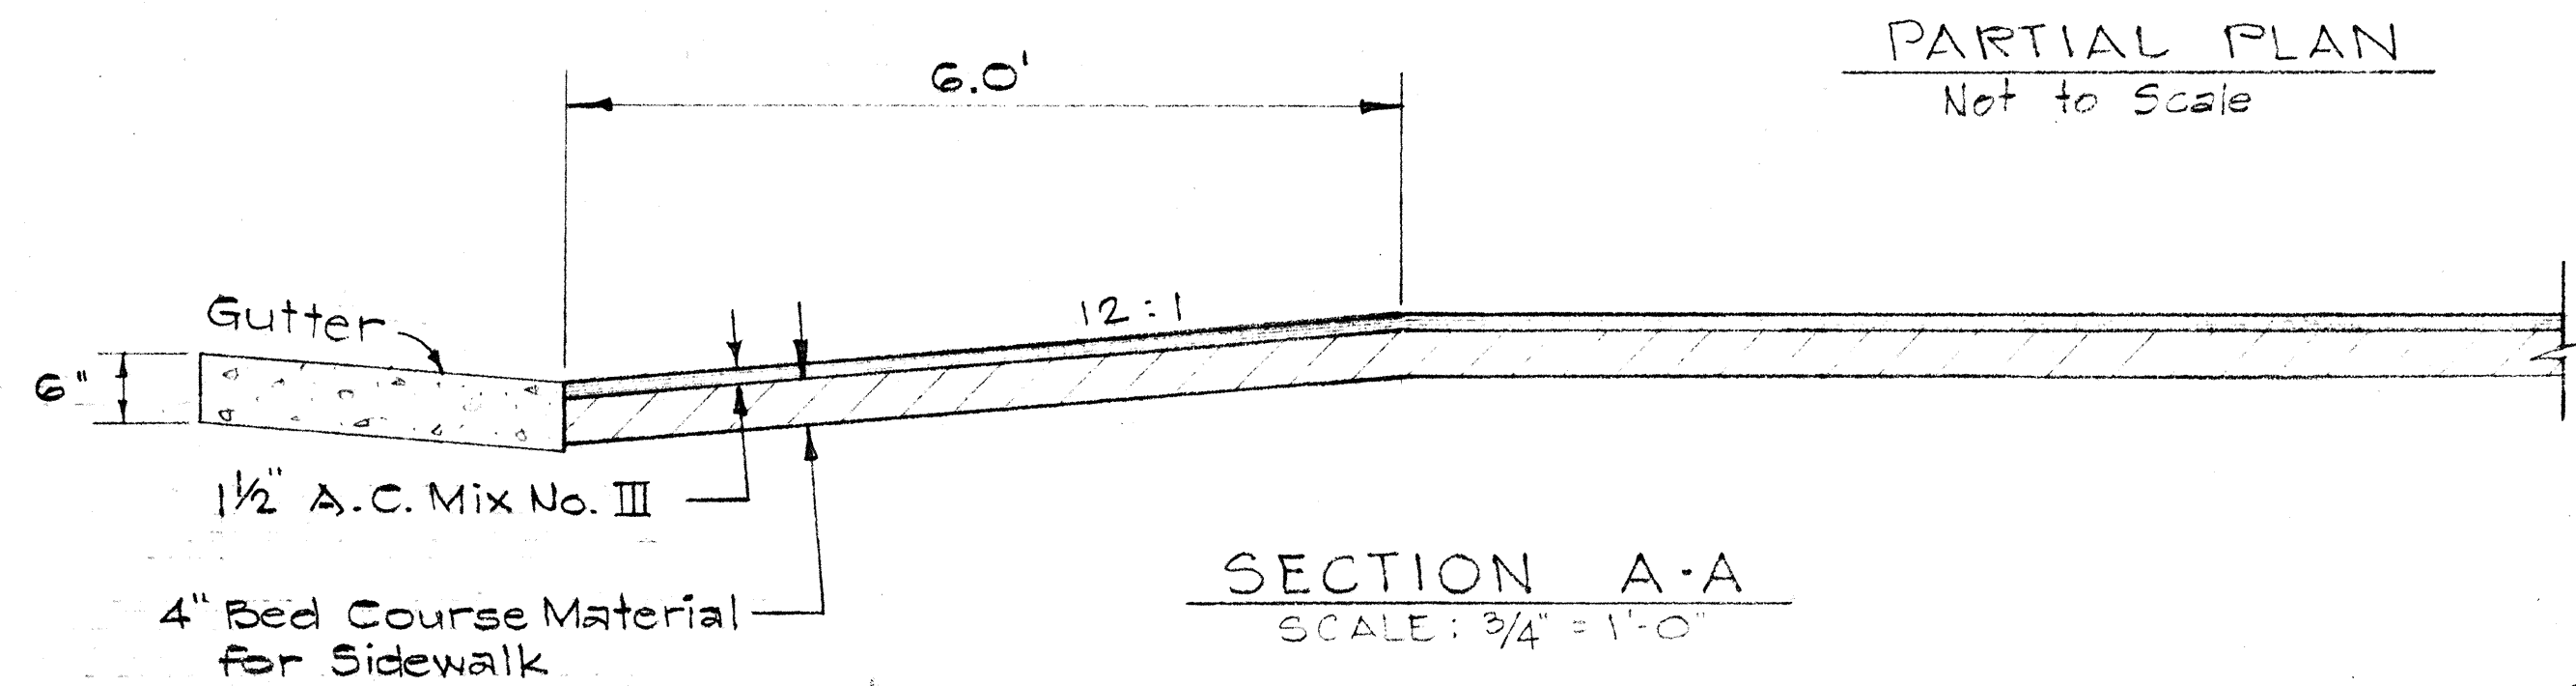

SECTION A-A
SCALE: 3/4" = 1'-0"

PARTIAL PLAN
Not to Scale

DETAIL OF SIDEWALK APPROACH AT ALL CURBS

STATE OF HAWAII
DEPARTMENT OF TRANSPORTATION
HIGHWAYS DIVISION

KAAHUMANU AVE. SIDEWALK
KAHULUI BEACH RD. TO PUUNENE AVE
PROJ. NO. 32A-02-71

SCALE AS SHOWN DEC. 1971
Revised: Nov. 1974

SHEET No. 6 OF 6 SHEETS