



FED. ROAD DIST. NO.	STATE	PROJ. NO.	FISCAL YEAR	SHEET NO.	TOTAL SHEETS
HAWAII	HAW.	32A-02-70	1970	2	19

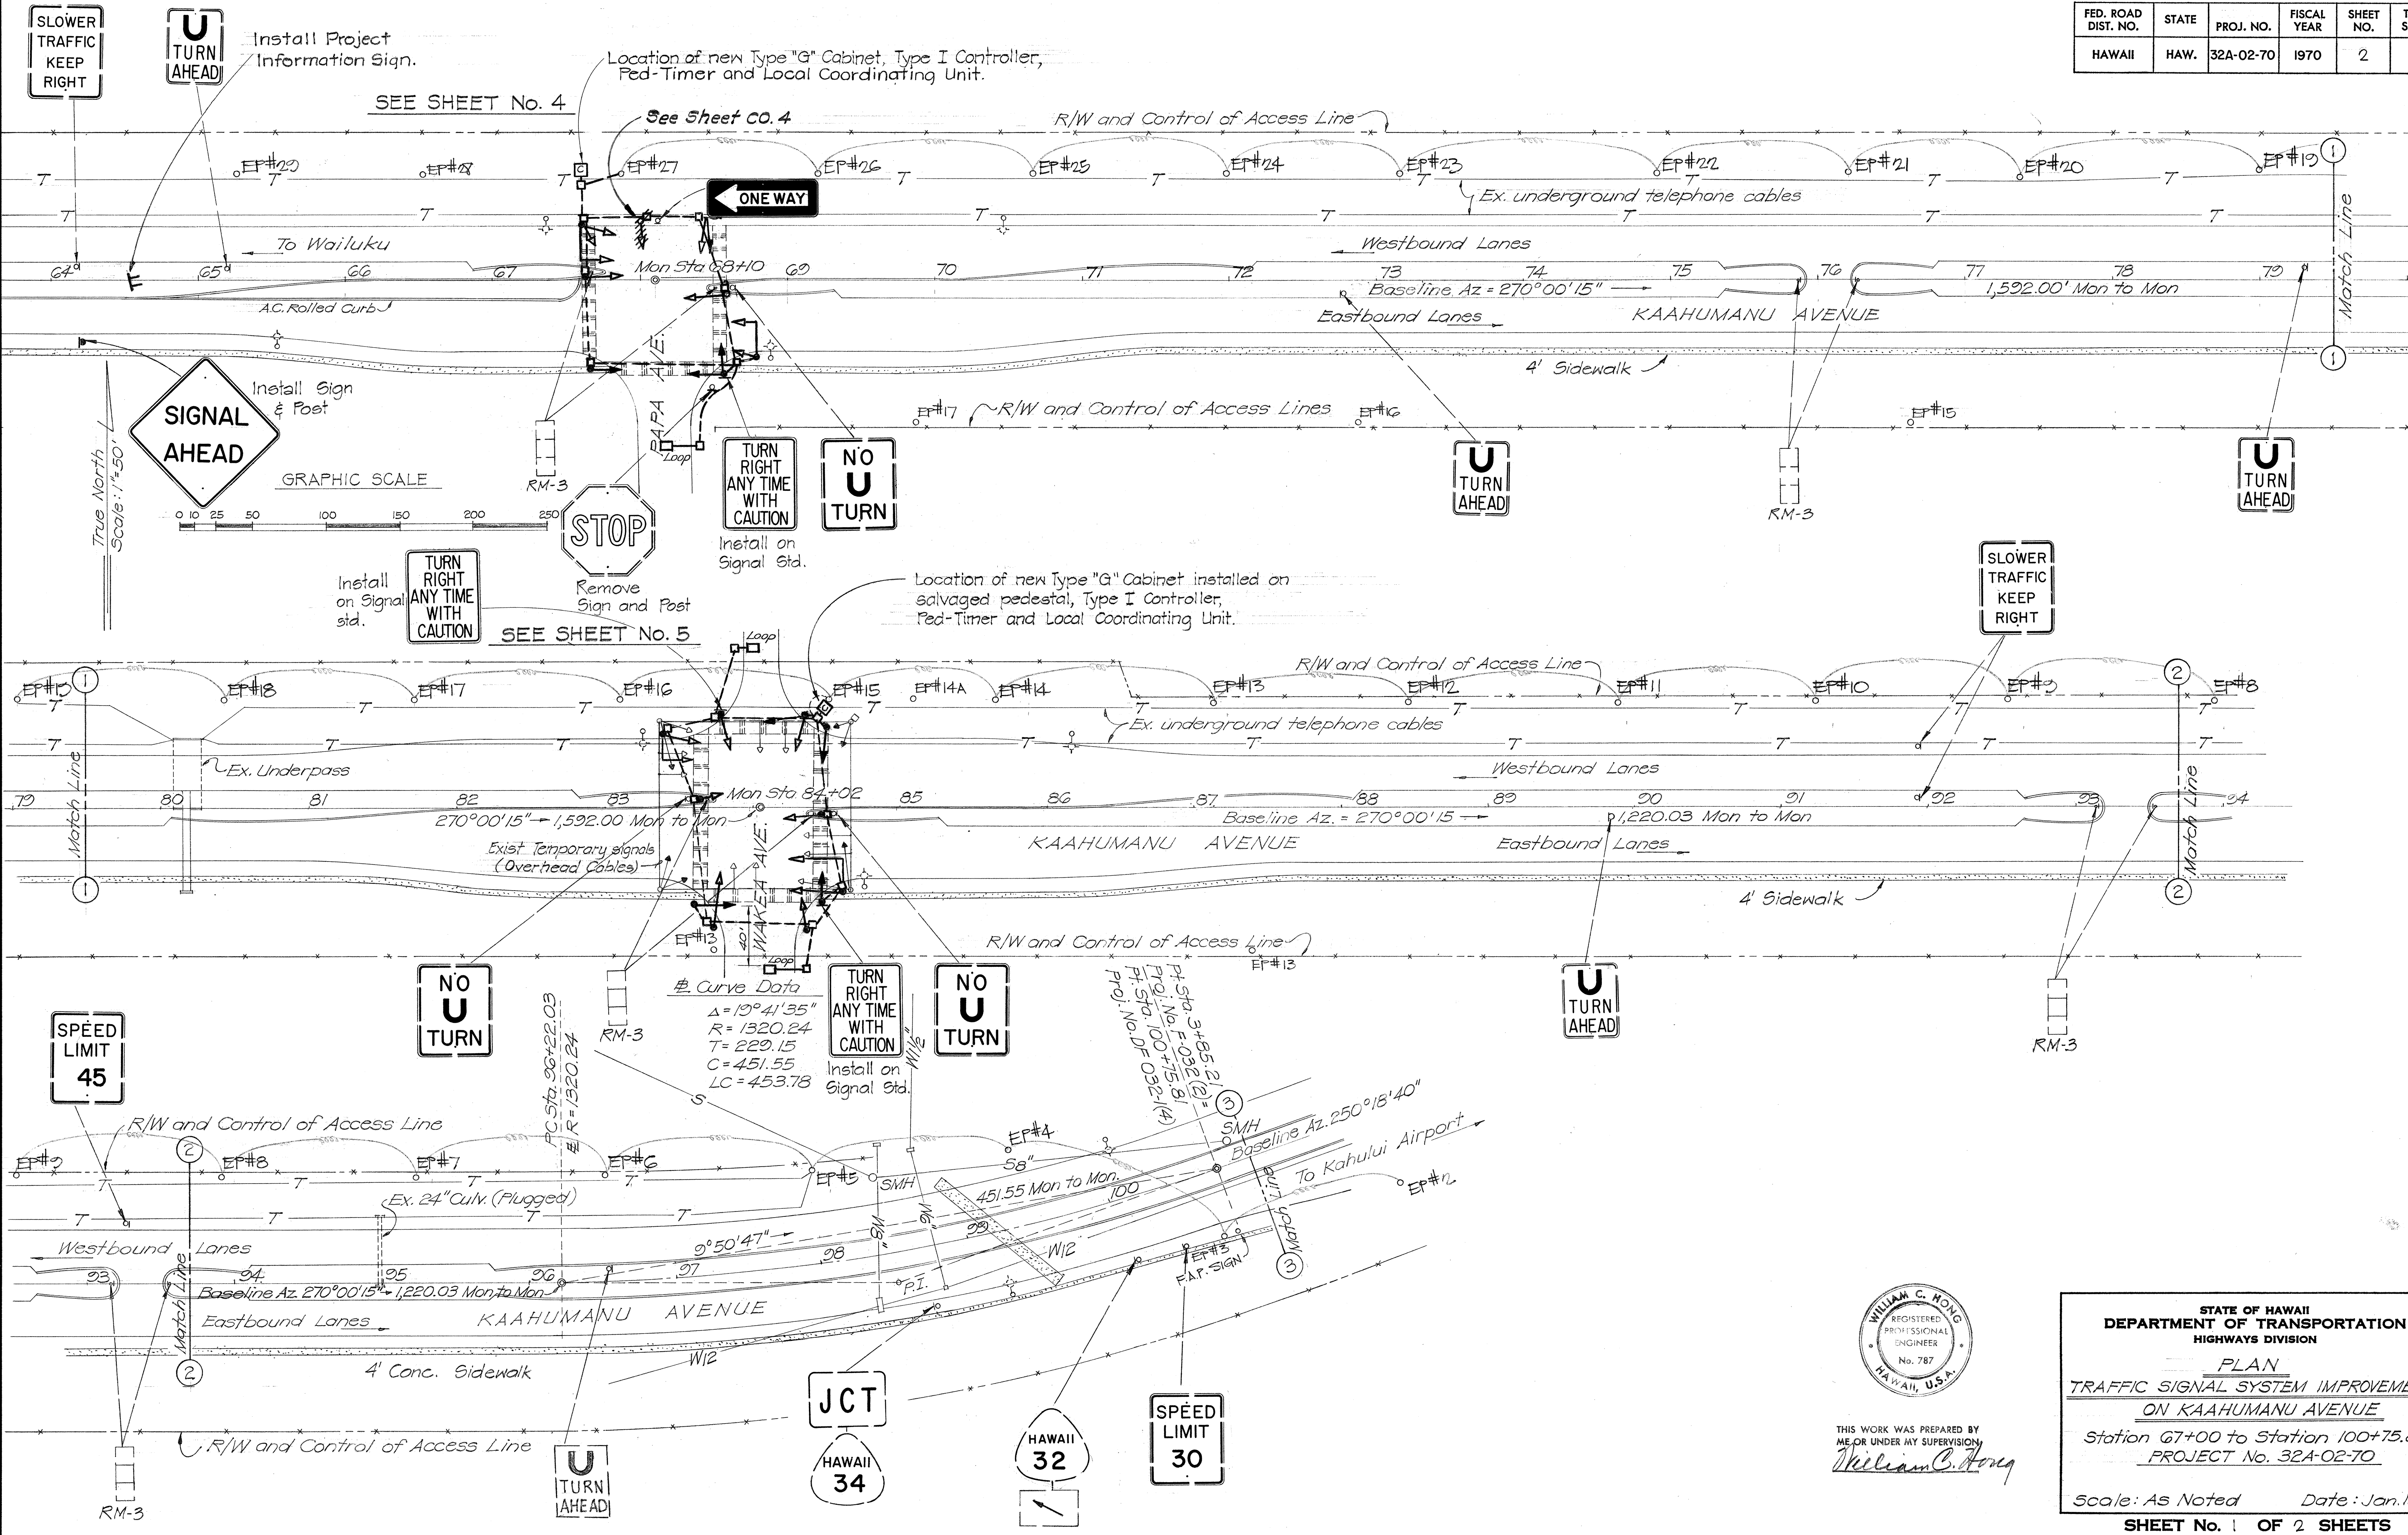

SURVEY PLOTTED BY	DATE
DRAWN BY	
NOTED BY	
CHECKED BY	
ORIGINAL PLAN	No.
NOTE BOOK	No.

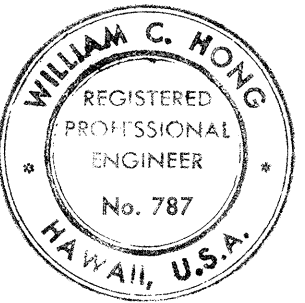

THIS WORK WAS PREPARED BY
ME OR UNDER MY SUPERVISION
William C. Hong

STATE OF HAWAII
DEPARTMENT OF TRANSPORTATION
HIGHWAYS DIVISION

PLAN
TRAFFIC SIGNAL SYSTEM IMPROVEMENTS
ON KAAHUMANU AVENUE
Station 67+00 to Station 100+75.81
PROJECT No. 32A-02-70

Scale: As Noted Date: Jan. 15, 1971

SHEET No. 1 OF 2 SHEETS

ORIGINAL PLAN	SURVEY PLOTTED BY _____	DATE _____
	DRAWN BY _____	" _____
NOTE BOOK	TRACED BY _____	" _____
	DESIGNED BY _____	" _____
	QUANTITIES BY _____	" _____
	CHECKED BY _____	" _____
No. _____		

