


INDEX TO DRAWINGS	
SHEET NO	DESCRIPTION
1.	TITLE SHEET
2.	PLAN & TYPICAL SECT.
3.	PAVEMENT MARKINGS
4.	ADJUSTMENT DETAILS
5.	STD. DET. RAISED PAVT. MARKERS
6.	TYP. DET. PROJ. INFOR. SIGN

STATE OF HAWAII
DEPARTMENT OF TRANSPORTATION
HIGHWAYS DIVISION
HONOLULU, HAWAII

"AS BUILT" PLANS OF
RESURFACING OF MAIN AND HIGH STREETS
WAILUKU, MAUI

PROJECT NO. HWY. M-01-73

DISTRICT OF WAILUKU
ISLAND OF MAUI

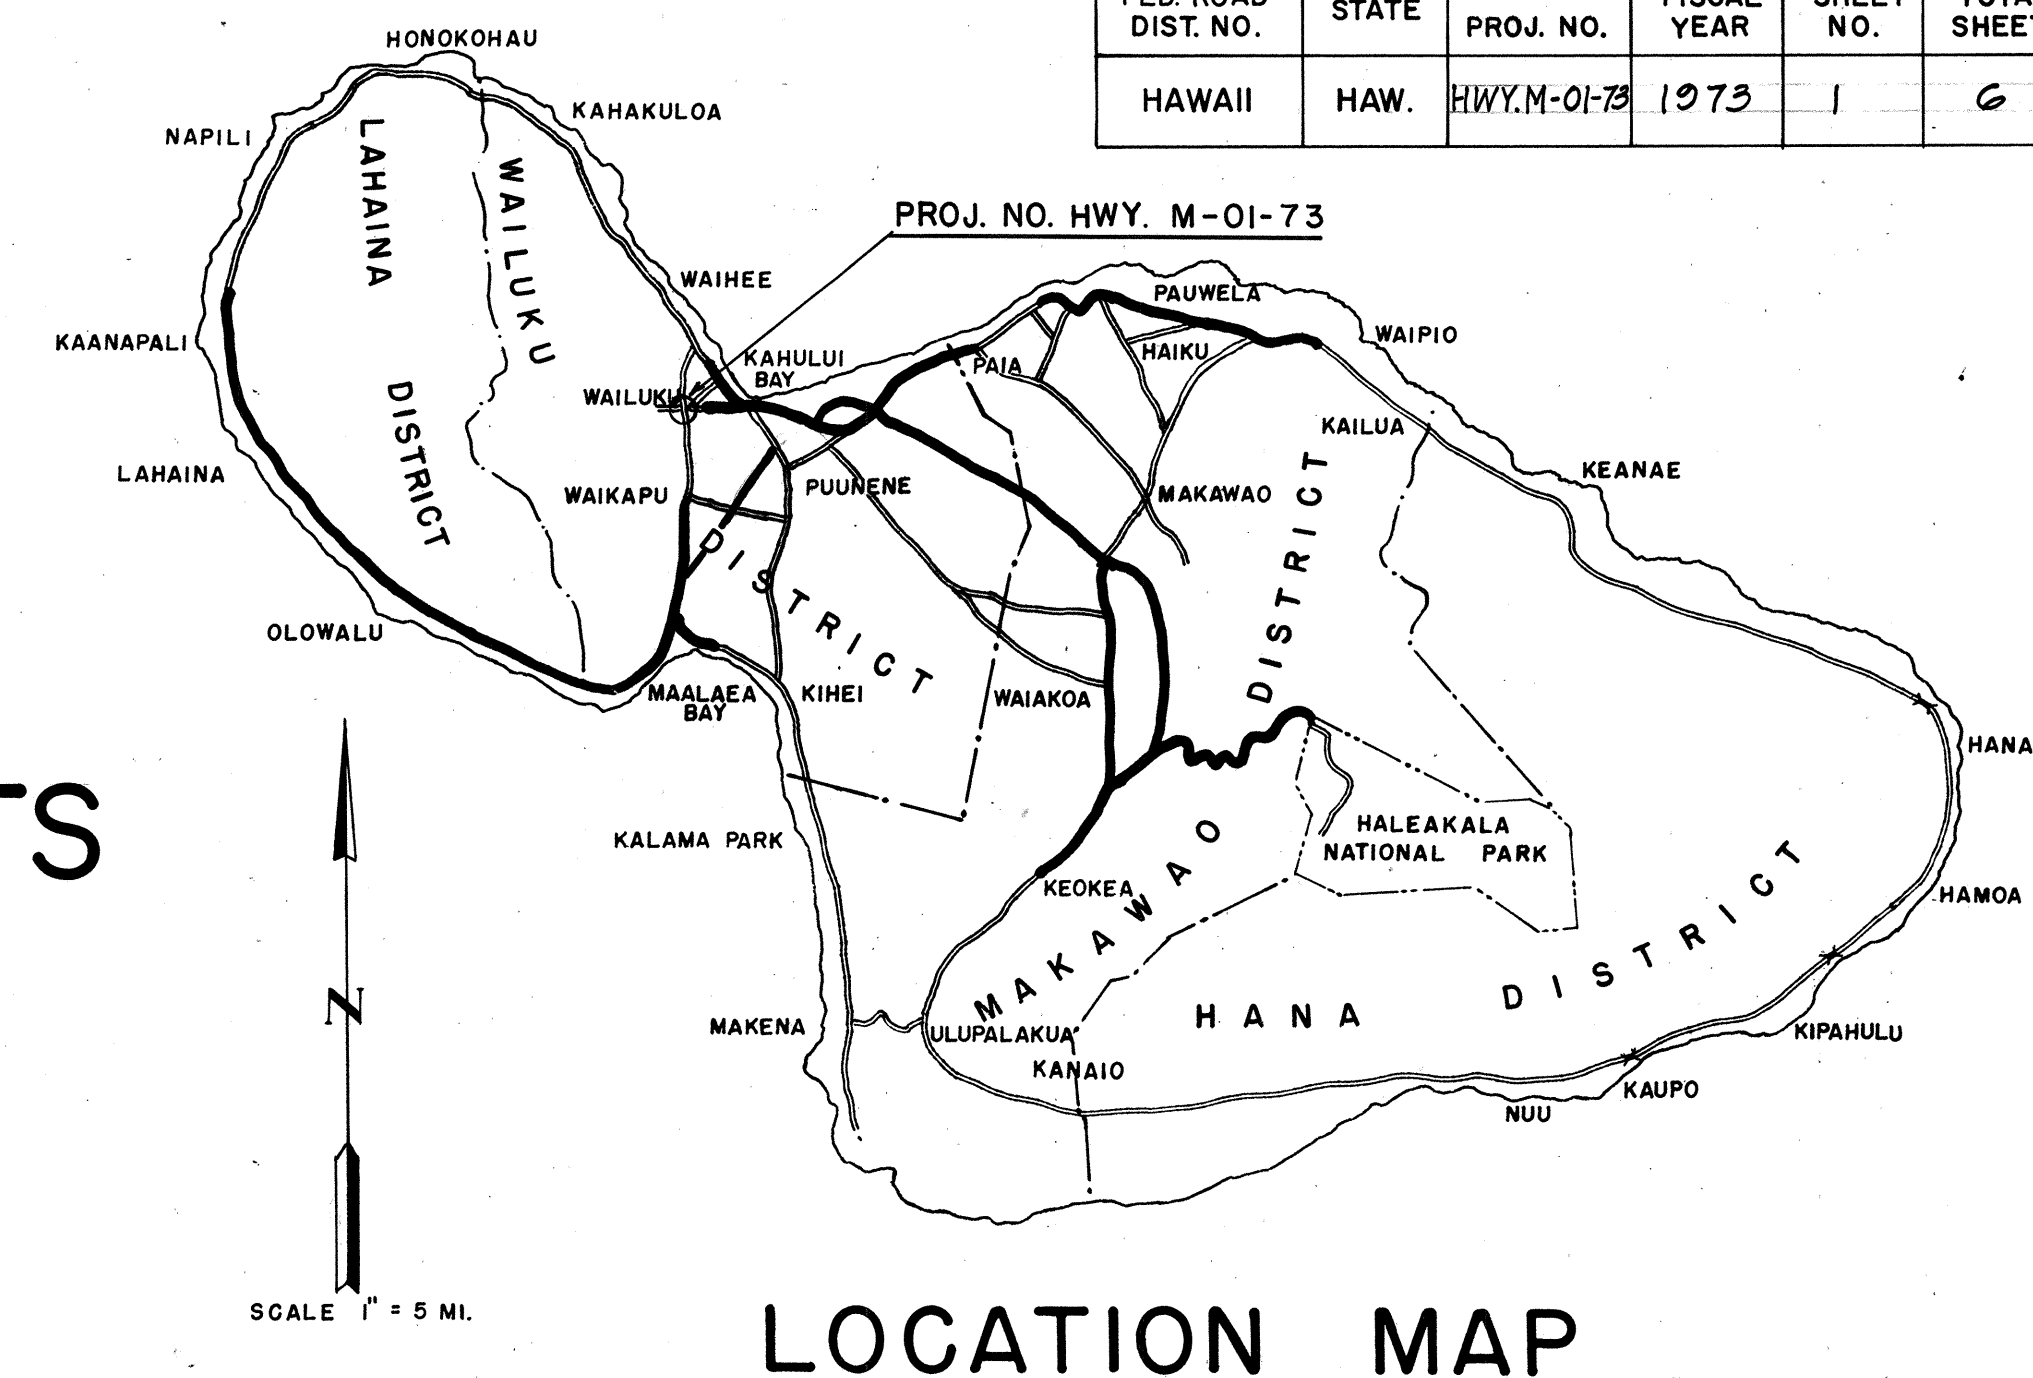

NOTE:
ALL CHANGES MADE DURING CONSTRUCTION HAVE BEEN INCORPORATED ON THESE PLANS IN RED EXCEPT CHANGES IN THE ORIGINAL THEORETICAL QUANTITIES.


Frank R. Clatter
PROJECT ENGINEER

Apr. 18, 1973
DATE

APPROVED:

DATE
10/25/72

Murray Lee
FOR DIRECTOR OF TRANSPORTATION

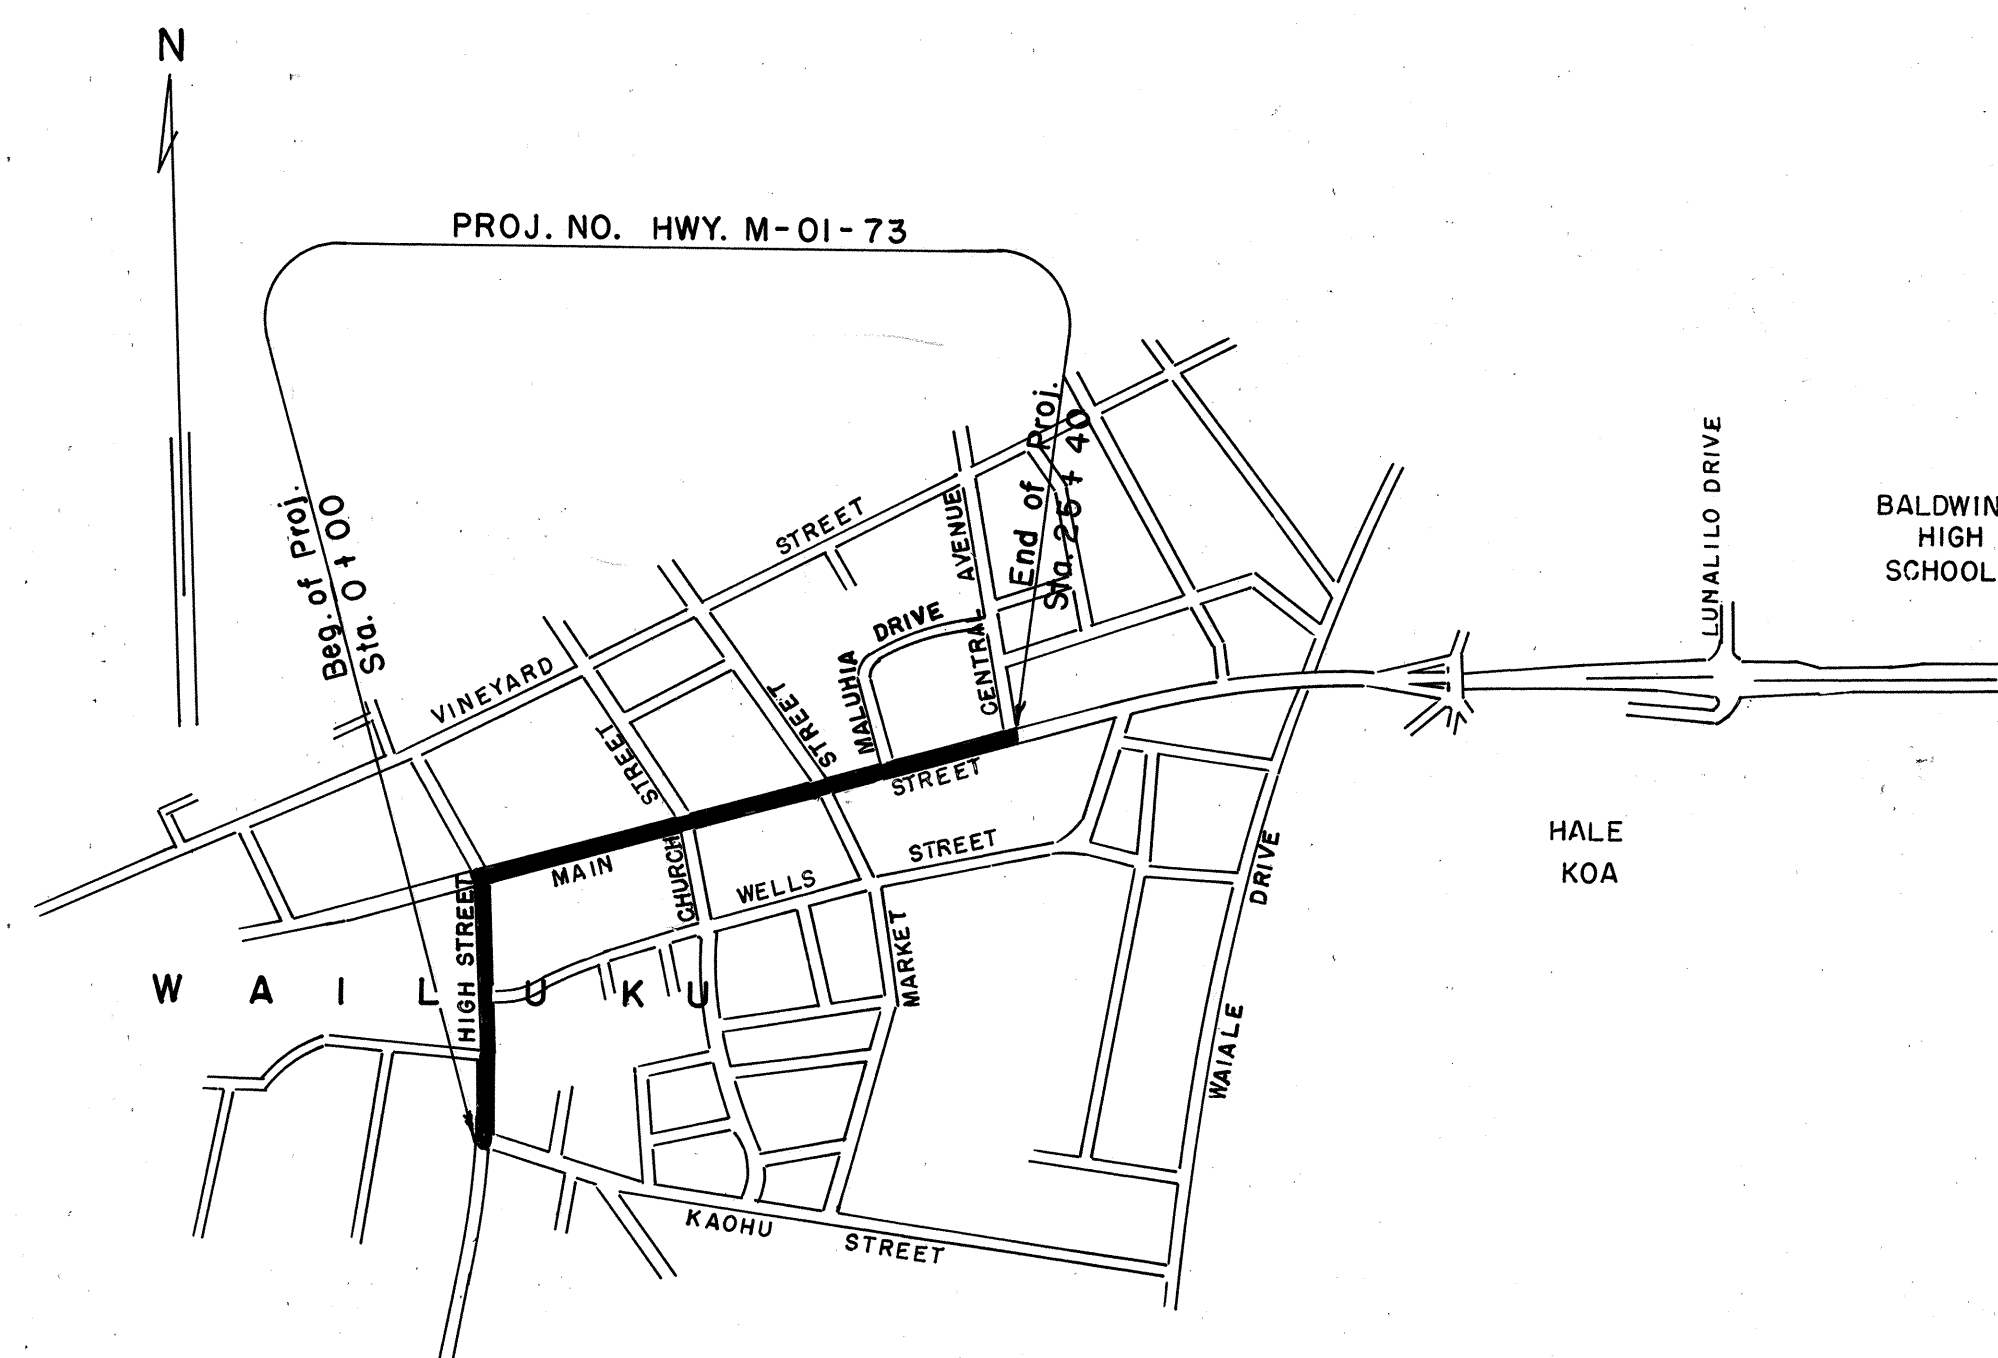

LAYOUT OF PROJECT
Length of Project = 0.481 Mile
Scale: 1" = 600'

DESIGNED BY: MAUI DISTRICT OFFICE
STATE HIGHWAYS DIVISION
DATE: SEPT. 1972

P.S. & E. By: Ronald F. Tsuzuki
Phone: 548-2456
Date: October, 1972