



| FED. ROAD DIST. NO. | STATE | PROJ. NO.  | FISCAL YEAR | SHEET NO. | TOTAL SHEETS |
|---------------------|-------|------------|-------------|-----------|--------------|
| HAWAII              | HAW.  | 32A-01-76M | 1976        | 7         | 11           |

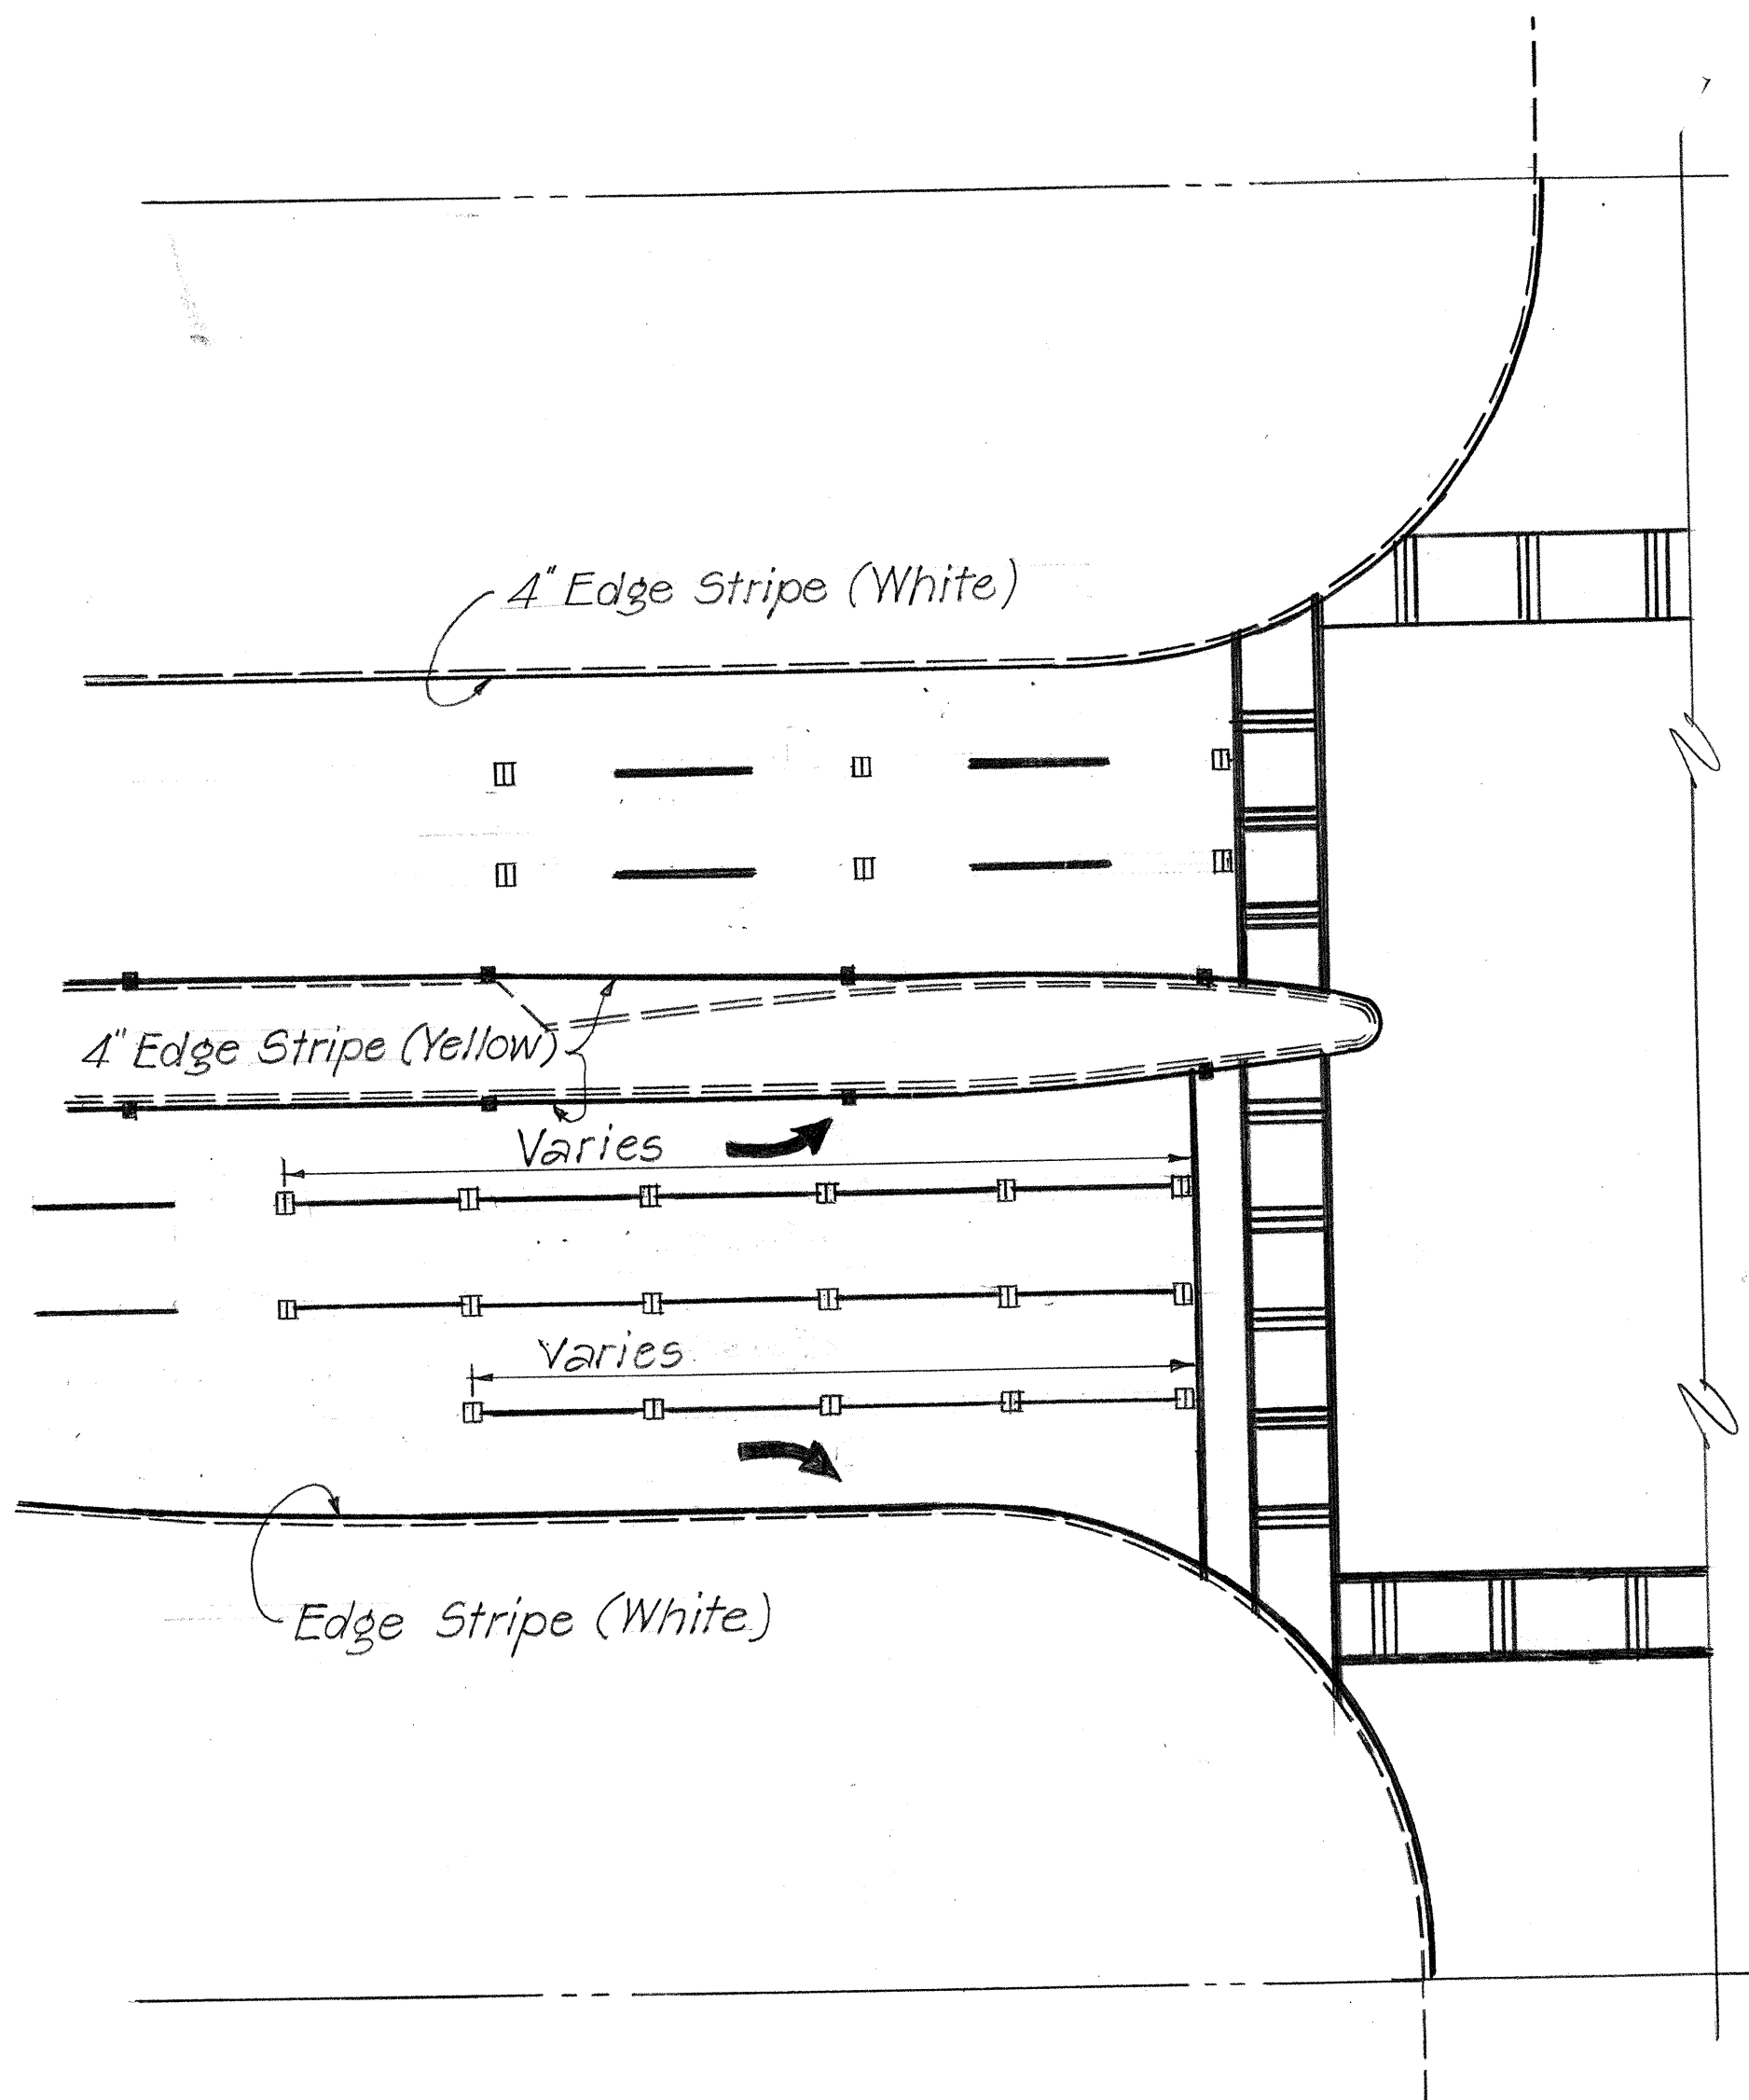

Note:  
Detail for Cross Walk and  
Arrows - See Sheet No 8

KAAHUMANU AVE.  
AT APPROACHES  
STA. 0+00 TO KAHULUI BEACH RD.

TYPICAL PAVEMENT MARKINGS  
Scale: 1"=20'

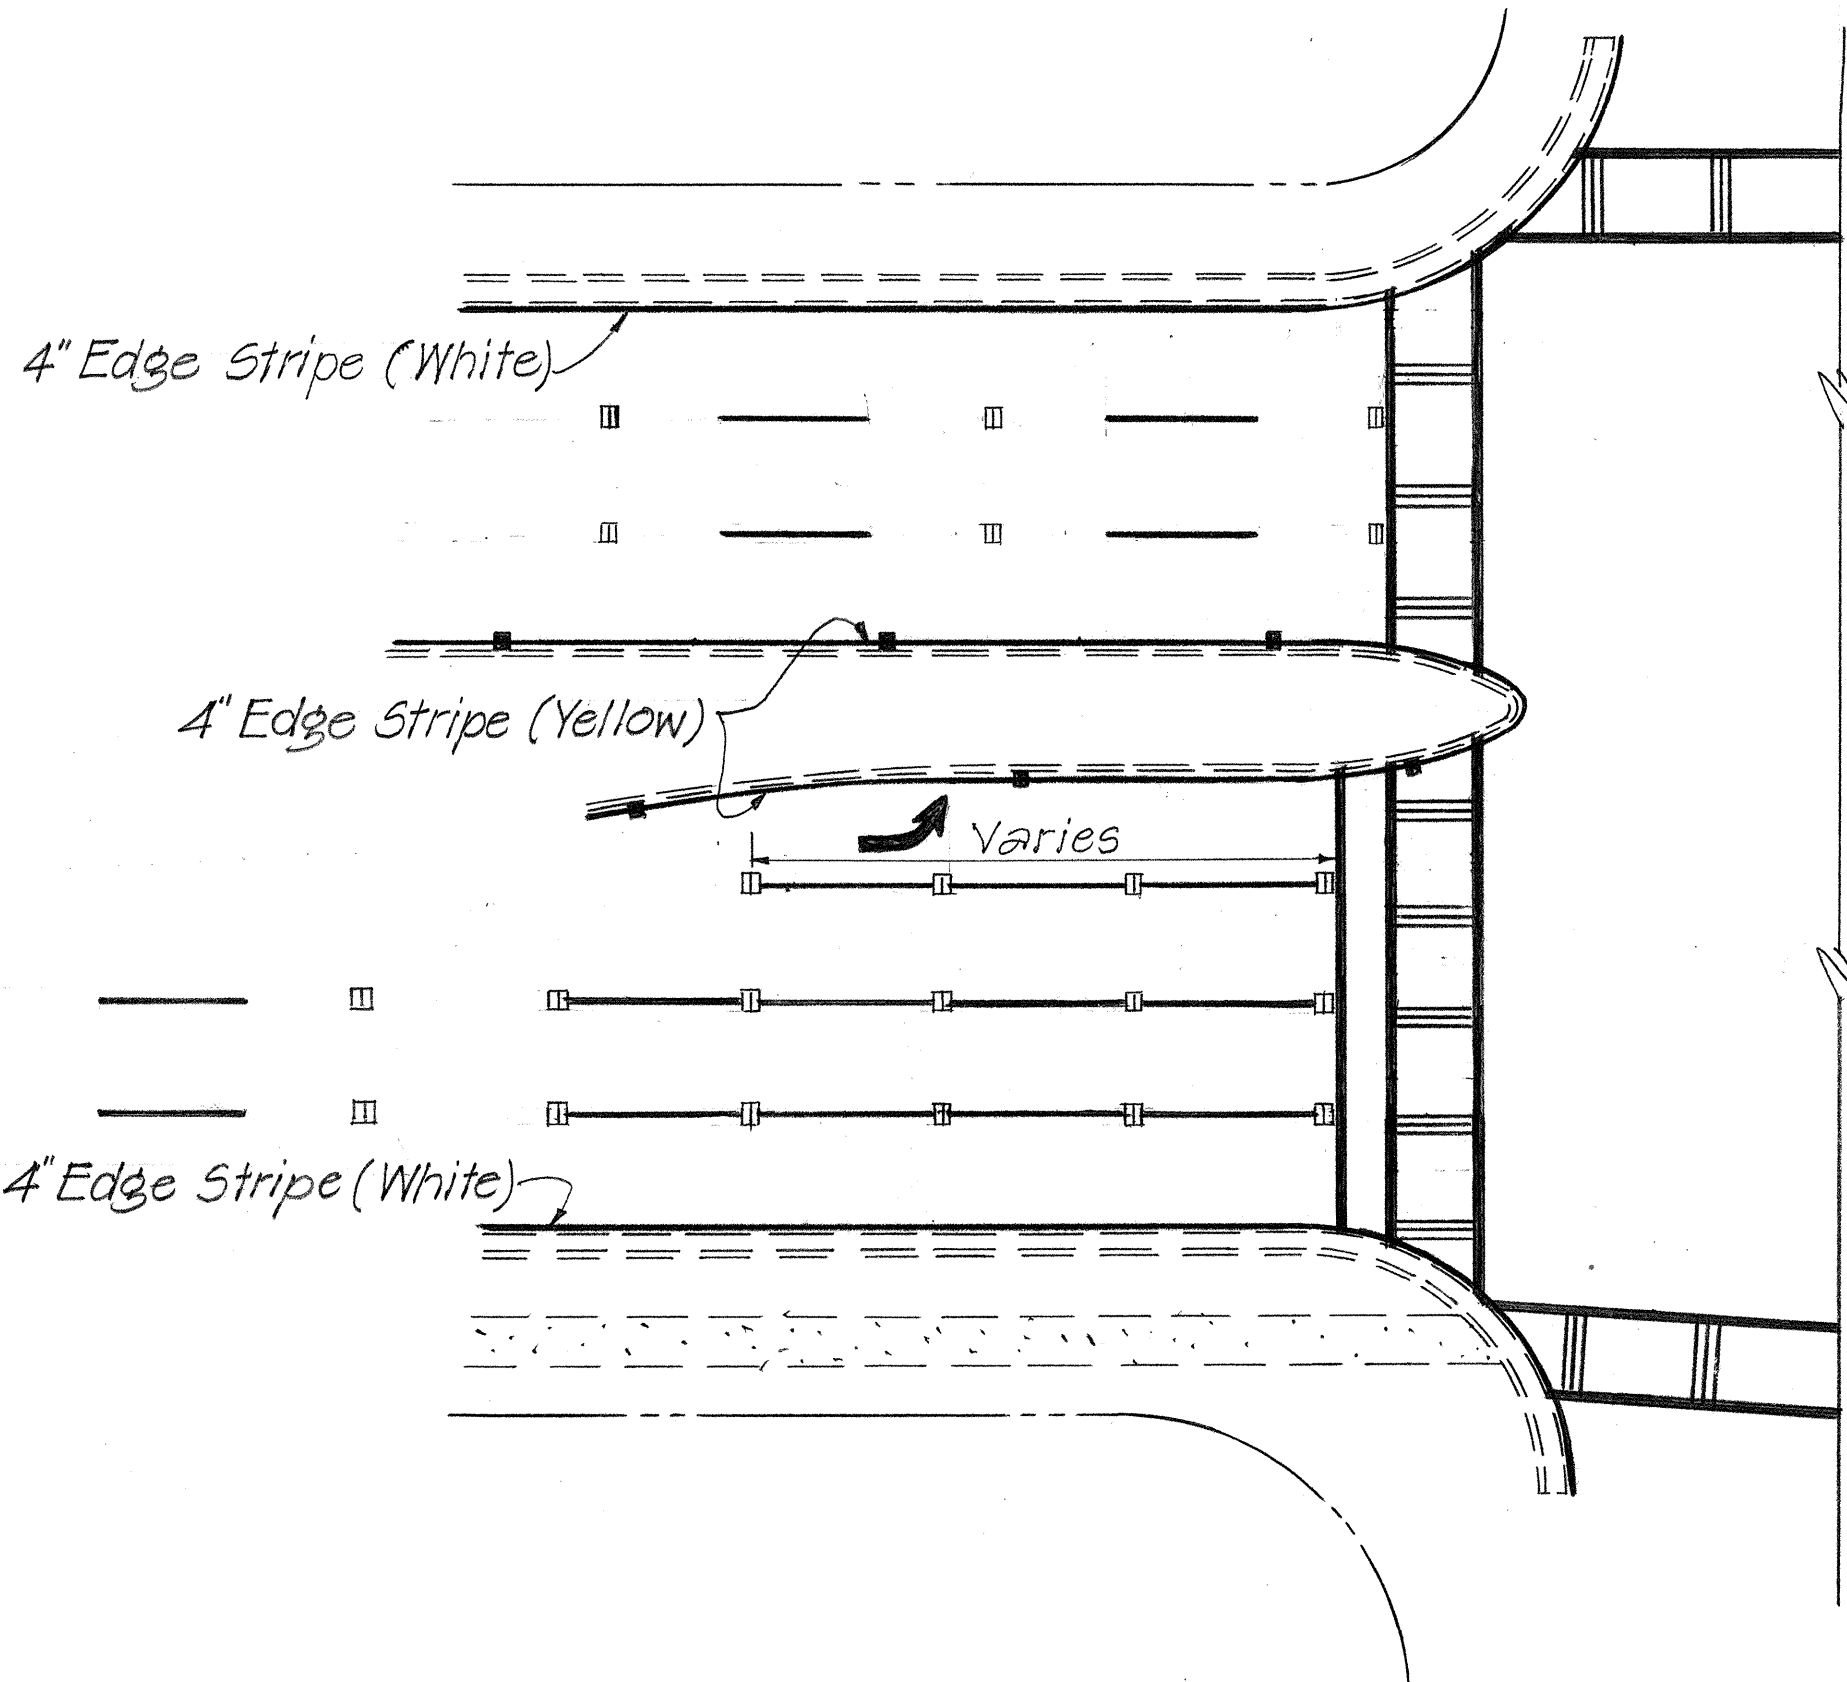

KAAHUMANU AVE.  
AT APPROACHES  
LONO AVE TO PUUNENE AVE.

|                   |      |
|-------------------|------|
| ORIGINAL PLAN     | DATE |
| SURVEY PLOTTED BY |      |
| DRAWN BY          |      |
| TRACED BY         |      |
| DESIGNED BY       |      |
| QUANTITIES BY     |      |
| CHECKED BY        |      |
| No.               |      |

|                                                                      |           |
|----------------------------------------------------------------------|-----------|
| STATE OF HAWAII<br>DEPARTMENT OF TRANSPORTATION<br>HIGHWAYS DIVISION |           |
| <u>PAVEMENT MARKINGS</u>                                             |           |
| <u>KAAHUMANU AVE. RESURFACING</u>                                    |           |
| <u>WAILUKU TO KAHULUI</u>                                            |           |
| <u>PROJ. NO. 32A-01-76M</u>                                          |           |
| SCALE AS NOTED                                                       | JULY 1976 |
| SHEET NO. 1 OF 1 SHEETS                                              |           |