


INDEX TO DRAWINGS	
SHEET NO	DESCRIPTION
1	TITLE SHEET
2	TYPICAL SECTION
3 - 6	ROADWAY PLAN
7	PAVEMENT MARKINGS
8	TYPICAL DETAILS OF PAVEMENT MARKINGS
9	MISCELLANEOUS DETAILS
10 - 11	STANDARD DETAILS


STATE OF HAWAII
DEPARTMENT OF TRANSPORTATION
HIGHWAYS DIVISION
HONOLULU, HAWAII
"AS BUILT" PLANS FOR
KAAHUMANU AVENUE RESURFACING
WAILUKU TO KAHULUI
PROJECT NO. 32A-01-76M
DISTRICT OF WAILUKU
COUNTY OF MAUI
ISLAND OF MAUI

SCALES

PLAN		1 IN. = 50 FT.
PROFILE	HOR.	1 IN. = FT.
	VER.	1 IN. = FT.
X-SECTIONS	HOR.	1 IN. = FT.
	VER.	1 IN. = FT.

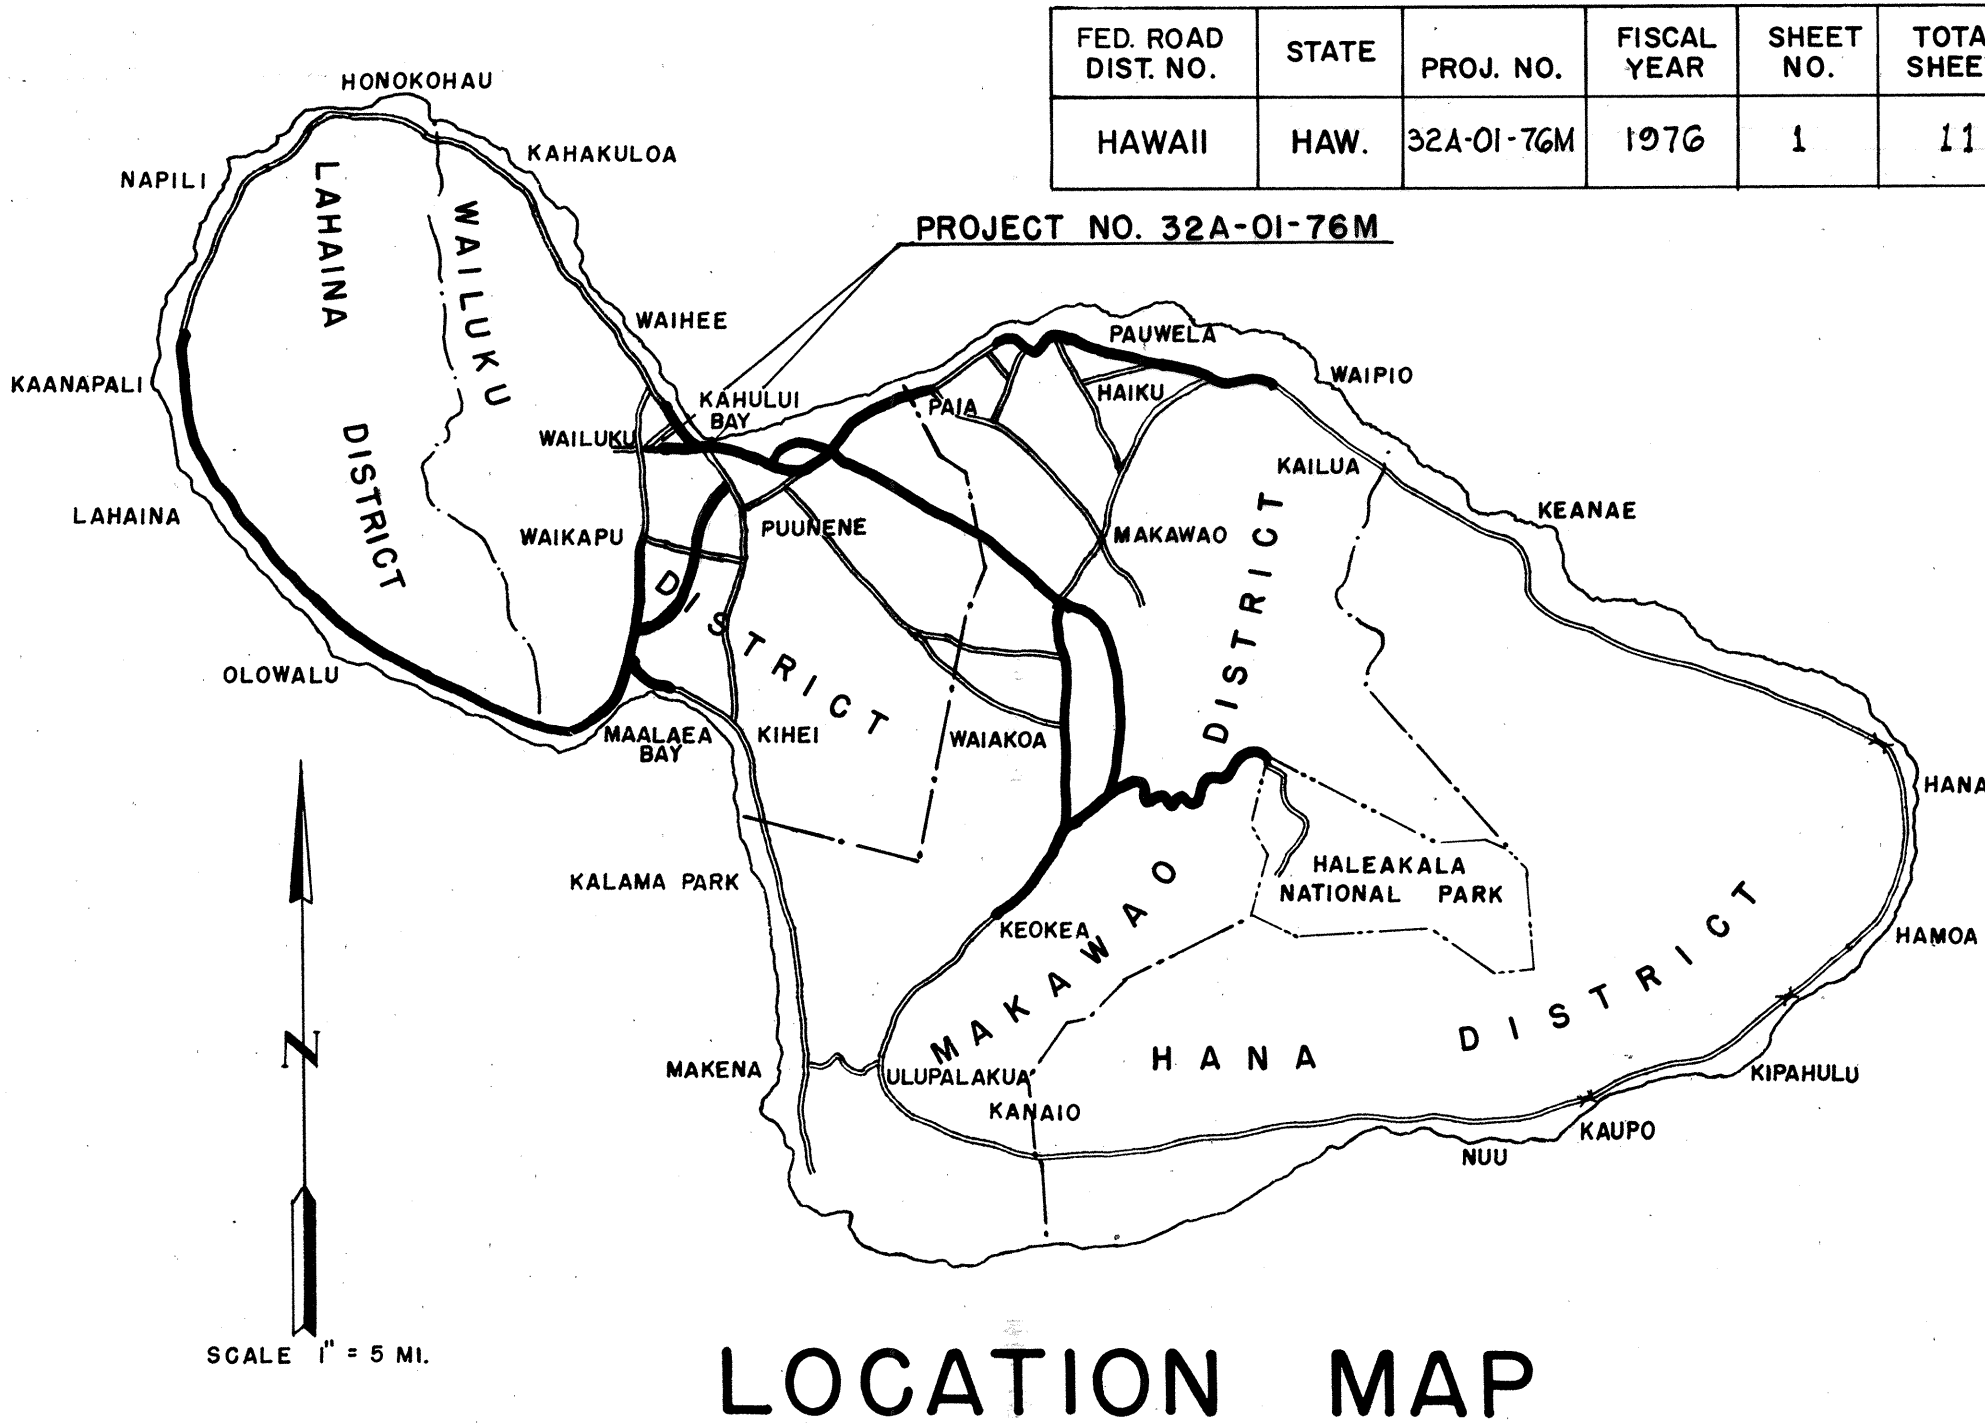

FEDERAL AID PROJECTS PREVIOUSLY CONSTRUCTED OR UNDER CONSTRUCTION

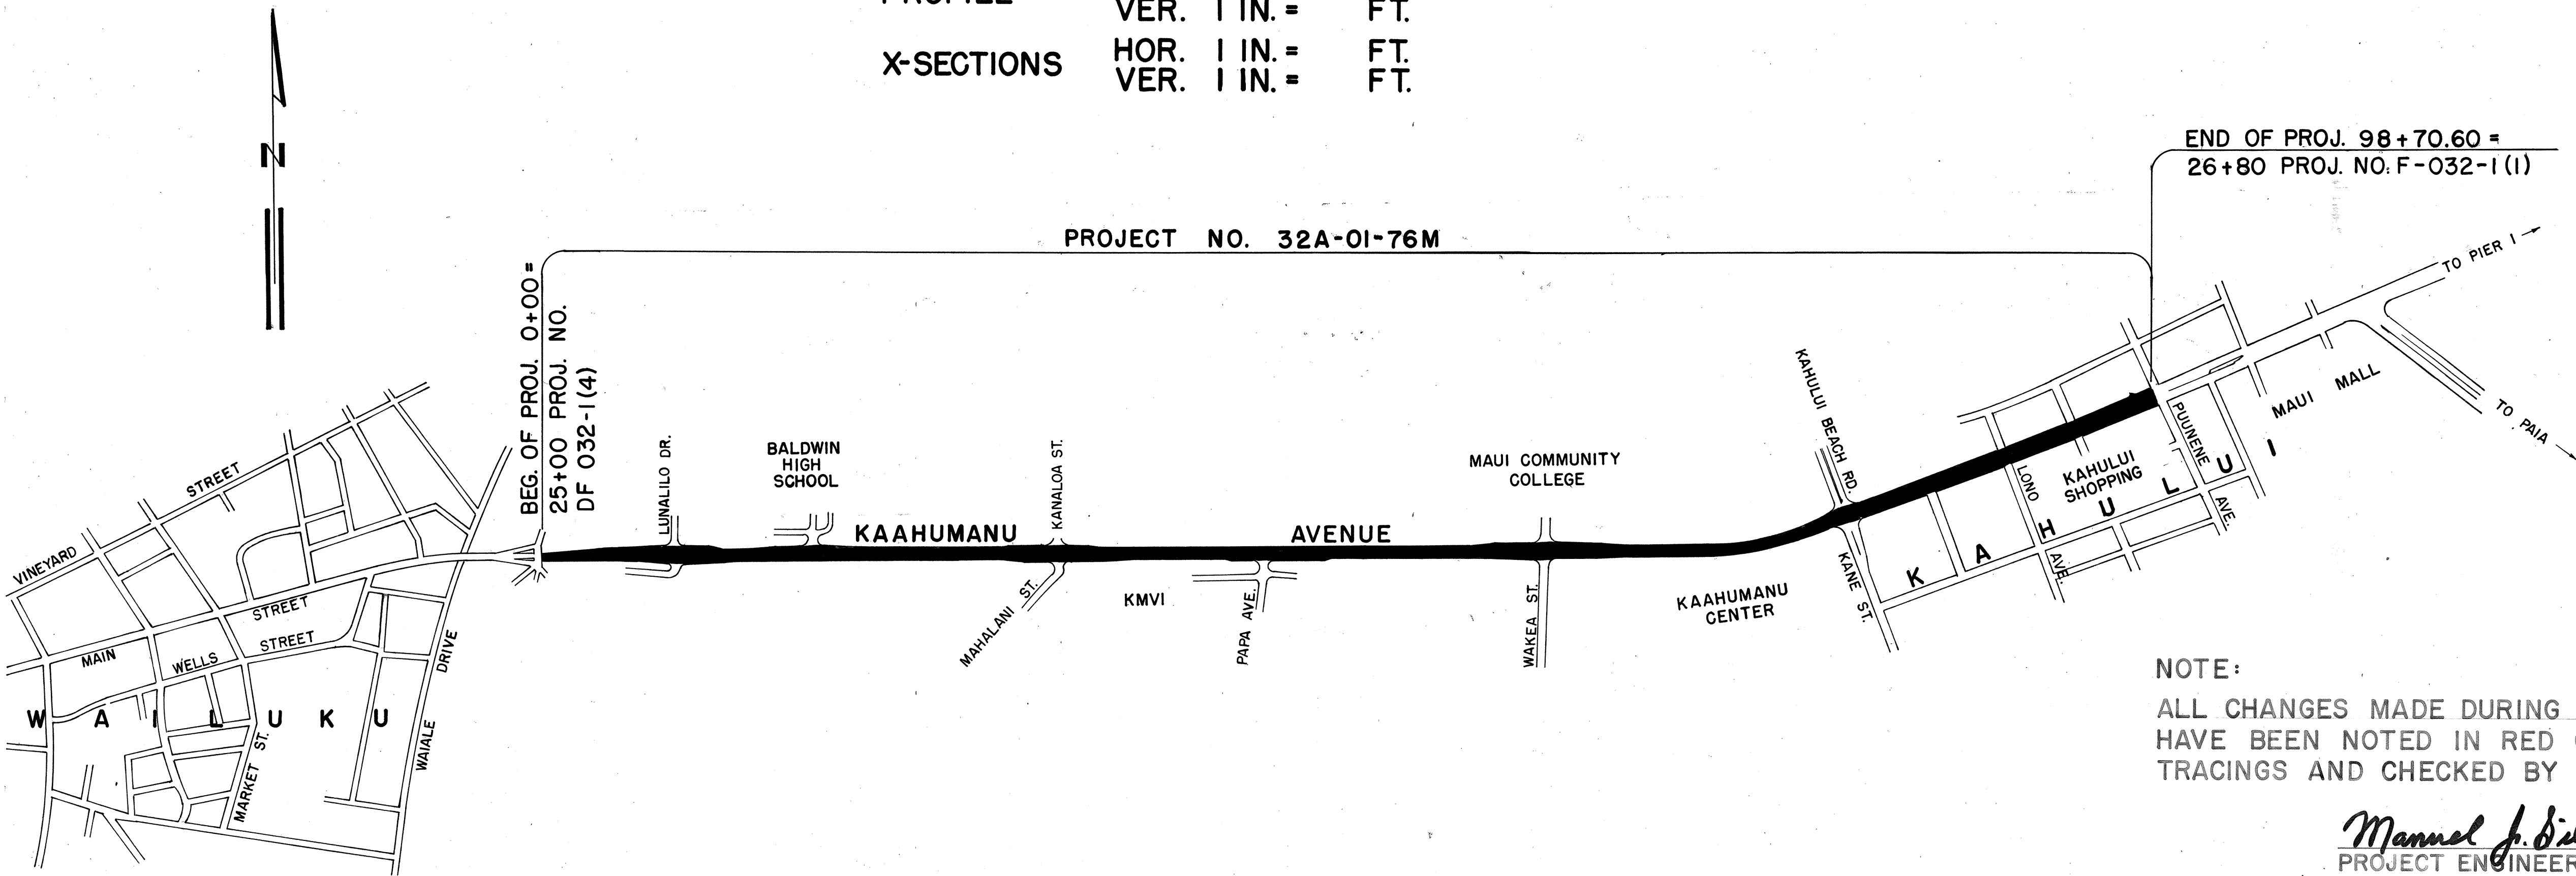

LAYOUT OF PROJECT

LENGTH OF PROJECT	1.869 MI.
"	3.000 KM.
SCALE:	1" = 600'

NOTE:
ALL CHANGES MADE DURING CONSTRUCTION
HAVE BEEN NOTED IN RED ON THESE
TRACINGS AND CHECKED BY

Mannuel J. Silva 28 Feb. 1977
PROJECT ENGINEER DATE

DEPARTMENT OF TRANSPORTATION STATE OF HAWAII	
APPROVED:	
R. Higashionna	10-15-75
for DIR. OF TRANSPORTATION	DATE

DESIGNED BY: MAUI DISTRICT OFFICE
STATE HWYS. DIVISION
DATE: JULY 1975
P S & E BY: RONALD F. TSUZUKI
HIGHWAY DESIGN UNIT B
TEL.: 548-2456 DATE: SEPT., 1975