

INDEX TO DRAWINGS	
SHEET NO	DESCRIPTION
1	TITLE SHEET
2	PLAN SHEET
3-6	MISC DETAILS
7	STANDARD DETAIL

STATE OF HAWAII

DEPARTMENT OF TRANSPORTATION

HIGHWAYS DIVISION

HONOLULU, HAWAII

"AS BUILT"

PLANS FOR

THE INSTALLATION OF

TRAFFIC SIGNALS

ON


KAAHUMANU AVENUE

AT MAHALANI STREET

PROJ. NO. 32A-01-76


DISTRICT OF WAILUKU

ISLAND OF MAUI

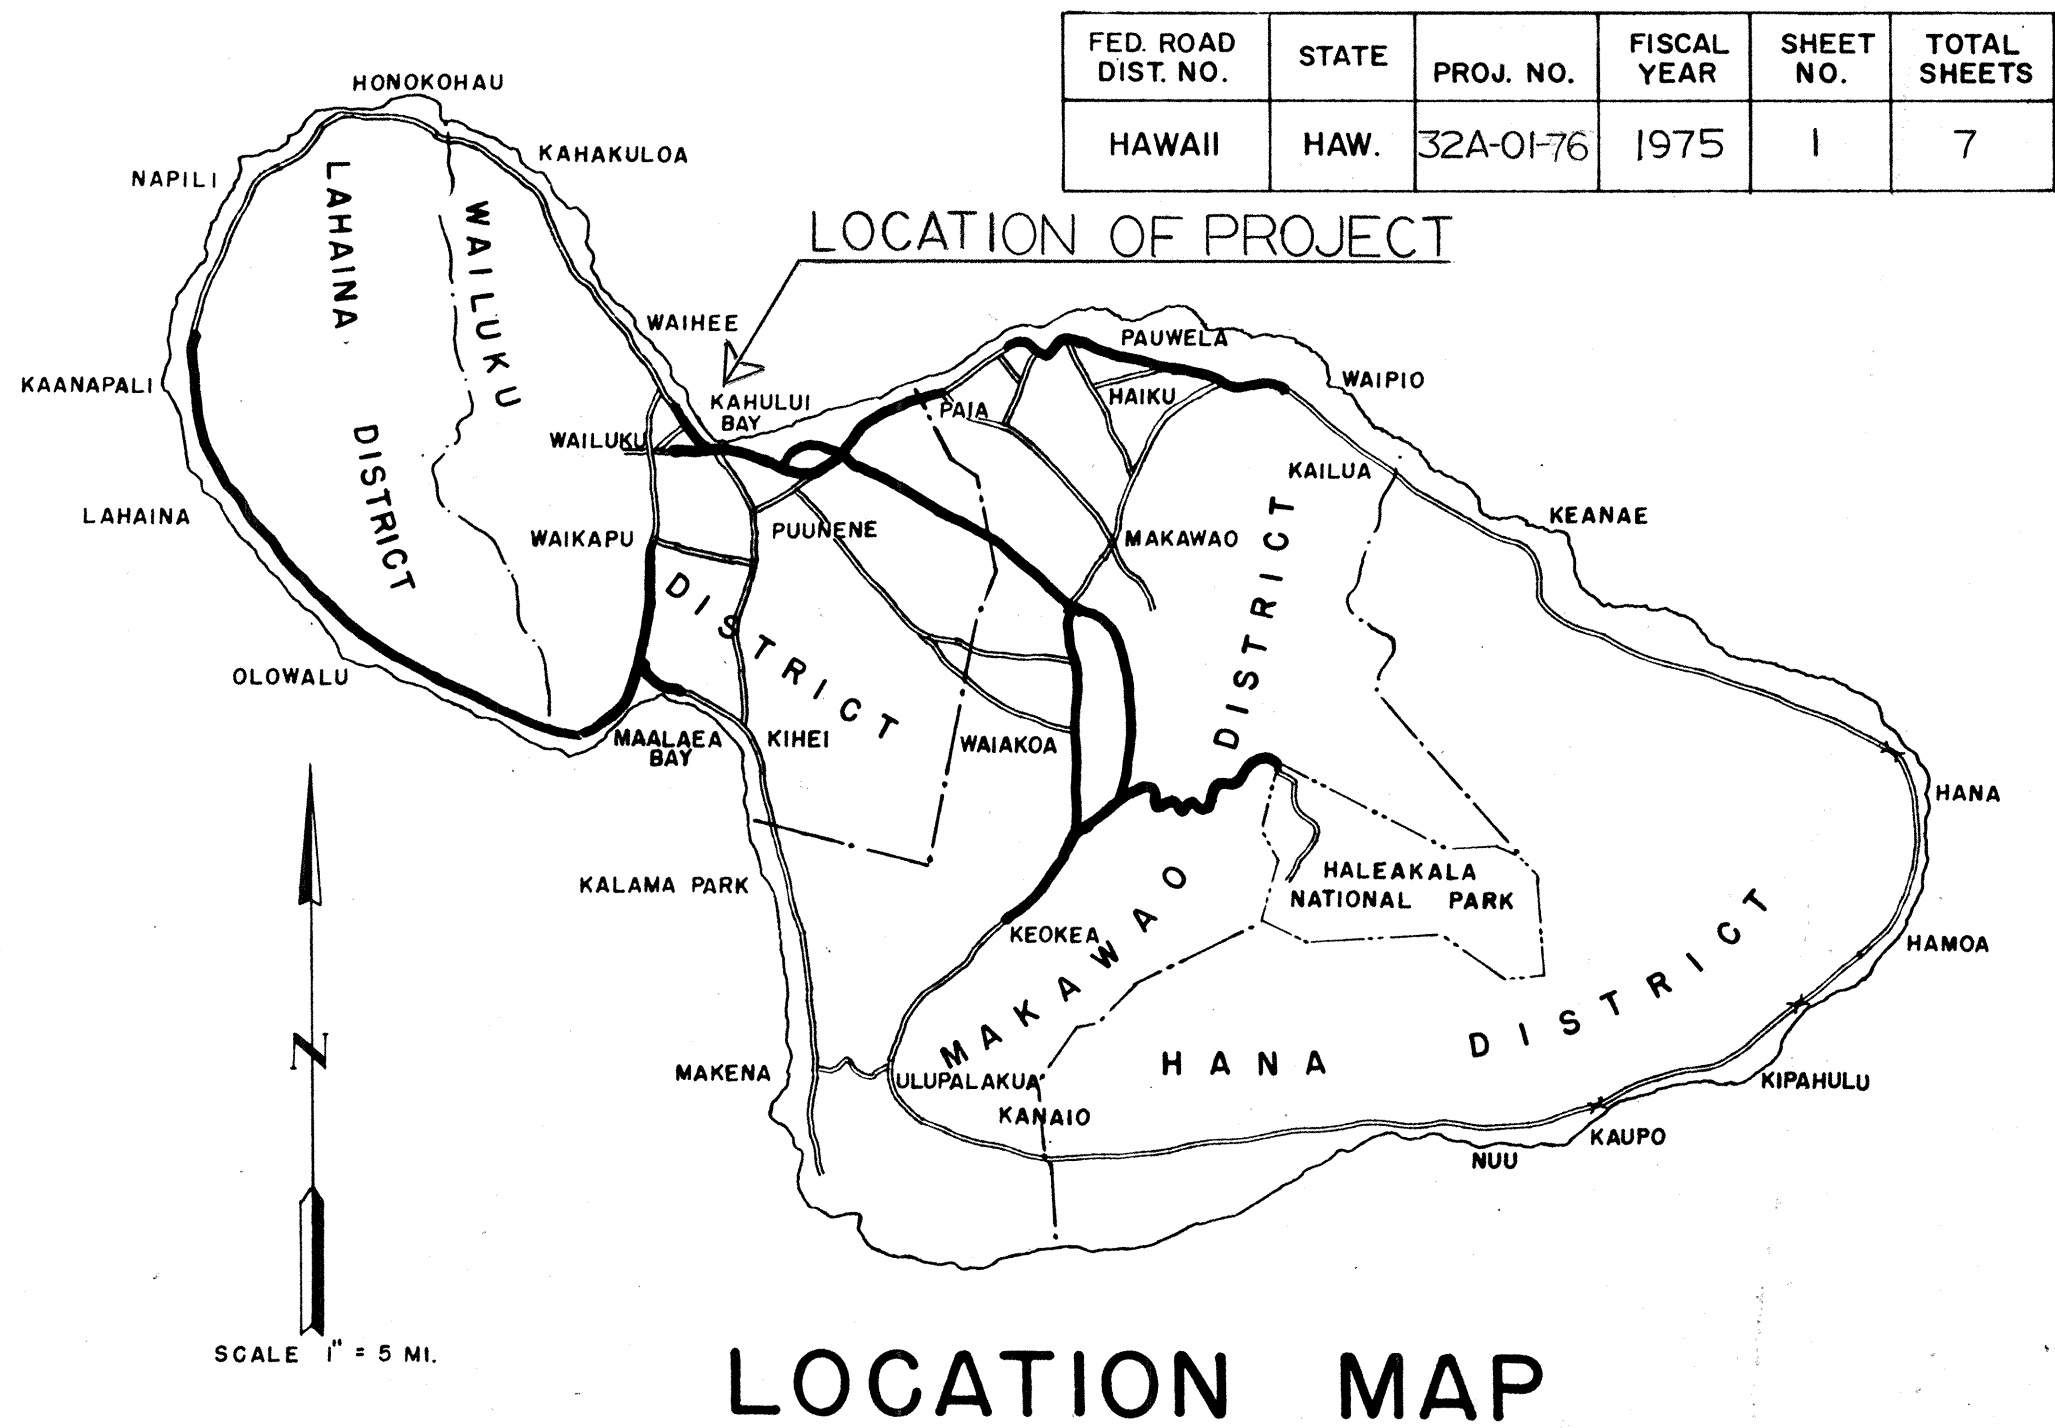

NOTE:
ALL CHANGES MADE DURING CONSTRUCTION
HAVE BEEN NOTED IN RED ON THESE
TRACINGS AND CHECKED BY

Manuel J. Silva 28 Feb. 1977
PROJECT ENGINEER DATE

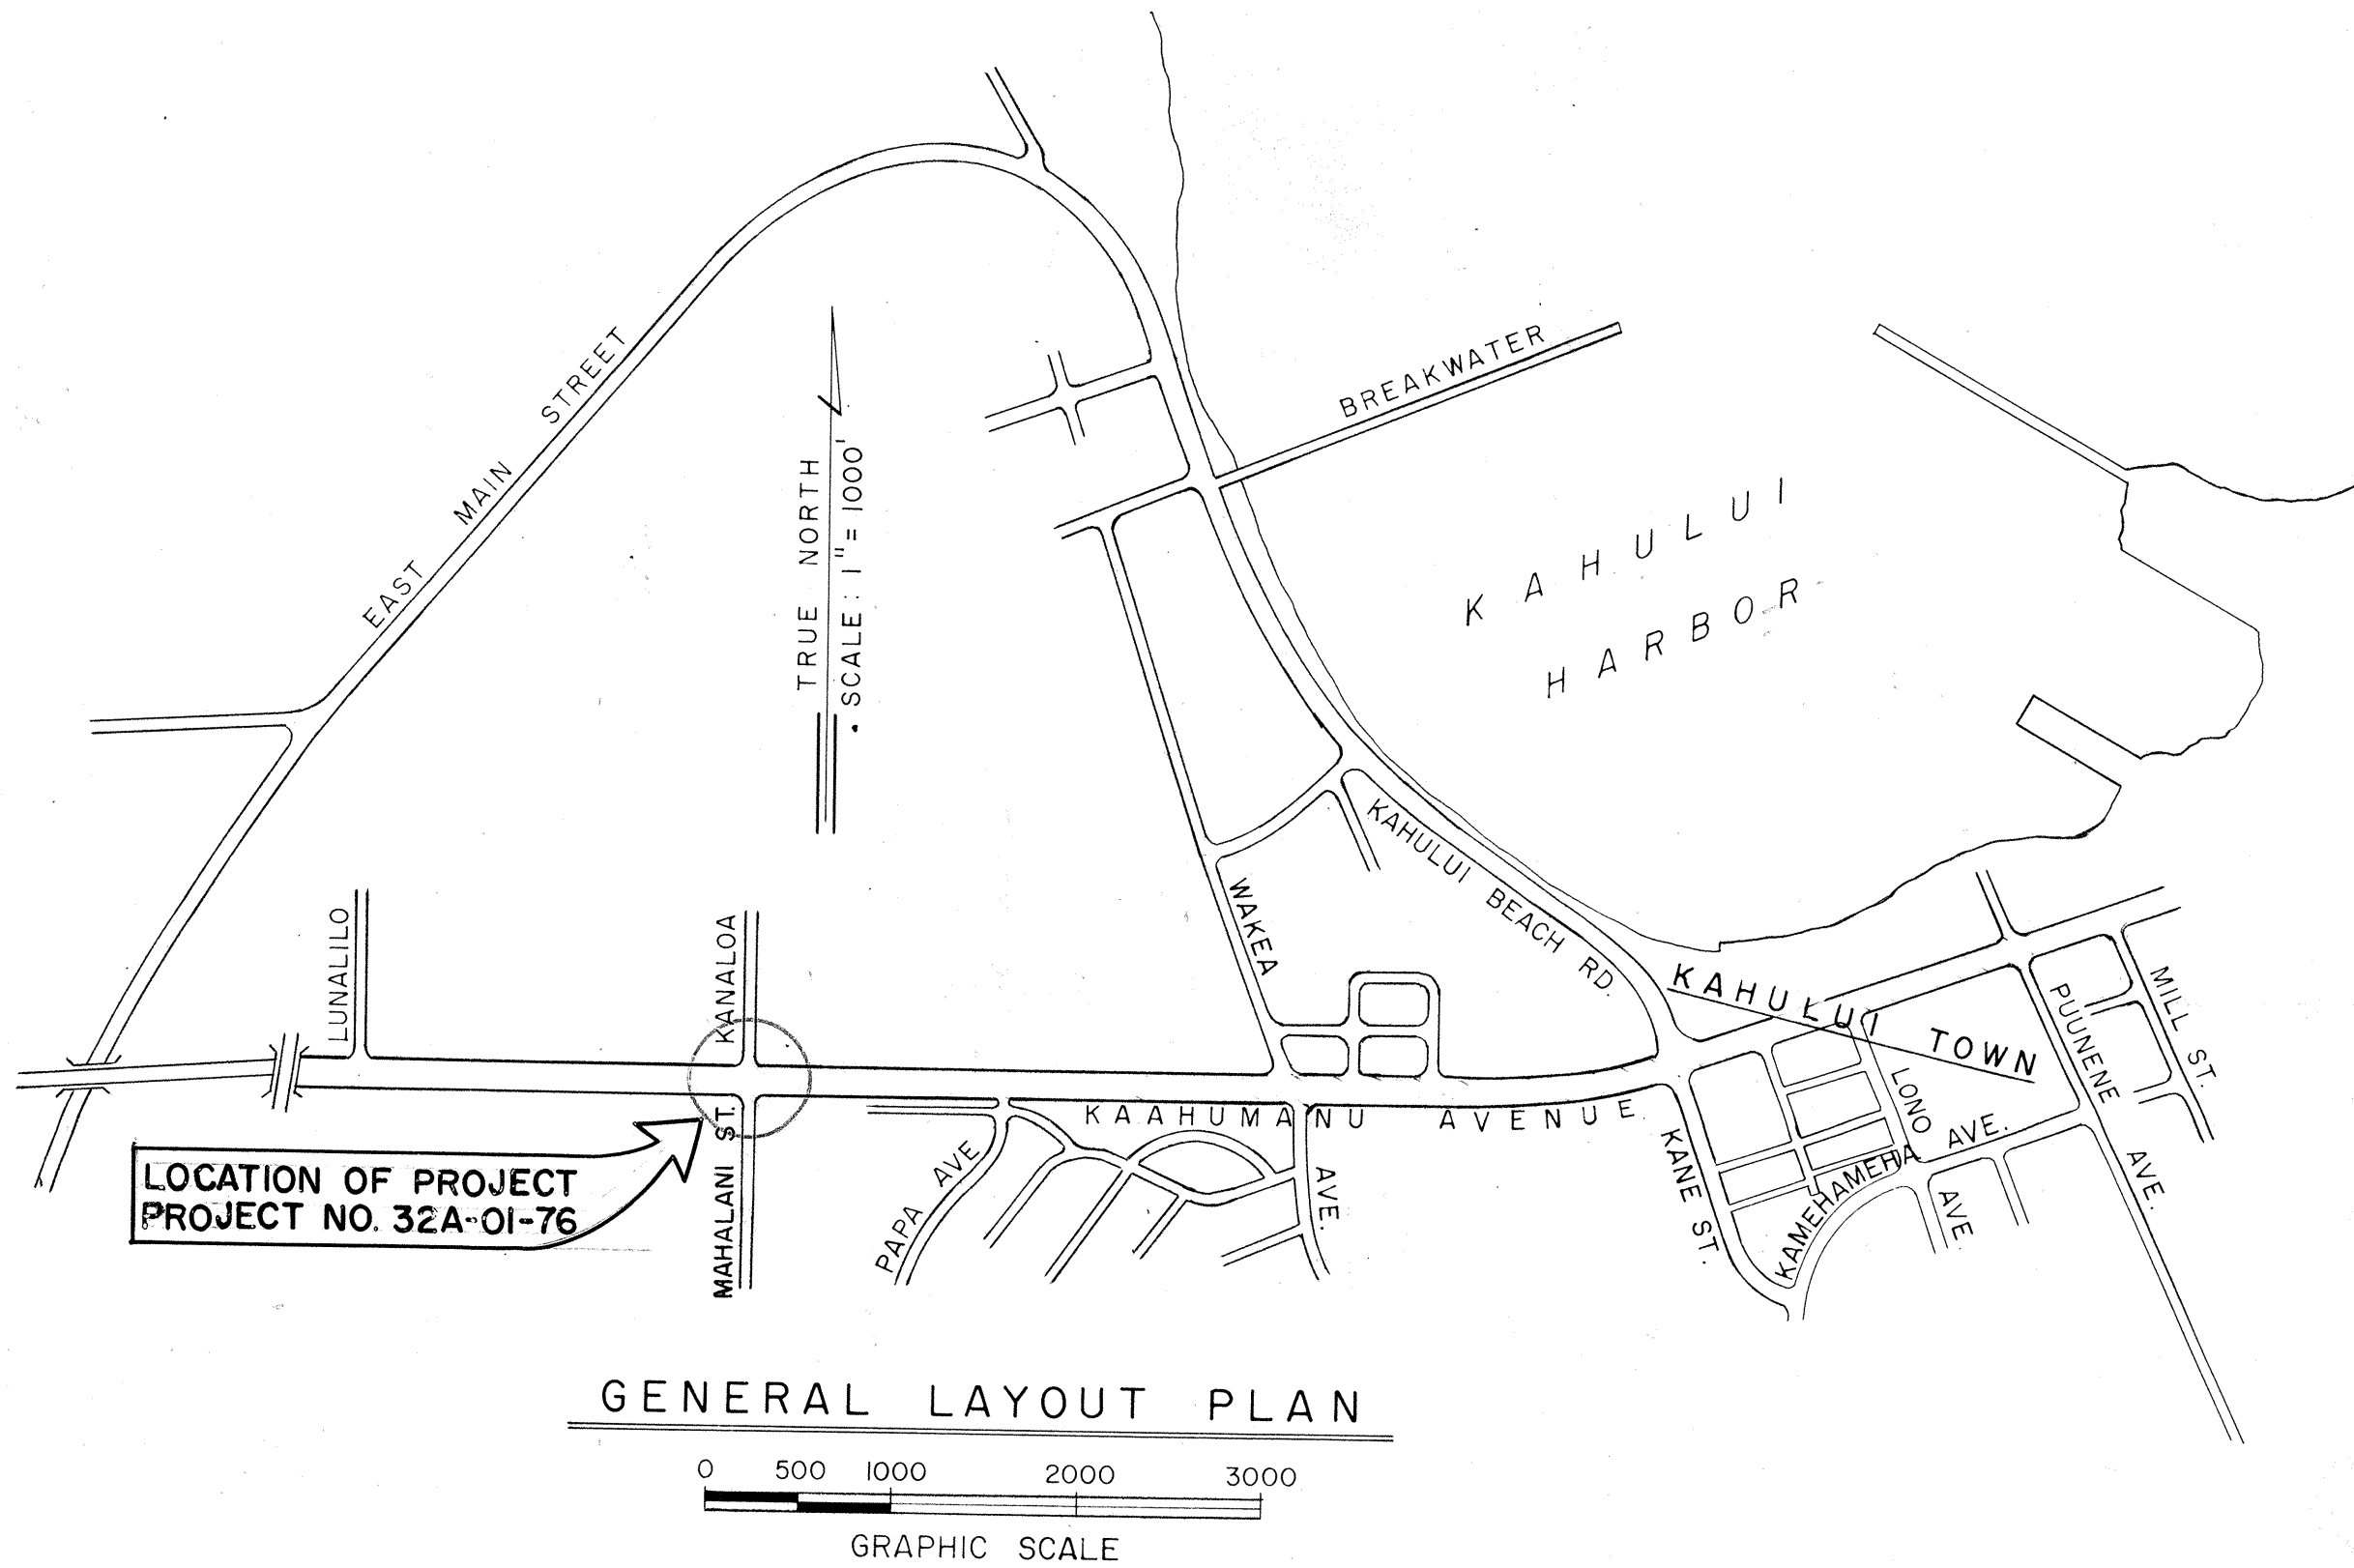

DEPARTMENT OF TRANSPORTATION
STATE OF HAWAII
APPROVED:
R. Higashimura 12-1-75
for DIR. OF TRANSPORTATION DATE

DESIGNED BY *R. Tsuzuki* 548-2456 10/1/75
P. S. & E. BY PHONE DATE