

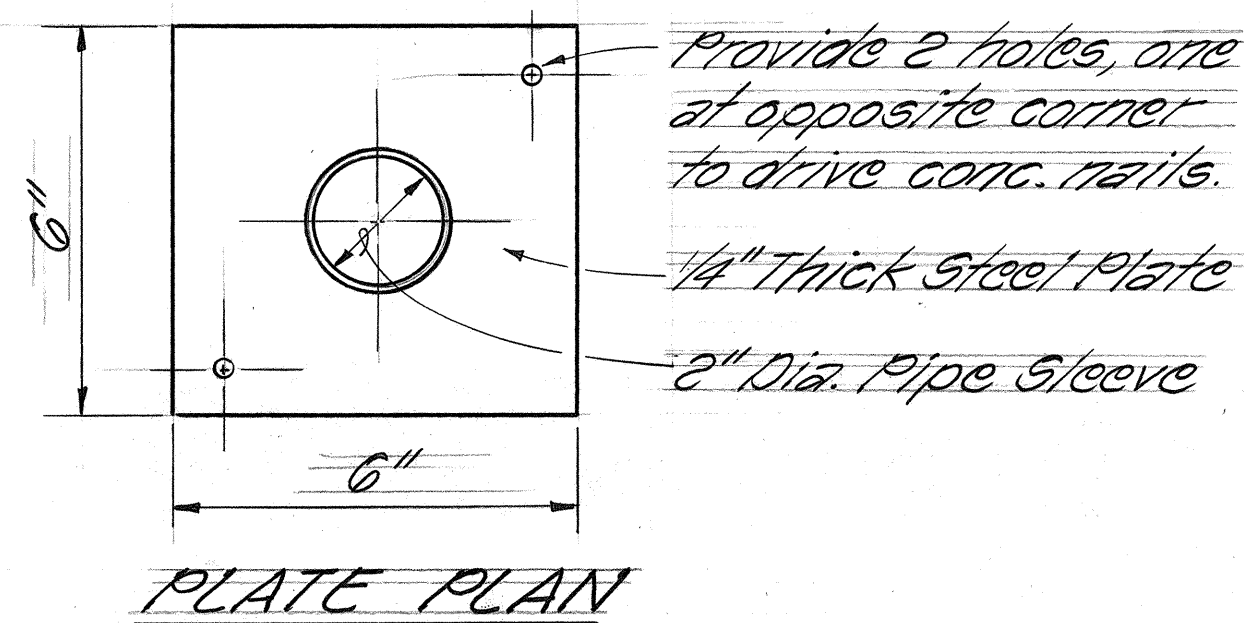


FED. ROAD DIST. NO.	STATE	PROJ. NO.	FISCAL YEAR	SHEET NO.	TOTAL SHEETS
HAWAII	HAW.	32A-01-83M	1983	3	17

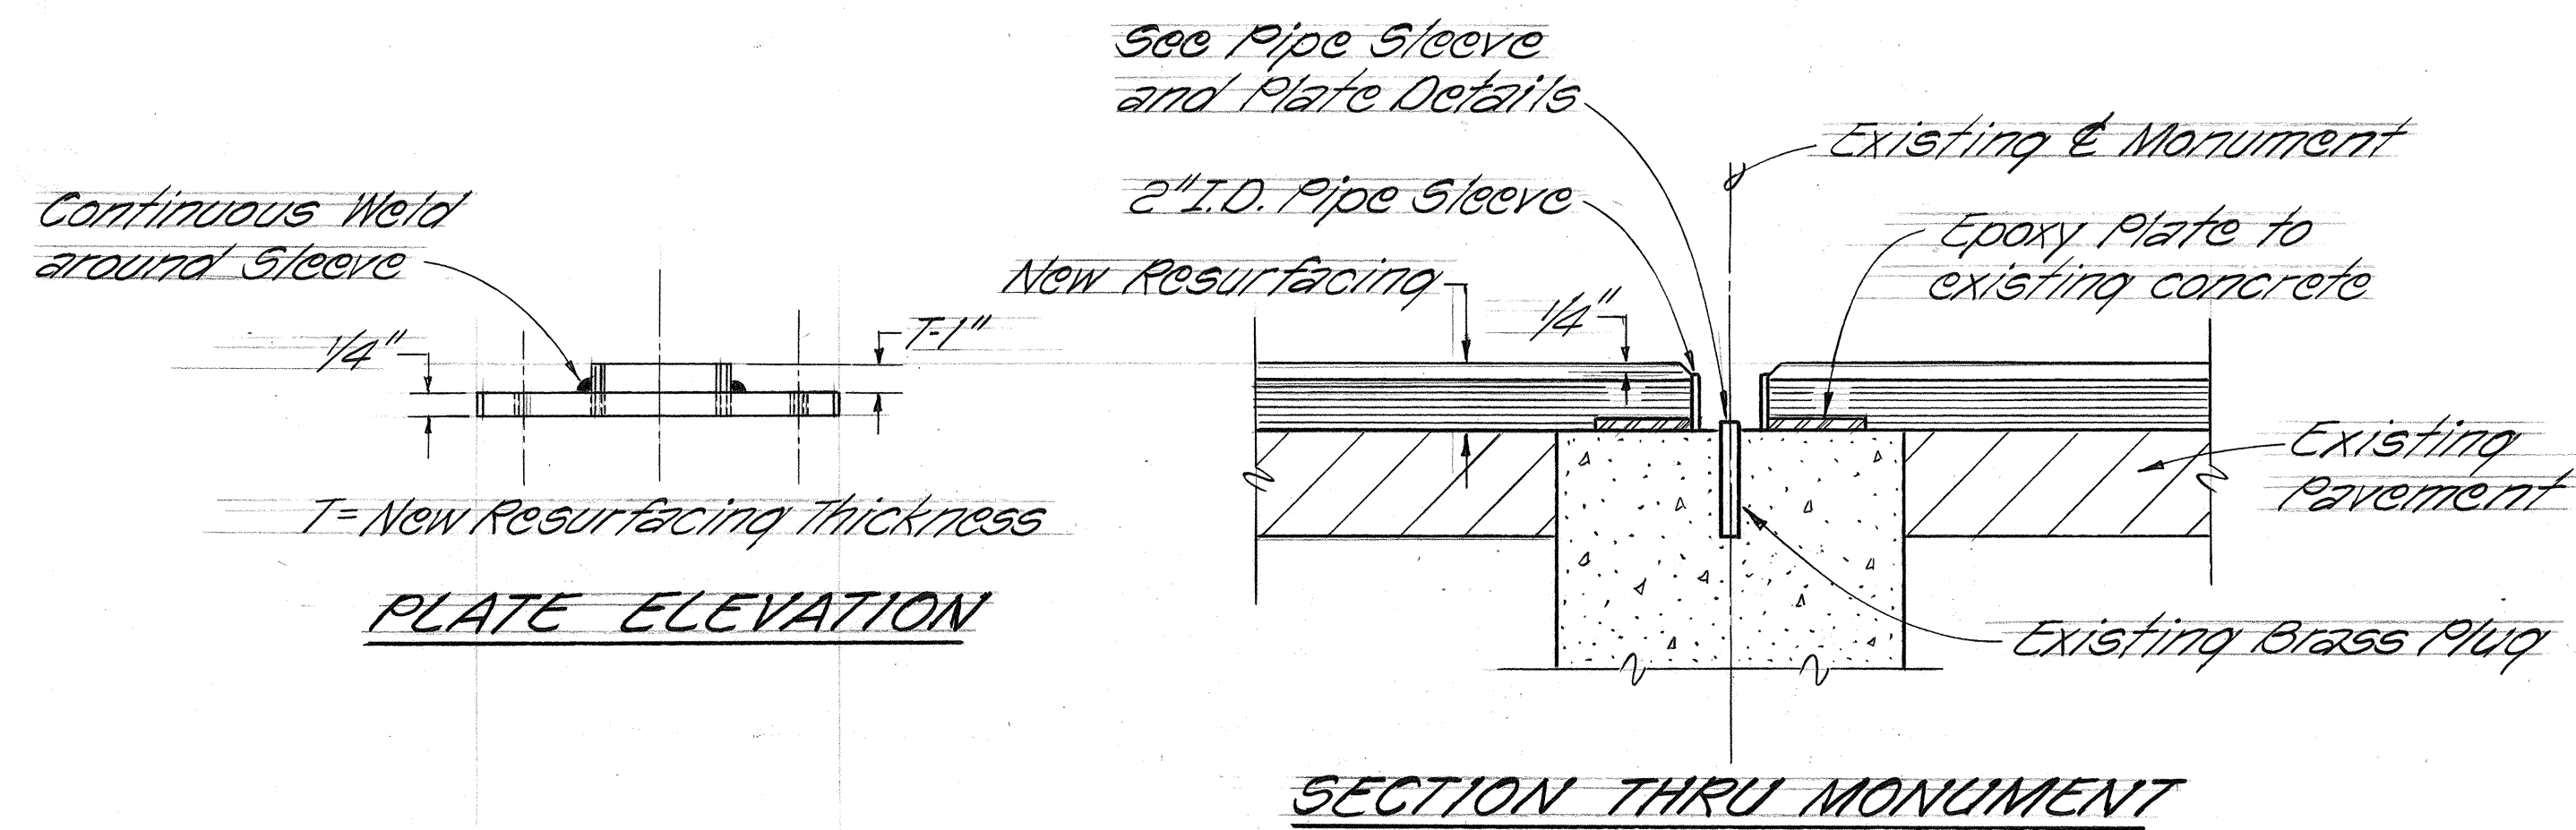

DETAILS FOR PRESERVING CENTERLINE MONUMENT Not to Scale

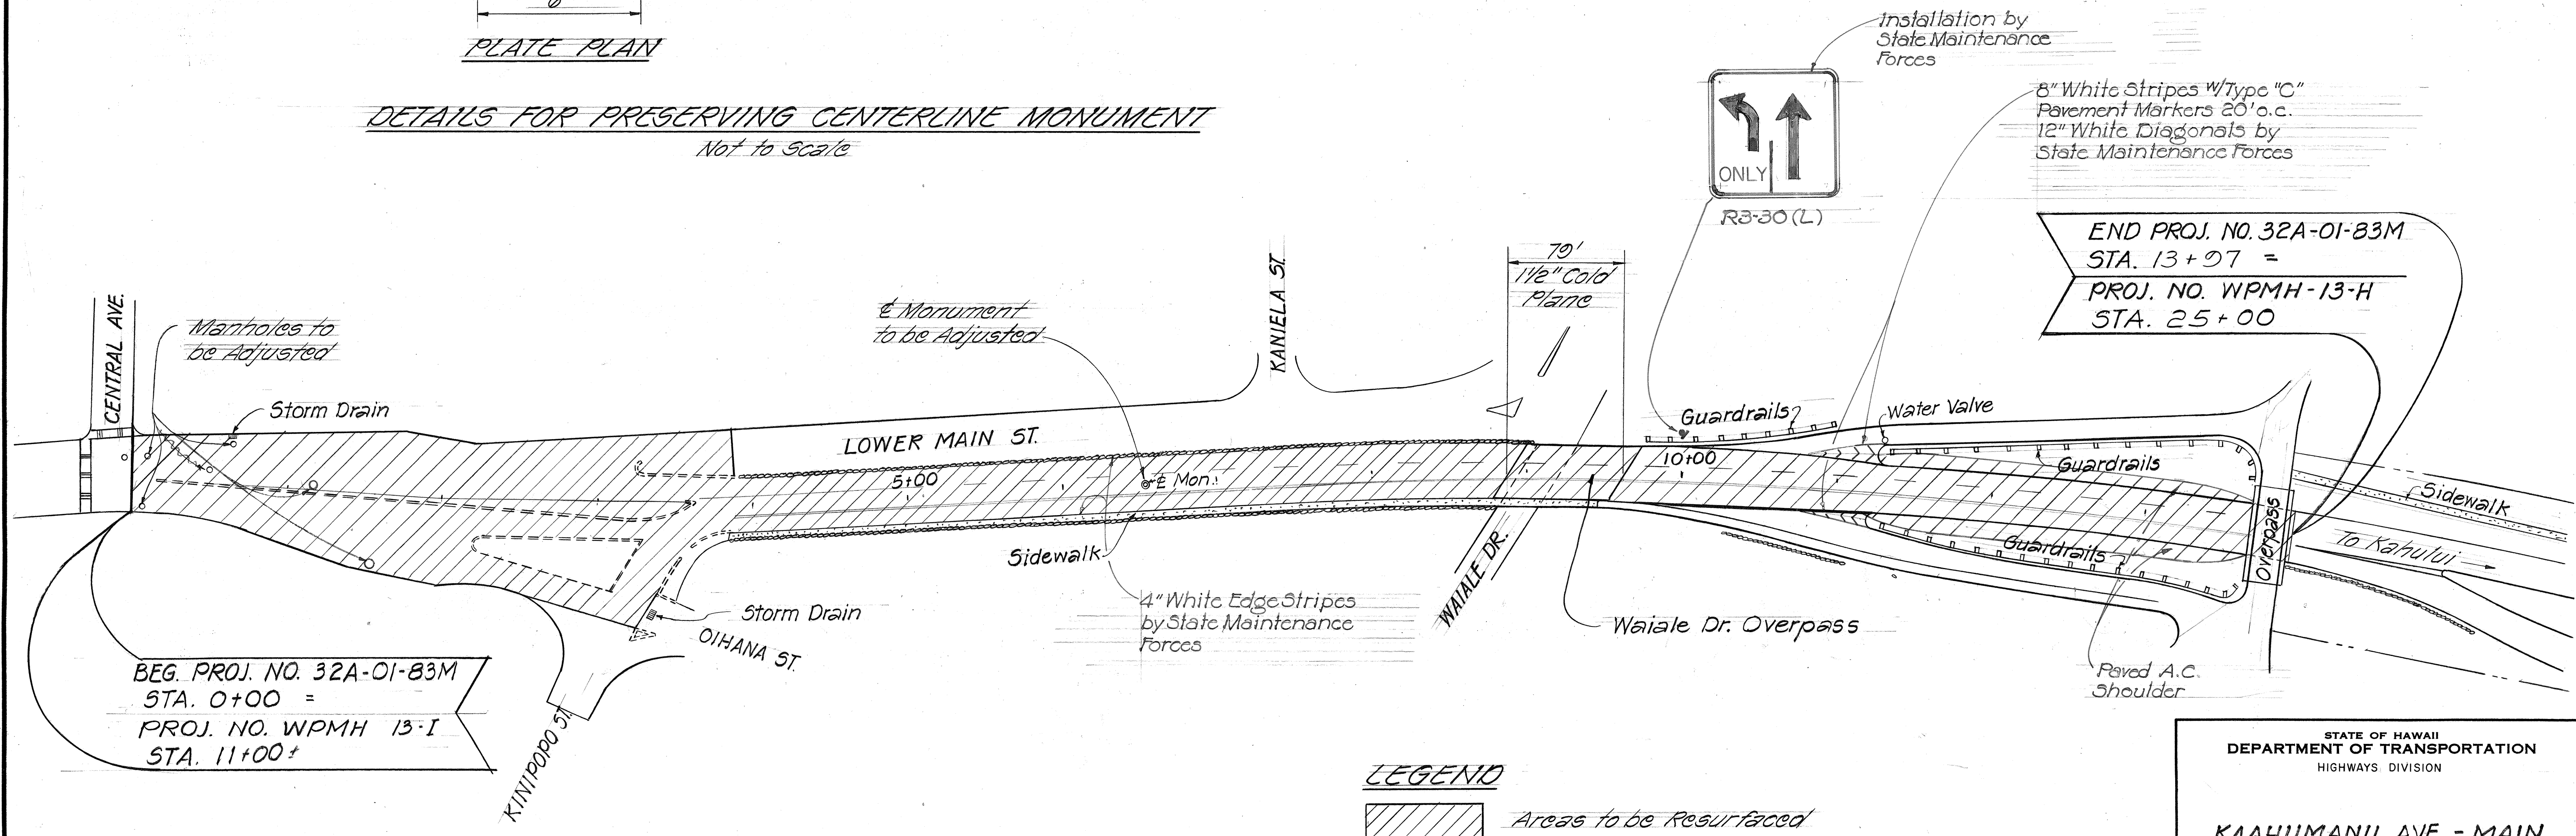

STATE OF HAWAII
DEPARTMENT OF TRANSPORTATION
HIGHWAYS DIVISION

KAAHUMANU AVE. - MAIN
STREET RESURFACING
(CENTRAL AVENUE TO UNDERPASS)
PROJ. NO. 32A-01-83M

SCALE: AS NOTED JUNE 1982

SHEET NO. 1 OF SHEETS