
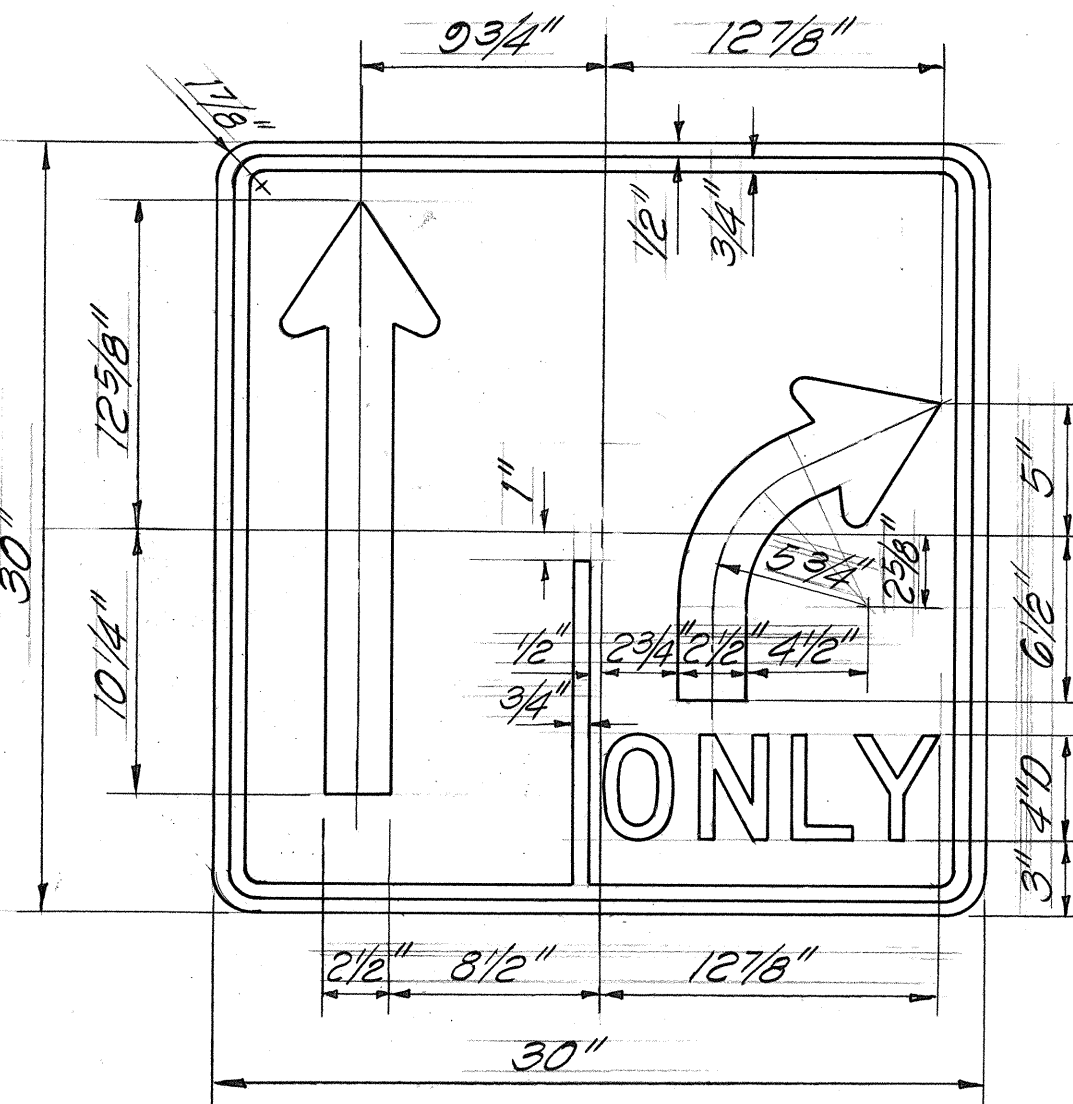


FED. ROAD DIST. NO.	STATE	PROJ. NO.	FISCAL YEAR	SHEET NO.	TOTAL SHEETS
HAWAII	HAW.	32A-01-83M	1983	4	11

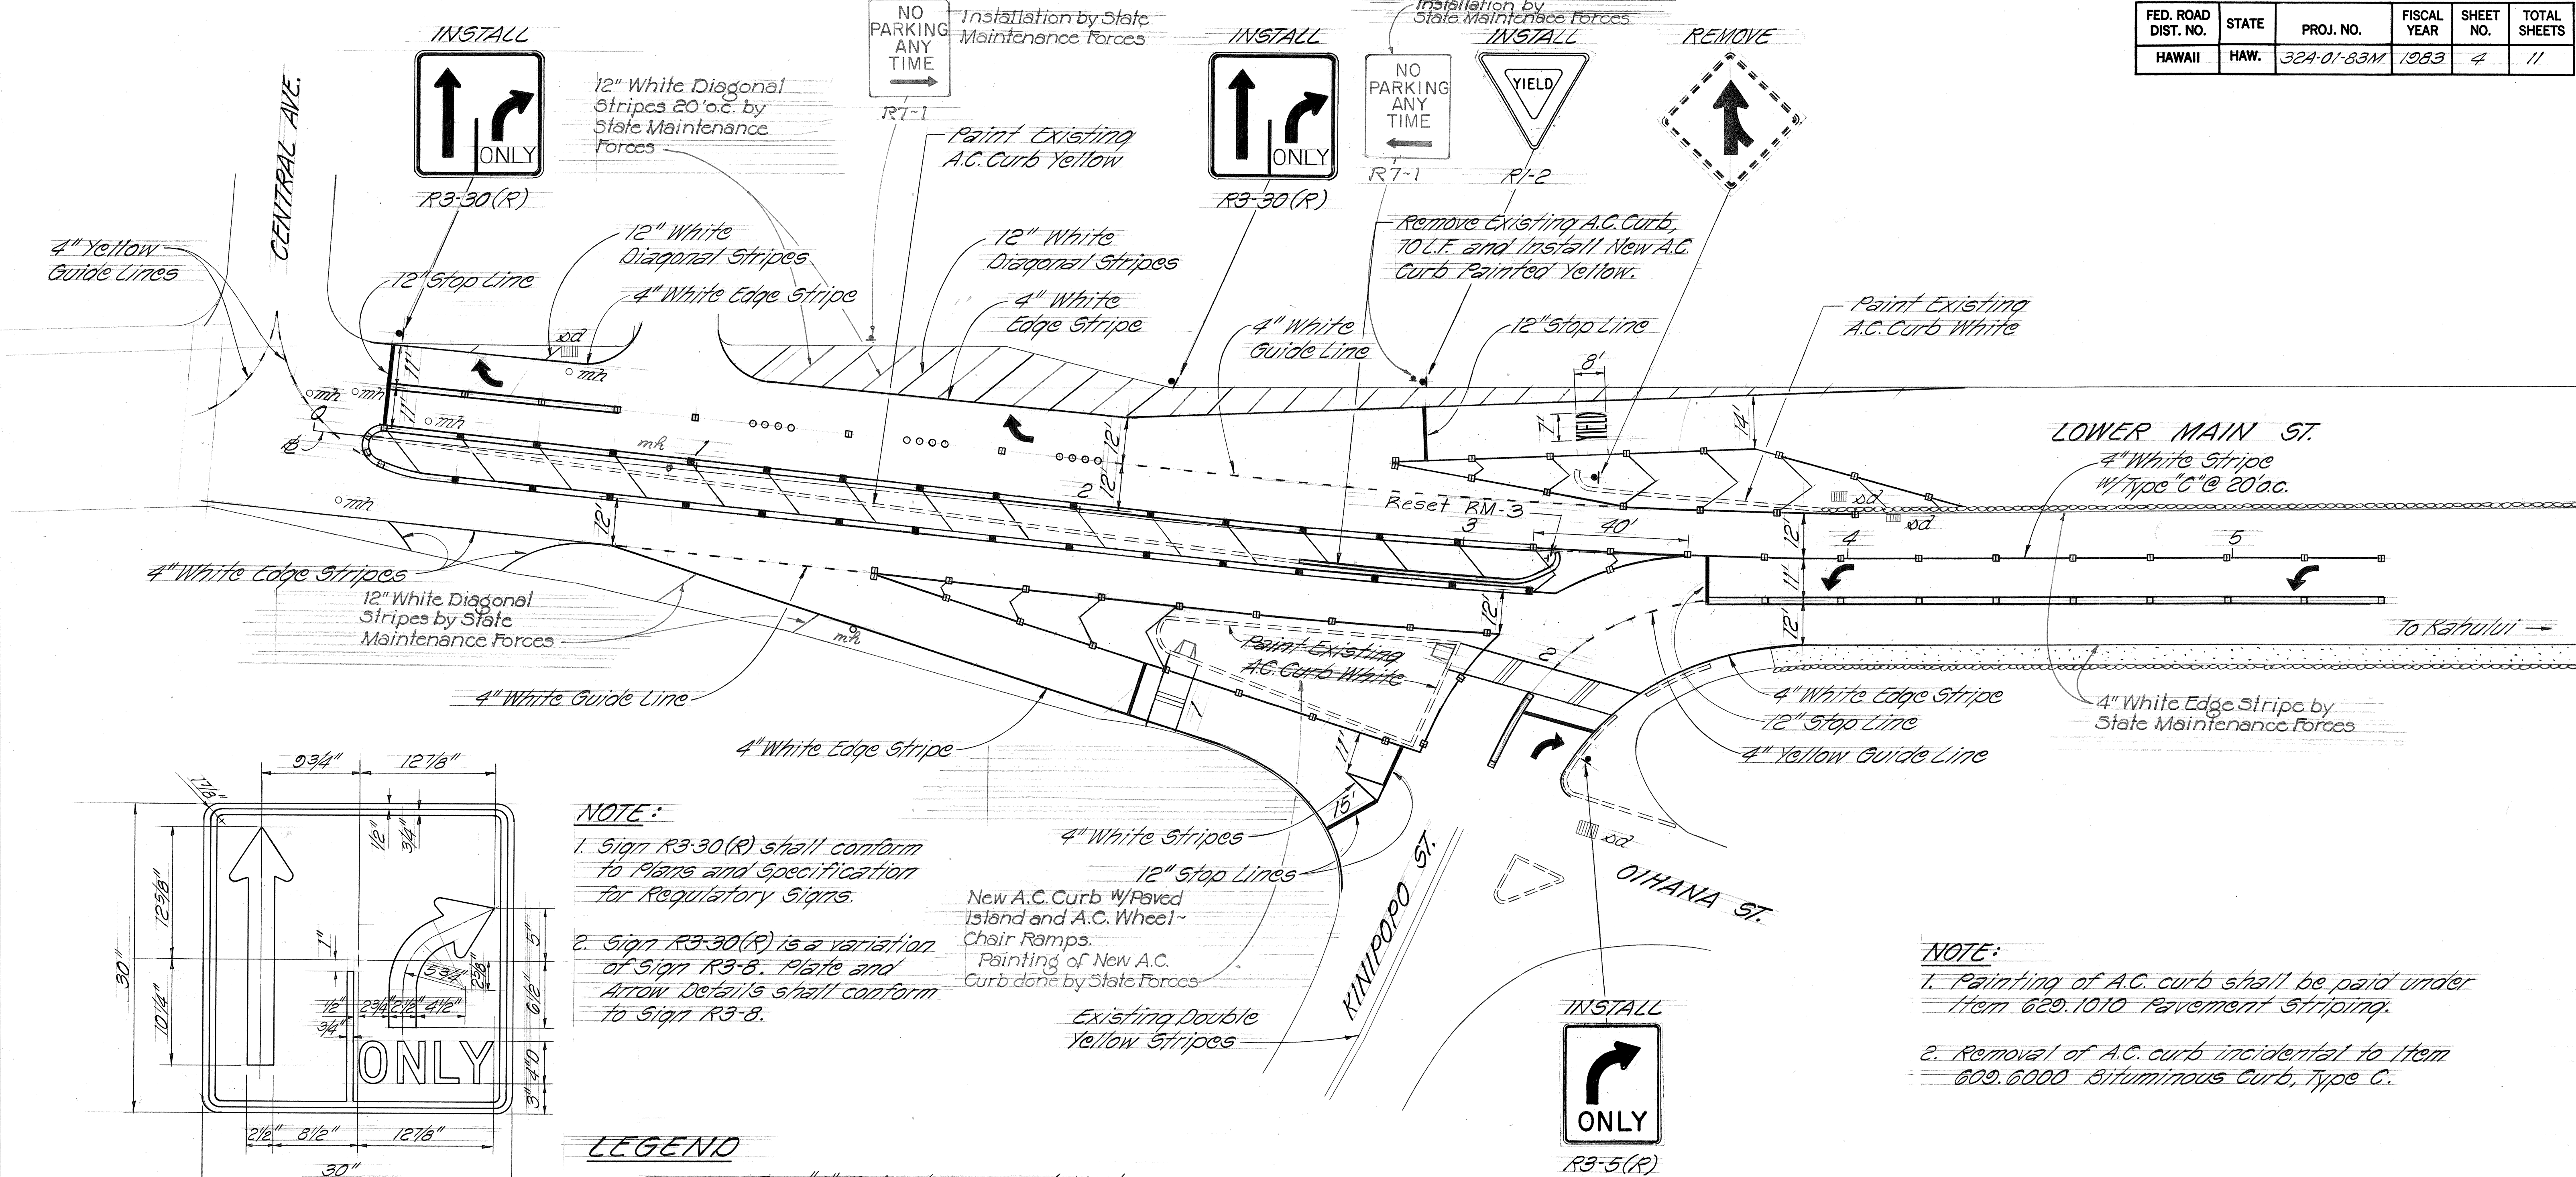

SIGN R3-30(R)
N.T.S.

LEGEND

- Type "A" Raised Pavement Marker
- Type "C" Raised Pavement Marker
- Type "D" Raised Pavement Marker
- Type "H" Raised Pavement Marker
- 8" Solid White
- 4" Double Yellow Stripes w/Type "C" Pavement Markers @ 20' o.c.
- 4" Double Yellow Stripes w/Type "D" Pavement Markers @ 20' o.c.
- 4" Double Yellow Stripes w/Type "H" Pavement Markers @ 20' o.c.
- and 12" Yellow Diagonal Stripes.
- 8" White Stripes w/Type "C" Pavement Markers @ 20' o.c.
- and 12" White Diagonal Stripes (Chevrans)
- Crosswalk and 12" Stop Line. Stop Line shall be 5' from crosswalks unless otherwise noted. Number indicates number of lanes.
- Pavement Arrow

STRIPING PLAN
Scale: 1"=20'

	TYPE "A" (Each)	TYPE "C" (Each)	TYPE "D" (Each)	TYPE "H" (Each)
STA. 0+00 TO STA. 5+30	12	53 52	75 10	29 34
STA. 5+30 TO STA. 13+97	88 30	22 21	44	0
TOTAL	100 102	75 73	59 54	29 34

STATE OF HAWAII
DEPARTMENT OF TRANSPORTATION
HIGHWAYS DIVISION

SIGNING AND PAVEMENT MARKING PLAN

KAAHUMANU AVE. - MAIN STREET RESURFACING (CENTRAL AVENUE TO UNDERPASS)

PROJ. NO. 32A-01-83M

SCALE: AS SHOWN JULY, 1982

SHEET NO. OF SHEETS

DATE	
SURVEY PLOTTED BY	
DRAWN BY	
DESIGNED BY	
CHECKED BY	
ORIGINAL PLAN	
NOTE BOOK	
No.	