|           | INDEX TO DRAWINGS        |
|-----------|--------------------------|
| SHEET NO. | DESCRIPTION              |
| l         | TITLE SHEET              |
| 2         | TYPICAL SECTION, DETAILS |
|           | & GENERAL NOTES          |
| 3         | ROADWAY PLAN             |
| 4         | STRIPING PLAN            |
| 5 - 11    | STANDARD DETAILS         |
|           | • ,                      |
|           |                          |
|           |                          |
|           | • ,                      |
|           |                          |




STATE OF HAWAII

DEPARTMENT OF TRANSPORTATION HIGHWAYS DIVISION

HONOLULU, HAWAII
"AS BUILT"
PLANS FOR

KAAHUMANU AVENUE - MAIN STREET RESURFACING (CENTRAL AVENUE TO UNDERPASS) PROJECT NO. 32A-01-83M

DISTRICT OF WAILUKU
ISLAND OF MAUI

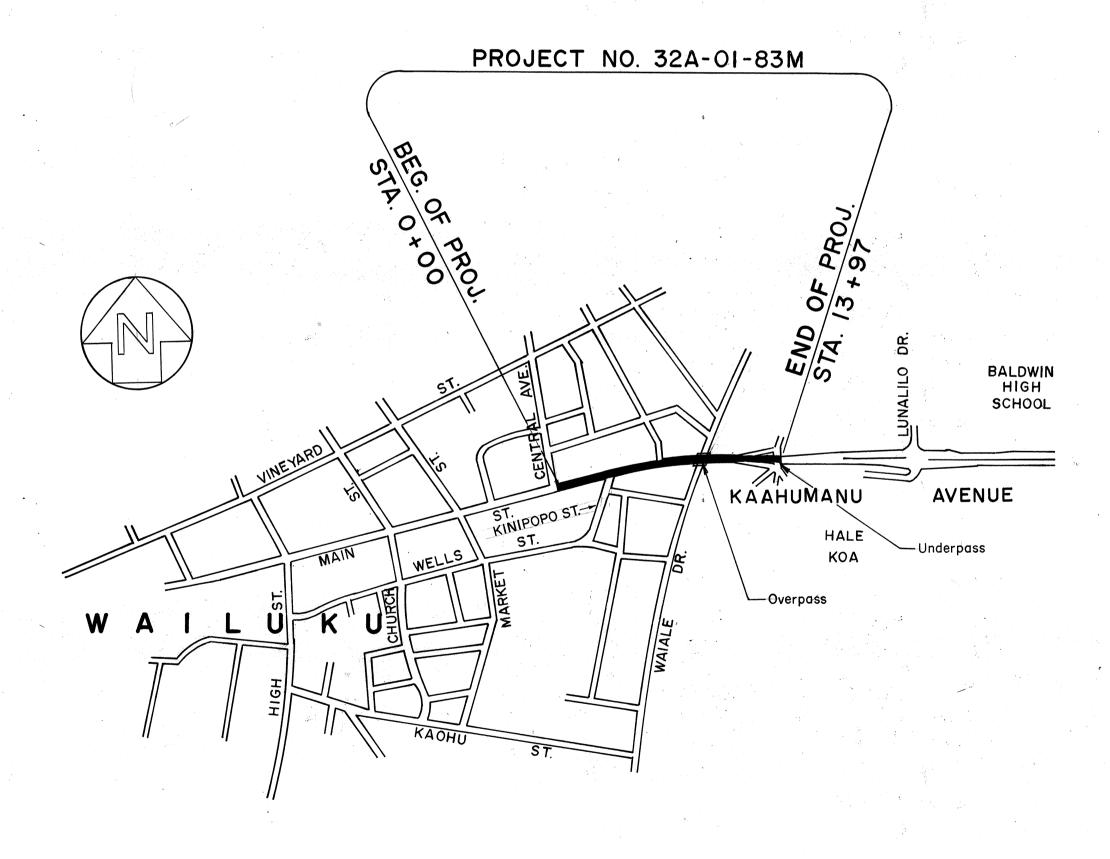


LAYOUT OF PROJECT

SCALE: |" = 600'

LENGTH OF PROJECT 0.265 MILE

FED. ROAD DIST. NO.

HAWAII HAW. 32A-OI-83M 1983 1 11

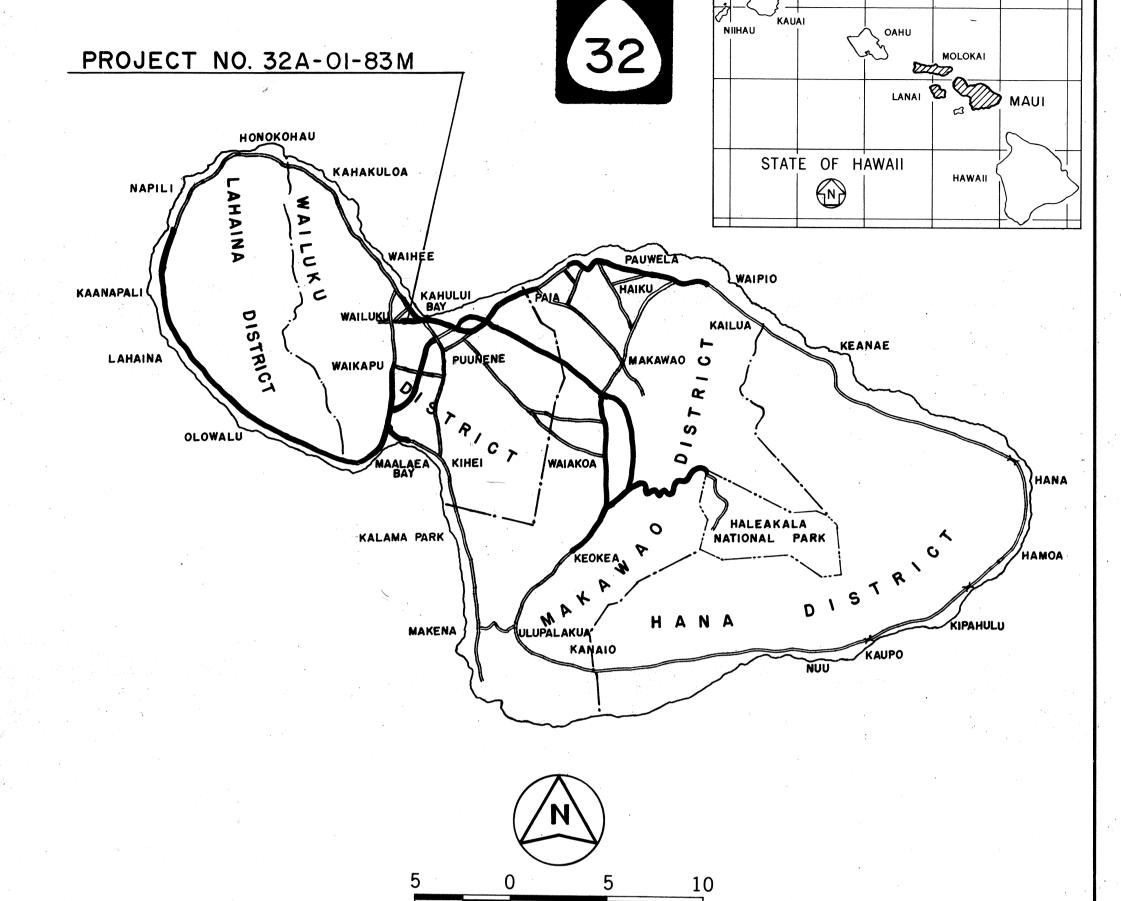

OR UNDER CONSTRUCTION

SCALE IN MILES

ALL CHANGES MADE DURING CONSTRUCTION HAVE BEEN INCORPORATED ON THESE PLANS IN RED EXCEPT CHANGES IN THE ORIGINAL THEORETICAL QUANTITIES, FOR ACTUAL QUANTITIES, REFER TO PROJECT LEDGER AND/OR COMPUTATION BOOK.

Cary Jamashita

RESIDENT ENGINEER

**4-22-83**DATE

DEPARTMENT OF TRANSPORTATION
STATE OF HAWAII

APPROVED:

OR. OF TRANSPORTATION
DATE

548-7534 PHONE

Maui District DESIGNED BY