· .					
INDEX TO DRAWINGS					
SHEET NO.	DESCRIPTION				
	TITLE SHEET				
2	LEGEND AND NOTES				
3-8	GEOMETRICS, STRIPING AND SIGNING PLAN				
9-14	TRAFFIC SIGNAL PLAN				
15	MISCELLANEOUS DETAILS				
16-17	TYPICAL DETAILS OF WHEELCHAIR RAMPS				
18 – 32	STANDARD DETAILS				
A Section 1					
) v					
:					



STATE OF HAWAII


DEPARTMENT OF TRANSPORTATION HIGHWAYS DIVISION


HONOLULU, HAWAII

"AS + BUILT"
PLANS FOR

## KAAHUMANU AVENUE TRAFFIC SIGNAL IMPROVEMENTS FEDERAL AID URBAN PROJECT NO. MG-0900(16)

DISTRICT OF WAILUKU
ISLAND OF MAUI

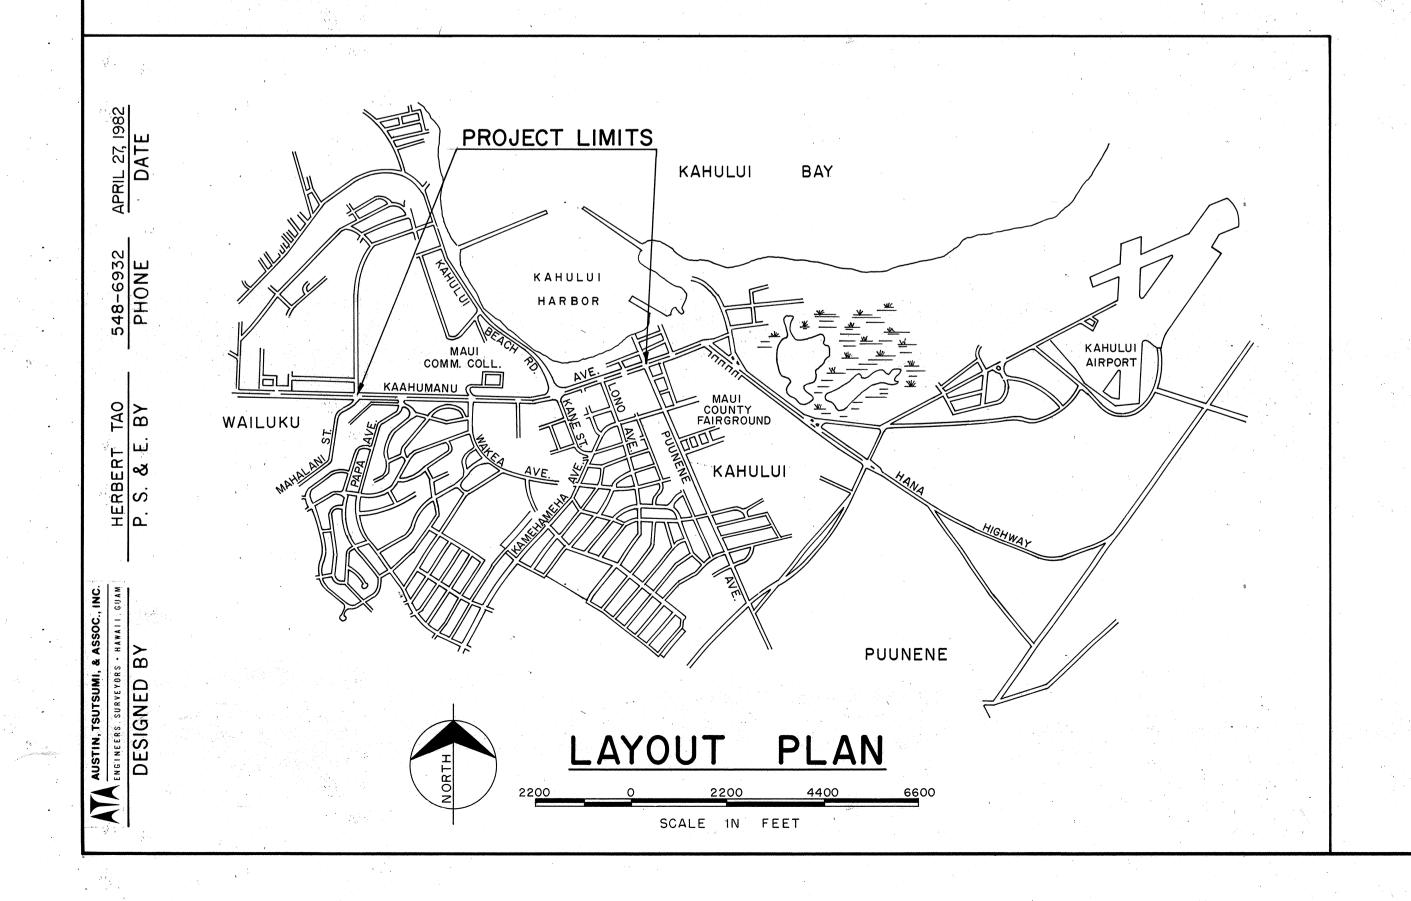

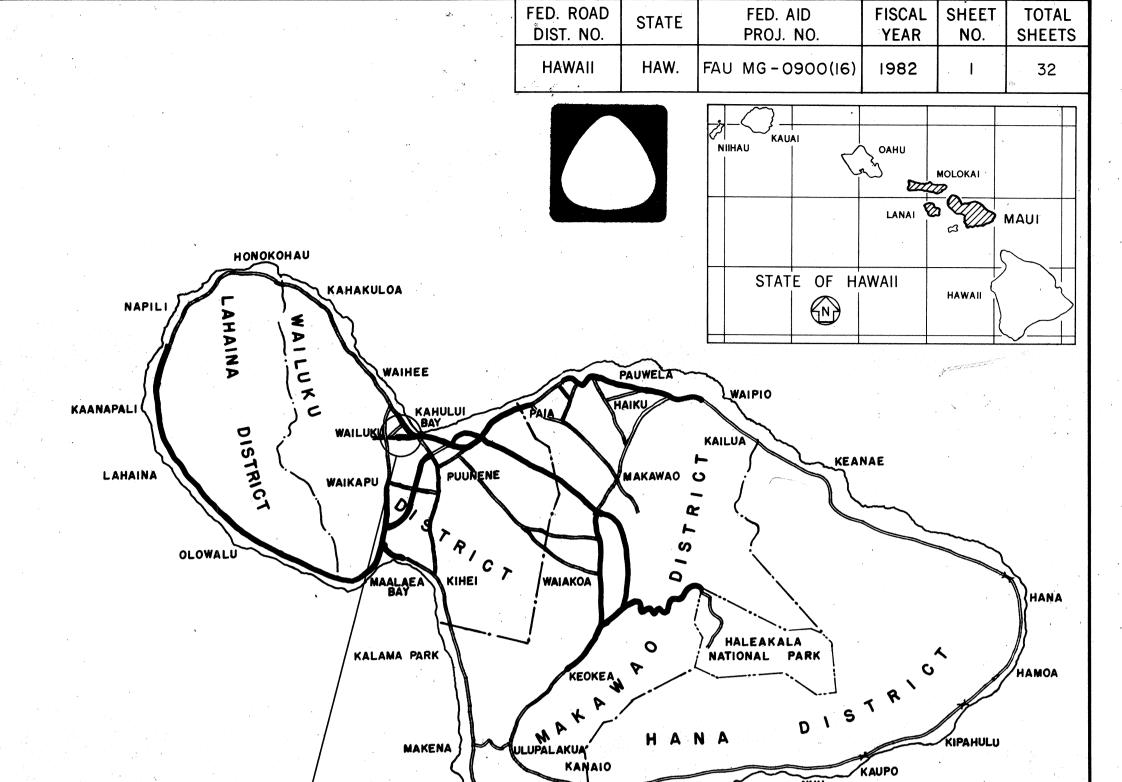

LOCATION OF PROJECT

FEDERAL AID PROJECTS PREVIOUSLY CONSTRUCTED OR UNDER CONSTRUCTION

CHANGES MADE DURING CONSTRUCTION HAVE BEEN INCORPORATED ON THESE PLANS EXCEPT CHANGES IN THE ORIGINAL THEORETICAL QUANTITIES, FOR ACTUAL QUANTITIES, REFER TO PROJECT LEDGER AND/OR COMPUTATION BOOK.

Cary Yamashita RESIDENT ENGINEER

**4-25-84** DATE

## DESIGN CLASSIFICATION

ADT (1980)	*	ν	30,500
DESIGN ADT (2000)		,	50,200
DHV			4,270
K			8.5%
<b>D</b>			50/50
Τ .		•	2.5%
T <sub>24</sub>			3.0%

DEPARTMENT OF TRANSPORTATION
FEDERAL HIGHWAY ADMINISTRATION
APPROVED:
7/29/82

L-DIVISION ADMINISTRATOR

DEPARTMENT OF TRANSPORTATION
STATE OF HAWAII

APPROVED:

Cyolick, Higashionna Inne 28,82

DIR. OF TRANSPORTATION DATE