

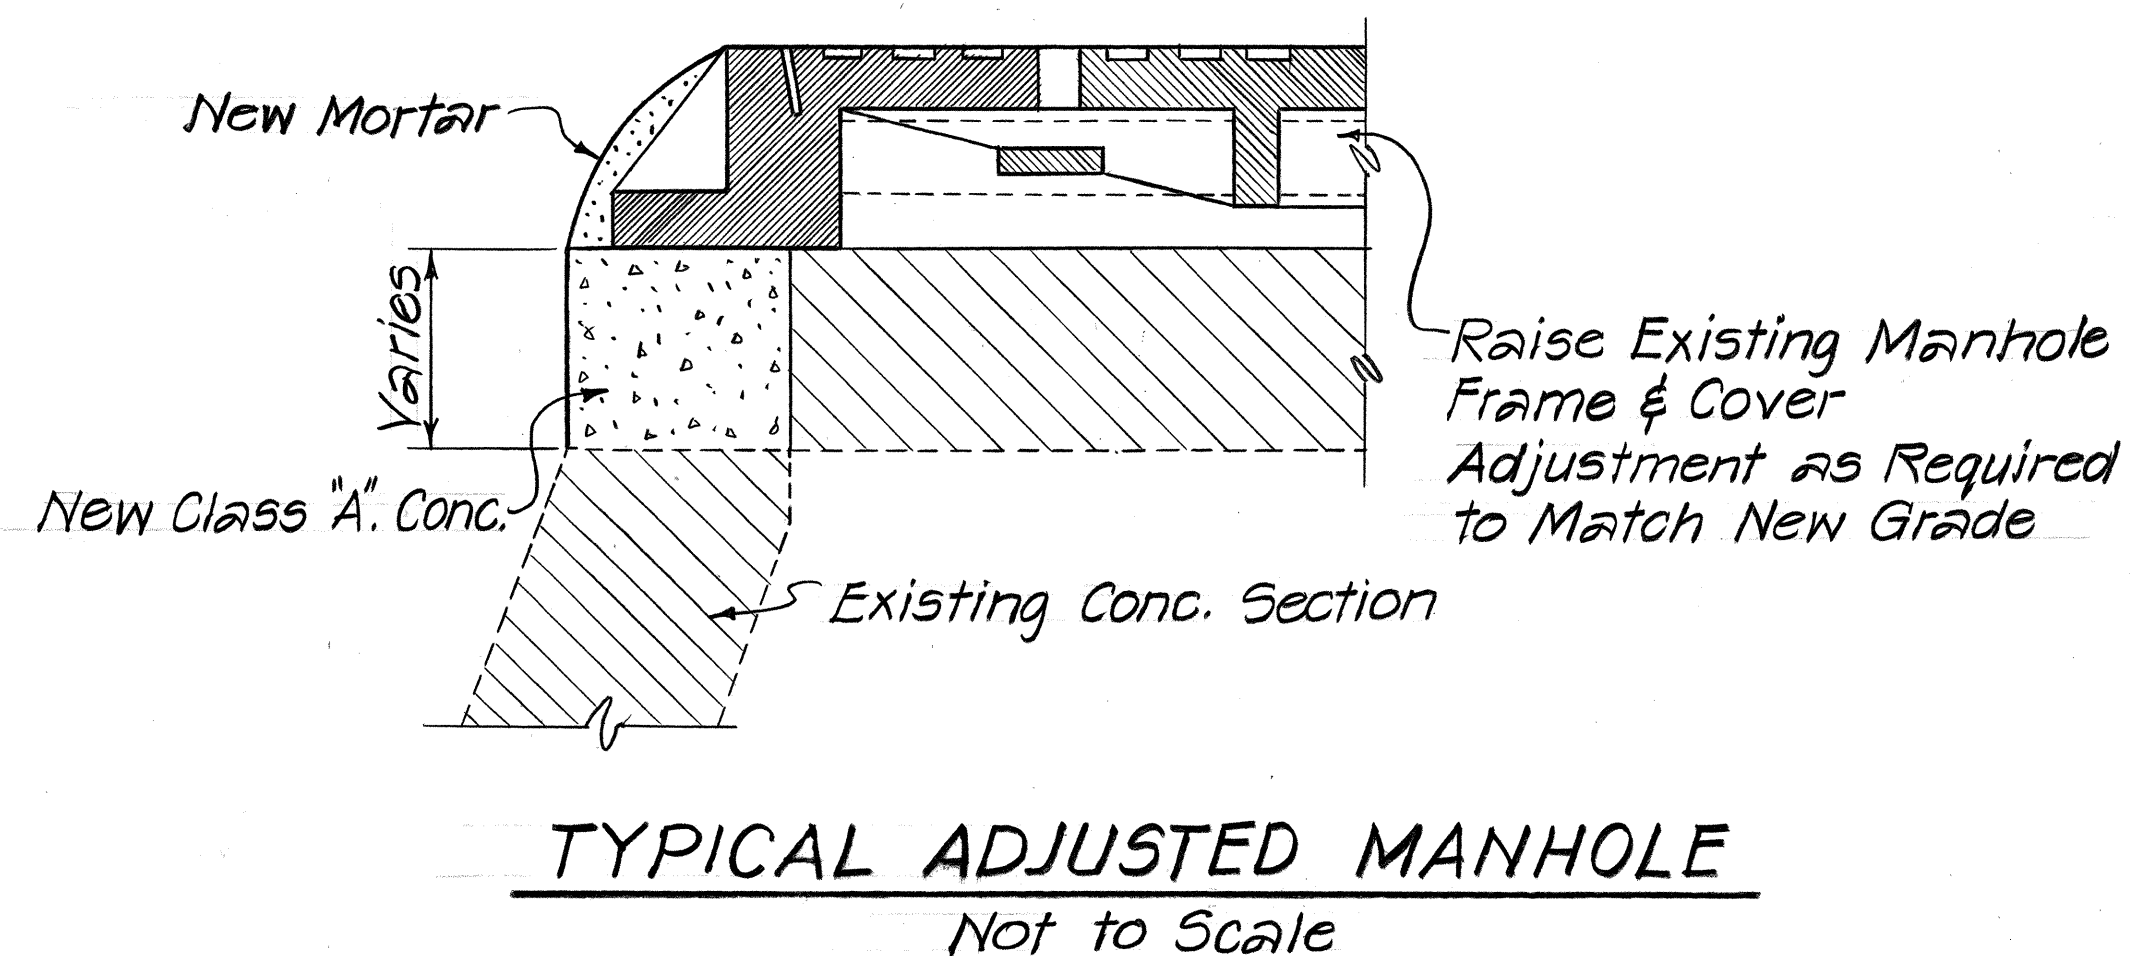
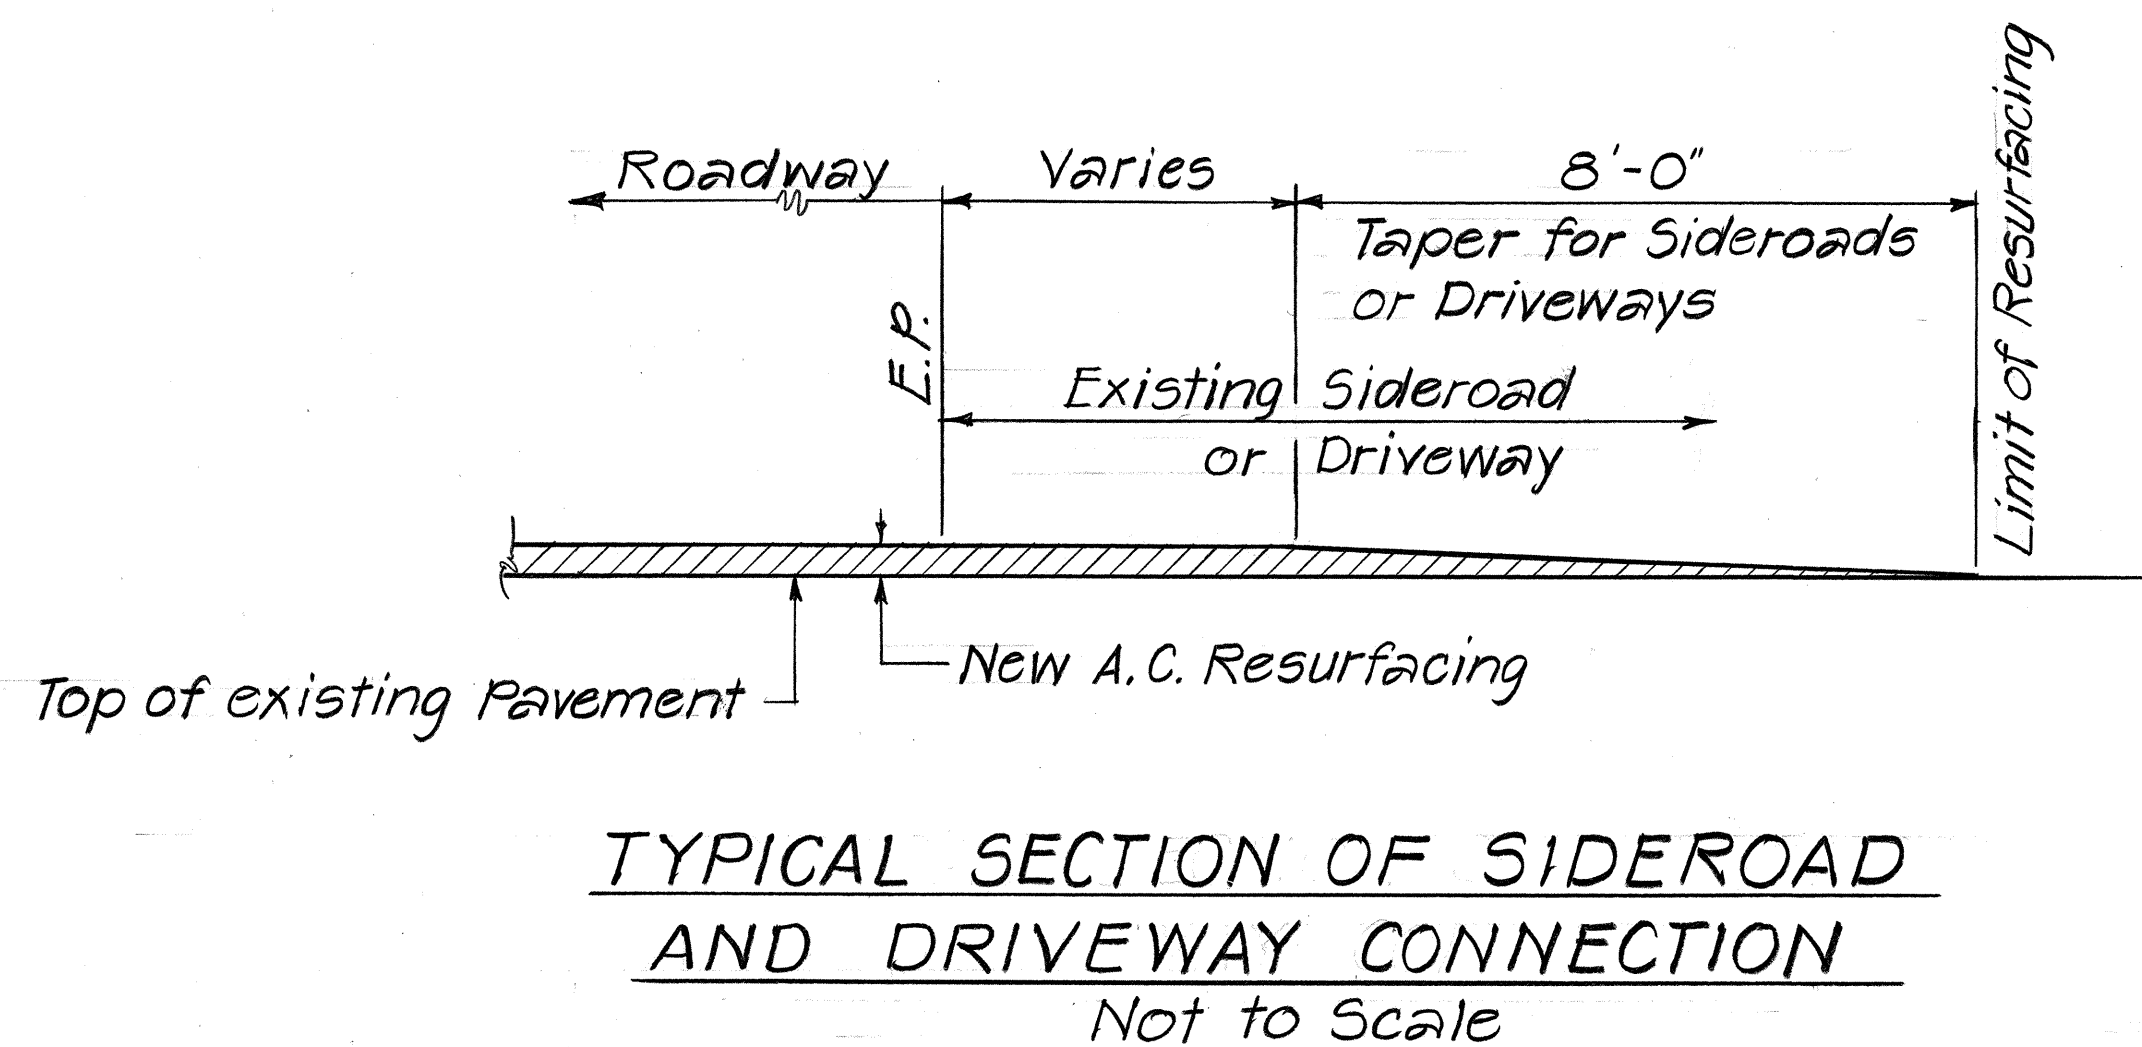
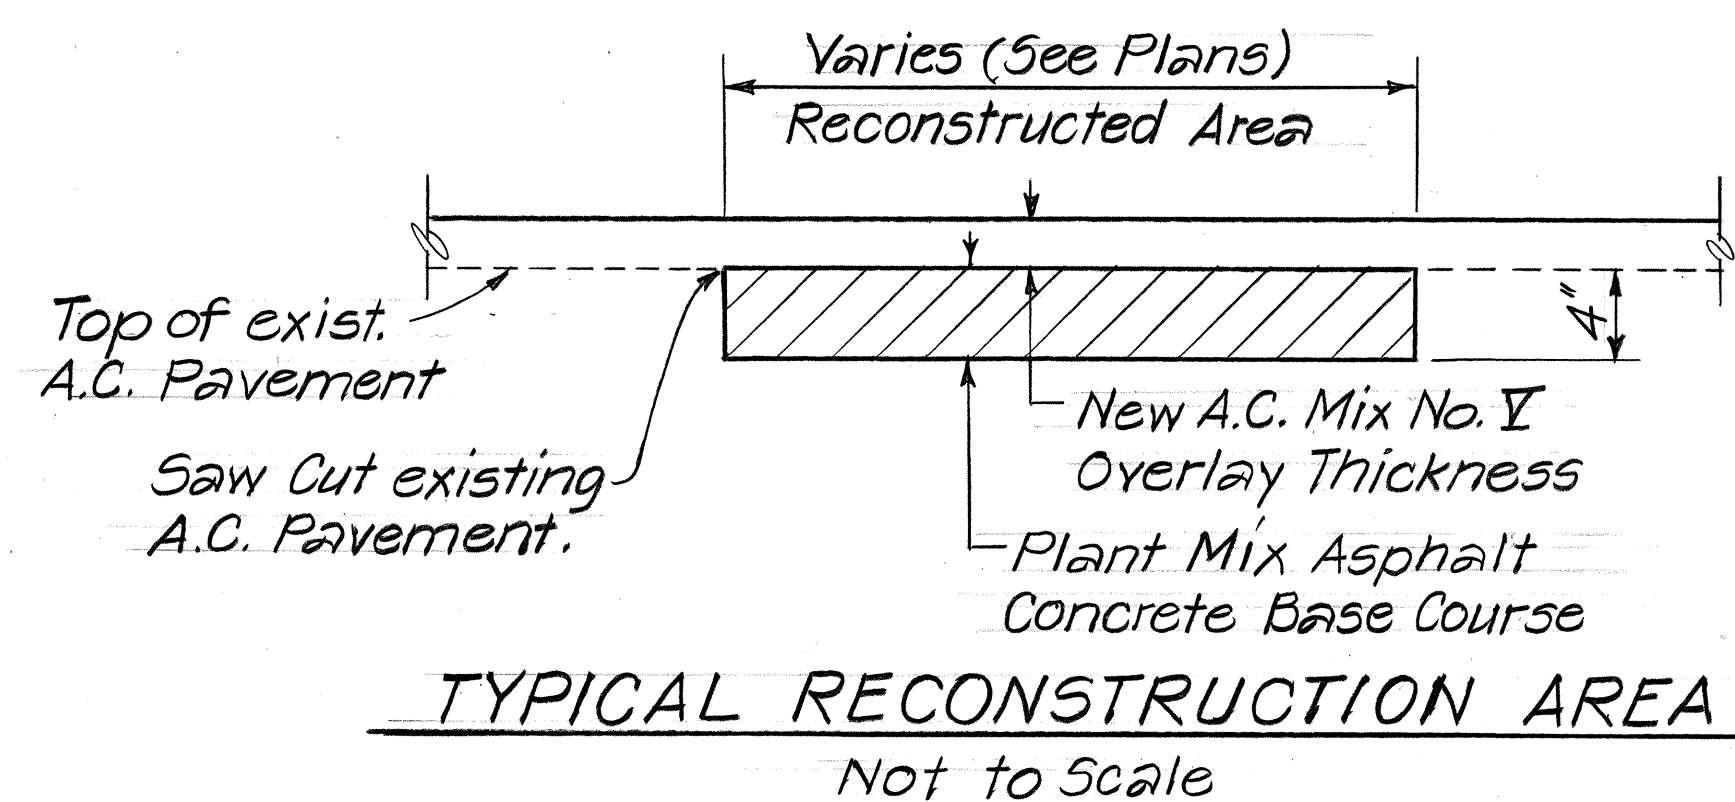
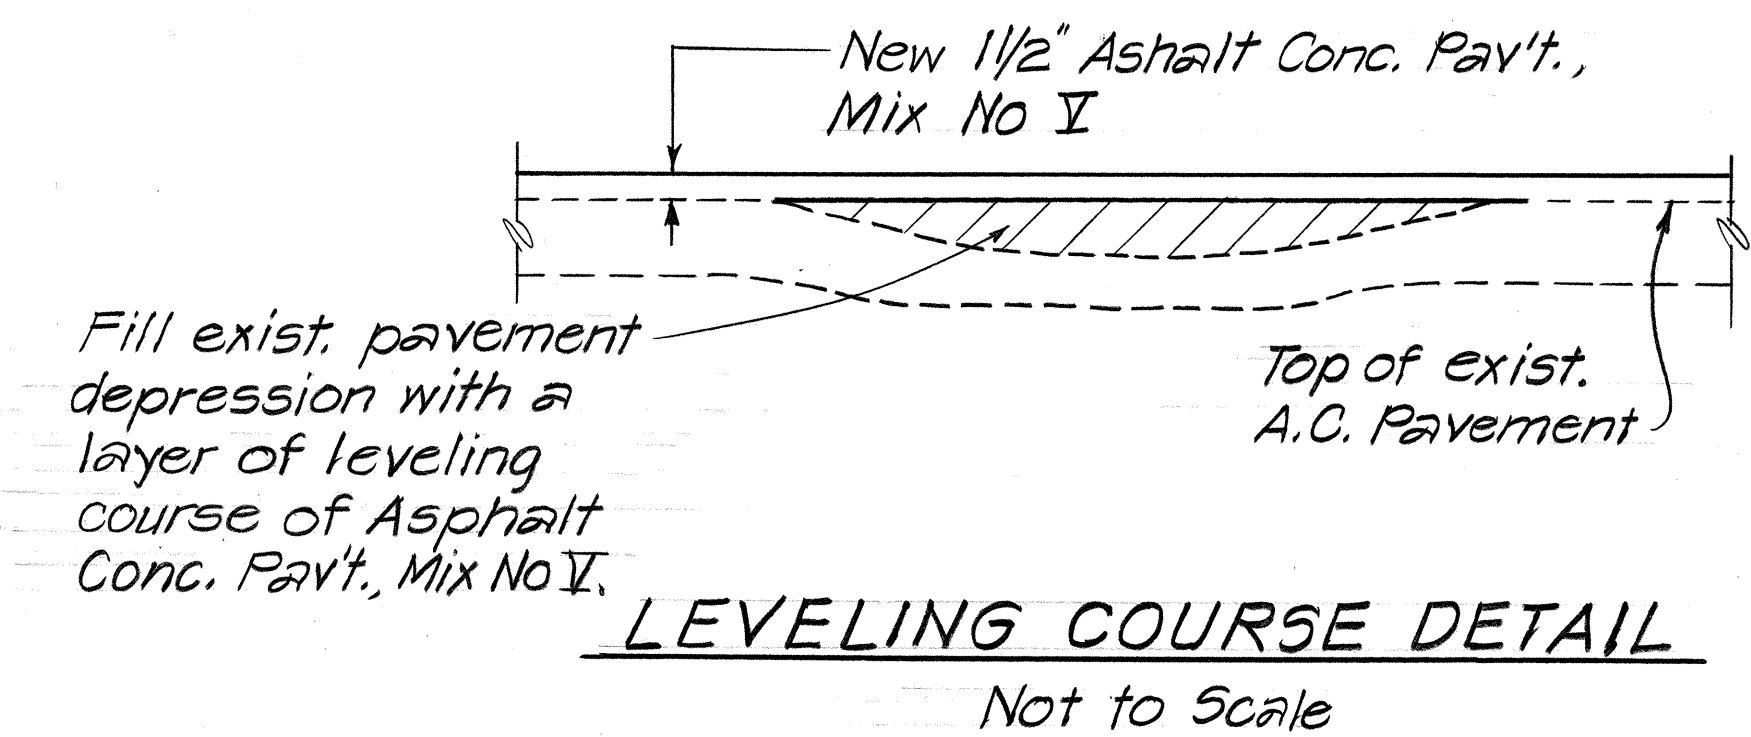


FED. ROAD DIST. NO.	STATE	PROJ. NO.	FISCAL YEAR	SHEET NO.	TOTAL SHEETS
HAWAII	HAW.	32A-01-89M	1989	5	13

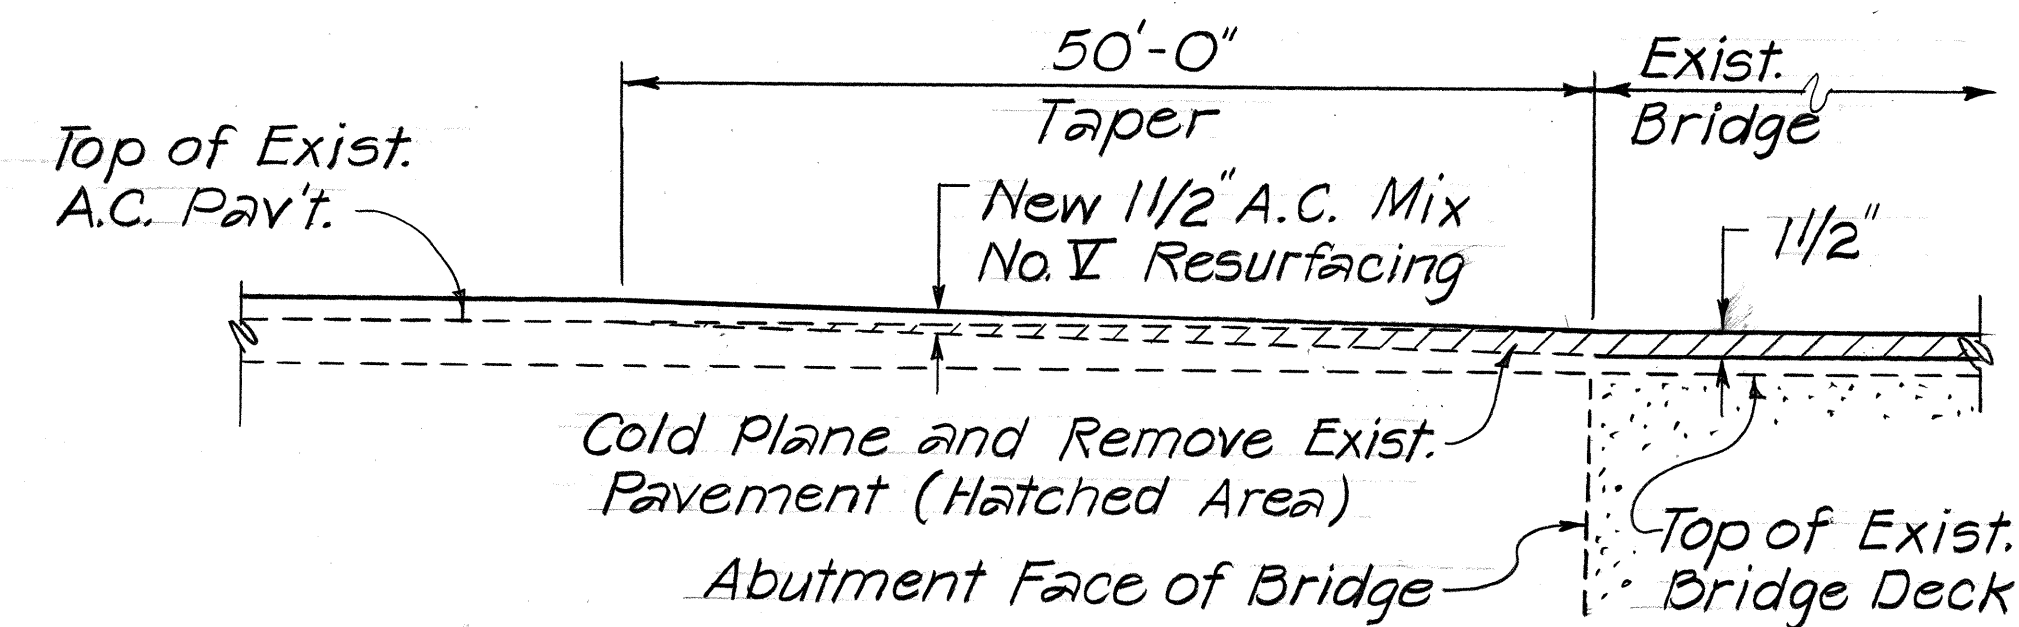

Cold Plane Existing Bridge
See Below for Details

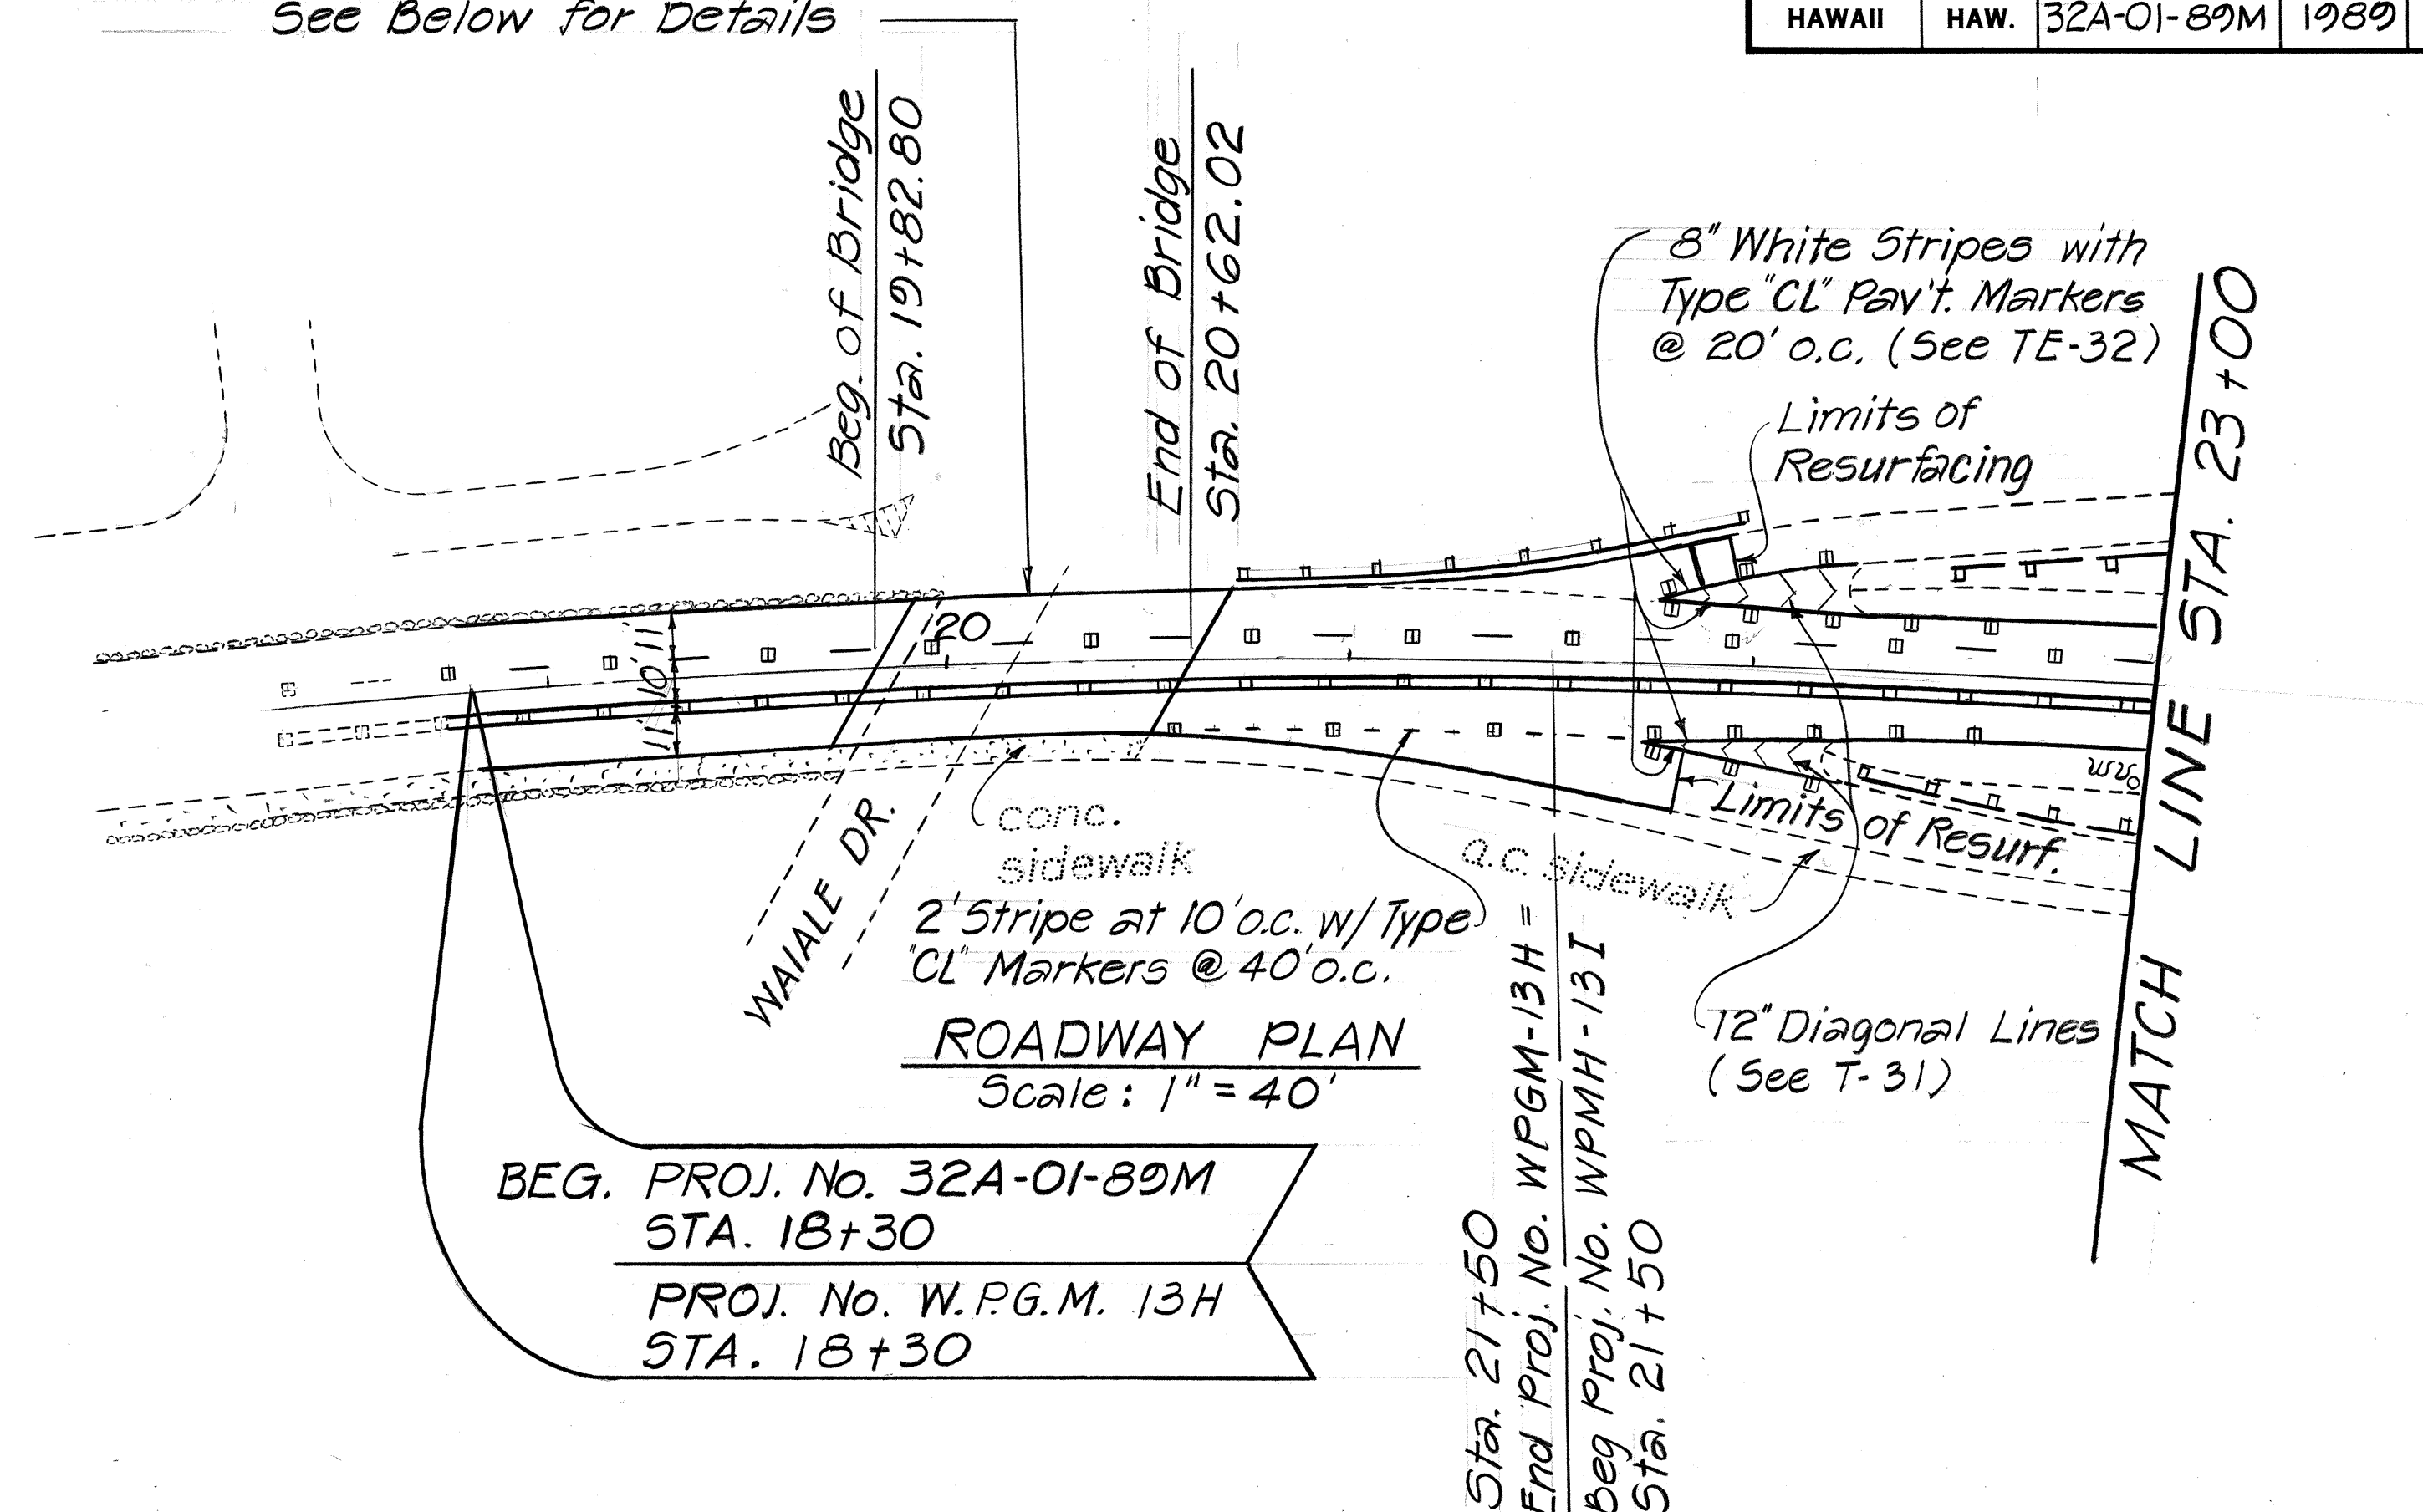

TYPICAL DETAIL AT WAI'ALE BRIDGE
Not to Scale

STATE OF HAWAII DEPARTMENT OF TRANSPORTATION HIGHWAYS DIVISION	
ROADWAY and STRIPING PLAN- TYPICAL DETAILS	
KAAHUMANU AVE. RESURFACING MAIN ST. TO HOBRON AVE. PROJECT NO. 32A-01-89M	
SCALE: AS NOTED	DATE: AUG 1988
SHEET NO. 1 OF 7 SHEETS	