

INDEX TO DRAWINGS	
SHEET NO.	DESCRIPTION
1	TITLE SHEET
2	STANDARD PLANS SUMMARY
3	GENERAL & UTILITY NOTES
4	TYPICAL SECTIONS
5	ROADWAY PLAN & TYP. DETAILS
6-II	ROADWAY PLANS & PAVEMENT MARKINGS
12	PAVEMENT MARKING LEGEND & SIGN DETAILS
13	GEOMETRICS, STRIPING & SIGNING PLAN FOR KAAHUMANU AVE. - WHARF ST. INTERSECTION

STATE OF HAWAII

DEPARTMENT OF TRANSPORTATION

HIGHWAYS DIVISION

HONOLULU, HAWAII

"AS-BUILT" PLANS FOR

KAAHUMANU AVENUE RESURFACING

MAIN STREET TO HOBRON AVENUE




PROJECT NO. 32A-01-89M

DISTRICT OF WAILUKU

COUNTY OF MAUI


ISLAND OF MAUI

FED. ROAD DIST. NO.	STATE	PROJ. NO.	FISCAL YEAR	SHEET NO.	TOTAL SHEETS
HAWAII	HAW.	32A-01-89M	1989	1	13

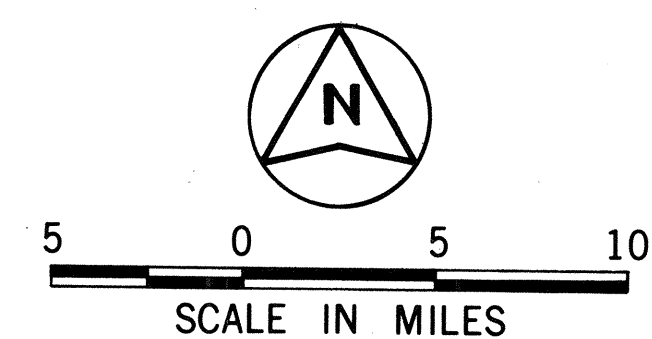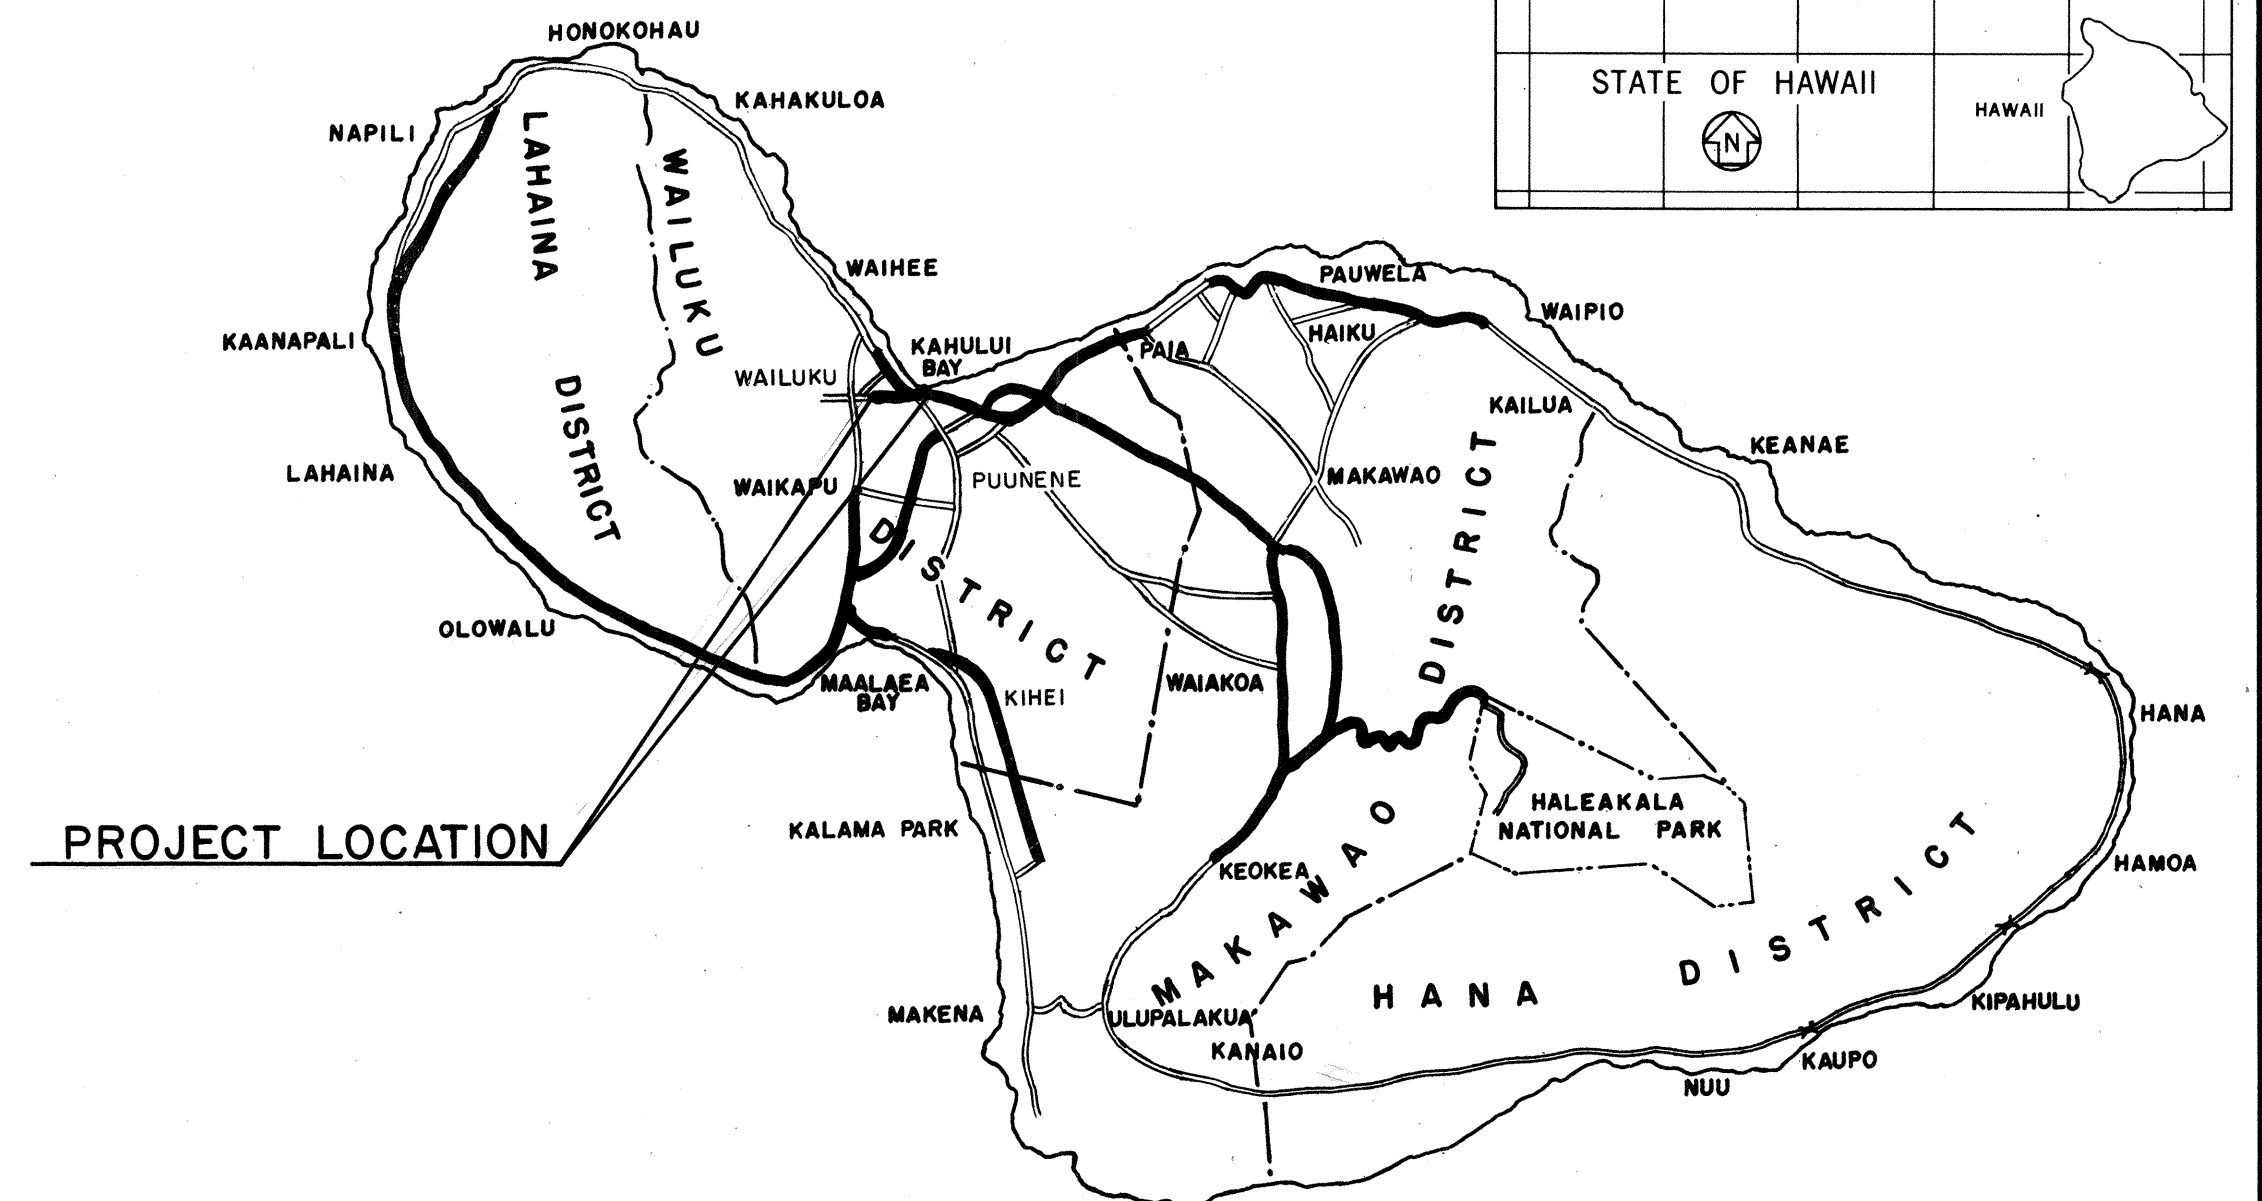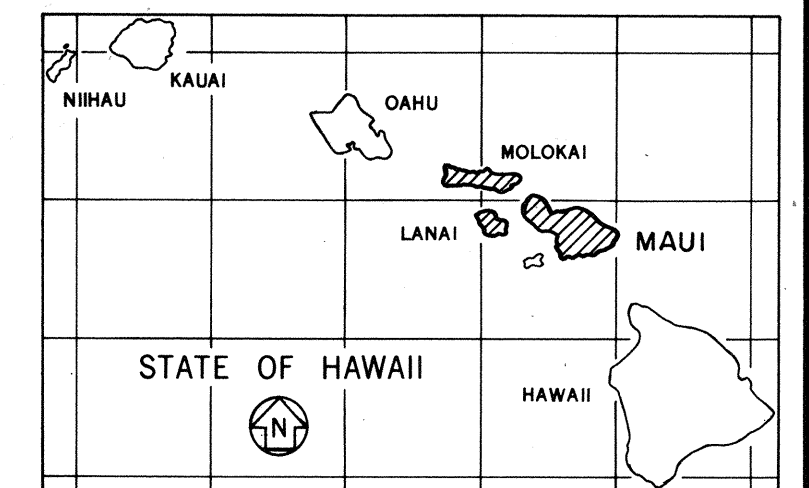


FEDERAL AID PROJECTS PREVIOUSLY CONSTRUCTED OR UNDER CONSTRUCTION

PROJECT NO. 32A-01-89M

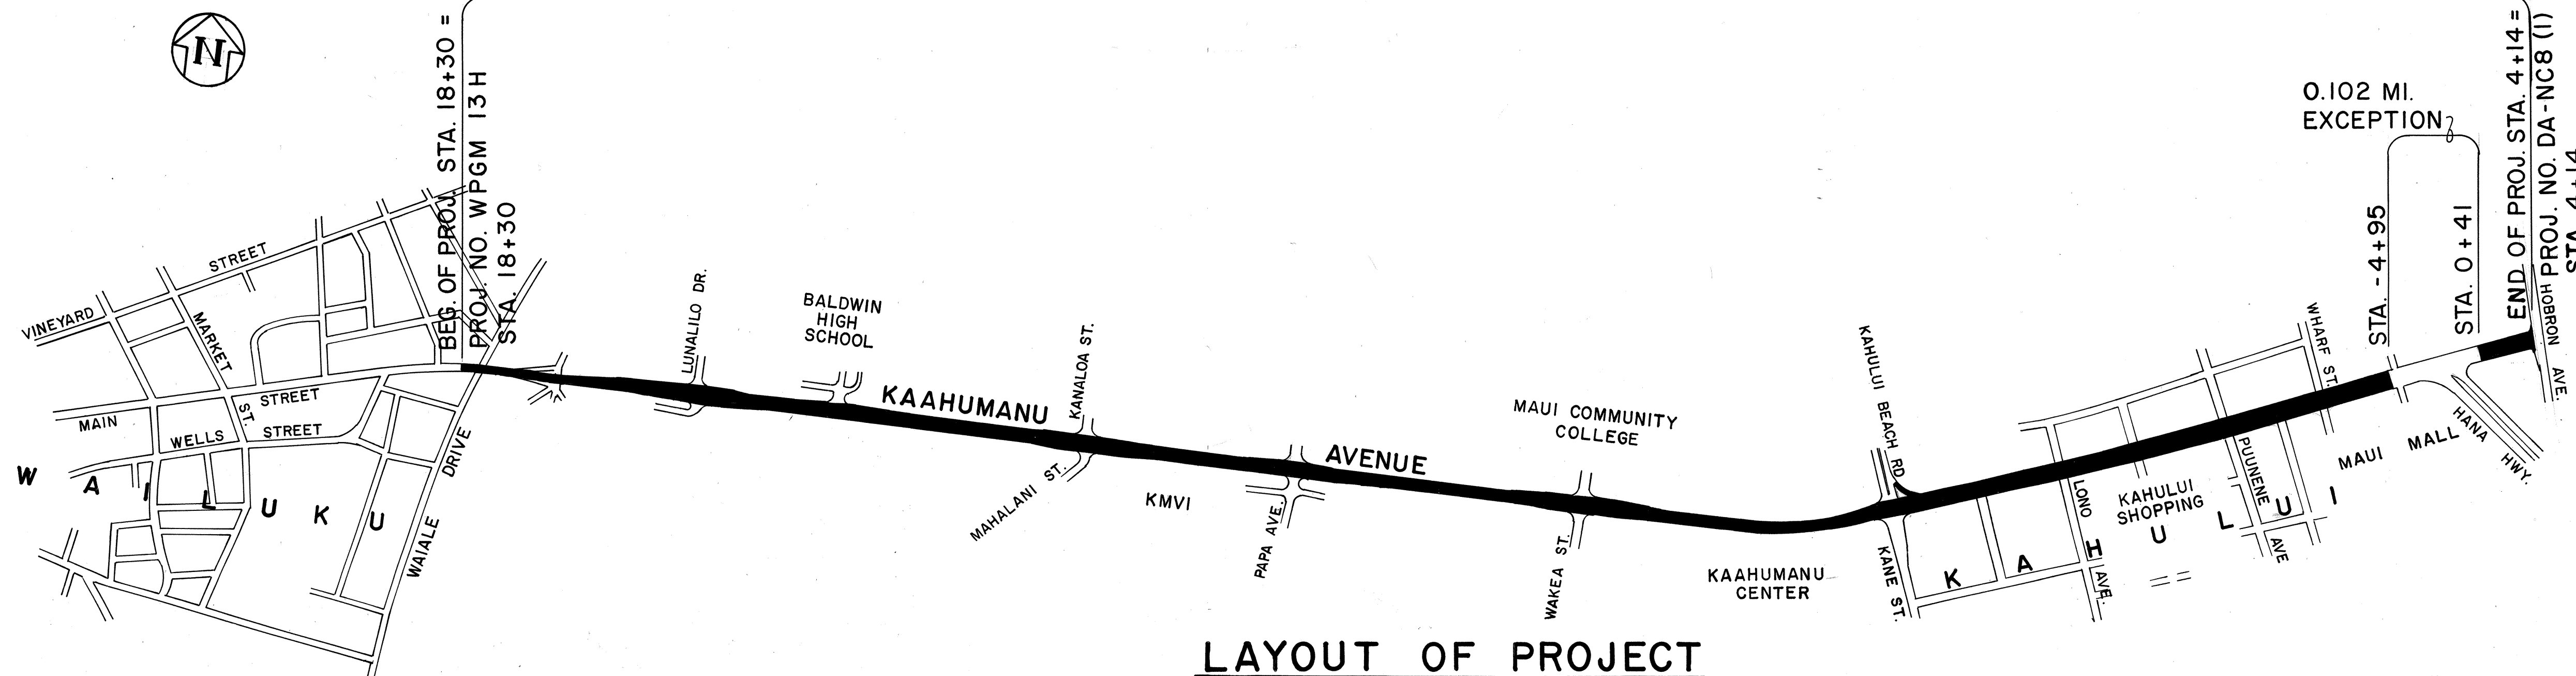

LAYOUT OF PROJECT

SCALE: 1" = 600'	
GROSS LENGTH OF PROJECT	2.371 MI.
EXCEPTION	0.102 MI.
NET LENGTH OF PROJECT	2.269 MI.
M. P. 0.468 TO M. P. 2.839	

CHANGES MADE DURING CONSTRUCTION HAVE BEEN INCORPORATED ON THESE PLANS EXCEPT CHANGES IN THE ORIGINAL THEORETICAL QUANTITIES. FOR ACTUAL QUANTITIES, REFER TO PROJECT LEDGER AND/OR COMPUTATION BOOK.

Michael Downing 9-29-93
 RESIDENT ENGINEER DATE

DEPARTMENT OF TRANSPORTATION STATE OF HAWAII	
APPROVED:	
<i>Edward J. ...</i>	5/20/89
DIR. OF TRANSPORTATION	DATE

MAUI DISTRICT A. NISHIMURA 548-7490 MAY, 1989
 DESIGNED BY P. S. & E. BY PHONE DATE