	INDEX TO DRAWINGS
SHEET NO.	DESCRIPTION
1	TITLE SHEET
2	STANDARD PLANS SUMMARY
3	LEGEND, GENERAL NOTES, AND PAVEMENT MARKING DETAILS
4	ROADWAY PLAN AND MISCELLANEOUS DETAILS
·	

STATE OF HAWAII

## DEPARTMENT OF TRANSPORTATION

HIGHWAYS DIVISION HONOLULU, HAWAII


"AS-BUILT"

PLANS FOR

## KAAHUMANU AVENUE

LEFT TURN ONTO MAHALANI STREET PROJECT NO. 32A-01-93M

DISTRICT OF WAILUKU ISLAND OF MAUI

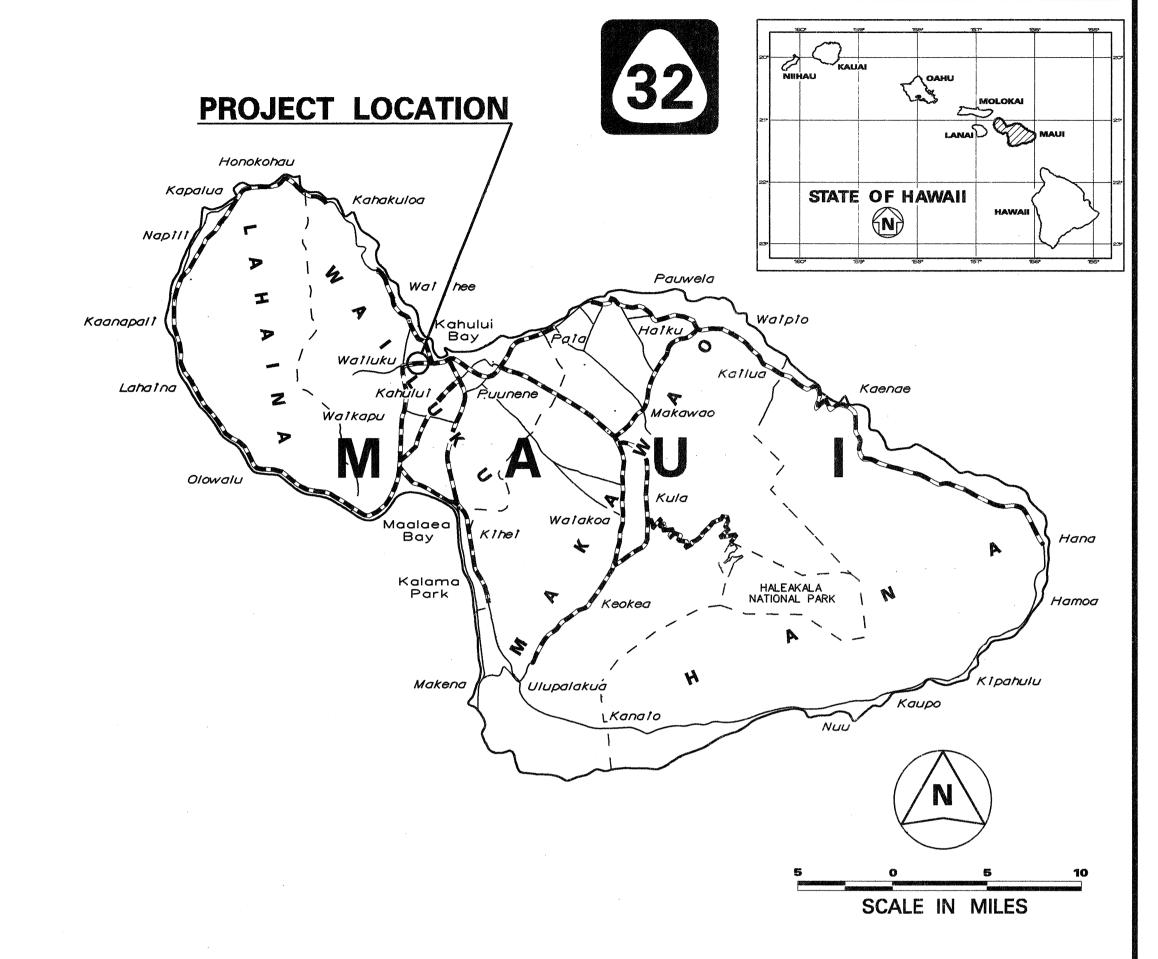


FEDERAL AID PROJECTS PREVIOUSLY CONSTRUCTED OR UNDER CONSTRUCTION

MILE POST 1.18 TO MILE POST 1.29

NO SIGNIFICANT CHANGES WERE MADE DURING CONSTRUCTION ON THESE PLANS EXCEPT CHANGES IN THE ORIGINAL THEORETICAL QUANTITIES FOR ACTUAL QUANTITIES REFER TO PROJECT LEDGER AND/OR COMPUTATION BOOK.

RESIDENT ENGINEER

5/22/96 DATE

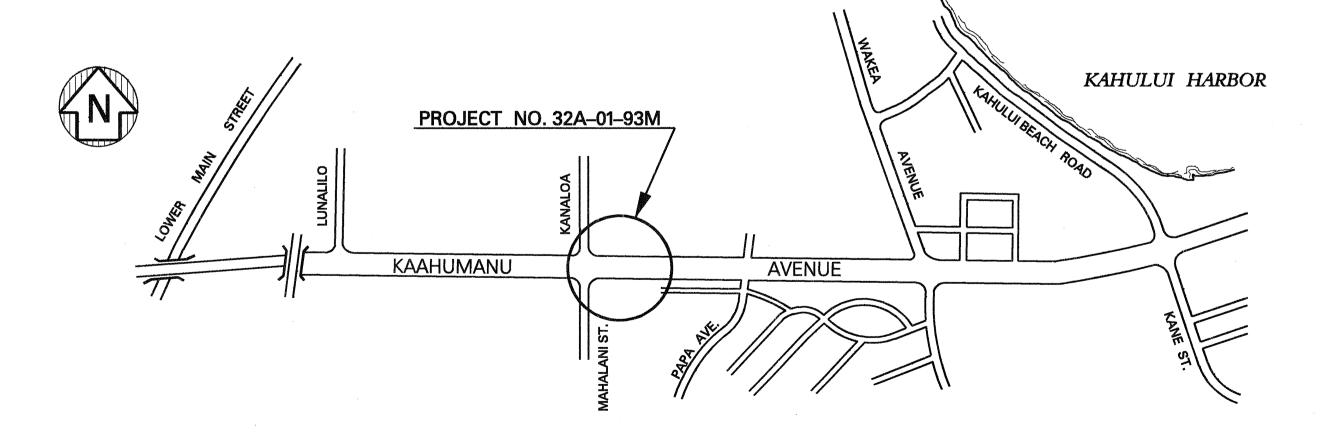

PROJECT LOCATION

1 0 1 2

SCALE IN THOUSAND FEET

.