


FED. ROAD DIST. NO.	STATE	PROJ. NO.	FISCAL YEAR	SHEET NO.	TOTAL SHEETS
HAWAII	HAW.	32A-01-96	1997	5	7

LEGEND

	4 each Type A Raised Pavement Markers Type C Raised Pavement Markers @ 40'-0" o.c.
	4 each Type J Raised Pavement Markers Type D Raised Pavement Markers @ 40'-0" o.c.
	8" White Stripe with Type C Raised Pavement Markers @ 20'-0" o.c. (Paint)
	4" Double Solid Yellow with Type D Raised Pavement Markers @ 20'-0" o.c. (Paint)
	4" Double Solid Yellow Stripes with Type H Raised Pavement Markers @ 20'-0" o.c. (Paint)
	4" Yellow Edge Stripe with Type H Raised Pavement Markers @ 40'-0" o.c. (Paint)
	4" Double Solid White Stripes with Type C Raised Pavement Markers @ 20'-0" o.c. (Paint)
	Lane Change Restriction Marking 4 each Type A Raised Pavement Markers Type C Raised Pavement Markers @ 20'-0" o.c. 4" White Stripe (Paint)
	4" or 8" White Edge Stripe with Type C Raised Pavement Markers @ 40'-0" o.c. (Paint)
	4" White Guide Lines (Paint)
	Transverse Median Marking (Paint)
	Transverse Shoulder Marking (Paint)
	Channelizing Island or Deceleration Lane Gore (Paint)
	Crosswalk and Stop Line. All Stop Lines shall be 10'-0" from Crosswalk unless otherwise noted. The circled number indicates the number of lanes for payment (Paint)
	Pavement Arrow (Paint)
	STOP Pavement Word (Paint)
	4 Each Type J Raised Pavement Markers Type D Raised Pavement Markers @ 40'-0" o.c. Type H Raised Pavement Markers (Reflective Surface facing no-passing direction) 4" Single Solid Yellow Stripe (Paint)
	Extension of Edge Line, 4" Wide x 2'-0" Long White Stripe @ 10'-0" o.c. w/Type C Markers @ 40'-0" o.c. (Paint))

NOTES

- Layout of pavement markings and striping shall be done by the Contractor and approved by the Engineer prior to any installation work.
- Existing pavement markings not incorporated in the final traffic pattern shall be removed as directed by the Engineer. Costs shall be incidental to the various pavement marking items.
- Raised pavement markers shall not be installed within crosswalks.
- Final locations of all signs shall be approved by the Engineer prior to any installation work.
- Existing signs not shown on these plans shall remain as posted unless otherwise directed by the Engineer. Removal and disposal of existing signs and/or posts as designated on these plans shall be incidental to the various signing items.
- Final locations of all Stop Lines shall be approved by the Engineer prior to installation.
- All pavement striping shall be as noted on the legend or plans.
- All preformed pavement marking tapes over existing pavement shall be applied with an approved primer as recommended by the tape manufacturer and as approved by the Engineer. The primer shall be allowed to dry to the tacky stage prior to tape application.
- Removal of Existing Delineators and Posts as directed by the Engineer shall be considered incidental to various signing items.
- Existing signs that are to be replaced shall not be removed until new signs are installed as replacements, or the message are no longer necessary.
- Backing for all new regulatory and warning signs shall not be spliced.
- All sign panels shall conform to section 621 of Special Provisions and the latest editions and amendments of the following FHWA publications:
 - "Manual on Uniform Traffic Control Devices for Street and Highways" (MUTCD)
 - "Standard Highway Signs"
 - "Standard Alphabets for Highway Signs"
- All new and relocated signs and markers installed on pipe post or light standard are to be mounted with band brackets and steel braces.
- The Contractor shall erect at the beginning of the project and at the end of the project advance construction warning sign as indicated on the plans or as directed by the Engineer for the duration of the highway project and shall be maintained by the Contractor. These signs shall be placed in addition to the required traffic control signs called for in Section 645-Traffic Control. The advance construction warning signs shall be new and become the property of the State. The Contractor shall remove, clean and deliver the signs and posts to the Maui District Baseyard or as directed by the Engineer at the end of the project.

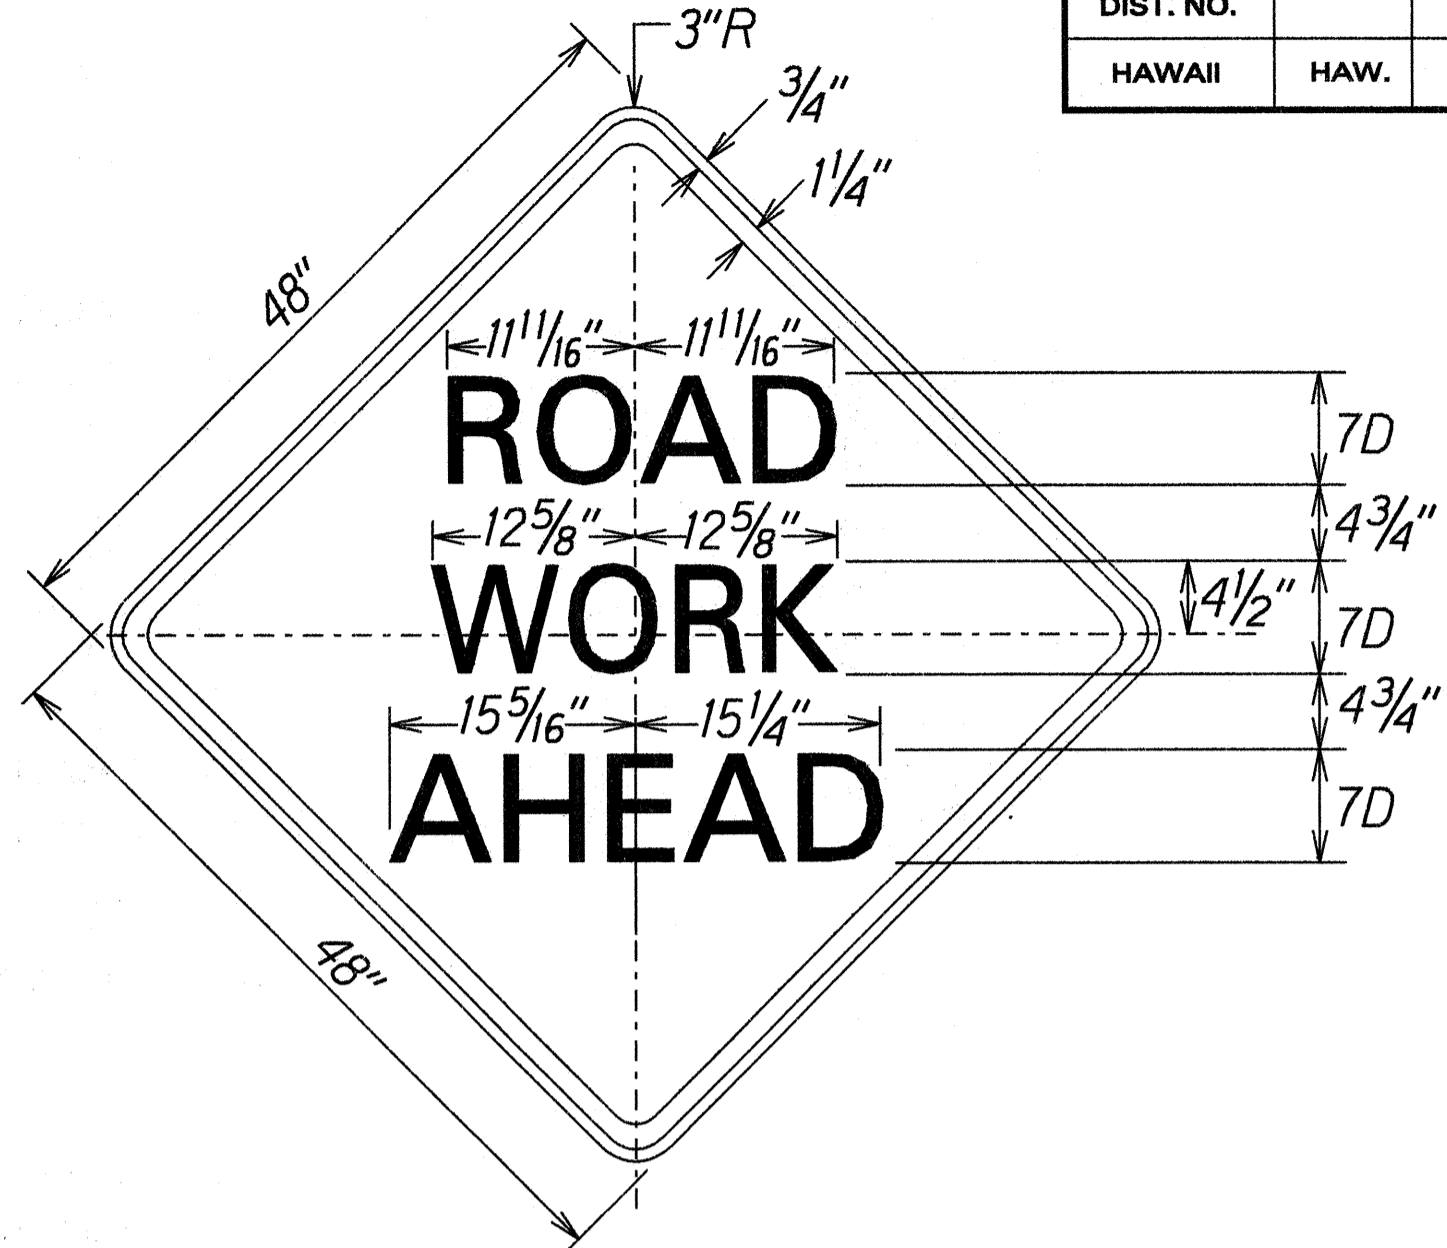


CW20-1A(d)

Scale: 1" = 1'-0"

Colors:

Legend: Black (Non Refl)
Background: Orange

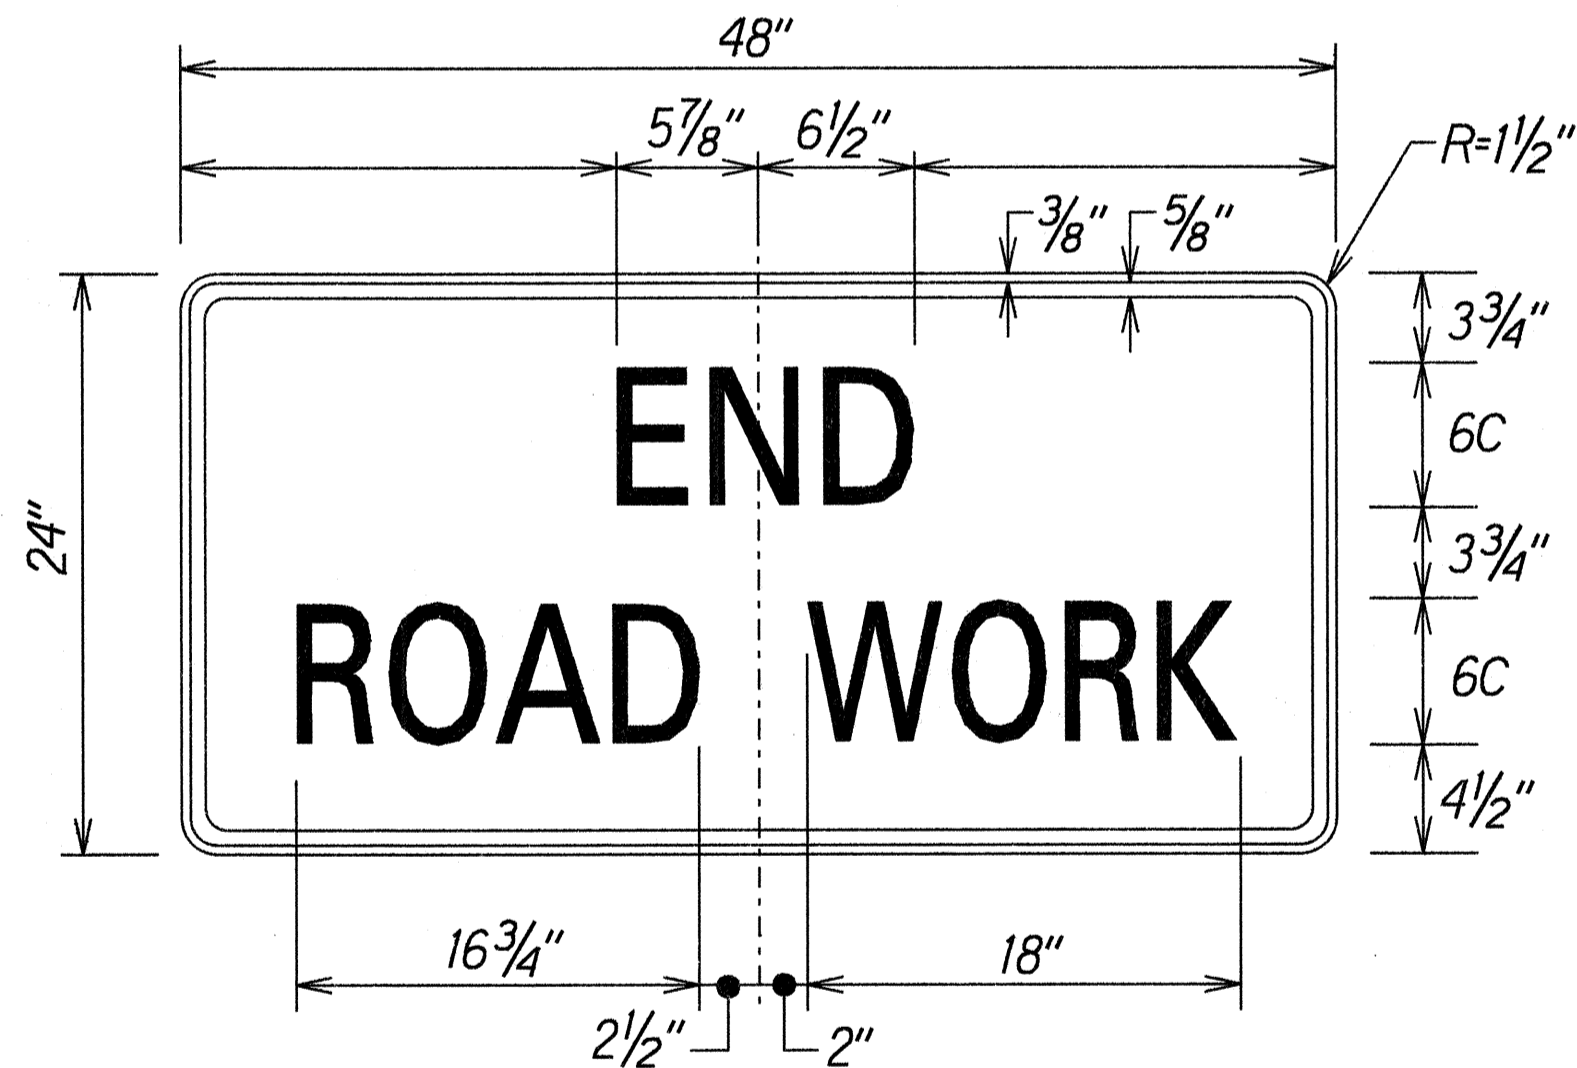


CG20-2A

Scale: 1 1/2" = 1'-0"

Colors:

Legend: Black (Non Refl)
Background: Orange

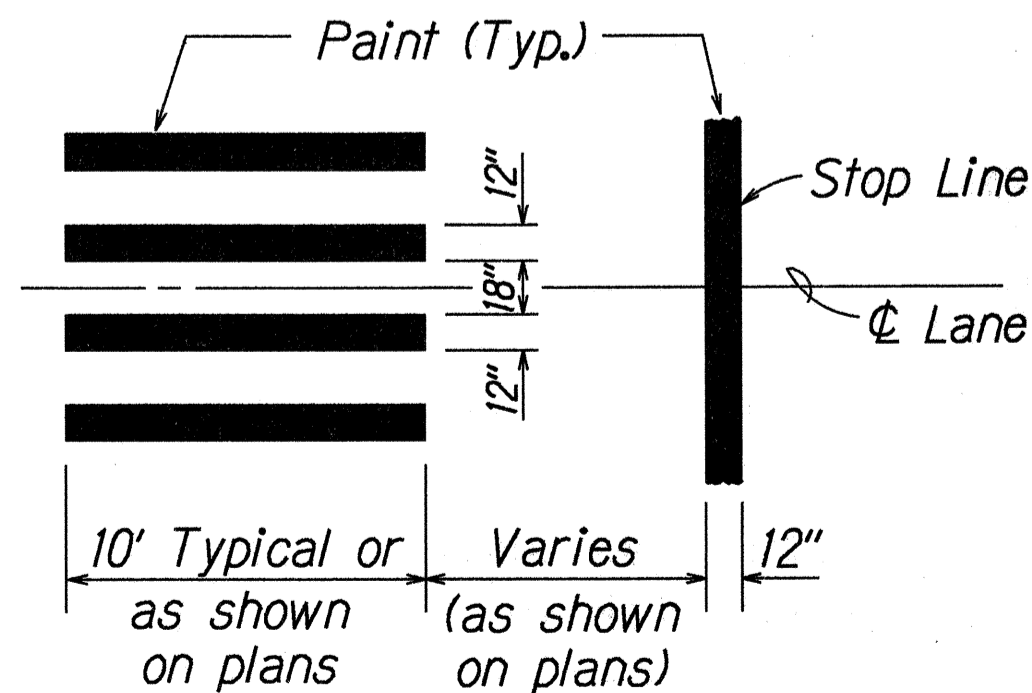

CROSSWALK STRIPING DETAIL

Not to Scale

STATE OF HAWAII DEPARTMENT OF TRANSPORTATION HIGHWAYS DIVISION	
PAVEMENT MARKING	
LEGEND, DETAILS & NOTES	
KAAHUMANU AVENUE	
Left Turn Lane Into Hoʻaloha Park	
Project No. 32A-01-96	
Scale: As Shown	Date: October, 1996
SHEET No. 1 OF 1 SHEETS	