	INDEX TO DRAWINGS
SHEET NO.	DESCRIPTION
1	TITLE SHEET
2	STANDARD PLANS SUMMARY
3	GENERAL NOTES AND LEGEND
4	ROADWAY PLAN AND TYPICAL SECTION
5	PAVEMENT MARKING, LEGEND,
	DETAILS AND NOTES
6	SIGNING AND PAVEMENT
	MARKING PLAN
7	MISCELANEOUS SUMMARIES
	•

STATE OF HAWAII

DEPARTMENT OF TRANSPORTATION

HIGHWAYS DIVISION
HONOLULU, HAWAII

"AS-BUILT"


PLANS FOR


KAAHUMANU AVENUE

LEFT TURN LANE INTO HO'ALOHA PARK PROJECT NO. 32A-01-96

DISTRICT OF KAHULUI
ISLAND OF MAUI

SCALE IN HUNDRED FEET

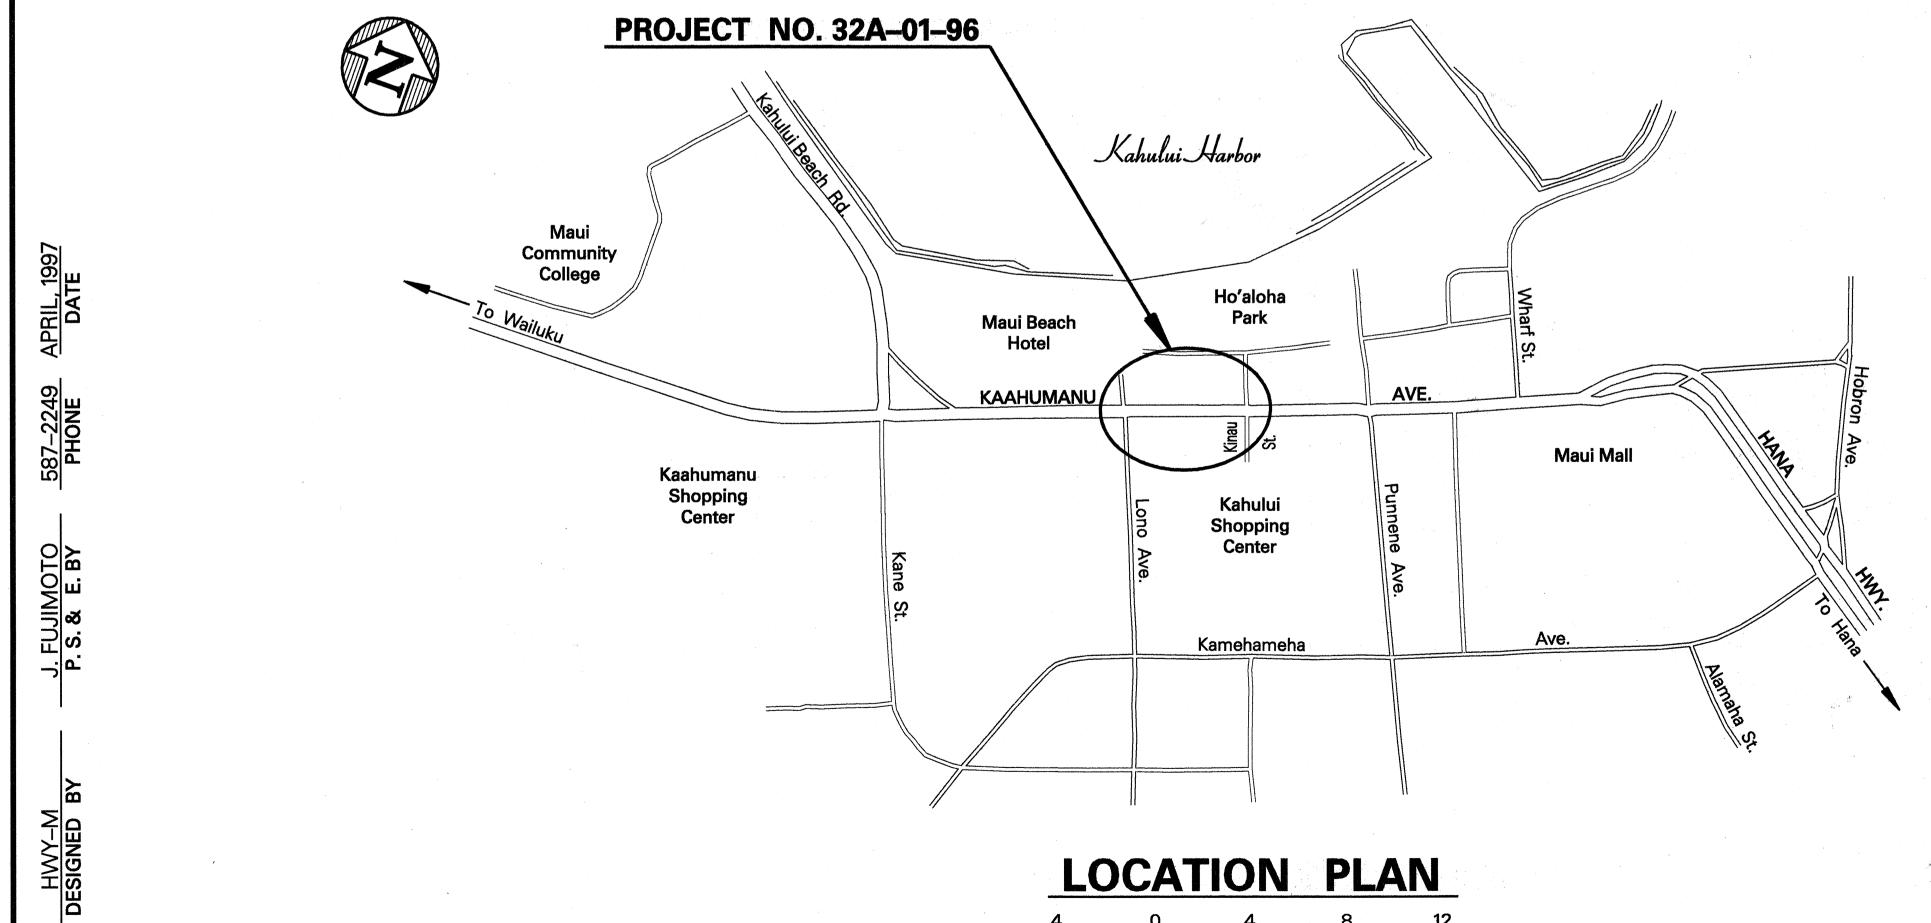

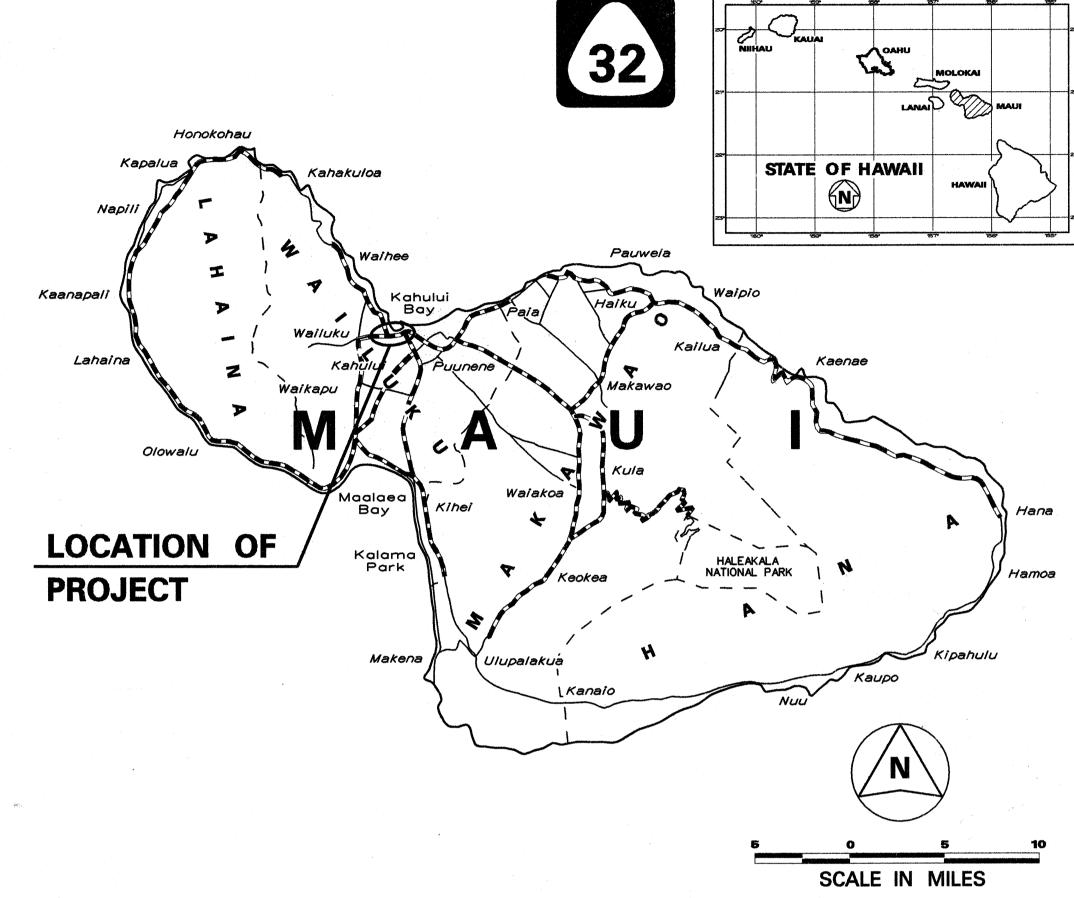

FED. ROAD DIST. NO.

PROJ. NO.

32A-01-96

---- FEDERAL AID PROJECTS PREVIOUSLY CONSTRUCTED OR UNDER CONSTRUCTION

MILE POST 2.30 TO MILE POST 2.40

NO SIGNIFICANT CHANGES WERE MADE DURING CONSTRUCTION ON THESE PLANS EXCEPT CHANGES IN THE ORIGINAL THEORETICAL QUANTITIES. FOR ACTUAL QUANTITIES, REFER TO PROJECT LEDGER AND/OR COMPUTATION BOOK.

SBilliotif RESIDENT ENGINEER

DATE

DEPARTMENT OF TRANSPOR STATE OF HAWAII	TATION
APPROVED:	4/16/97
DIR. OF TRANSPORTATION	DATE