

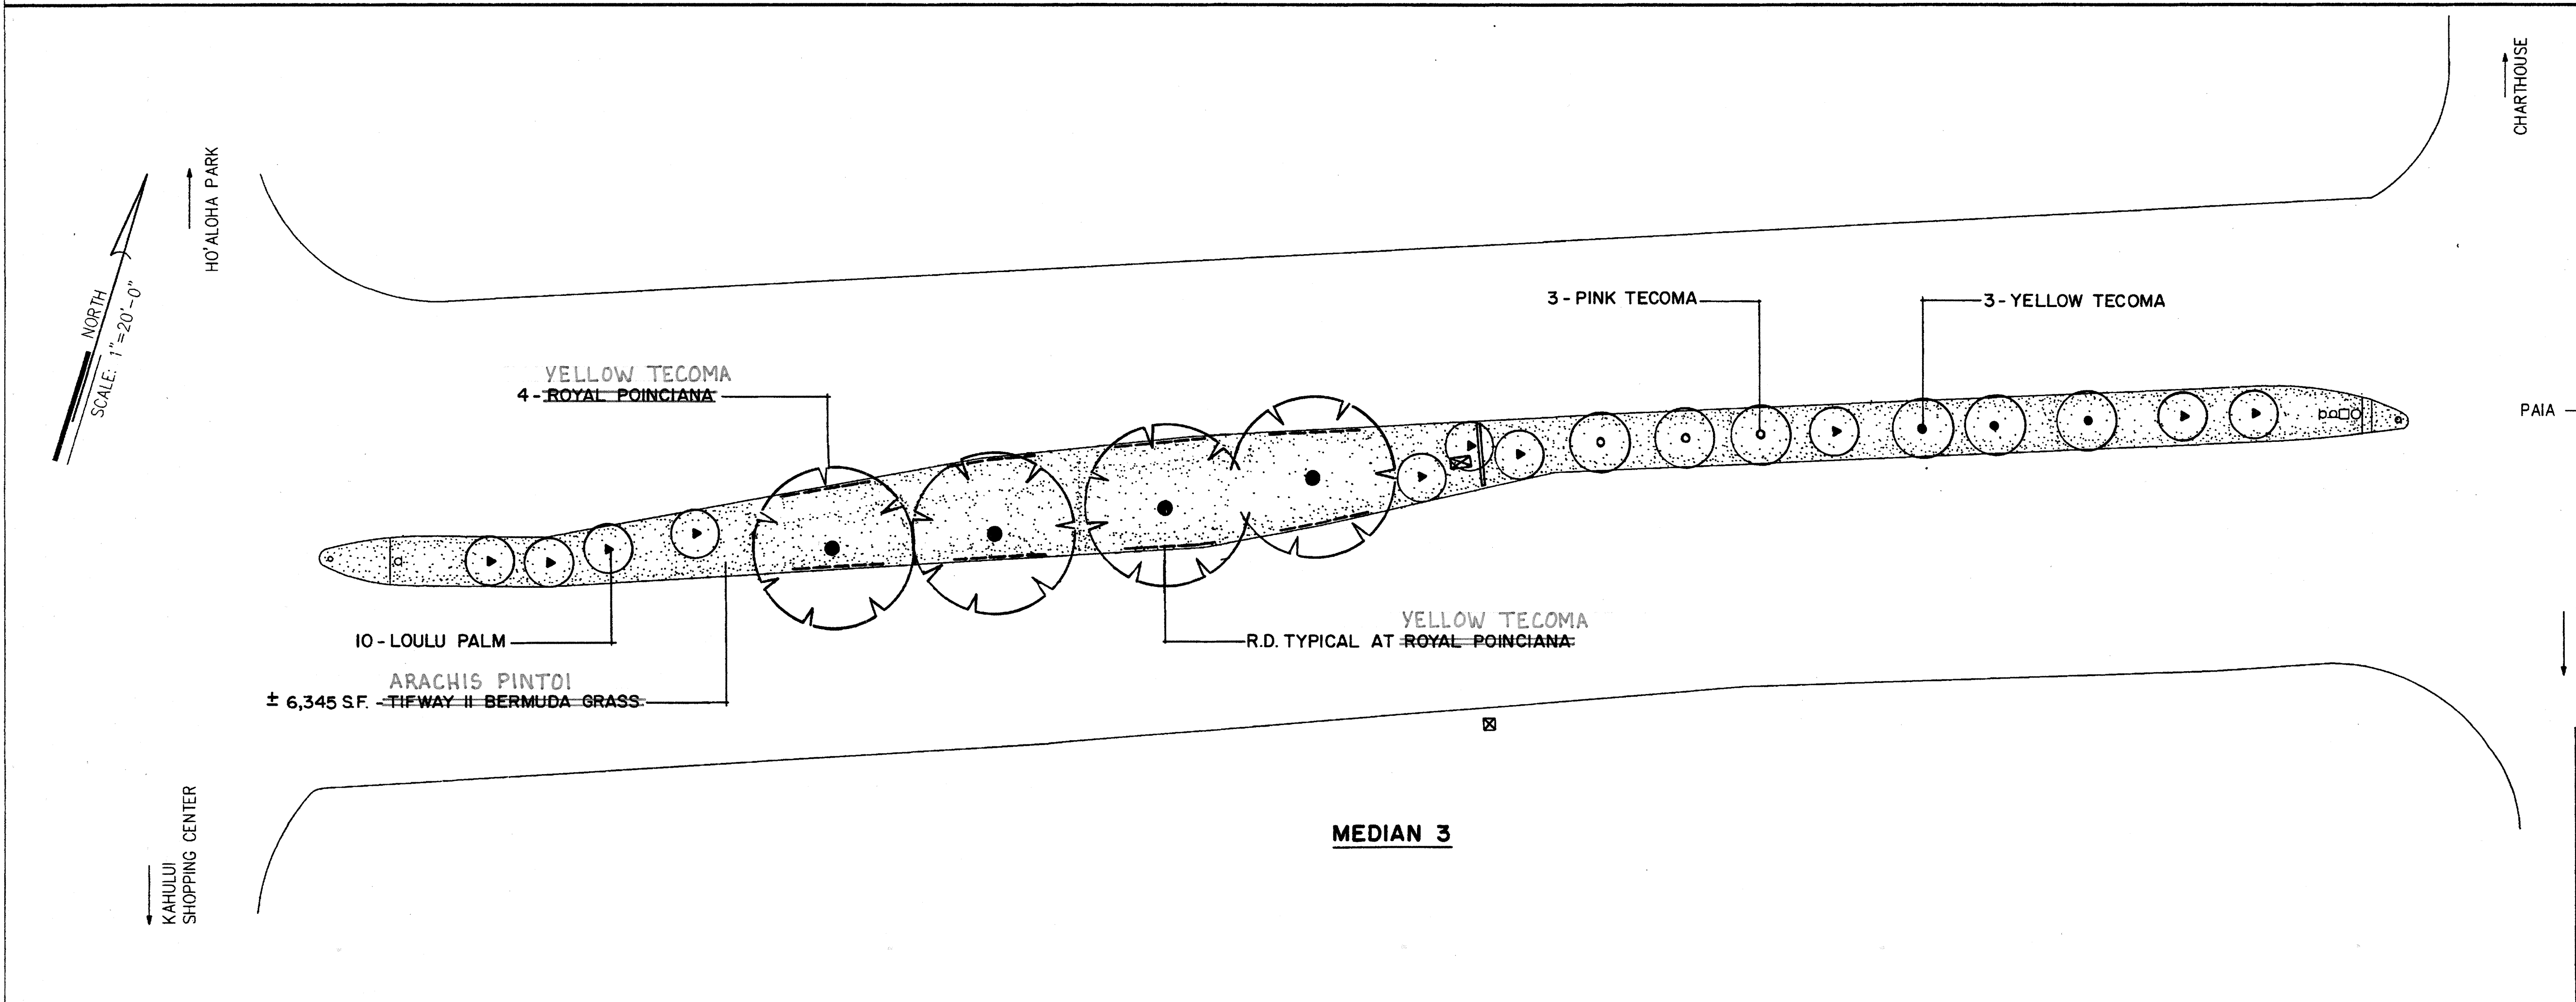


FED. ROAD DIST. NO.	STATE	FED. AID PROJ. NO.	FISCAL YEAR	SHEET NO.	TOTAL SHEETS
HAWAII	HI.	STP- 032-1 (7)	2001	2	11

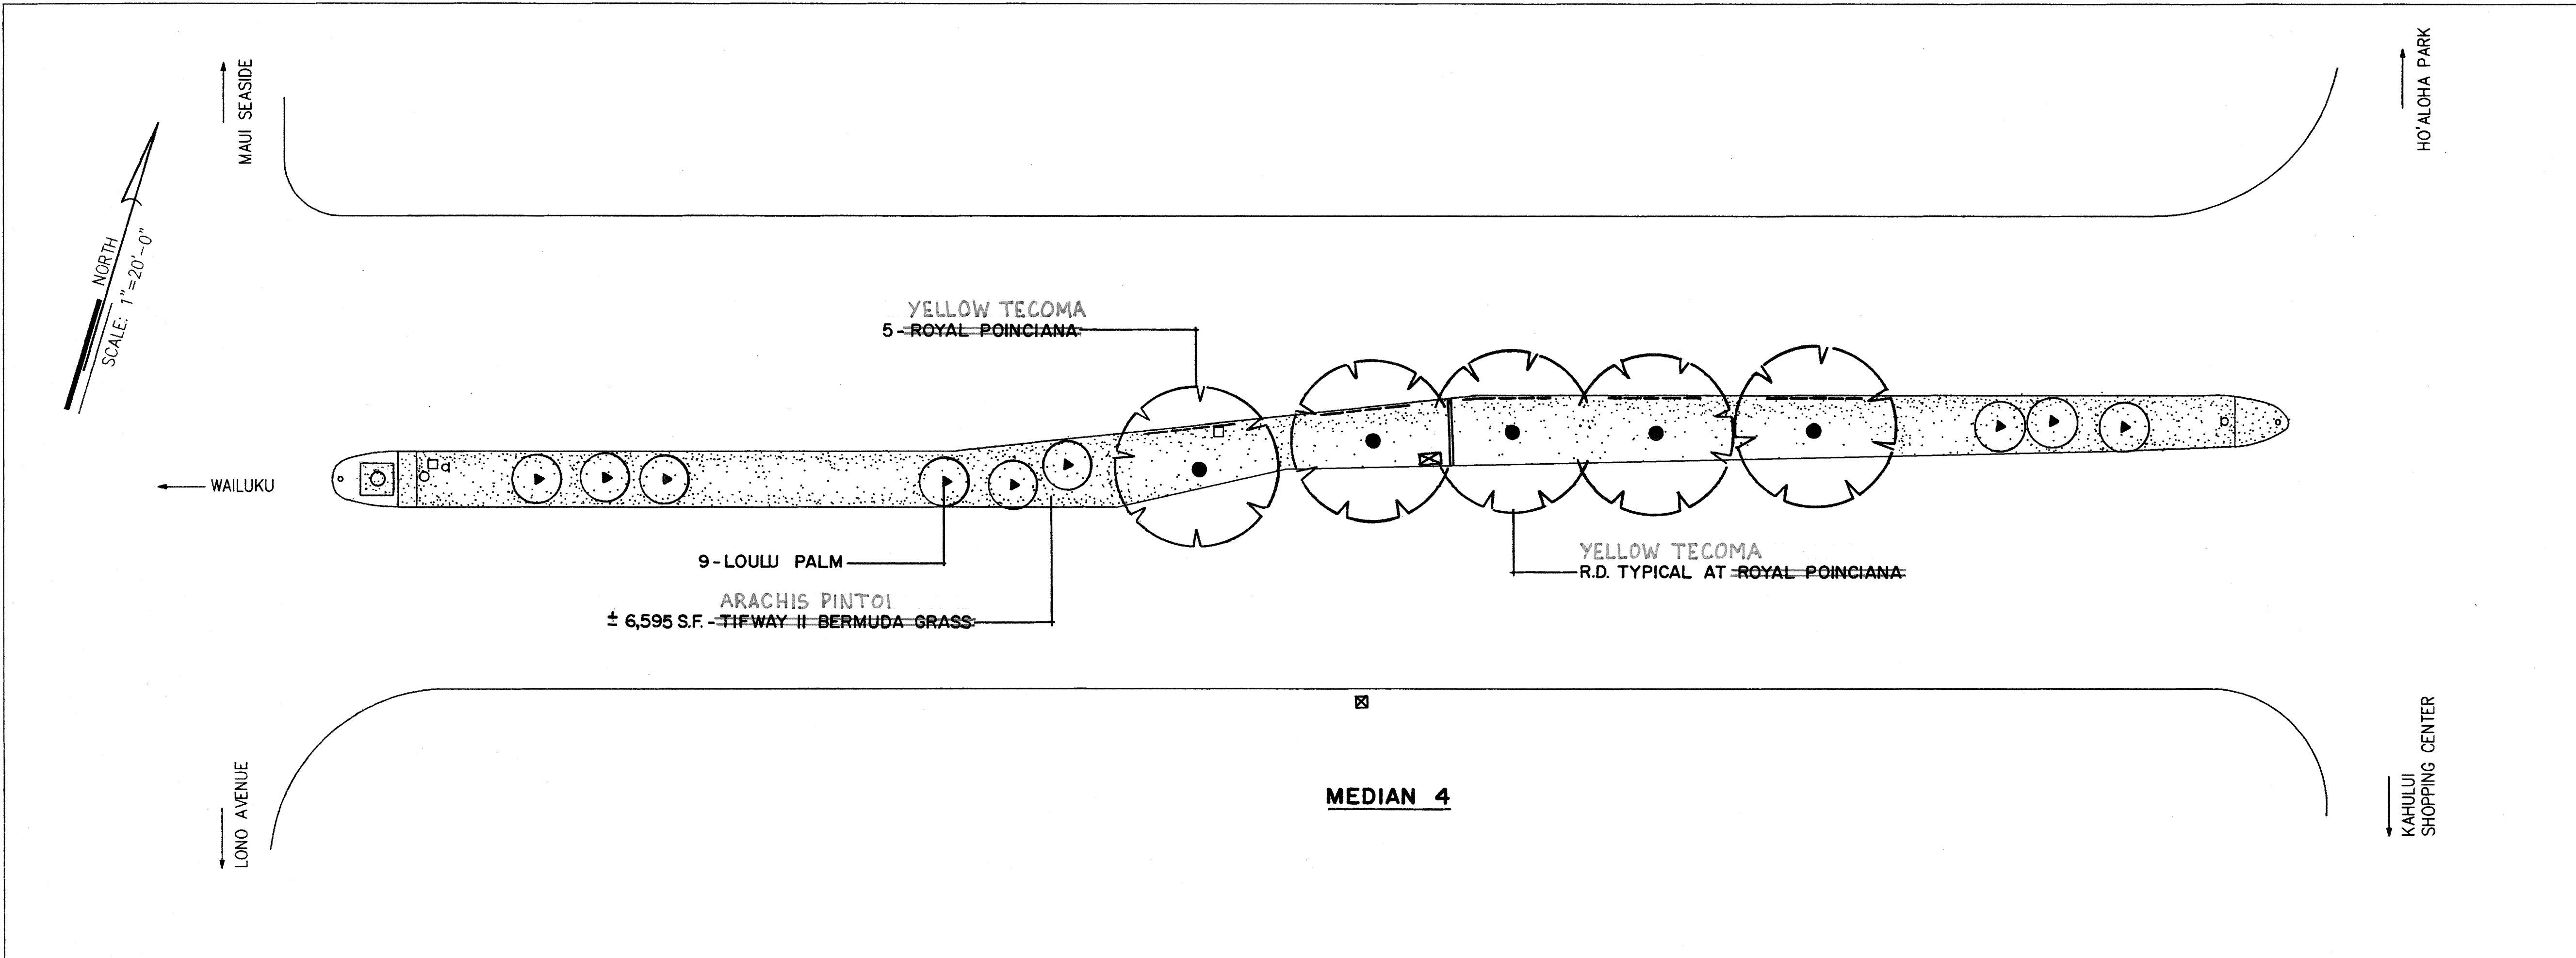


- LEGEND**
- TRAFFIC SIGNAL POLE
 - TRAFFIC SIGNAL BOX
 - p SIGN
 - REFLECTOR
 - DRAIN MANHOLE
 - ⊠ WATER METER
 - (30"x60") ⊠ IRRIGATION EQUIPMENT ASSEMBLY SLAB
 - DRIP IRRIGATION START CONNECTION HEADERS. (SEE IRRIGATION DRAWINGS FOR DETAILS)

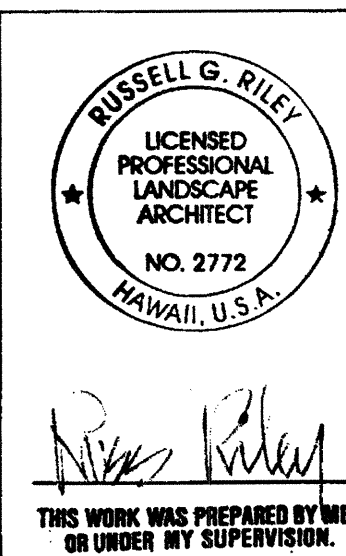

REVISION	DATE	DESCRIPTION	MADE BY	APPROVED
STATE OF HAWAII DEPARTMENT OF TRANSPORTATION HIGHWAYS DIVISION				
PLANTING PLAN I				
KAAHUMANU AVENUE LANDSCAPE IMPROVEMENTS				
PHASE 1 FROM LONO AVENUE TO HANA HIGHWAY				
KAHULUI, MAUI, HAWAII				

"AS-BUILT"

FED. ROAD DIST. NO.	STATE	FED. AID PROJ. NO.	FISCAL YEAR	SHEET NO.	TOTAL SHEETS
HAWAII	HI.	STP- 032-1 (7)	2001	3	11

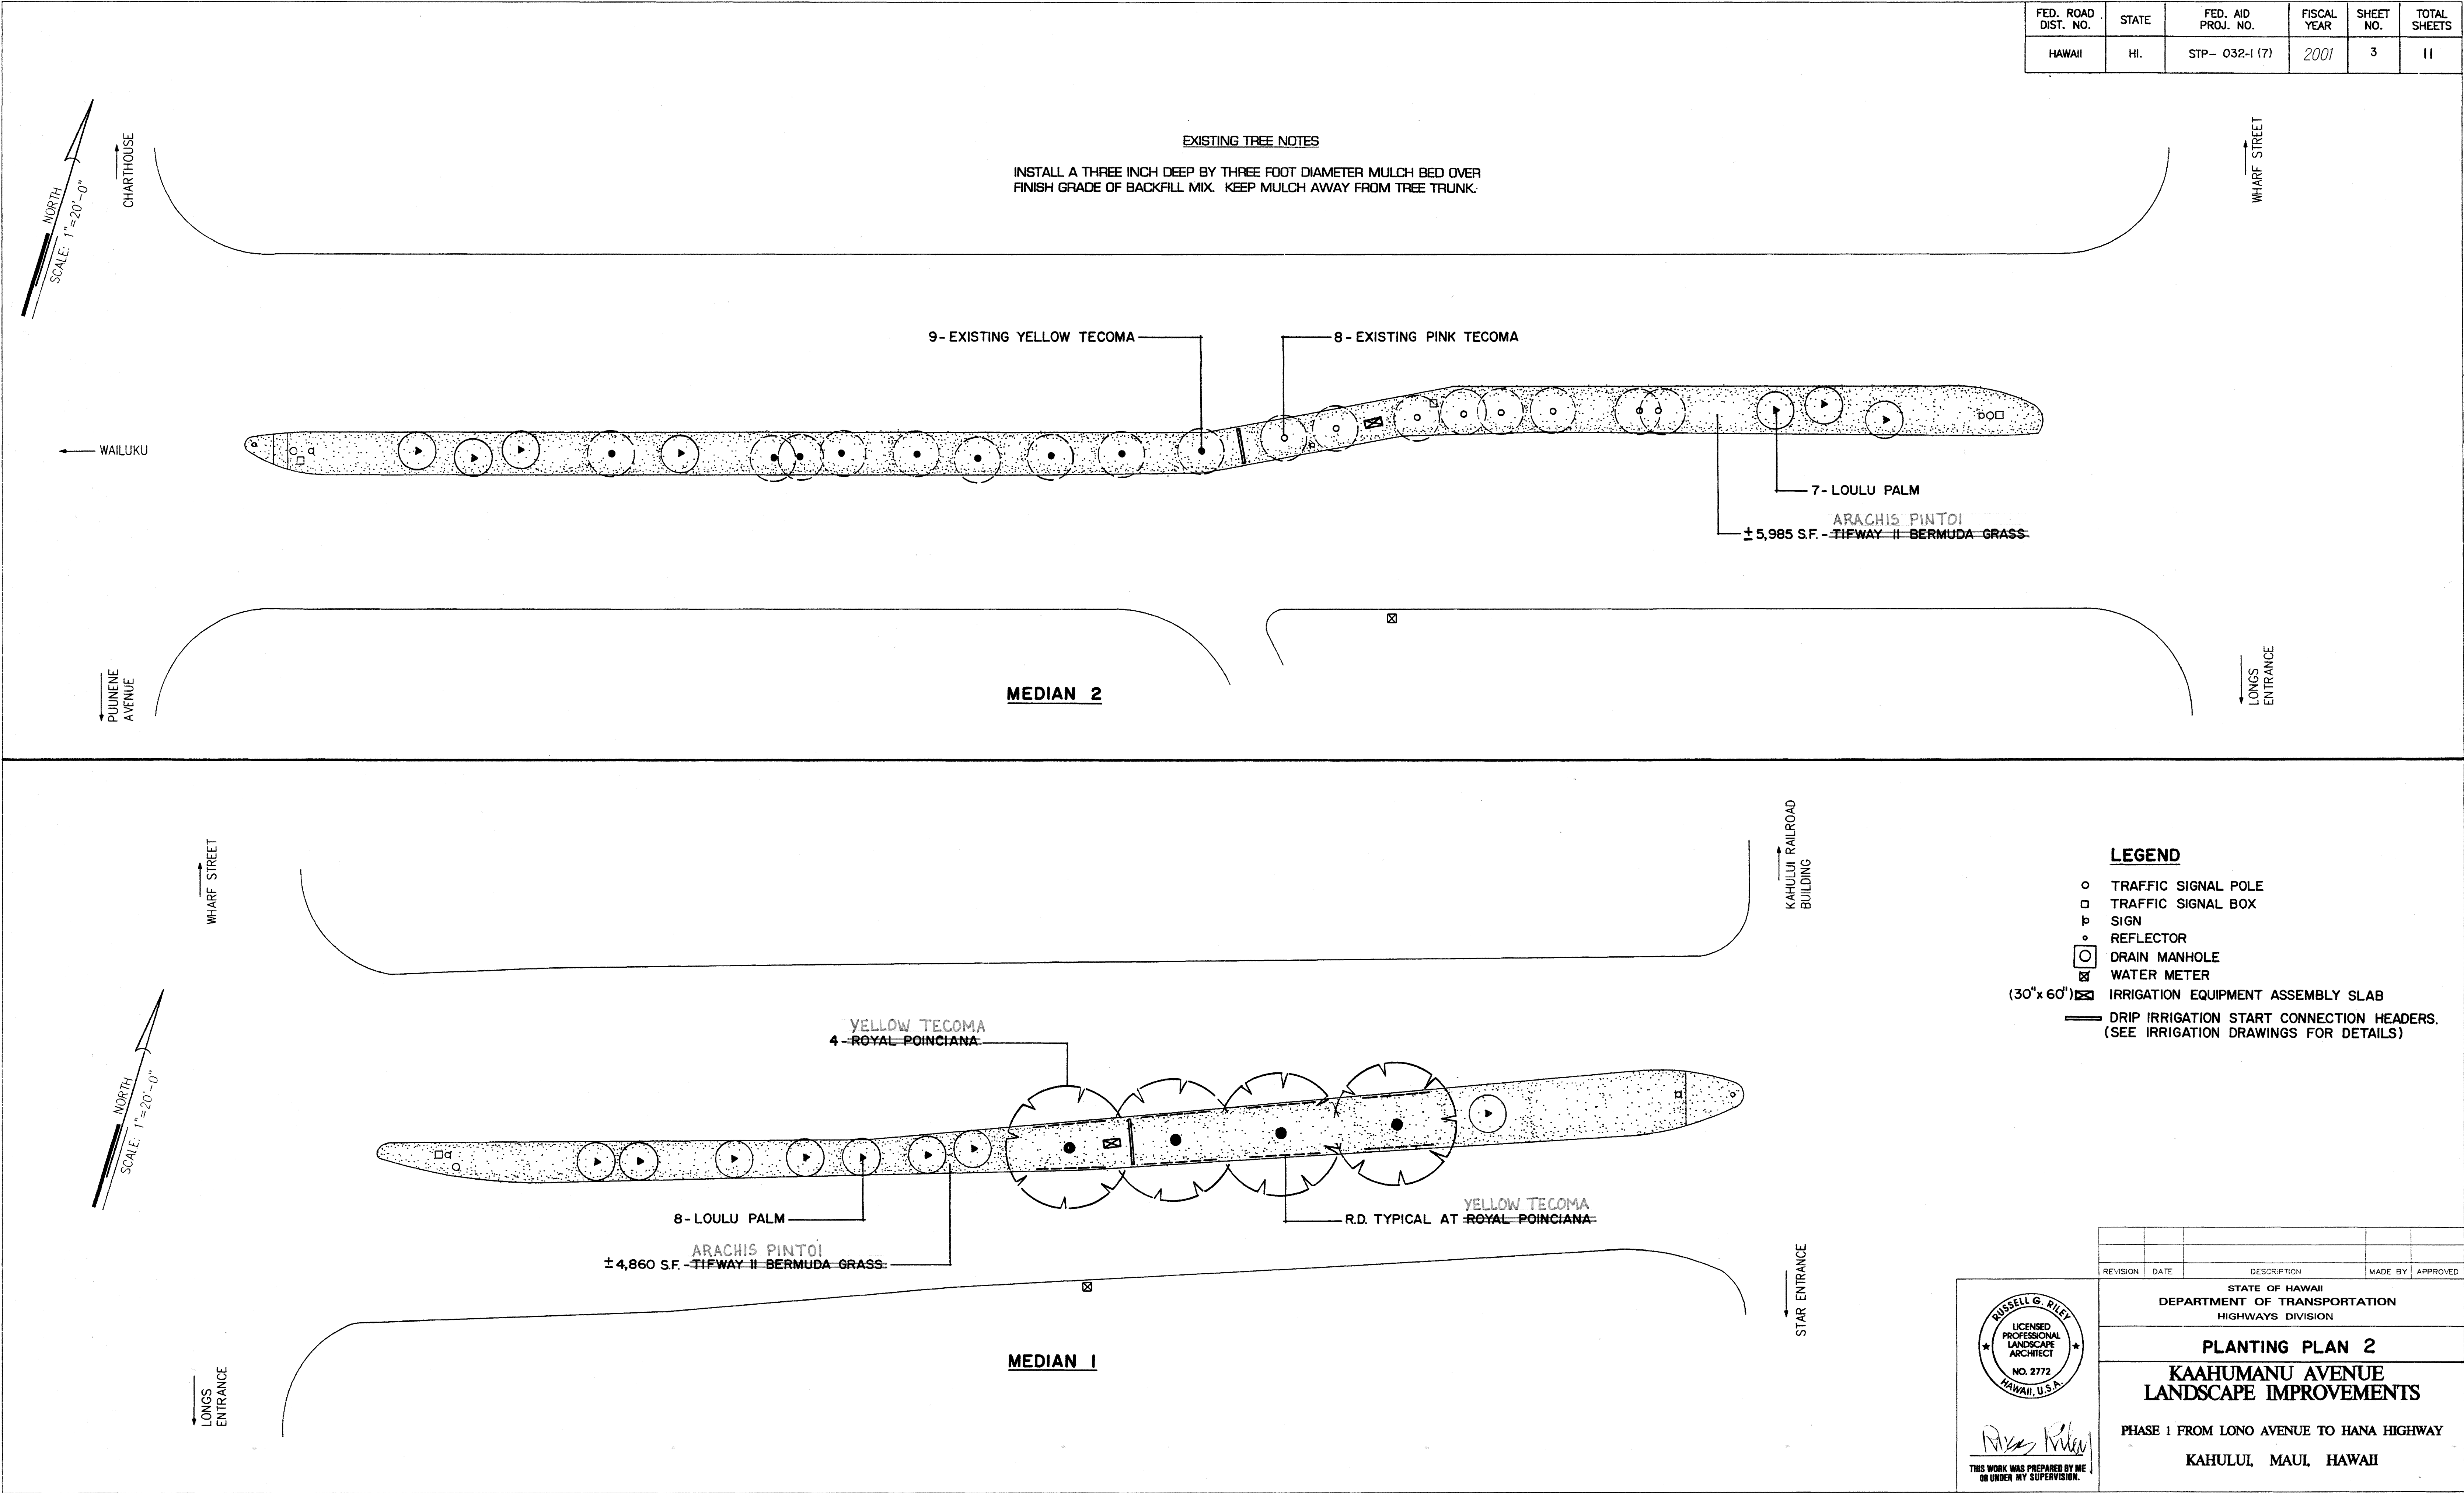

"AS-BUILT"