



FED. ROAD DIST. NO.	STATE	FED. AID PROJ. NO.	FISCAL YEAR	SHEET NO.	TOTAL SHEETS
HAWAII	HAW.	NH-032-1(8)	2000	64	111

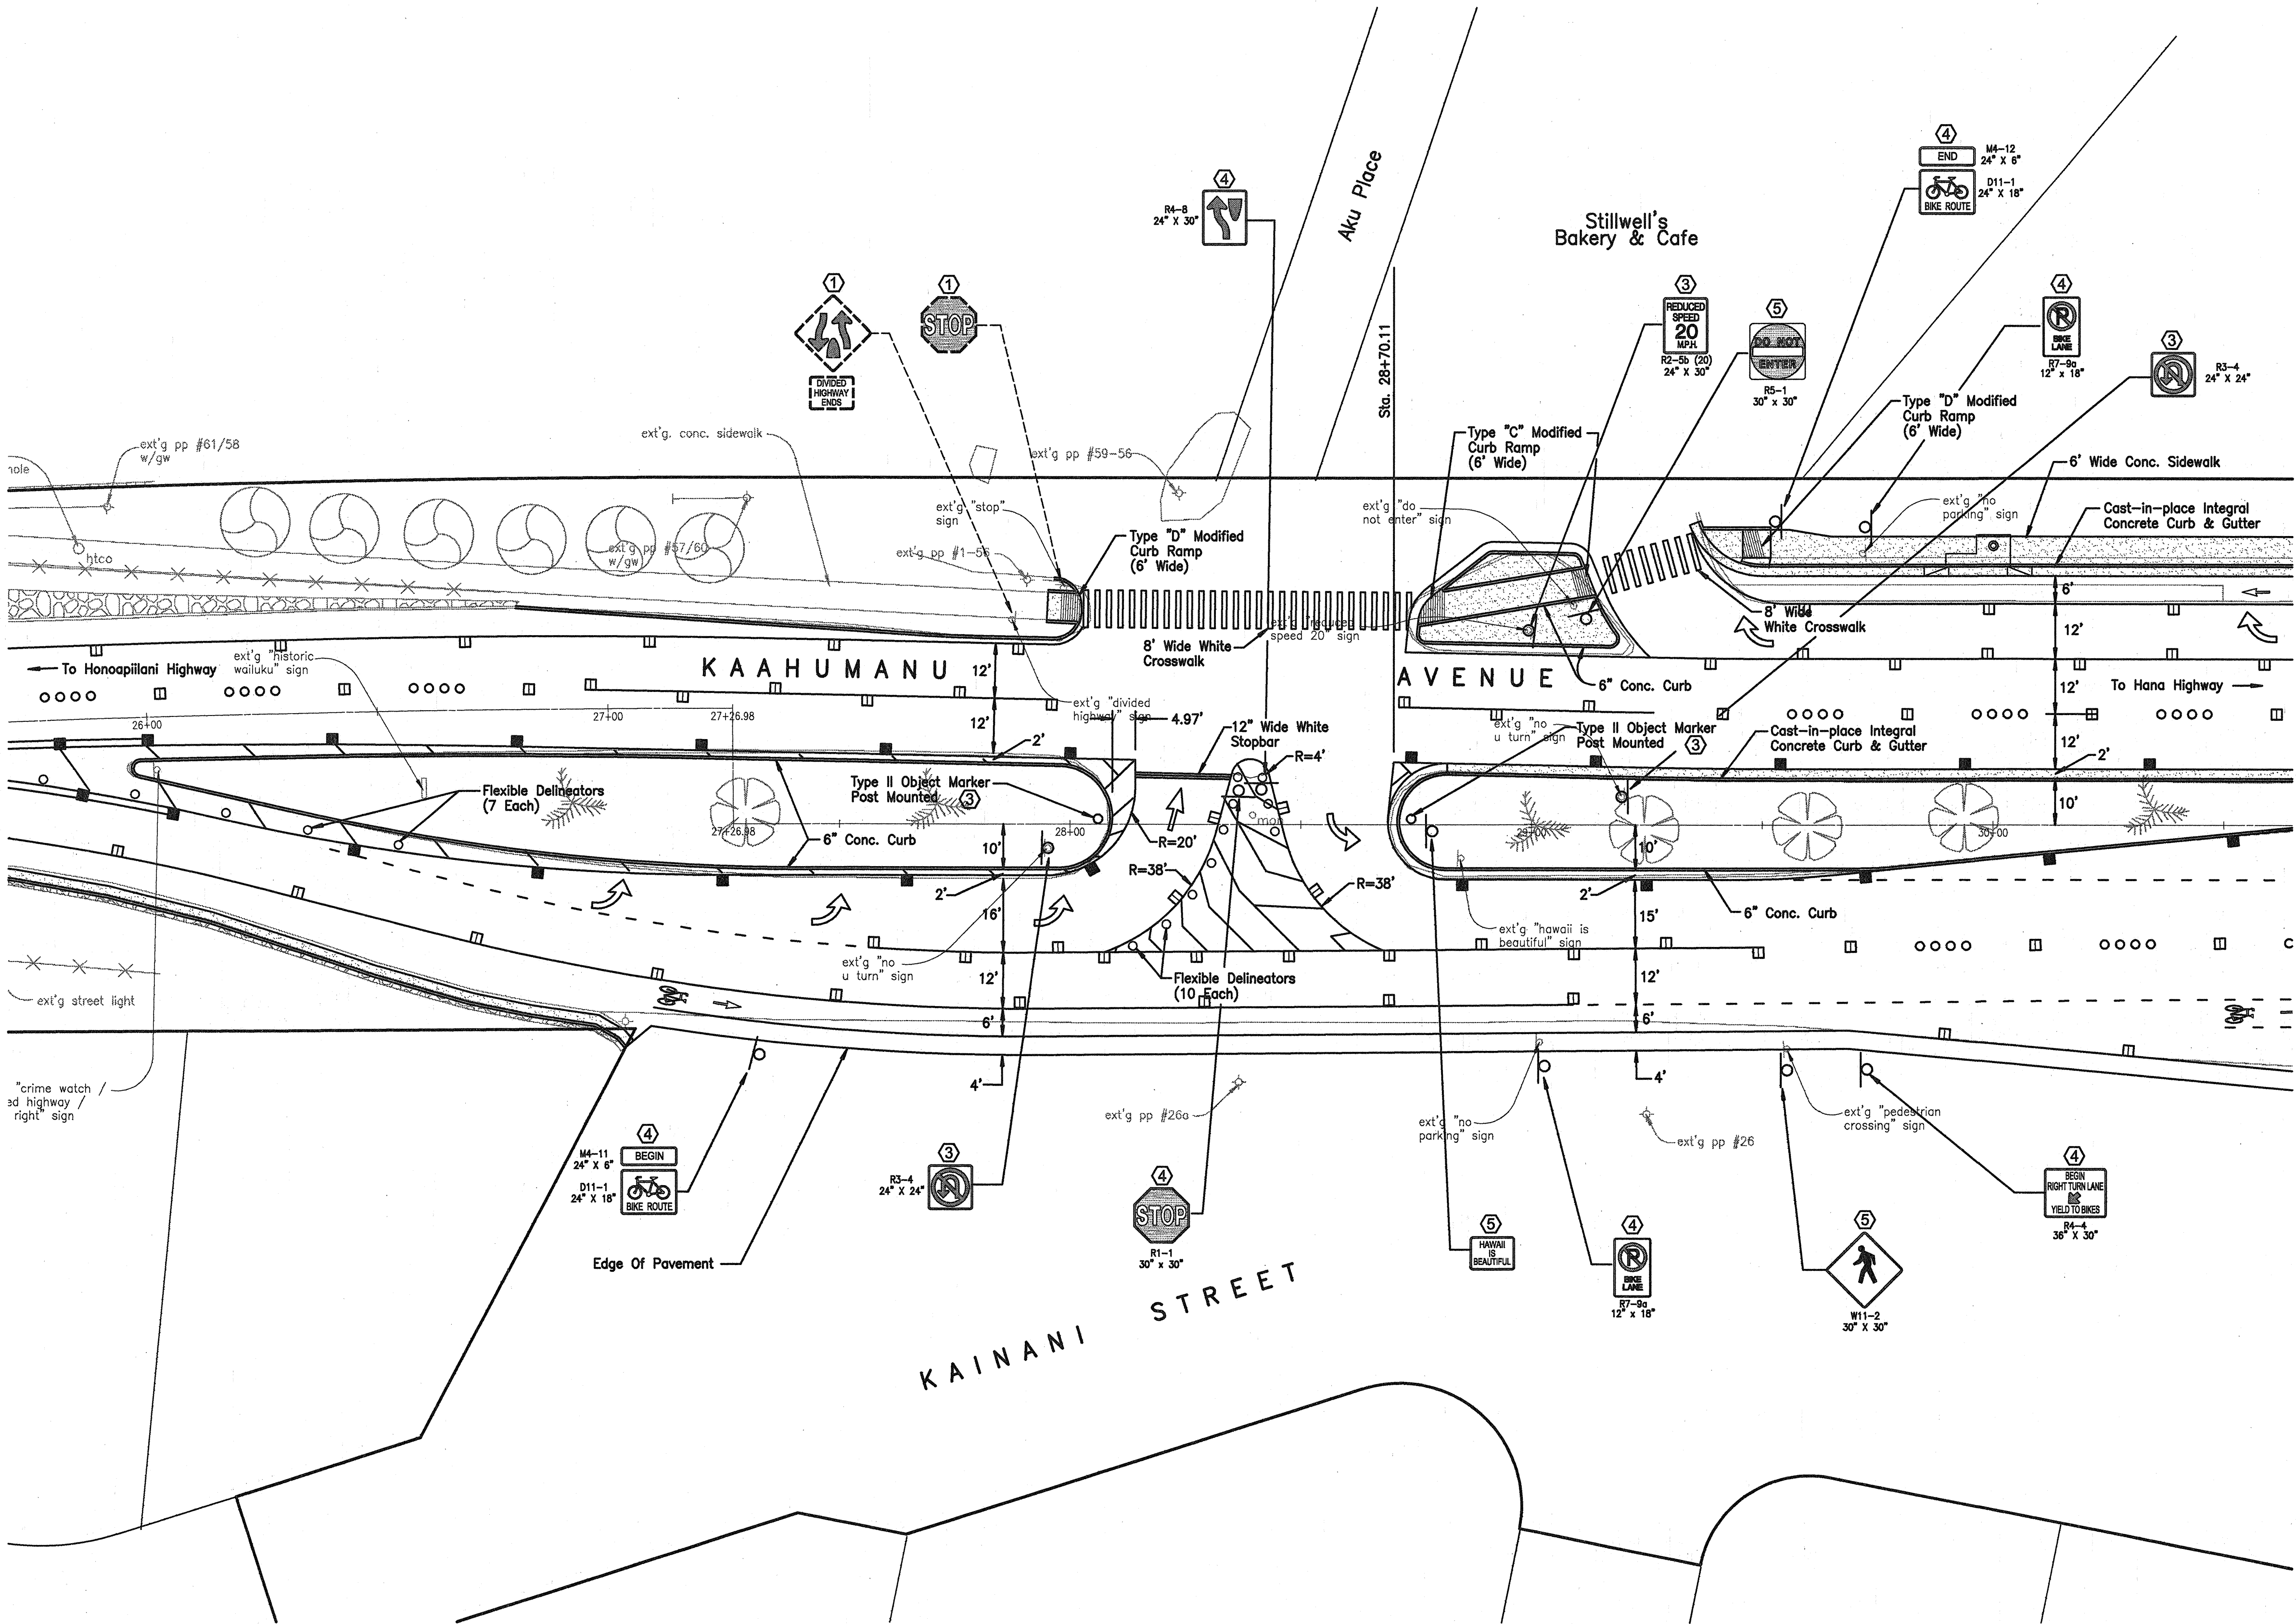

- LEGEND:**
- 4 EACH TYPE "A" RAISED PAVEMENT MARKERS
TYPE "C" RAISED PAVEMENT MARKERS AT 40'-0" O.C.
 - 4" DOUBLE SOLID YELLOW STRIPES WITH TYPE "H"
RAISED PAVEMENT MARKERS AT 20'-0" O.C.
(TAPE, TYPE I OR THERMOPLASTIC EXTRUSION)
 - 8" SOLID WHITE STRIPE W/ TYPE "C" RAISED PAVEMENT
MARKERS AT 20'-0" O.C. (TAPE, TYPE I OR THERMOPLASTIC
EXTRUSION)
 - 4" YELLOW EDGE STRIPE WITH TYPE "H" RAISED
PAVEMENT MARKERS AT 40'-0" O.C.
(TAPE, TYPE II OR THERMOPLASTIC EXTRUSION)
 - CHANNELIZING ISLAND OR DECELERATION LANE GORE
(TAPE, TYPE II OR THERMOPLASTIC EXTRUSION)
 - 4" OR 8" WHITE EDGE STRIPE W/ TYPE "C" RAISED PAVEMENT
MARKERS AT 40'-0" O.C. (TAPE, TYPE II OR THERMOPLASTIC
EXTRUSION)
 - 4" WHITE GUIDELINES (TAPE, TYPE III OR THERMOPLASTIC
EXTRUSION EXCEPT FOR BUS BAYS) (GUIDELINES FOR TURNING
MOVEMENTS THROUGH INTERSECTIONS SHALL BE YELLOW)
 - TRANSVERSE MEDIAN MARKING (TAPE, TYPE II OR
THERMOPLASTIC EXTRUSION)
 - TRANSVERSE SHOULDER MARKING (TAPE, TYPE II
OR THERMOPLASTIC EXTRUSION)
 - PAVEMENT ARROW (TAPE, TYPE III OR THERMOPLASTIC EXTRUSION)
 - CROSSWALK AND STOP LINE. ALL STOP LINES SHALL BE
10'-0" FROM CROSSWALK UNLESS OTHERWISE NOTED.
THE CIRCLED NUMBER INDICATES THE NUMBER OF LANES
FOR PAYMENT (TAPE, TYPE III OR THERMOPLASTIC EXTRUSION)
 - BIKE LANE MARKING (PAINT)
 - EXISTING SIGN(S) AND POST(S) TO REMAIN
 - REMOVE EXISTING SIGN(S) AND POST(S)
 - REMOVE EXISTING AND INSTALL NEW SIGN(S) AND POST(S)
 - INSTALL NEW SIGN(S) AND POST(S)
 - RELOCATE EXISTING SIGN(S) AND POST(S)
 - REMOVE EXT'G AND INSTALL NEW SIGN(S) ON
TRAFFIC SIGNAL POST(S)

SURVEY PLOTTED BY	DATE
DRAWN BY	DATE
DESIGNED BY	DATE
QUANTITIES BY	DATE
CHECKED BY	DATE

INTERSECTION - KAAHUMANU AVENUE AT STA. 28+40±

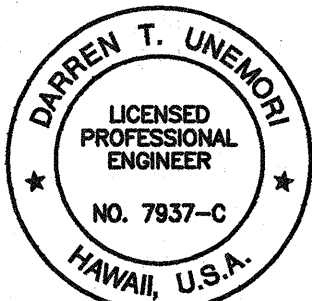


THIS WORK WAS PREPARED BY ME
OR UNDER MY SUPERVISION
Signature: *[Signature]* 4/18/00

STATE OF HAWAII
DEPARTMENT OF TRANSPORTATION
HIGHWAYS DIVISION
INTERSECTION STRIPING & SIGNAGE PLAN
MAIN STREET RESURFACING
CENTRAL AVENUE TO KAAHUMANU AVENUE
AND
KAAHUMANU AVENUE RESURFACING
MAIN STREET TO HOBSON AVENUE
Fed. Aid Project No. NH-032-1(8)

SCALE: AS NOTED
SHEET No. 1 OF 15 SHEETS

FED. ROAD DIST. NO.	STATE	FED. AID PROJ. NO.	FISCAL YEAR	SHEET NO.	TOTAL SHEETS
HAWAII	HAW.	NH-032-1(8)	2000	65	111

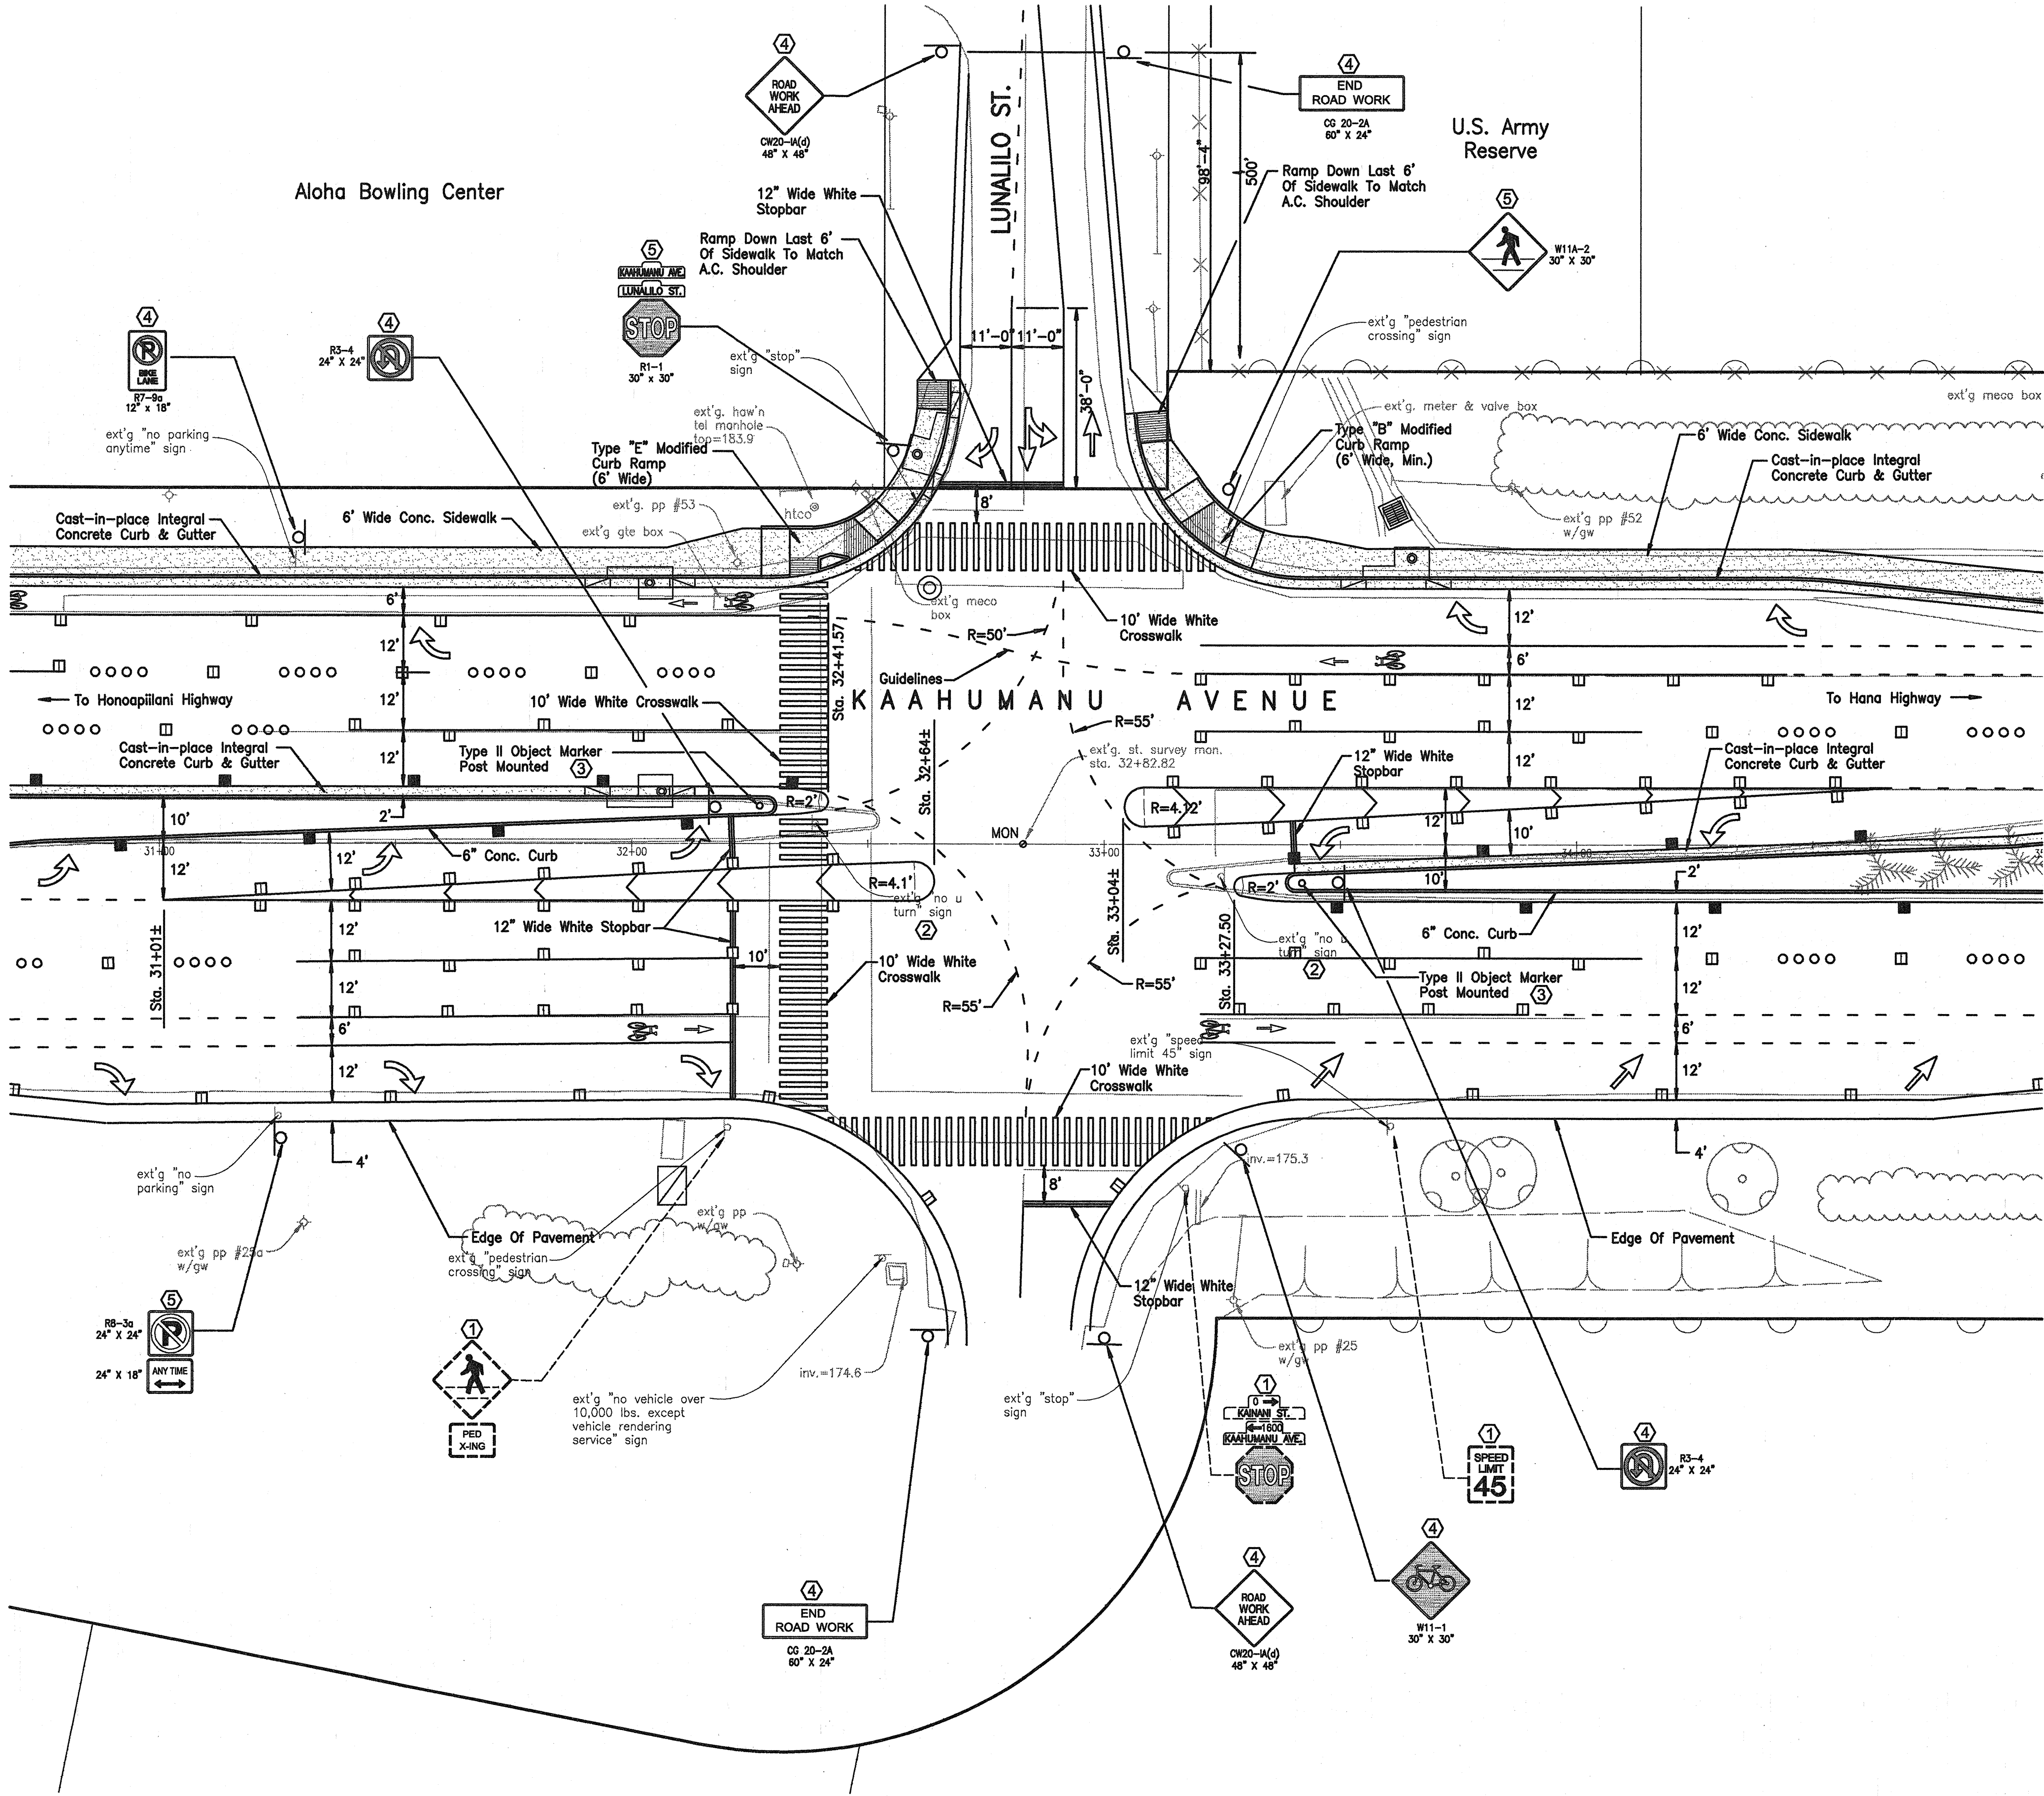


TRUE NORTH
SCALE: 1 IN. = 20 FT.

- LEGEND:**
- 4 EACH TYPE "A" RAISED PAVEMENT MARKERS
TYPE "C" RAISED PAVEMENT MARKERS AT 40'-0" O.C.
 - 4" DOUBLE SOLID YELLOW STRIPES WITH TYPE "H"
RAISED PAVEMENT MARKERS AT 20'-0" O.C.
(TAPE, TYPE I OR THERMOPLASTIC EXTRUSION)
 - 8" SOLID WHITE STRIPE W/ TYPE "C" RAISED PAVEMENT
MARKERS AT 20'-0" O.C. (TAPE, TYPE I OR THERMOPLASTIC
EXTRUSION)
 - 4" YELLOW EDGE STRIPE WITH TYPE "H" RAISED
PAVEMENT MARKERS AT 40'-0" O.C.
(TAPE, TYPE II OR THERMOPLASTIC EXTRUSION)
 - CHANNELIZING ISLAND OR DECELERATION LANE GORE
(TAPE, TYPE II OR THERMOPLASTIC EXTRUSION)
 - 4" OR 8" WHITE EDGE STRIPE W/ TYPE "C" RAISED PAVEMENT
MARKERS AT 40'-0" O.C. (TAPE, TYPE II OR THERMOPLASTIC
EXTRUSION)
 - 4" WHITE GUIDELINES (TAPE, TYPE III OR THERMOPLASTIC
EXTRUSION EXCEPT FOR BUS BAYS) (GUIDELINES FOR TURNING
MOVEMENTS THROUGH INTERSECTIONS SHALL BE YELLOW)
 - TRANSVERSE MEDIAN MARKING (TAPE, TYPE II OR
THERMOPLASTIC EXTRUSION)
 - TRANSVERSE SHOULDER MARKING (TAPE, TYPE II
OR THERMOPLASTIC EXTRUSION)
 - PAVEMENT ARROW (TAPE, TYPE III OR THERMOPLASTIC EXTRUSION)
 - CROSSWALK AND STOP LINE. ALL STOP LINES SHALL BE
10'-0" FROM CROSSWALK UNLESS OTHERWISE NOTED.
THE CIRCLED NUMBER INDICATES THE NUMBER OF LANES
FOR PAYMENT (TAPE, TYPE III OR THERMOPLASTIC EXTRUSION)
 - BIKE LANE MARKING (PAINT)
 - EXISTING SIGN(S) AND POST(S) TO REMAIN
 - REMOVE EXISTING SIGN(S) AND POST(S)
 - REMOVE EXISTING AND INSTALL NEW SIGN(S) AND POST(S)
 - INSTALL NEW SIGN(S) AND POST(S)
 - RELOCATE EXISTING SIGN(S) AND POST(S)
 - REMOVE EXT'G AND INSTALL NEW SIGN(S) ON
TRAFFIC SIGNAL POST(S)

DATE	DATE	DATE	DATE	DATE
DESIGNED BY	DRAWN BY	CHECKED BY	NOTED BY	PLOTTED BY
DATE	DATE	DATE	DATE	DATE

INTERSECTION - KAAHUMANU AVENUE / LUNALILO STREET

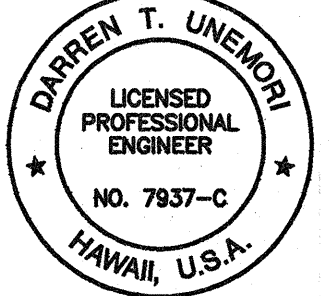

THIS WORK WAS PREPARED BY ME
OR UNDER MY SUPERVISION
Signature: [Signature] 4/14/00

STATE OF HAWAII
DEPARTMENT OF TRANSPORTATION
HIGHWAYS DIVISION
INTERSECTION STRIPING & SIGNAGE PLAN
MAIN STREET RESURFACING
CENTRAL AVENUE TO KAAHUMANU AVENUE
AND
KAAHUMANU AVENUE RESURFACING
MAIN STREET TO HOBRON AVENUE
Fed. Aid Project No. NH-032-1(8)

SCALE: AS NOTED
SHEET No. 2 OF 15 SHEETS

[illegible]

4 EACH TYPE "A" RAISED PAVEMENT MARKERS AT 40'-0" O.C.

4" DOUBLE SOLID YELLOW STRIPES WITH TYPE "H" RAISED PAVEMENT MARKERS AT 20'-0" O.C. (TAPE, TYPE I OR THERMOPLASTIC EXTRUSION)

8" SOLID WHITE STRIPE W/ TYPE "C" RAISED PAVEMENT MARKERS AT 20'-0" O.C. (TAPE, TYPE I OR THERMOPLASTIC EXTRUSION)

4" YELLOW EDGE STRIPE WITH TYPE "H" RAISED PAVEMENT MARKERS AT 40'-0" O.C. (TAPE, TYPE II OR THERMOPLASTIC EXTRUSION)

CHANNELIZING ISLAND OR DECELERATION LANE GORE (TAPE, TYPE II OR THERMOPLASTIC EXTRUSION)

4" OR 8" WHITE, EDGE STRIPE W/ TYPE "C" RAISED PAVEMENT MARKERS AT 40'-0" O.C. (TAPE, TYPE II OR THERMOPLASTIC EXTRUSION)

4" WHITE GUIDELINES (TAPE, TYPE III OR THERMOPLASTIC EXTRUSION EXCEPT FOR BUS BAYS) (GUIDELINES FOR TURNING MOVEMENTS THROUGH INTERSECTIONS SHALL BE YELLOW)

TRANSVERSE MEDIAN MARKING (TAPE, TYPE II OR THERMOPLASTIC EXTRUSION)

TRANSVERSE SHOULDER MARKING (TAPE, TYPE II OR THERMOPLASTIC EXTRUSION)

PAVEMENT ARROW (TAPE, TYPE III OR THERMOPLASTIC EXTRUSION)

CROSSWALK AND STOP LINE. ALL STOP LINES SHALL BE 10'-0" FROM CROSSWALK UNLESS OTHERWISE NOTED. THE CIRCLED NUMBER INDICATES THE NUMBER OF LANES FOR PAYMENT (TAPE, TYPE III OR THERMOPLASTIC EXTRUSION)

BIKE LANE MARKING (PAINT)

EXISTING SIGN(S) AND POST(S) TO REMAIN

REMOVE EXISTING SIGN(S) AND POST(S)

REMOVE EXISTING AND INSTALL NEW SIGN(S) AND POST(S)

INSTALL NEW SIGN(S) AND POST(S)


RELOCATE EXISTING SIGN(S) AND POST(S)

REMOVE EXT'G AND INSTALL NEW SIGN(S) ON TRAFFIC SIGNAL POST(S)

66


98proj/98049/conplans/in-str0a.dwg

FED. ROAD DIST. NO.	STATE	FED. AID PROJ. NO.	FISCAL YEAR	SHEET NO.	TOTAL SHEETS
HAWAII	HAW.	NH-032-1(8)	2000	67	111

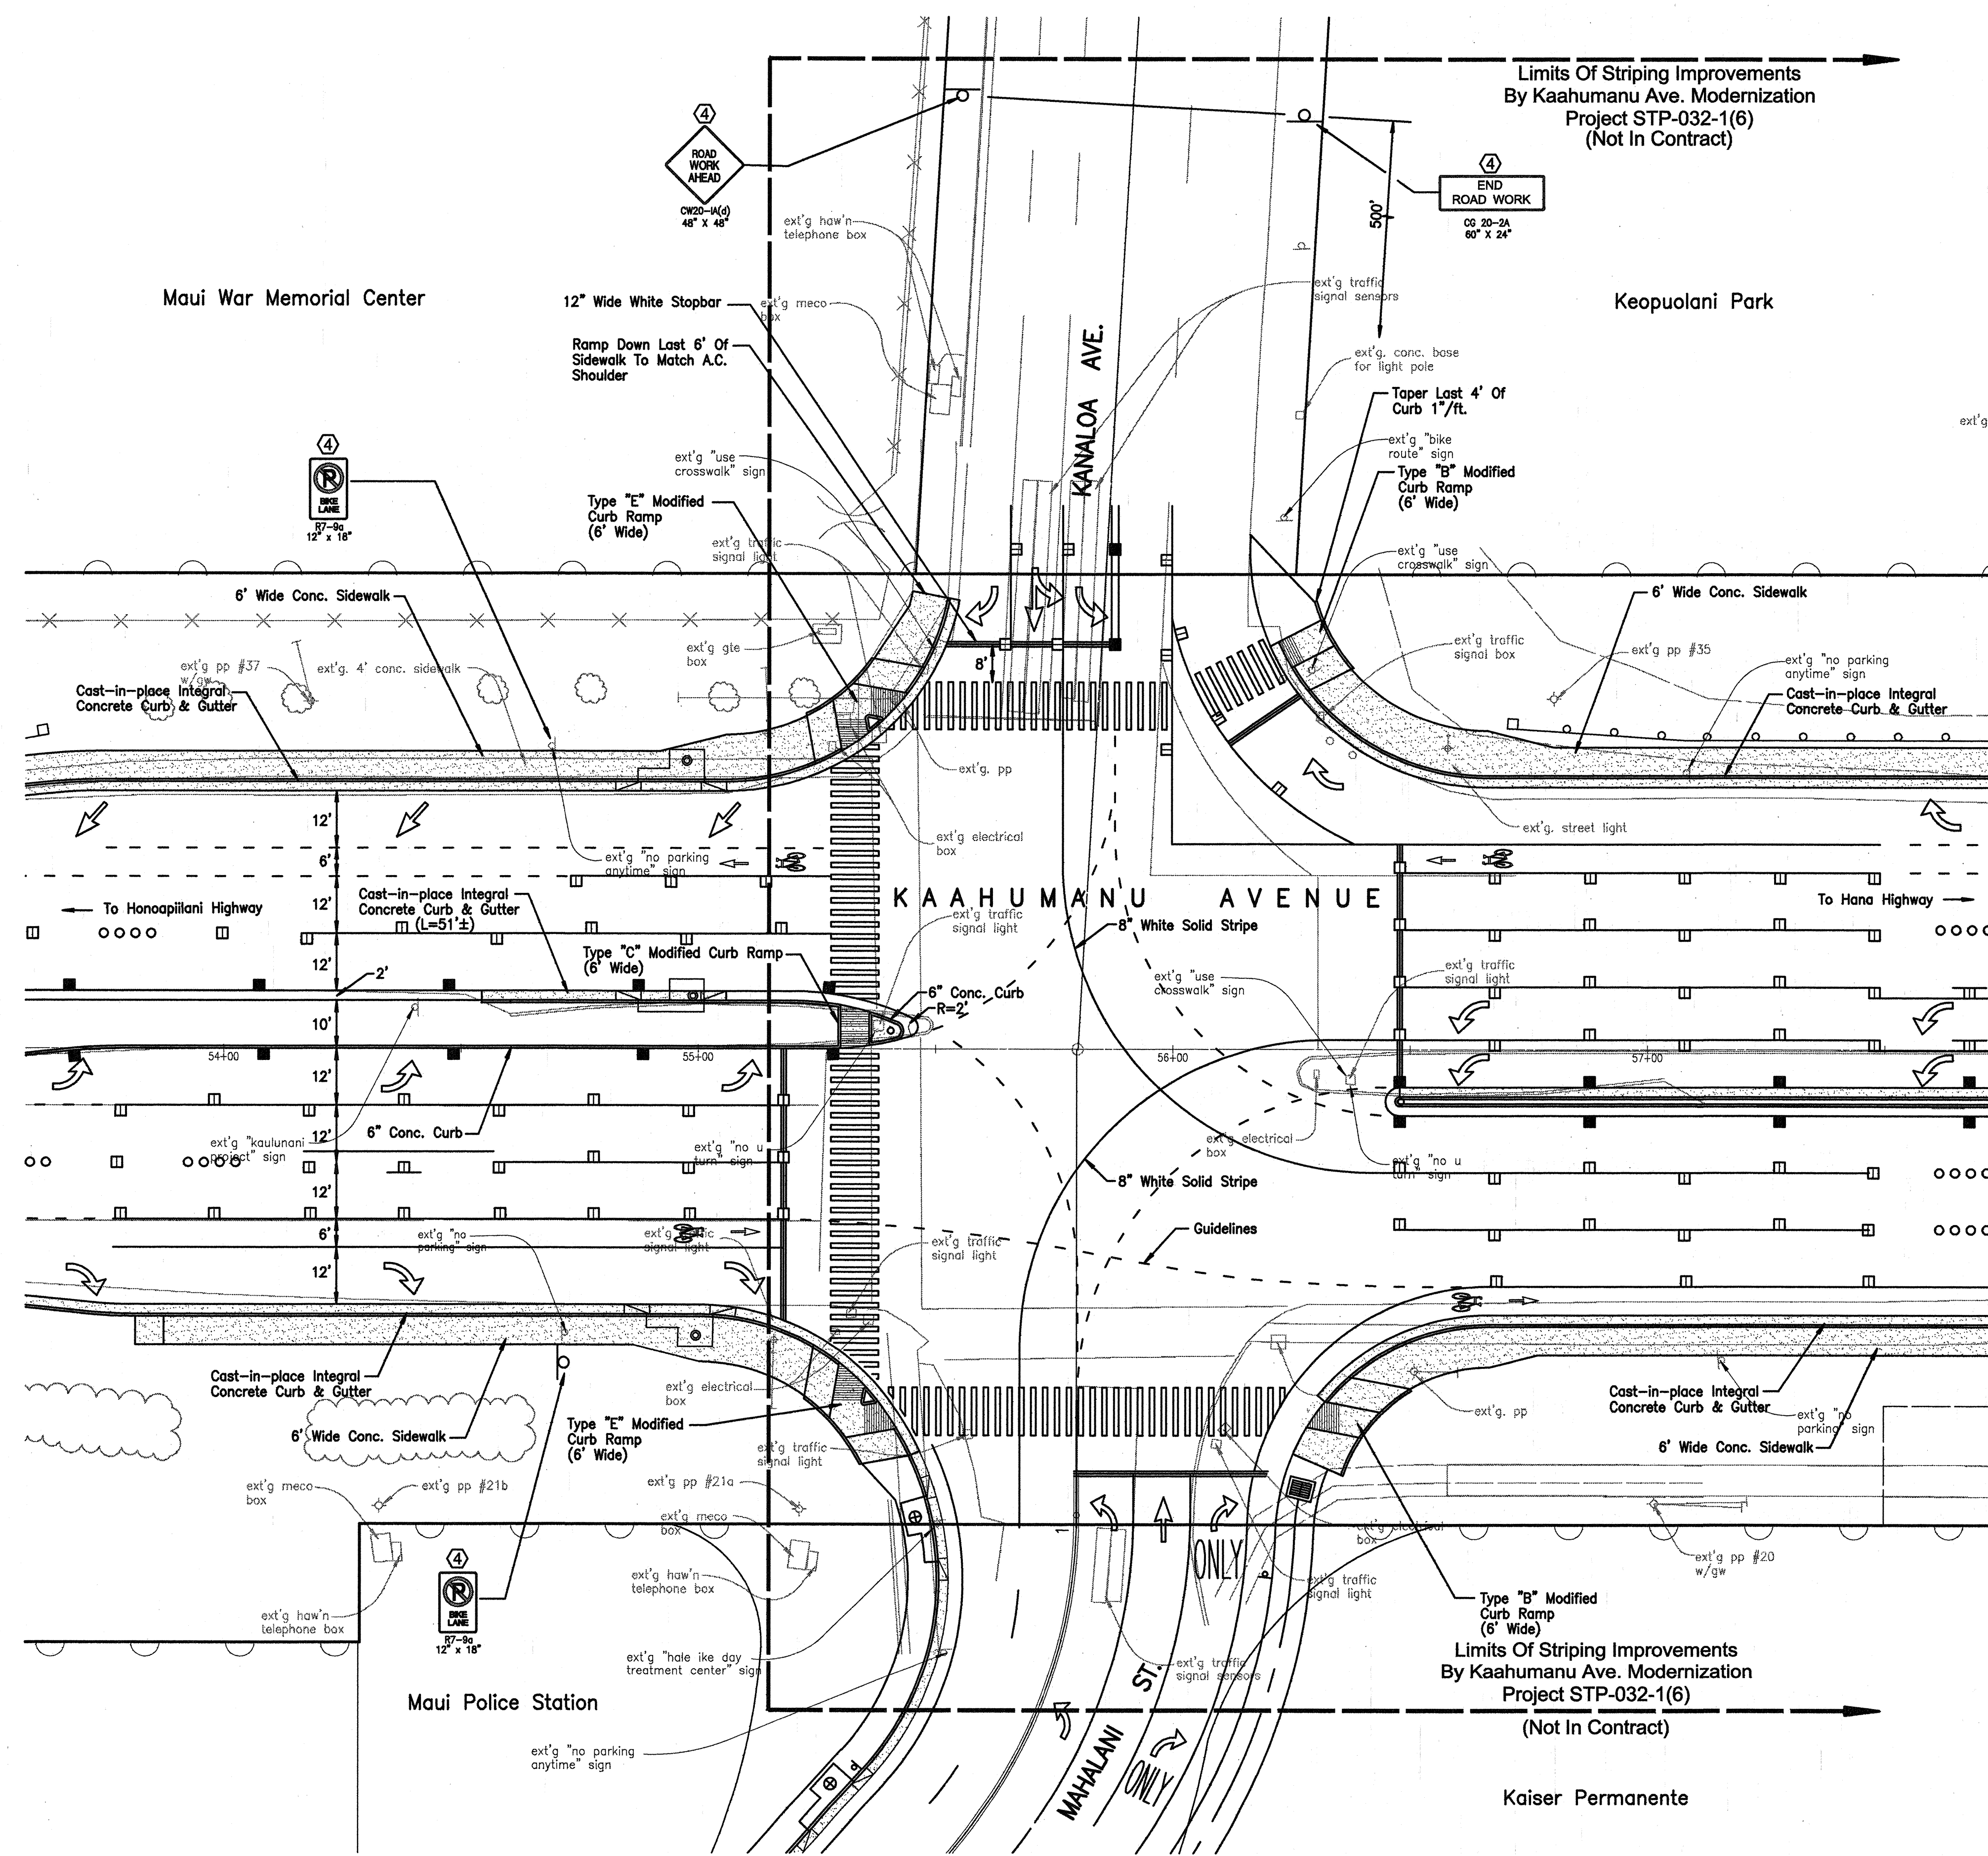

LEGEND:

- 4" EACH TYPE "A" RAISED PAVEMENT MARKERS
TYPE "C" RAISED PAVEMENT MARKERS AT 40'-0" O.C.
- 4" DOUBLE SOLID YELLOW STRIPES WITH TYPE "H"
RAISED PAVEMENT MARKERS AT 20'-0" O.C.
(TAPE, TYPE I OR THERMOPLASTIC EXTRUSION)
- 8" SOLID WHITE STRIPE W/ TYPE "C" RAISED PAVEMENT
MARKERS AT 20'-0" O.C. (TAPE, TYPE I OR THERMOPLASTIC
EXTRUSION)
- 4" YELLOW EDGE STRIPE WITH TYPE "H" RAISED
PAVEMENT MARKERS AT 40'-0" O.C.
(TAPE, TYPE II OR THERMOPLASTIC EXTRUSION)
- CHANNELIZING ISLAND OR DECELERATION LANE GORE
(TAPE, TYPE II OR THERMOPLASTIC EXTRUSION)
- 4" OR 8" WHITE EDGE STRIPE W/ TYPE "C" RAISED PAVEMENT
MARKERS AT 40'-0" O.C. (TAPE, TYPE II OR THERMOPLASTIC
EXTRUSION)
- 4" WHITE GUIDELINES (TAPE, TYPE III OR THERMOPLASTIC
EXTRUSION EXCEPT FOR BUS BAYS) (GUIDELINES FOR TURNING
MOVEMENTS THROUGH INTERSECTIONS SHALL BE YELLOW)
- TRANSVERSE MEDIAN MARKING (TAPE, TYPE II OR
THERMOPLASTIC EXTRUSION)
- TRANSVERSE SHOULDER MARKING (TAPE, TYPE II
OR THERMOPLASTIC EXTRUSION)
- PAVEMENT ARROW (TAPE, TYPE III OR THERMOPLASTIC EXTRUSION)
- CROSSWALK AND STOP LINE. ALL STOP LINES SHALL BE
10'-0" FROM CROSSWALK UNLESS OTHERWISE NOTED.
THE CIRCLED NUMBER INDICATES THE NUMBER OF LANES
FOR PAYMENT (TAPE, TYPE III OR THERMOPLASTIC EXTRUSION)
- BIKE LANE MARKING (PAINT)
- EXISTING SIGN(S) AND POST(S) TO REMAIN
- REMOVE EXISTING SIGN(S) AND POST(S)
- REMOVE EXISTING AND INSTALL NEW SIGN(S) AND POST(S)
- INSTALL NEW SIGN(S) AND POST(S)
- RELOCATE EXISTING SIGN(S) AND POST(S)
- REMOVE EXT'G AND INSTALL NEW SIGN(S) ON
TRAFFIC SIGNAL POST(S)

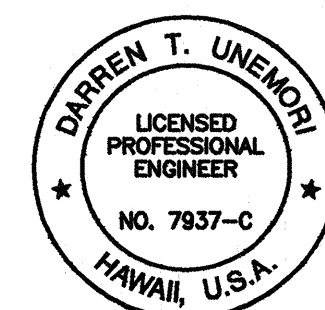

THIS WORK WAS PREPARED BY ME
OR UNDER MY SUPERVISION


Signature

STATE OF HAWAII
DEPARTMENT OF TRANSPORTATION
HIGHWAYS DIVISION

INTERSECTION STRIPING & SIGNAGE PLAN

MAIN STREET RESURFACING
CENTRAL AVENUE TO KAAHUMANU AVENUE
AND
KAAHUMANU AVENUE RESURFACING
MAIN STREET TO HOBSON AVENUE
Fed. Aid Project No. NH-032-1(8)

SCALE: AS NOTED


SHEET No. 4 OF 15 SHEETS

INTERSECTION - KAAHUMANU AVENUE / MAHALANI STREET

ORIGINAL PLAN	SURVEY PLOTTED BY _____ DATE _____	
	DRAWN BY _____ DATE _____	
NOTE BOOK	TRACED BY _____ DATE _____	
	DESIGNED BY _____ DATE _____	
	QUANTITIES BY _____ DATE _____	
	CHECKED BY _____ DATE _____	
		No. _____

98proj/98049/conplans/in-str0a.dwg

FED. ROAD DIST. NO.	STATE	FED. AID PROJ. NO.	FISCAL YEAR	SHEET NO.	TOTAL SHEETS
HAWAII	HAW.	NH-032-1(8)	2000	68	111

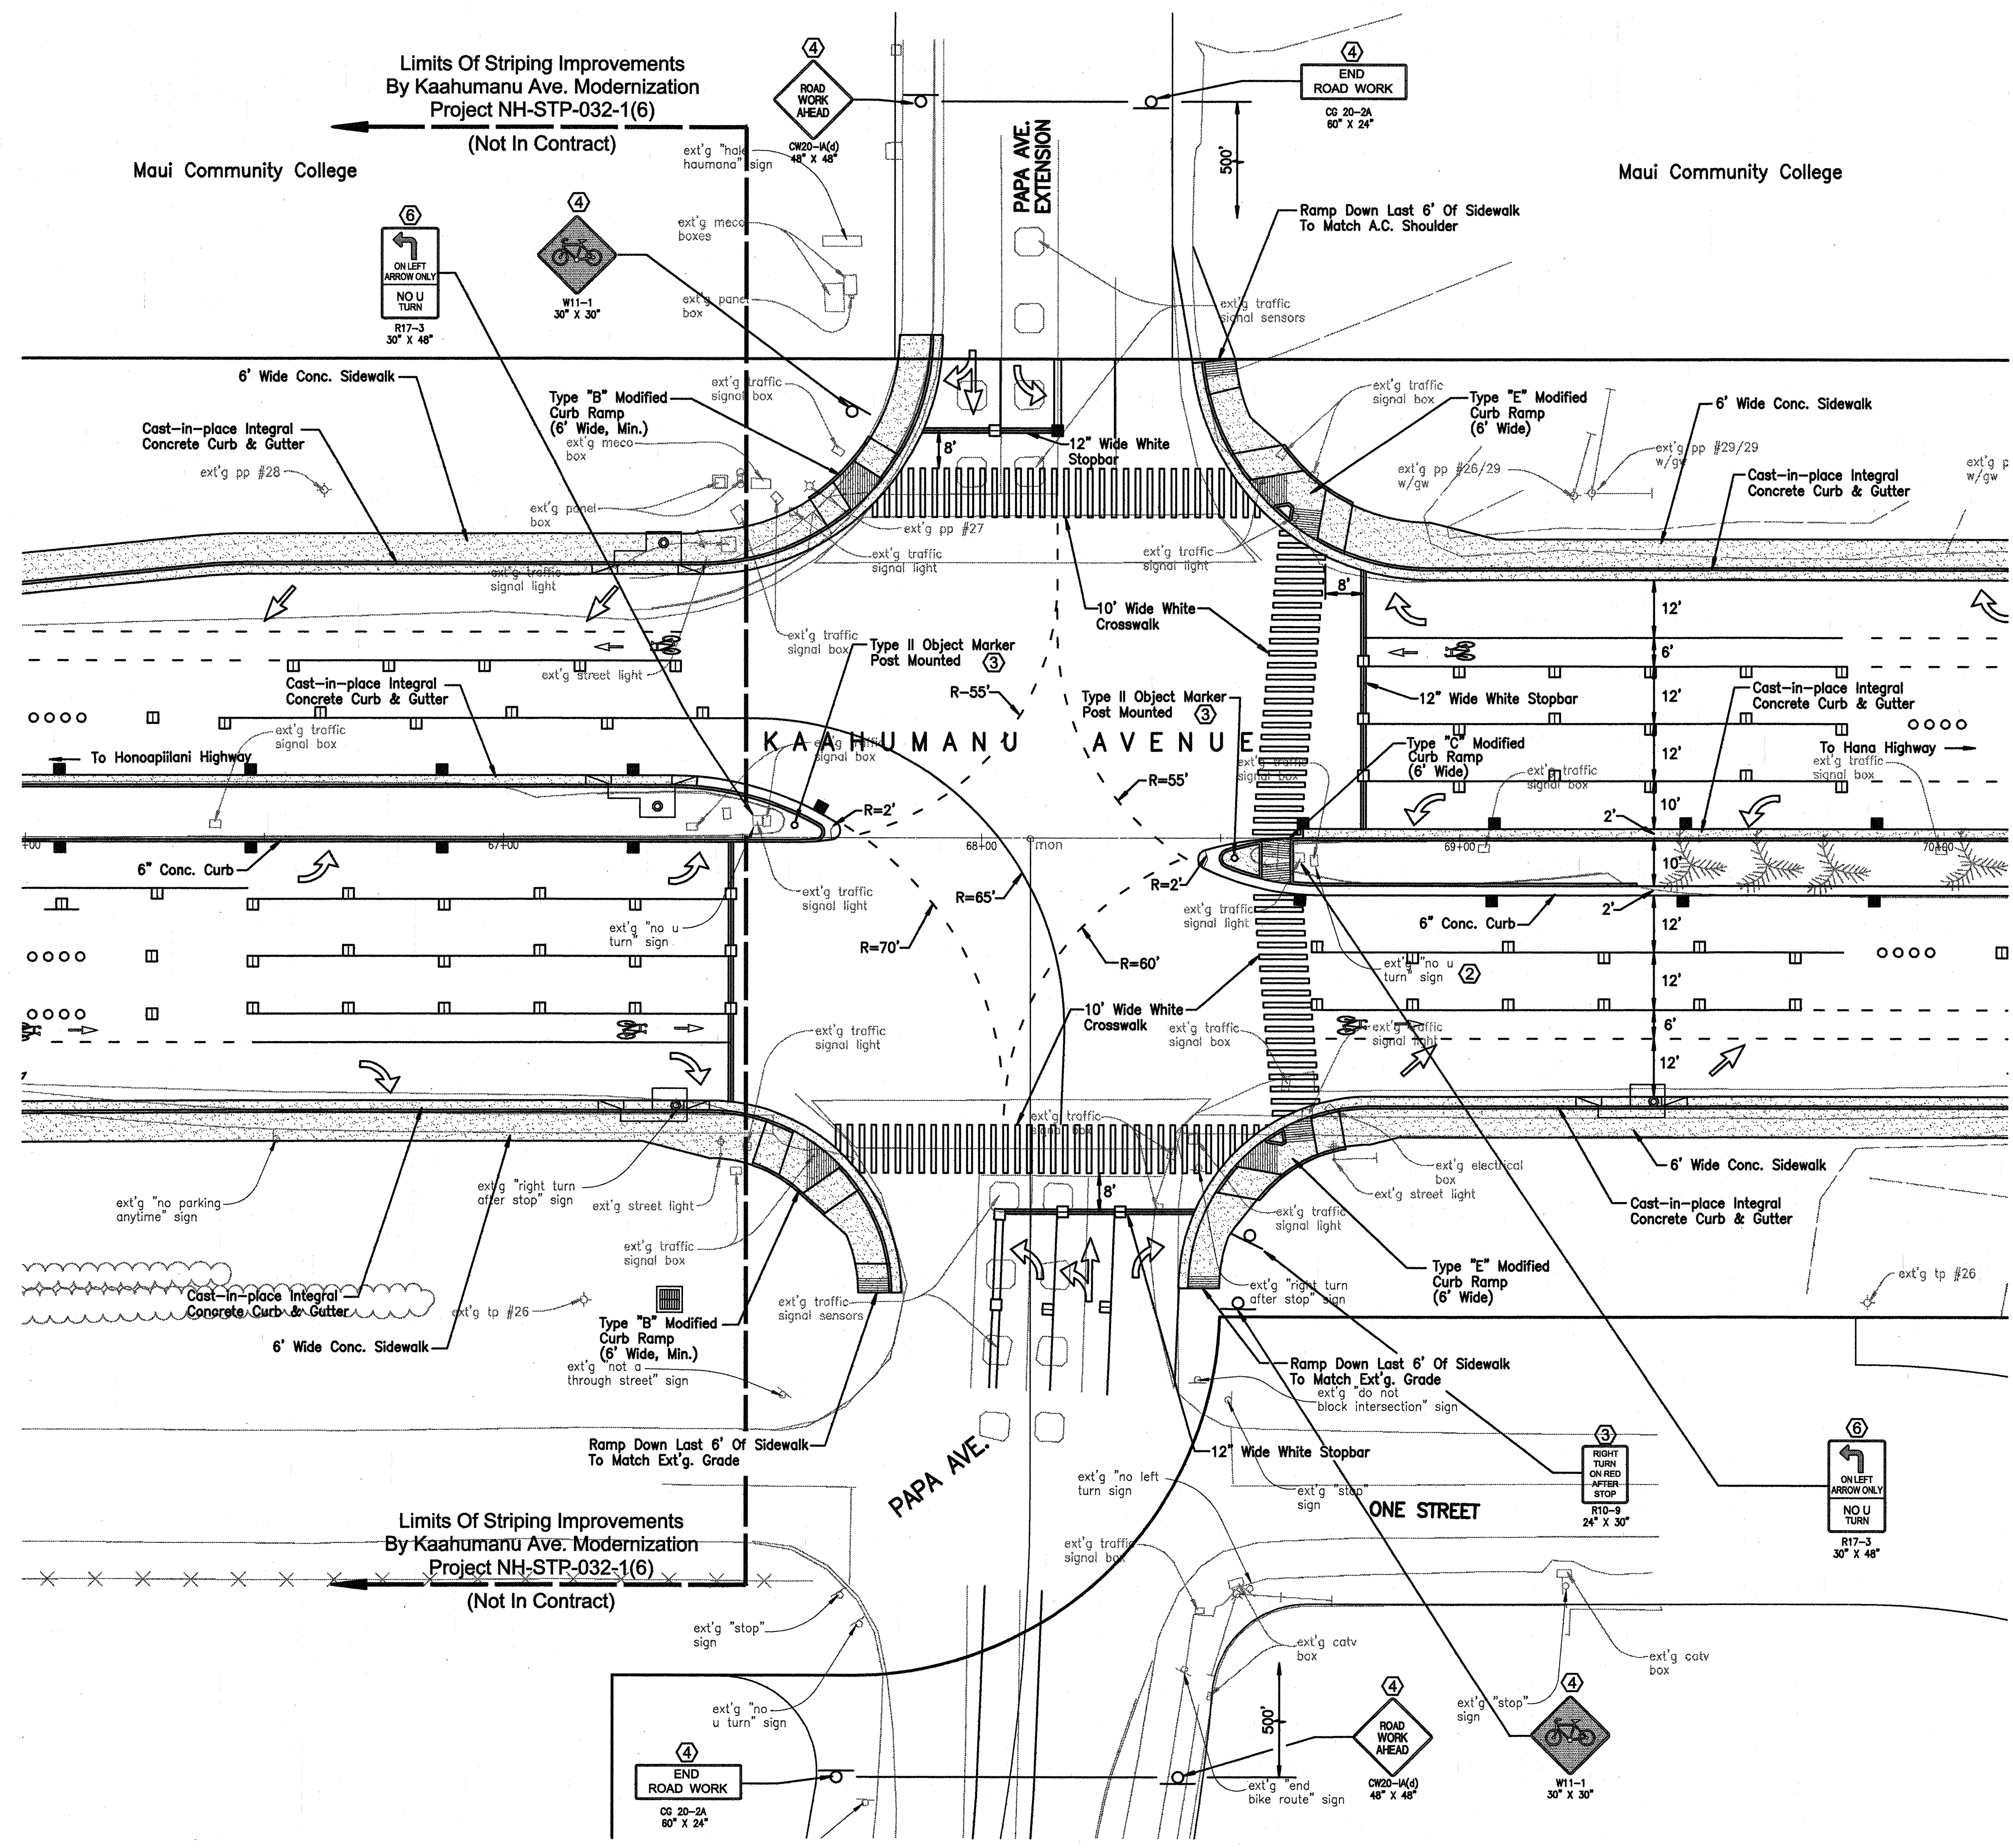

LEGEND:

- 4 EACH TYPE "A" RAISED PAVEMENT MARKERS TYPE "C" RAISED PAVEMENT MARKERS AT 40'-0" O.C.
- 4" DOUBLE SOLID YELLOW STRIPES WITH TYPE "H" RAISED PAVEMENT MARKERS AT 20'-0" O.C. (TAPE, TYPE I OR THERMOPLASTIC EXTRUSION)
- 8" SOLID WHITE STRIPE W/ TYPE "C" RAISED PAVEMENT MARKERS AT 20'-0" O.C. (TAPE, TYPE I OR THERMOPLASTIC EXTRUSION)
- 4" YELLOW EDGE STRIPE WITH TYPE "H" RAISED PAVEMENT MARKERS AT 40'-0" O.C. (TAPE, TYPE II OR THERMOPLASTIC EXTRUSION)
- CHANNELIZING ISLAND OR DECELERATION LANE GORE (TAPE, TYPE II OR THERMOPLASTIC EXTRUSION)
- 4" OR 8" WHITE EDGE STRIPE W/ TYPE "C" RAISED PAVEMENT MARKERS AT 40'-0" O.C. (TAPE, TYPE II OR THERMOPLASTIC EXTRUSION)
- 4" WHITE GUIDELINES (TAPE, TYPE III OR THERMOPLASTIC EXTRUSION EXCEPT FOR BUS BAYS) (GUIDELINES FOR TURNING MOVEMENTS THROUGH INTERSECTIONS SHALL BE YELLOW)
- TRANSVERSE MEDIAN MARKING (TAPE, TYPE II OR THERMOPLASTIC EXTRUSION)
- TRANSVERSE SHOULDER MARKING (TAPE, TYPE II OR THERMOPLASTIC EXTRUSION)
- PAVEMENT ARROW (TAPE, TYPE III OR THERMOPLASTIC EXTRUSION)
- CROSSWALK AND STOP LINE. ALL STOP LINES SHALL BE 10'-0" FROM CROSSWALK UNLESS OTHERWISE NOTED. THE CIRCLED NUMBER INDICATES THE NUMBER OF LANES FOR PAYMENT (TAPE, TYPE III OR THERMOPLASTIC EXTRUSION)
- BIKE LANE MARKING (PAINT)
- EXISTING SIGN(S) AND POST(S) TO REMAIN
- REMOVE EXISTING SIGN(S) AND POST(S)
- REMOVE EXISTING AND INSTALL NEW SIGN(S) AND POST(S)
- INSTALL NEW SIGN(S) AND POST(S)
- RELOCATE EXISTING SIGN(S) AND POST(S)
- REMOVE EXISTING AND INSTALL NEW SIGN(S) ON TRAFFIC SIGNAL POST(S)

DATE	DATE	DATE	DATE	DATE	DATE
DESIGNED BY	DESIGNED BY	DESIGNED BY	DESIGNED BY	DESIGNED BY	DESIGNED BY
CHECKED BY	CHECKED BY	CHECKED BY	CHECKED BY	CHECKED BY	CHECKED BY
NO.	NO.	NO.	NO.	NO.	NO.

DIARMEN T. UNGERL
LICENSED PROFESSIONAL ENGINEER
NO. 7937-C
HAWAII, U.S.A.

THIS WORK WAS PREPARED BY ME OR UNDER MY SUPERVISION

Signature

STATE OF HAWAII
DEPARTMENT OF TRANSPORTATION
HIGHWAYS DIVISION

INTERSECTION STRIPING & SIGNAGE PLAN


MAIN STREET RESURFACING
CENTRAL AVENUE TO KAAHUMANU AVENUE
AND
KAAHUMANU AVENUE RESURFACING
MAIN STREET TO HOBSON AVENUE
Fed. Aid Project No. NH-032-1(8)

SCALE: AS NOTED

SHEET No. 5 OF 15 SHEETS

INTERSECTION - KAAHUMANU AVENUE / PAPA AVENUE

FED. ROAD DIST. NO.	STATE	FED. AID PROJ. NO.	FISCAL YEAR	SHEET NO.	TOTAL SHEETS
HAWAII	HAW.	NH-032-1(8)	2000	69	111

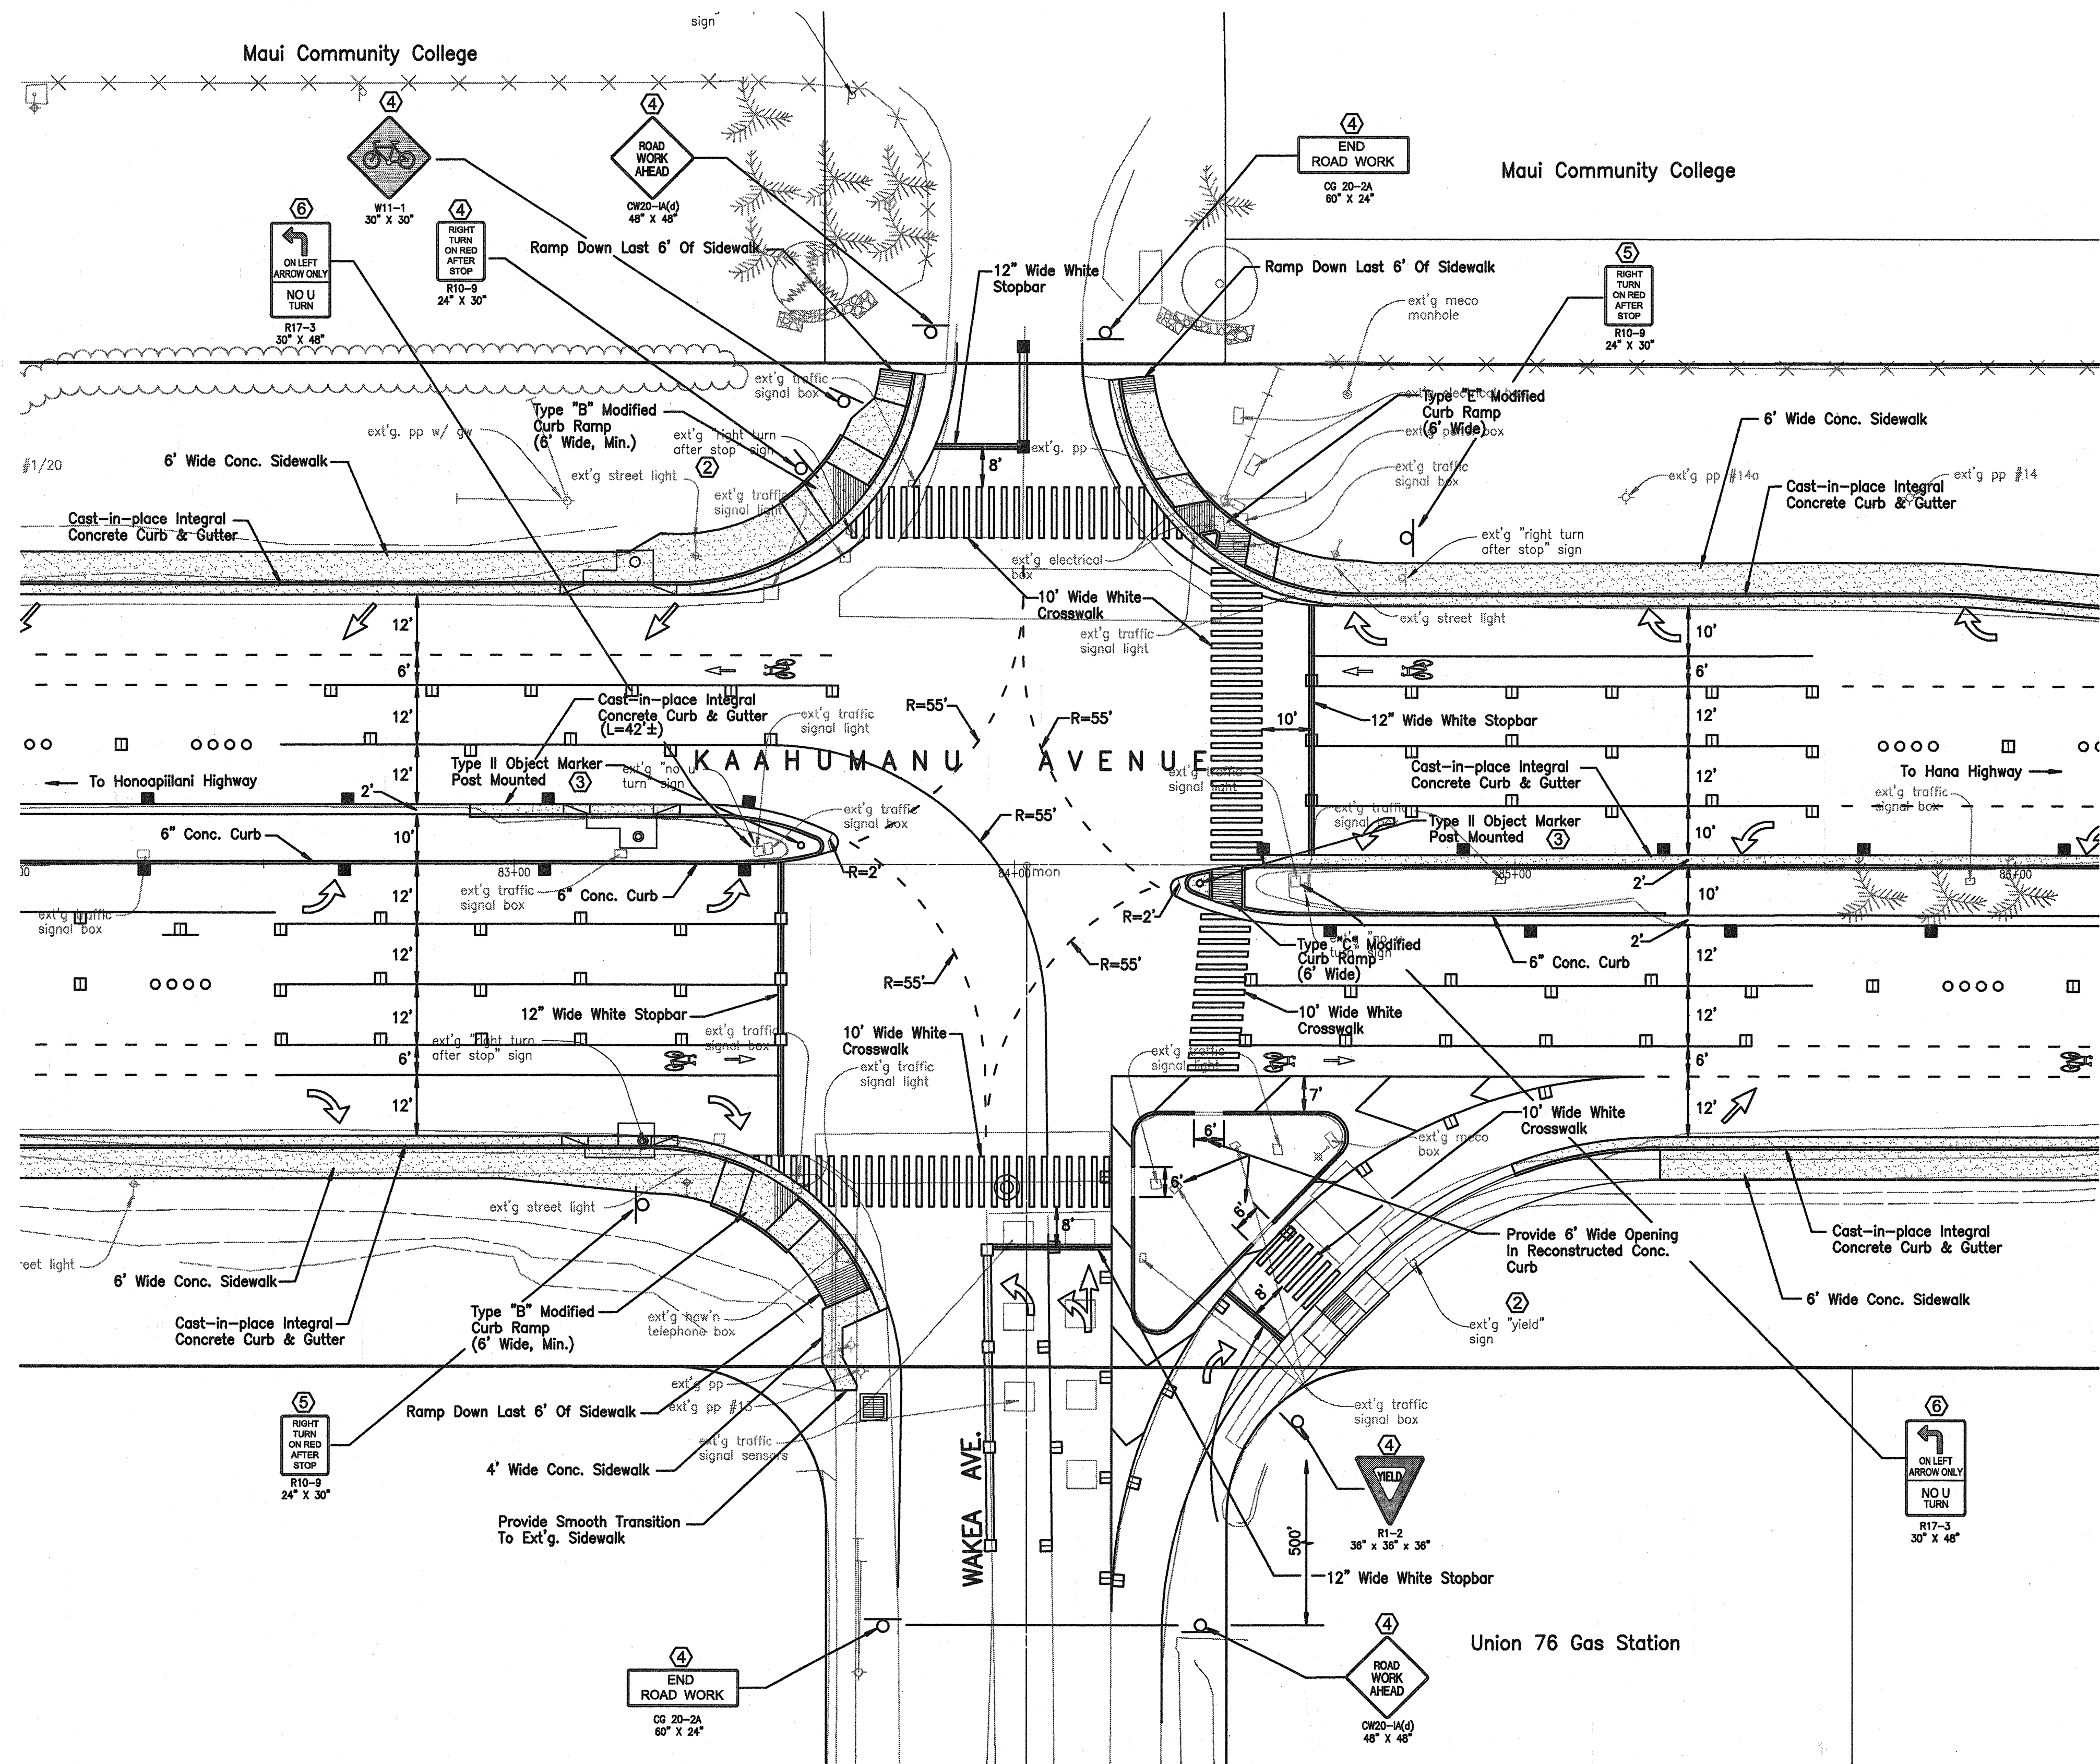


LEGEND:

- 4 EACH TYPE "A" RAISED PAVEMENT MARKERS
TYPE "C" RAISED PAVEMENT MARKERS AT 40'-0" O.C.
- 4" DOUBLE SOLID YELLOW STRIPES WITH TYPE "H"
RAISED PAVEMENT MARKERS AT 20'-0" O.C.
(TAPE, TYPE I OR THERMOPLASTIC EXTRUSION)
- 8" SOLID WHITE STRIPE W/ TYPE "C" RAISED PAVEMENT
MARKERS AT 20'-0" O.C. (TAPE, TYPE I OR THERMOPLASTIC
EXTRUSION)
- 4" YELLOW EDGE STRIPE WITH TYPE "H" RAISED
PAVEMENT MARKERS AT 40'-0" O.C.
(TAPE, TYPE II OR THERMOPLASTIC EXTRUSION)
- CHANNELIZING ISLAND OR DECELERATION LANE GORE
(TAPE, TYPE II OR THERMOPLASTIC EXTRUSION)
- 4" OR 8" WHITE EDGE STRIPE W/ TYPE "C" RAISED PAVEMENT
MARKERS AT 40'-0" O.C. (TAPE, TYPE II OR THERMOPLASTIC
EXTRUSION)
- 4" WHITE GUIDELINES (TAPE, TYPE III OR THERMOPLASTIC
EXTRUSION EXCEPT FOR BUS BAYS) (GUIDELINES FOR TURNING
MOVEMENTS THROUGH INTERSECTIONS SHALL BE YELLOW)
- TRANSVERSE MEDIAN MARKING (TAPE, TYPE II OR
THERMOPLASTIC EXTRUSION)
- TRANSVERSE SHOULDER MARKING (TAPE, TYPE II
OR THERMOPLASTIC EXTRUSION)
- PAVEMENT ARROW (TAPE, TYPE III OR THERMOPLASTIC EXTRUSION)
- CROSSWALK AND STOP LINE. ALL STOP LINES SHALL BE
10'-0" FROM CROSSWALK UNLESS OTHERWISE NOTED.
THE CIRCLED NUMBER INDICATES THE NUMBER OF LANES
FOR PAYMENT (TAPE, TYPE III OR THERMOPLASTIC EXTRUSION)
- BIKE LANE MARKING (PAINT)
- EXISTING SIGN(S) AND POST(S) TO REMAIN
- REMOVE EXISTING SIGN(S) AND POST(S)
- REMOVE EXISTING AND INSTALL NEW SIGN(S) AND POST(S)
- INSTALL NEW SIGN(S) AND POST(S)
- RELOCATE EXISTING SIGN(S) AND POST(S)
- REMOVE EXT'G AND INSTALL NEW SIGN(S) ON
TRAFFIC SIGNAL POST(S)

SURVEY PLOTTED BY	DATE
DRAWN BY	DATE
DESIGNED BY	DATE
QUANTITIES BY	DATE
CHECKED BY	DATE

98pca/28049/complan/11-10-00.dwg

INTERSECTION - KAAHUMANU AVENUE / WAKEA AVENUE

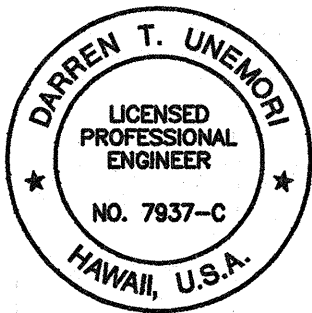

THIS WORK WAS PREPARED BY ME
OR UNDER MY SUPERVISION
Signature 4/12/00

STATE OF HAWAII
DEPARTMENT OF TRANSPORTATION
HIGHWAYS DIVISION


INTERSECTION STRIPING & SIGNAGE PLAN

MAIN STREET RESURFACING
CENTRAL AVENUE TO KAAHUMANU AVENUE
AND
KAAHUMANU AVENUE RESURFACING
MAIN STREET TO HOBSON AVENUE
Fed. Aid Project No. NH-032-1(8)

SCALE: AS NOTED

FED. ROAD DIST. NO.	STATE	FED. AID PROJ. NO.	FISCAL YEAR	SHEET NO.	TOTAL SHEETS
HAWAII	HAW.	NH-032-1(8)	2000	70	111

TRUE NORTH
SCALE: 1 IN. = 20 FT.

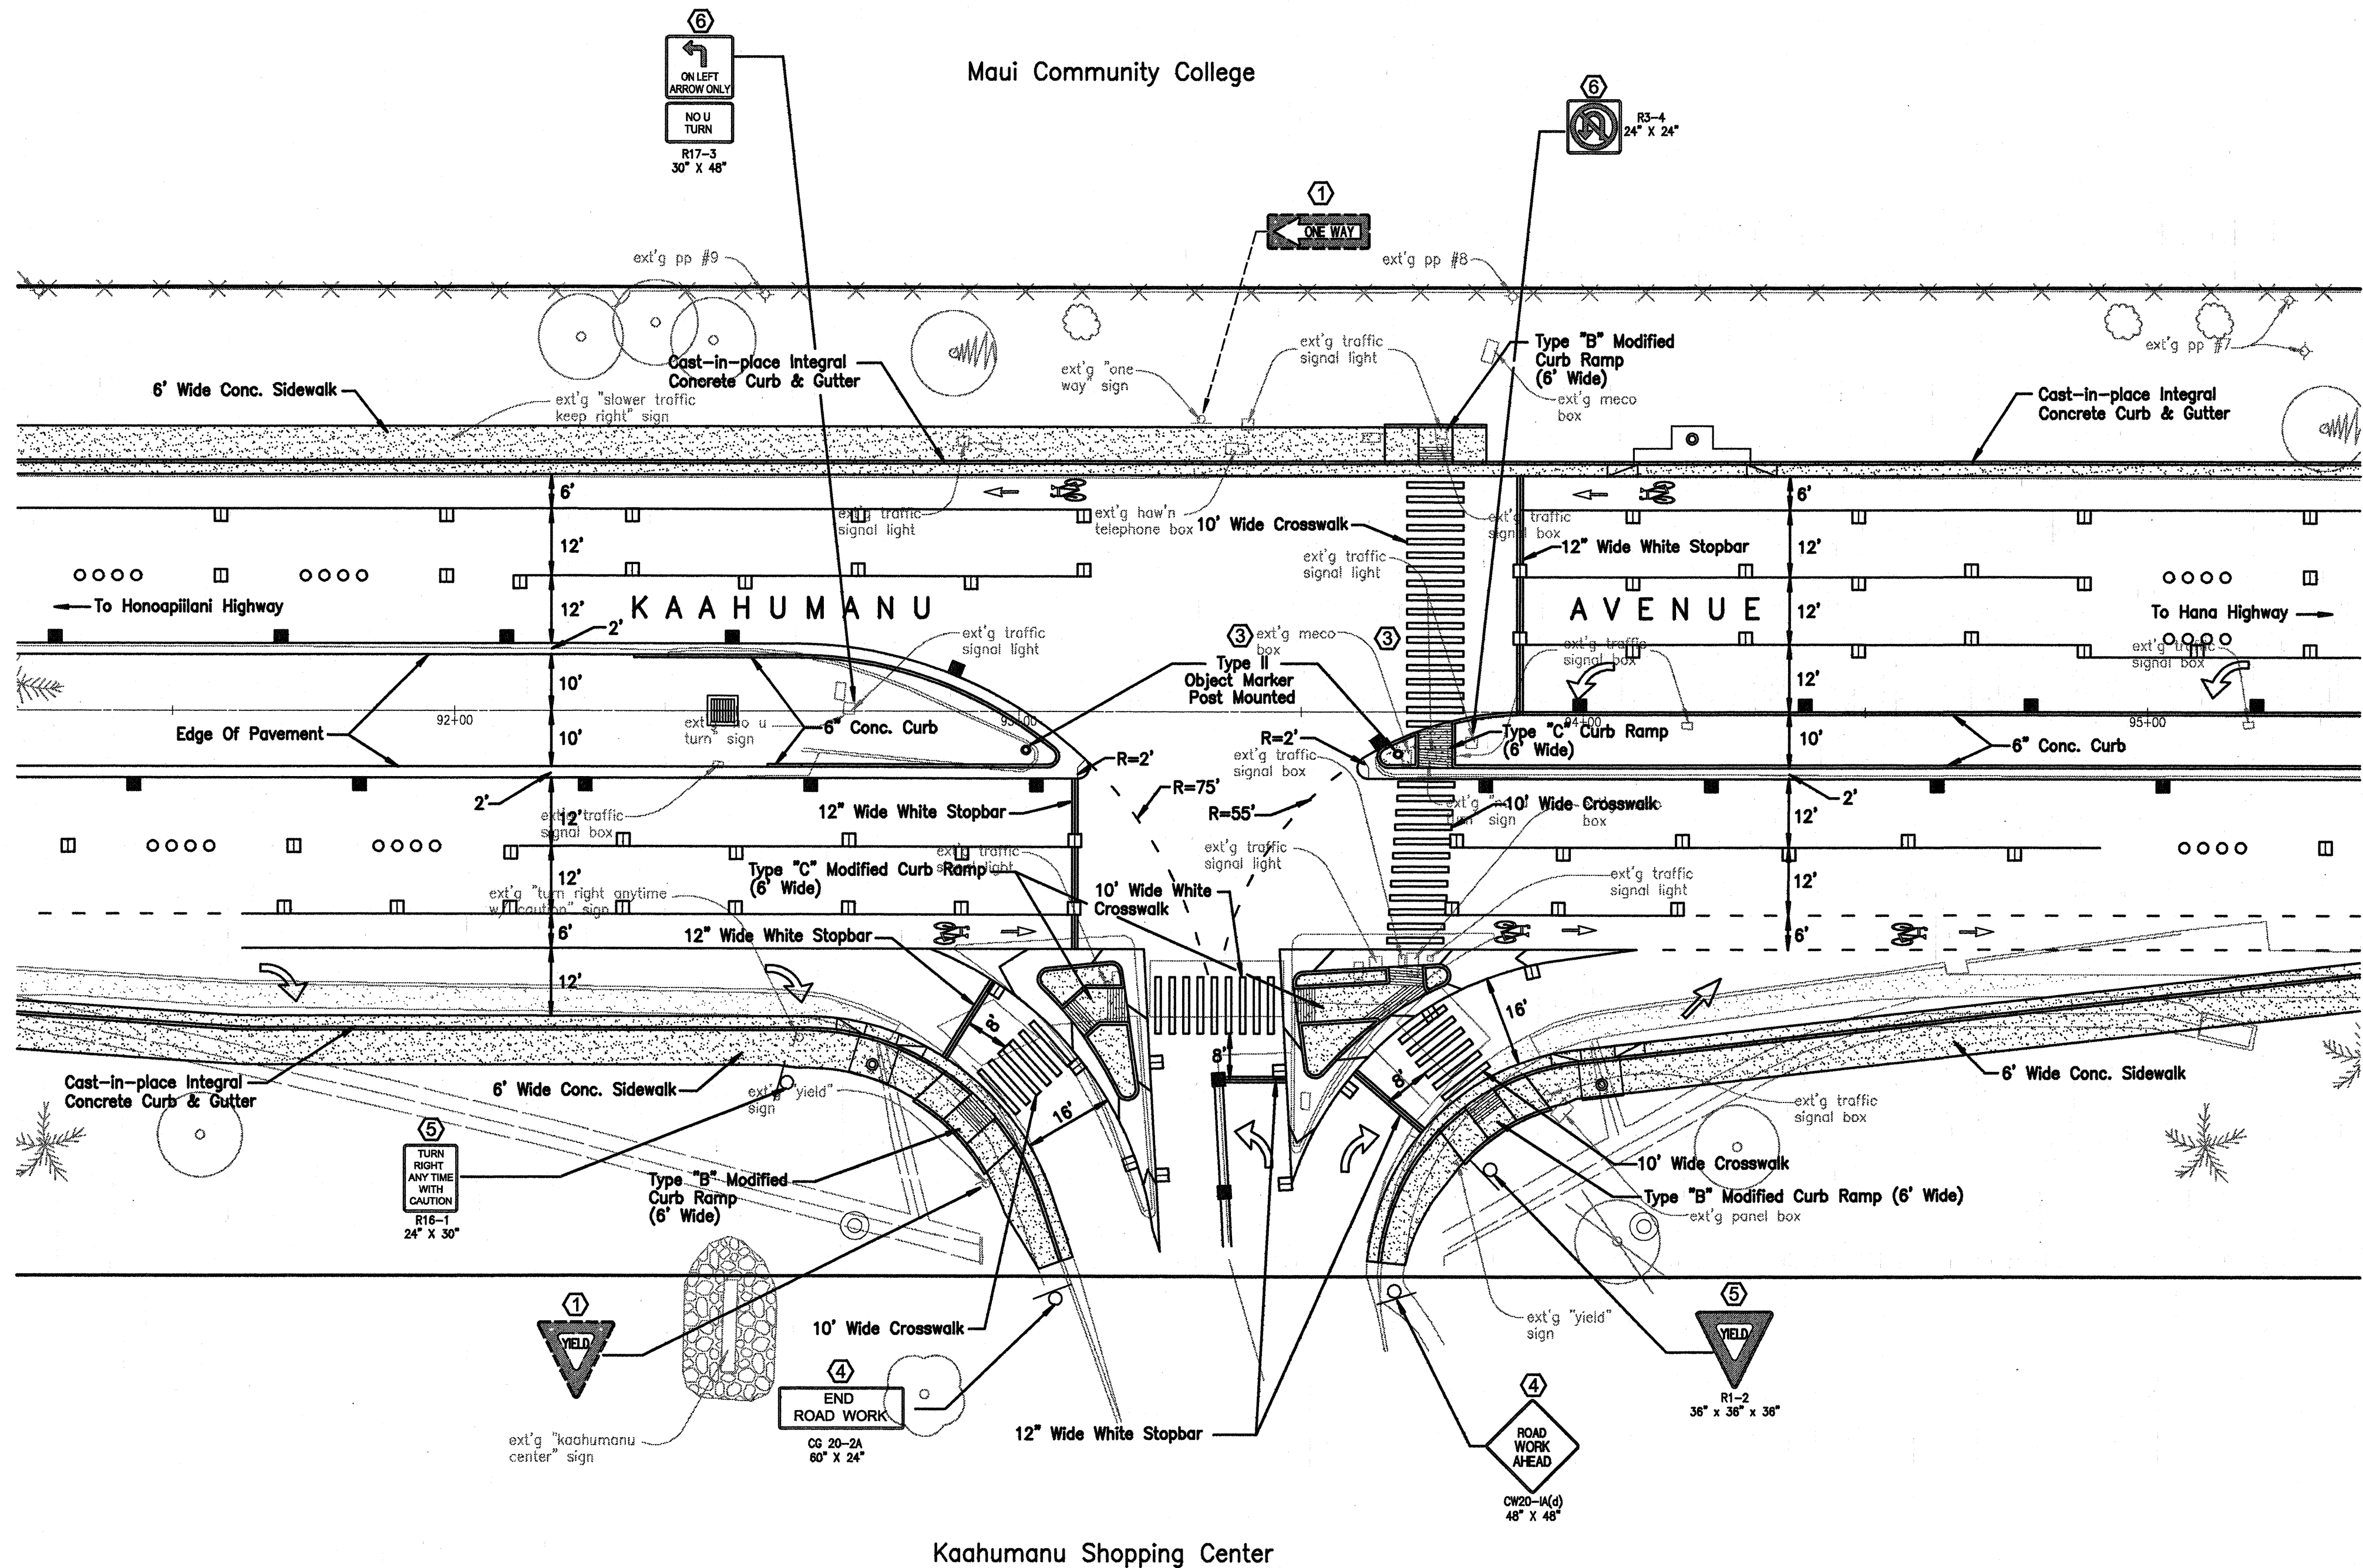

LEGEND:

- 4 EACH TYPE "A" RAISED PAVEMENT MARKERS
TYPE "C" RAISED PAVEMENT MARKERS AT 40'-0" O.C.
- 4" DOUBLE SOLID YELLOW STRIPES WITH TYPE "H" RAISED PAVEMENT MARKERS AT 20'-0" O.C. (TAPE, TYPE I OR THERMOPLASTIC EXTRUSION)
- 8" SOLID WHITE STRIPE W/ TYPE "C" RAISED PAVEMENT MARKERS AT 20'-0" O.C. (TAPE, TYPE I OR THERMOPLASTIC EXTRUSION)
- 4" YELLOW EDGE STRIPE WITH TYPE "H" RAISED PAVEMENT MARKERS AT 40'-0" O.C. (TAPE, TYPE II OR THERMOPLASTIC EXTRUSION)
- CHANNELIZING ISLAND OR DECELERATION LANE GORE (TAPE, TYPE II OR THERMOPLASTIC EXTRUSION)
- 4" OR 8" WHITE EDGE STRIPE W/ TYPE "C" RAISED PAVEMENT MARKERS AT 40'-0" O.C. (TAPE, TYPE II OR THERMOPLASTIC EXTRUSION)
- 4" WHITE GUIDELINES (TAPE, TYPE III OR THERMOPLASTIC EXTRUSION EXCEPT FOR BUS BAYS) (GUIDELINES FOR TURNING MOVEMENTS THROUGH INTERSECTIONS SHALL BE YELLOW)
- TRANSVERSE MEDIAN MARKING (TAPE, TYPE II OR THERMOPLASTIC EXTRUSION)
- TRANSVERSE SHOULDER MARKING (TAPE, TYPE II OR THERMOPLASTIC EXTRUSION)
- PAVEMENT ARROW (TAPE, TYPE III OR THERMOPLASTIC EXTRUSION)
- CROSSWALK AND STOP LINE. ALL STOP LINES SHALL BE 10'-0" FROM CROSSWALK UNLESS OTHERWISE NOTED. THE CIRCLED NUMBER INDICATES THE NUMBER OF LANES FOR PAYMENT (TAPE, TYPE III OR THERMOPLASTIC EXTRUSION)
- BIKE LANE MARKING (PAINT)
- EXISTING SIGN(S) AND POST(S) TO REMAIN
- REMOVE EXISTING SIGN(S) AND POST(S)
- REMOVE EXISTING AND INSTALL NEW SIGN(S) AND POST(S)
- INSTALL NEW SIGN(S) AND POST(S)
- RELOCATE EXISTING SIGN(S) AND POST(S)
- REMOVE EXT'G AND INSTALL NEW SIGN(S) ON TRAFFIC SIGNAL POST(S)

SURVEY PLOTTED BY	DATE
DESIGNED BY	DATE
TRACED BY	DATE
NOTE BOOK	DATE
CHECKED BY	DATE

INTERSECTION - KAAHUMANU AVENUE / KAAHUMANU SHOPPING CENTER ENTRANCE

DARREN T. UNEMORI
LICENSED PROFESSIONAL ENGINEER
NO. 7837-C
HAWAII, U.S.A.

THIS WORK WAS PREPARED BY ME
OR UNDER MY SUPERVISION

STATE OF HAWAII
DEPARTMENT OF TRANSPORTATION
HIGHWAYS DIVISION


INTERSECTION STRIPING & SIGNAGE PLAN

MAIN STREET RESURFACING
CENTRAL AVENUE TO KAAHUMANU AVENUE
AND
KAAHUMANU AVENUE RESURFACING
MAIN STREET TO HOBSON AVENUE
Fed. Aid Project No. NH-032-1(8)

SCALE: AS NOTED

SHEET No. 7 OF 15 SHEETS

FED. ROAD DIST. NO.	STATE	FED. AID PROJ. NO.	FISCAL YEAR	SHEET NO.	TOTAL SHEETS
HAWAII	HAW.	NH-032-1(8)	2000	71	111

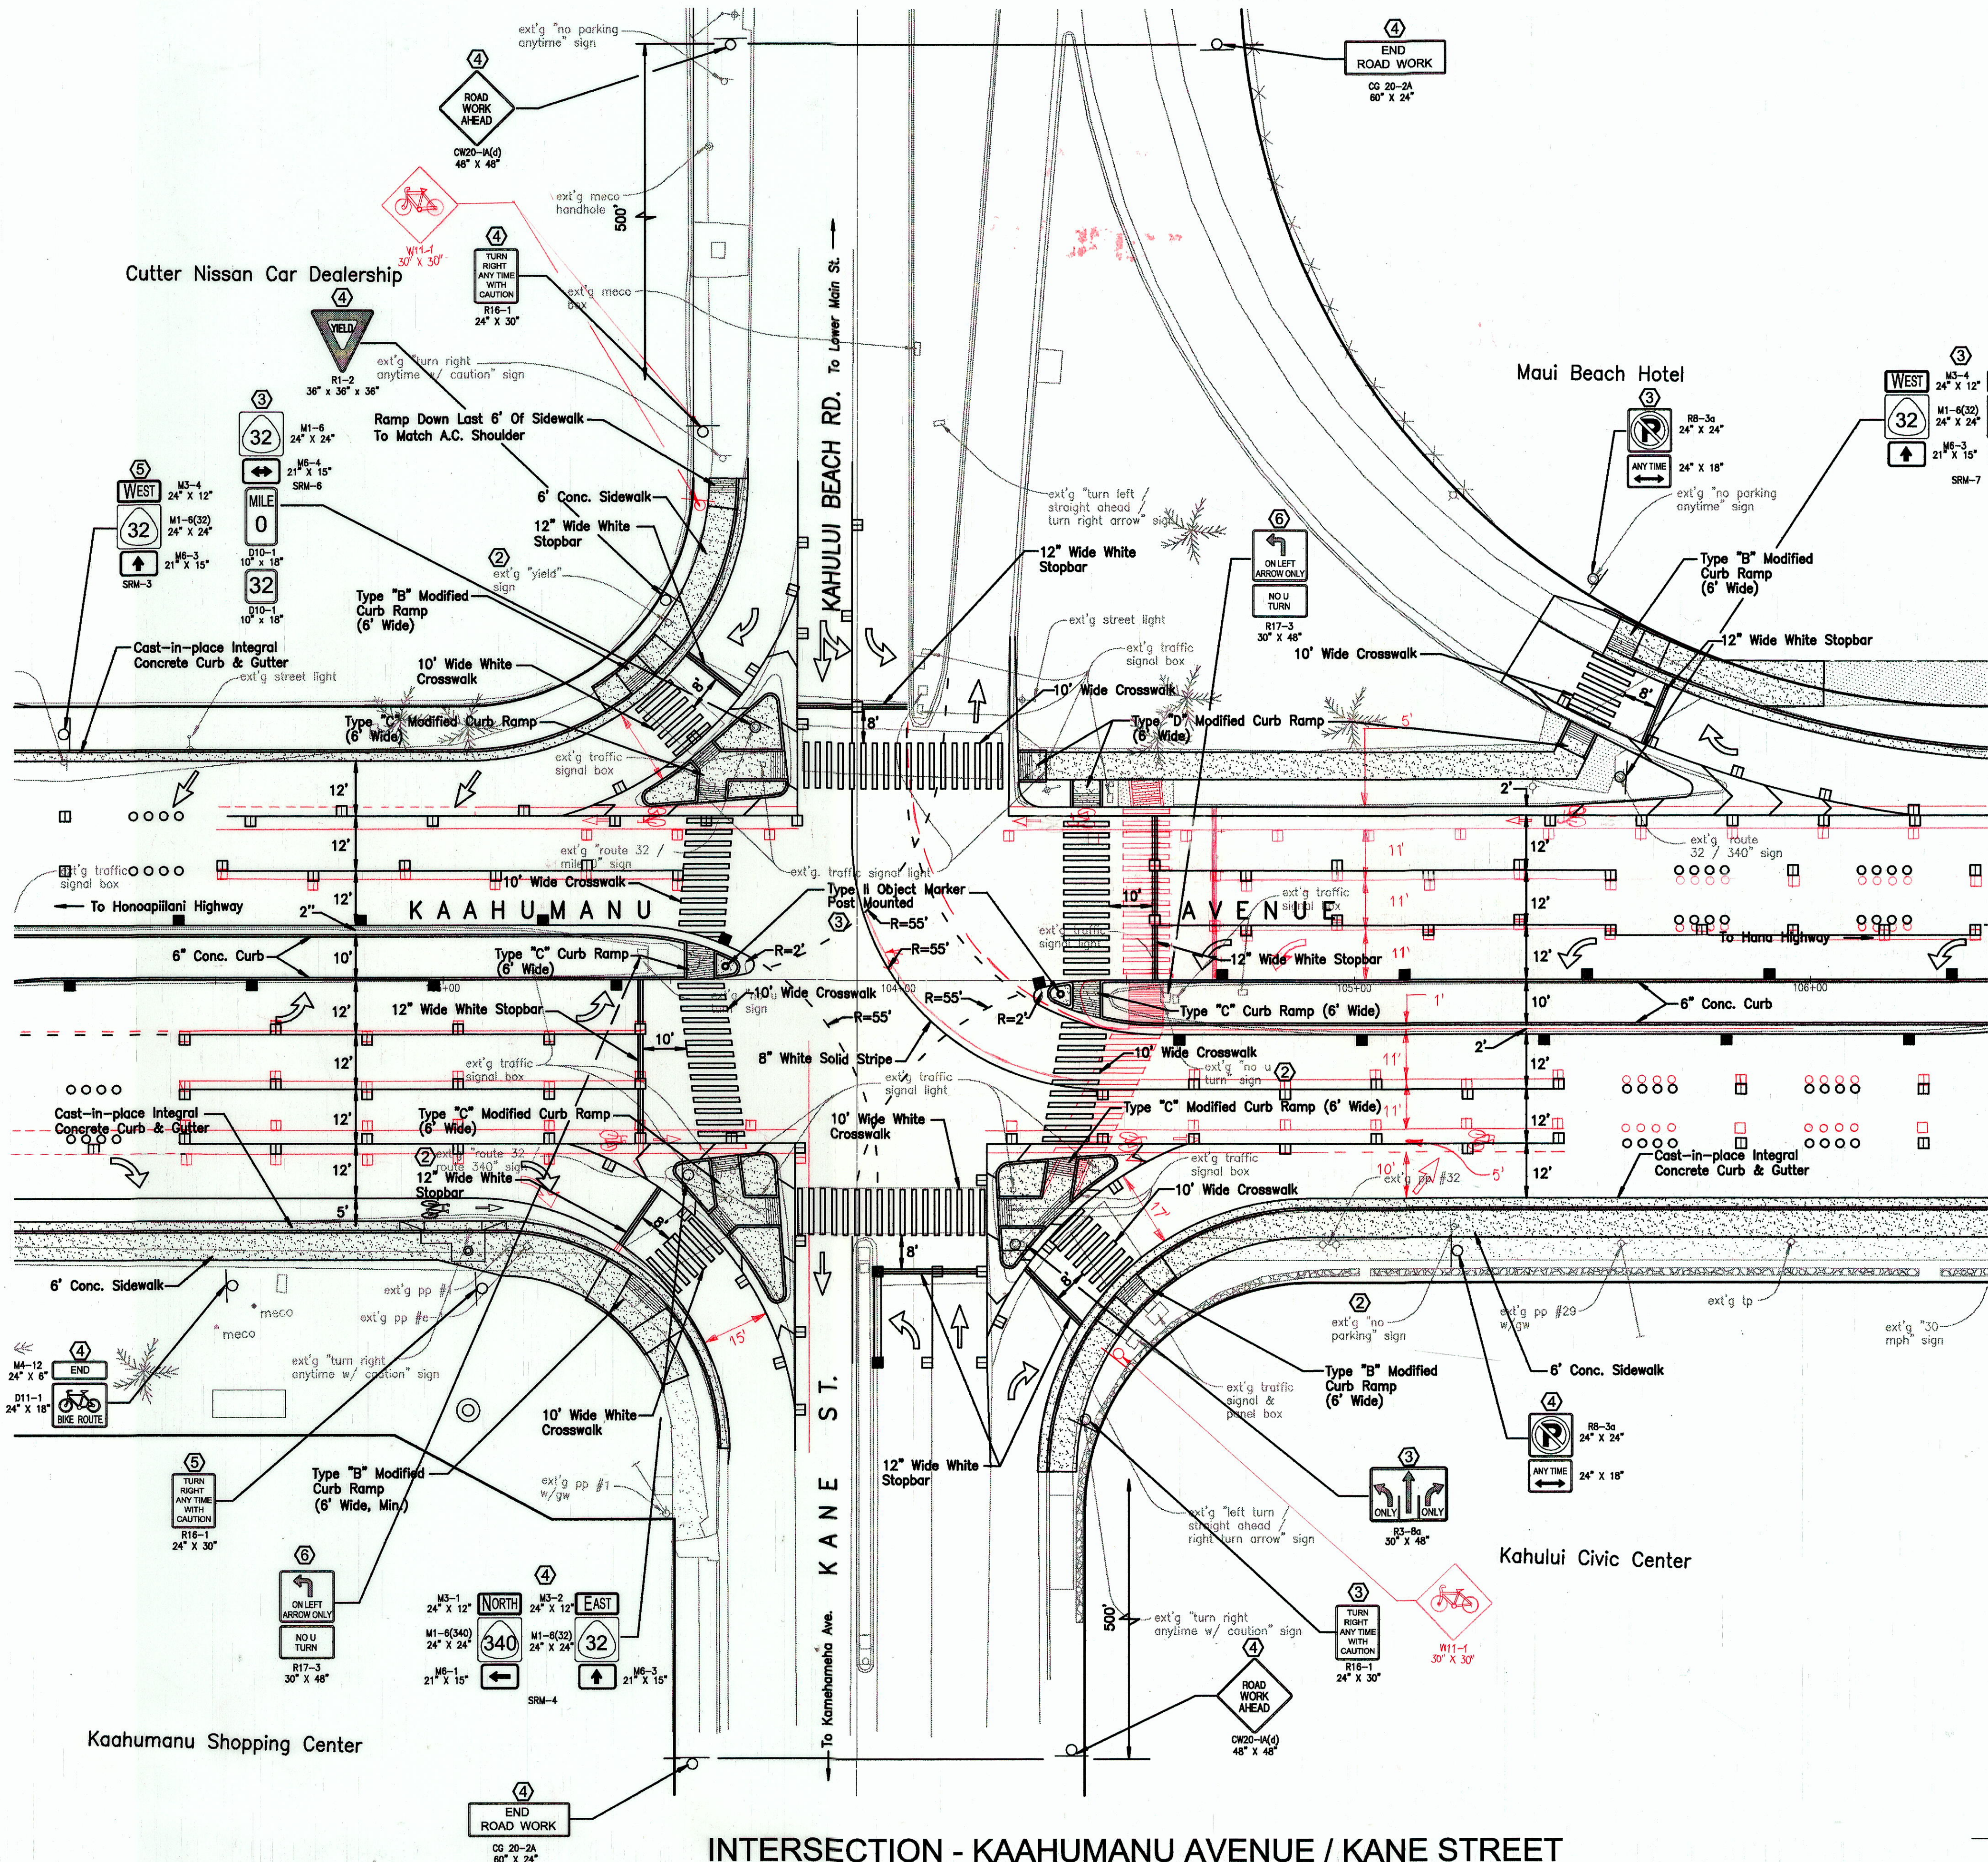

- LEGEND:**
- 4 EACH TYPE "A" RAISED PAVEMENT MARKERS
TYPE "C" RAISED PAVEMENT MARKERS AT 40'-0" O.C.
 - 4" DOUBLE SOLID YELLOW STRIPES WITH TYPE "H"
RAISED PAVEMENT MARKERS AT 20'-0" O.C.
(TAPE, TYPE I OR THERMOPLASTIC EXTRUSION)
 - 8" SOLID WHITE STRIPE W/ TYPE "C" RAISED PAVEMENT
MARKERS AT 20'-0" O.C. (TAPE, TYPE I OR THERMOPLASTIC
EXTRUSION)
 - 4" YELLOW EDGE STRIPE WITH TYPE "H" RAISED
PAVEMENT MARKERS AT 40'-0" O.C.
(TAPE, TYPE II OR THERMOPLASTIC EXTRUSION)
 - CHANNELIZING ISLAND OR DECELERATION LANE CORE
(TAPE, TYPE II OR THERMOPLASTIC EXTRUSION)
 - 4" OR 8" WHITE EDGE STRIPE W/ TYPE "C" RAISED PAVEMENT
MARKERS AT 40'-0" O.C. (TAPE, TYPE II OR THERMOPLASTIC
EXTRUSION)
 - 4" WHITE GUIDELINES (TAPE, TYPE III OR THERMOPLASTIC
EXTRUSION EXCEPT FOR BUS BAYS) (GUIDELINES FOR TURNING
MOVEMENTS THROUGH INTERSECTIONS SHALL BE YELLOW)
 - TRANSVERSE MEDIAN MARKING (TAPE, TYPE II OR
THERMOPLASTIC EXTRUSION)
 - TRANSVERSE SHOULDER MARKING (TAPE, TYPE II
OR THERMOPLASTIC EXTRUSION)
 - PAVEMENT ARROW (TAPE, TYPE III OR THERMOPLASTIC EXTRUSION)
 - CROSSWALK AND STOP LINE. ALL STOP LINES SHALL BE
10'-0" FROM CROSSWALK UNLESS OTHERWISE NOTED.
THE CIRCLED NUMBER INDICATES THE NUMBER OF LANES
FOR PAYMENT (TAPE, TYPE III OR THERMOPLASTIC EXTRUSION)
 - BIKE LANE MARKING (PAINT)
 - EXISTING SIGN(S) AND POST(S) TO REMAIN
 - REMOVE EXISTING SIGN(S) AND POST(S)
 - REMOVE EXISTING AND INSTALL NEW SIGN(S) AND POST(S)
 - INSTALL NEW SIGN(S) AND POST(S)
 - RELOCATE EXISTING SIGN(S) AND POST(S)
 - REMOVE EXT'G AND INSTALL NEW SIGN(S) ON
TRAFFIC SIGNAL POST(S)

SURVEY PLOTTED BY	DATE
DESIGNED BY	DATE
TRACED BY	DATE
NOTED BY	DATE
CHECKED BY	DATE

DARREN T. UNEMORI
LICENSED PROFESSIONAL ENGINEER
NO. 7957-C
HAWAII, U.S.A.

THIS WORK WAS PREPARED BY ME
OR UNDER MY SUPERVISION

Signature

STATE OF HAWAII
DEPARTMENT OF TRANSPORTATION
HIGHWAYS DIVISION

INTERSECTION STRIPING & SIGNAGE PLAN

MAIN STREET RESURFACING
CENTRAL AVENUE TO KAAHUMANU AVENUE
AND
KAAHUMANU AVENUE RESURFACING
MAIN STREET TO HOBSON AVENUE
Fed. Aid Project No. NH-032-1(8)

SCALE: AS NOTED

SHEET No. 8 OF 15 SHEETS

INTERSECTION - KAAHUMANU AVENUE / KANE STREET


"AS-BUILT"

FED. ROAD DIST. NO.	STATE	FED. AID PROJ. NO.	FISCAL YEAR	SHEET NO.	TOTAL SHEETS
HAWAII	HAW.	NH-032-1(8)	2000	72	111

TRUE NORTH
SCALE: 1" = 20 FT.

LEGEND:

- 4 EACH TYPE "A" RAISED PAVEMENT MARKERS
TYPE "C" RAISED PAVEMENT MARKERS AT 40'-0" O.C.
- 4" DOUBLE SOLID YELLOW STRIPES WITH TYPE "H"
RAISED PAVEMENT MARKERS AT 20'-0" O.C.
(TAPE, TYPE I OR THERMOPLASTIC EXTRUSION)
- 8" SOLID WHITE STRIPE W/ TYPE "C" RAISED PAVEMENT
MARKERS AT 20'-0" O.C. (TAPE, TYPE I OR THERMOPLASTIC
EXTRUSION)
- 4" YELLOW EDGE STRIPE WITH TYPE "H" RAISED
PAVEMENT MARKERS AT 40'-0" O.C.
(TAPE, TYPE II OR THERMOPLASTIC EXTRUSION)
- CHANNELIZING ISLAND OR DECELERATION LANE GORE
(TAPE, TYPE II OR THERMOPLASTIC EXTRUSION)
- 4" OR 8" WHITE EDGE STRIPE W/ TYPE "C" RAISED PAVEMENT
MARKERS AT 40'-0" O.C. (TAPE, TYPE II OR THERMOPLASTIC
EXTRUSION)
- 4" WHITE GUIDELINES (TAPE, TYPE III OR THERMOPLASTIC
EXTRUSION EXCEPT FOR BUS BAYS) (GUIDELINES FOR TURNING
MOVEMENTS THROUGH INTERSECTIONS SHALL BE YELLOW)
- TRANSVERSE MEDIAN MARKING (TAPE, TYPE II OR
THERMOPLASTIC EXTRUSION)
- TRANSVERSE SHOULDER MARKING (TAPE, TYPE II
OR THERMOPLASTIC EXTRUSION)
- PAVEMENT ARROW (TAPE, TYPE III OR THERMOPLASTIC EXTRUSION)
- ② CROSSWALK AND STOP LINE. ALL STOP LINES SHALL BE
10'-0" FROM CROSSWALK UNLESS OTHERWISE NOTED.
THE CIRCLED NUMBER INDICATES THE NUMBER OF LANES
FOR PAYMENT (TAPE, TYPE III OR THERMOPLASTIC EXTRUSION)
- BIKE LANE MARKING (PAINT)
- ① EXISTING SIGN(S) AND POST(S) TO REMAIN
- ② REMOVE EXISTING SIGN(S) AND POST(S)
- ③ REMOVE EXISTING AND INSTALL NEW SIGN(S) AND POST(S)
- ④ INSTALL NEW SIGN(S) AND POST(S)
- ⑤ RELOCATE EXISTING SIGN(S) AND POST(S)
- ⑥ REMOVE EXT'G AND INSTALL NEW SIGN(S) ON
TRAFFIC SIGNAL POST(S)

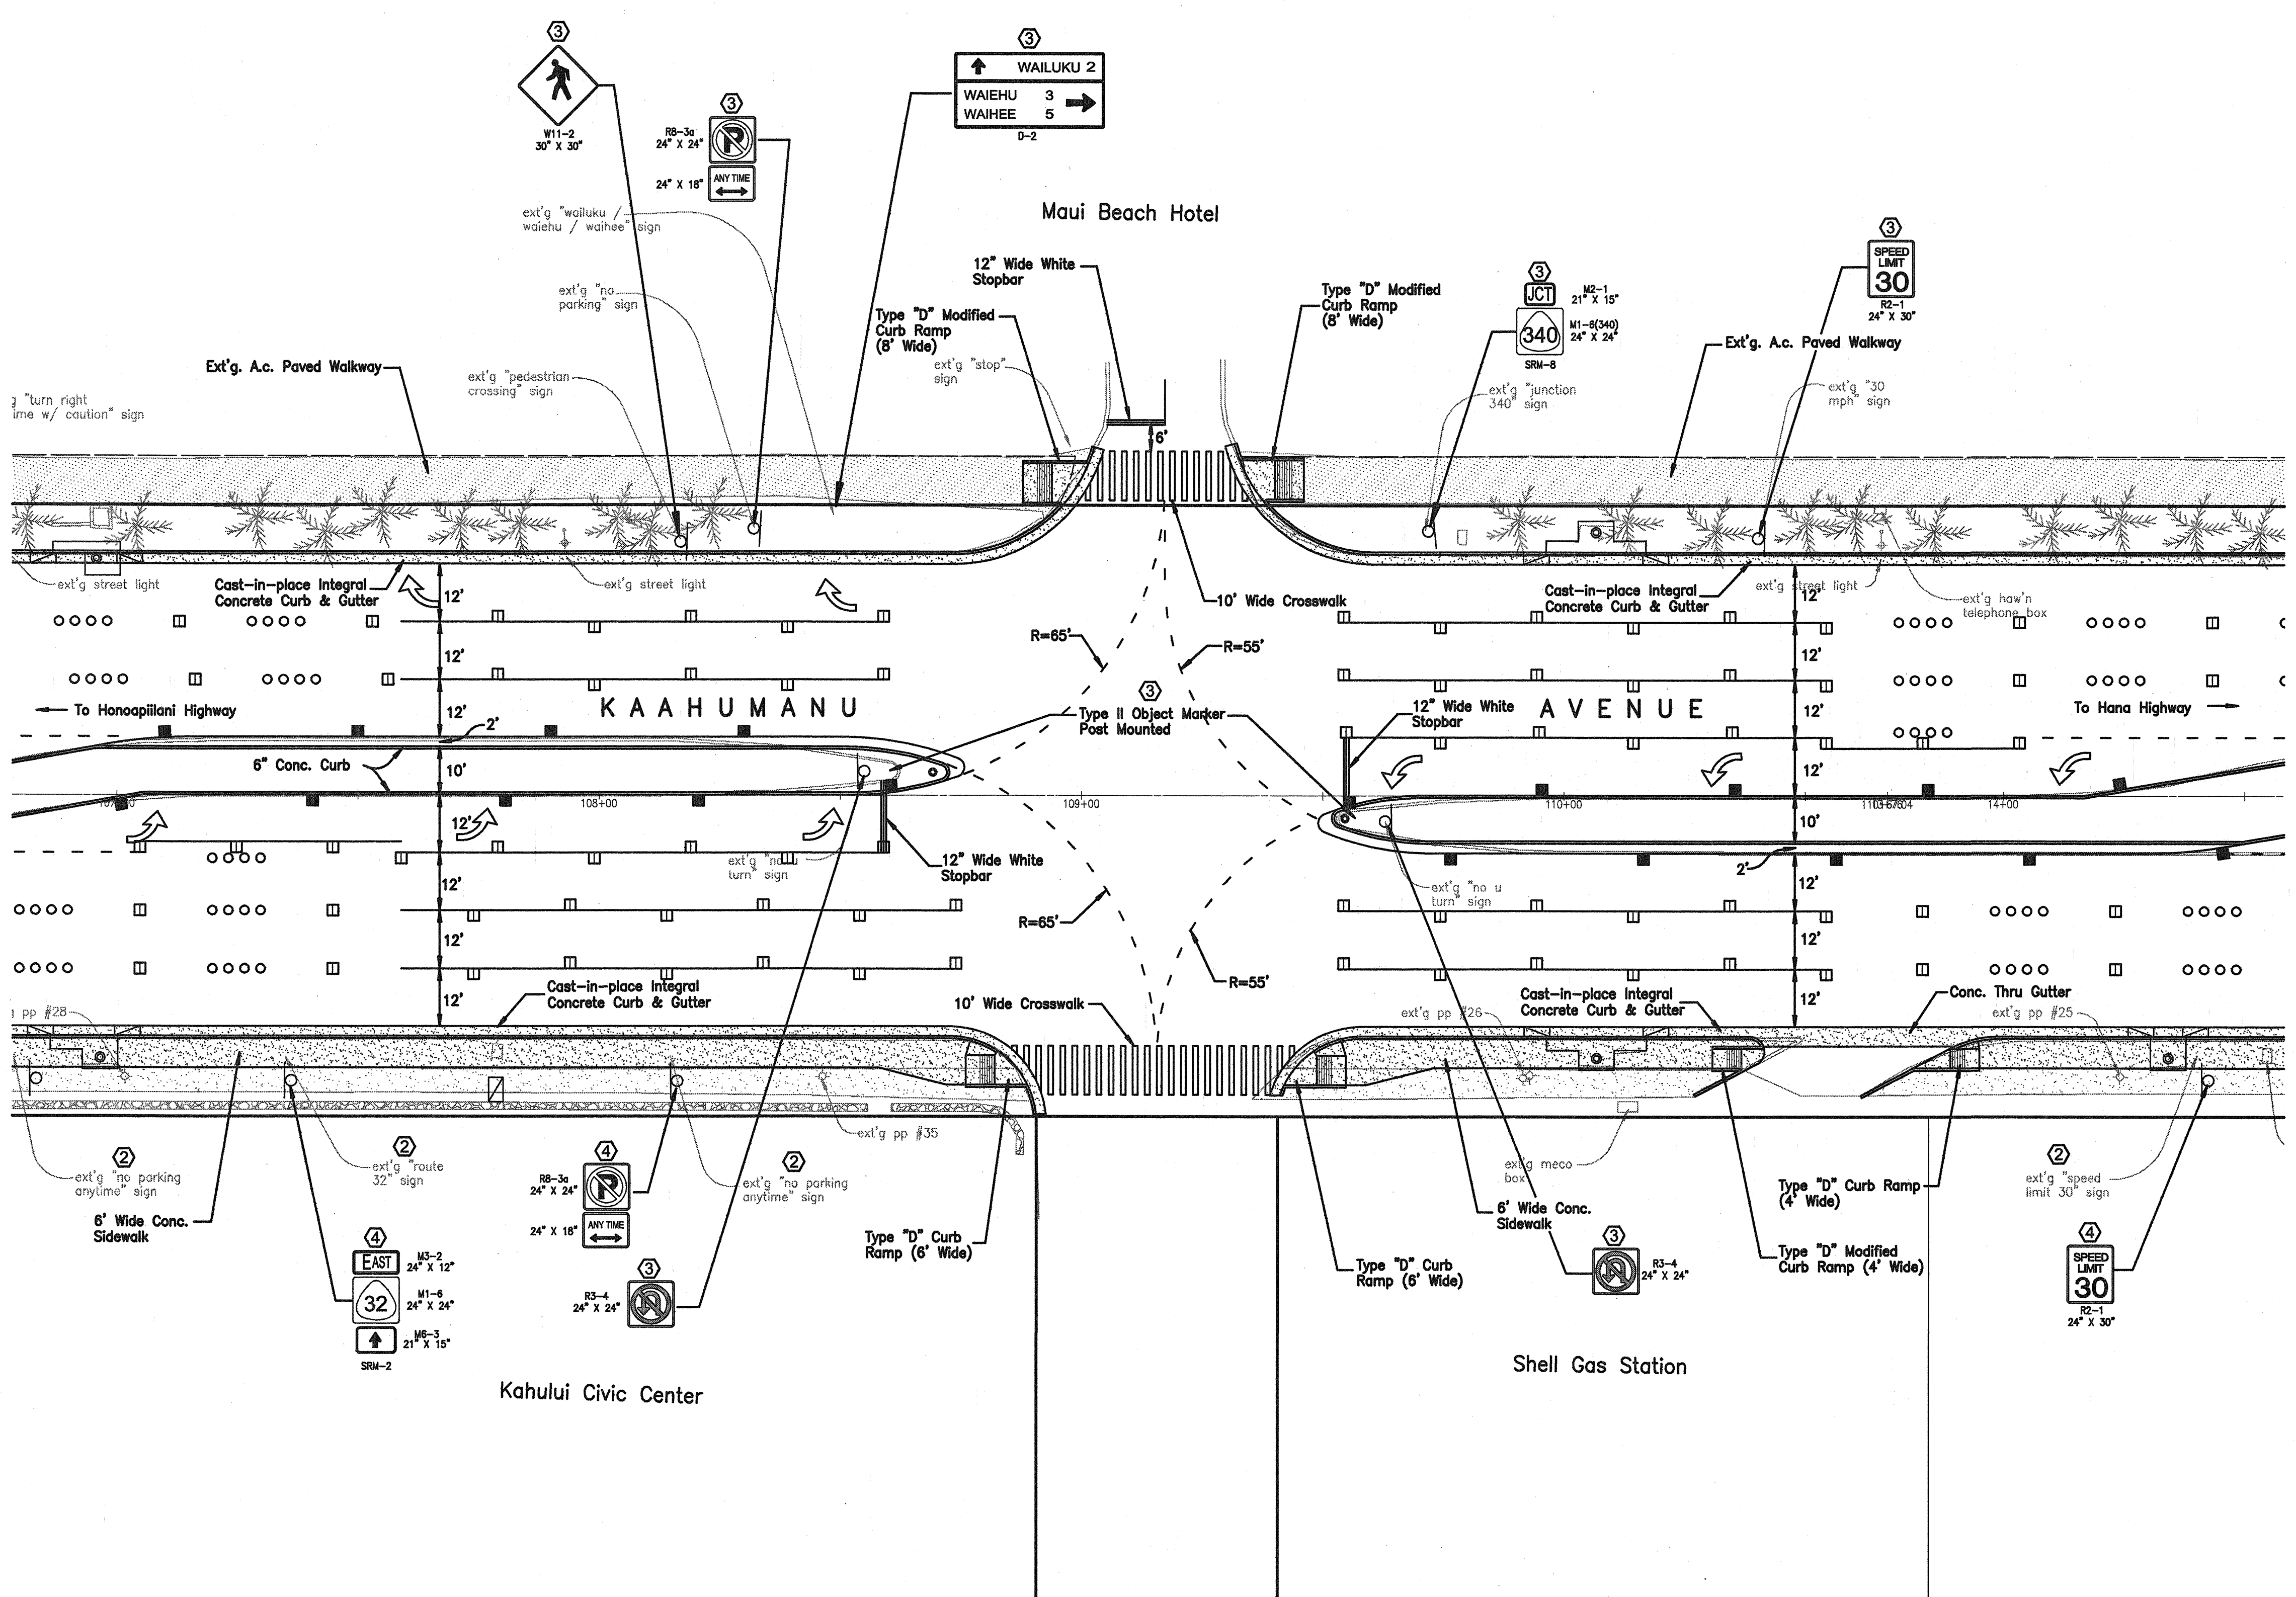

INTERSECTION - KAAHUMANU AVENUE / MAUI BEACH HOTEL / SHELL GAS STATION

DARREN T. UMEMOTO
LICENSED PROFESSIONAL ENGINEER
NO. 7937-C
HAWAII, U.S.A.

THIS WORK WAS PREPARED BY ME
OR UNDER MY SUPERVISION

[Signature]
Date: 4/1/00

STATE OF HAWAII
DEPARTMENT OF TRANSPORTATION
HIGHWAYS DIVISION

INTERSECTION STRIPING & SIGNAGE PLAN

**MAIN STREET RESURFACING
CENTRAL AVENUE TO KAAHUMANU AVENUE
AND
KAAHUMANU AVENUE RESURFACING
MAIN STREET TO HOBSON AVENUE
Fed. Aid Project No. NH-032-1(8)**


SCALE: AS NOTED

SHEET No. 9 OF 15 SHEETS

DATE	DATE	DATE	DATE	DATE
DESIGNED BY	DRAWN BY	CHECKED BY	NOTED BY	DATE
DATE	DATE	DATE	DATE	DATE
DATE	DATE	DATE	DATE	DATE
DATE	DATE	DATE	DATE	DATE

FED. ROAD DIST. NO.	STATE	FED. AID PROJ. NO.	FISCAL YEAR	SHEET NO.	TOTAL SHEETS
HAWAII	HAW.	NH-032-1(8)	2000	73	111

TRUE NORTH
SCALE: 1" = 20 FT.

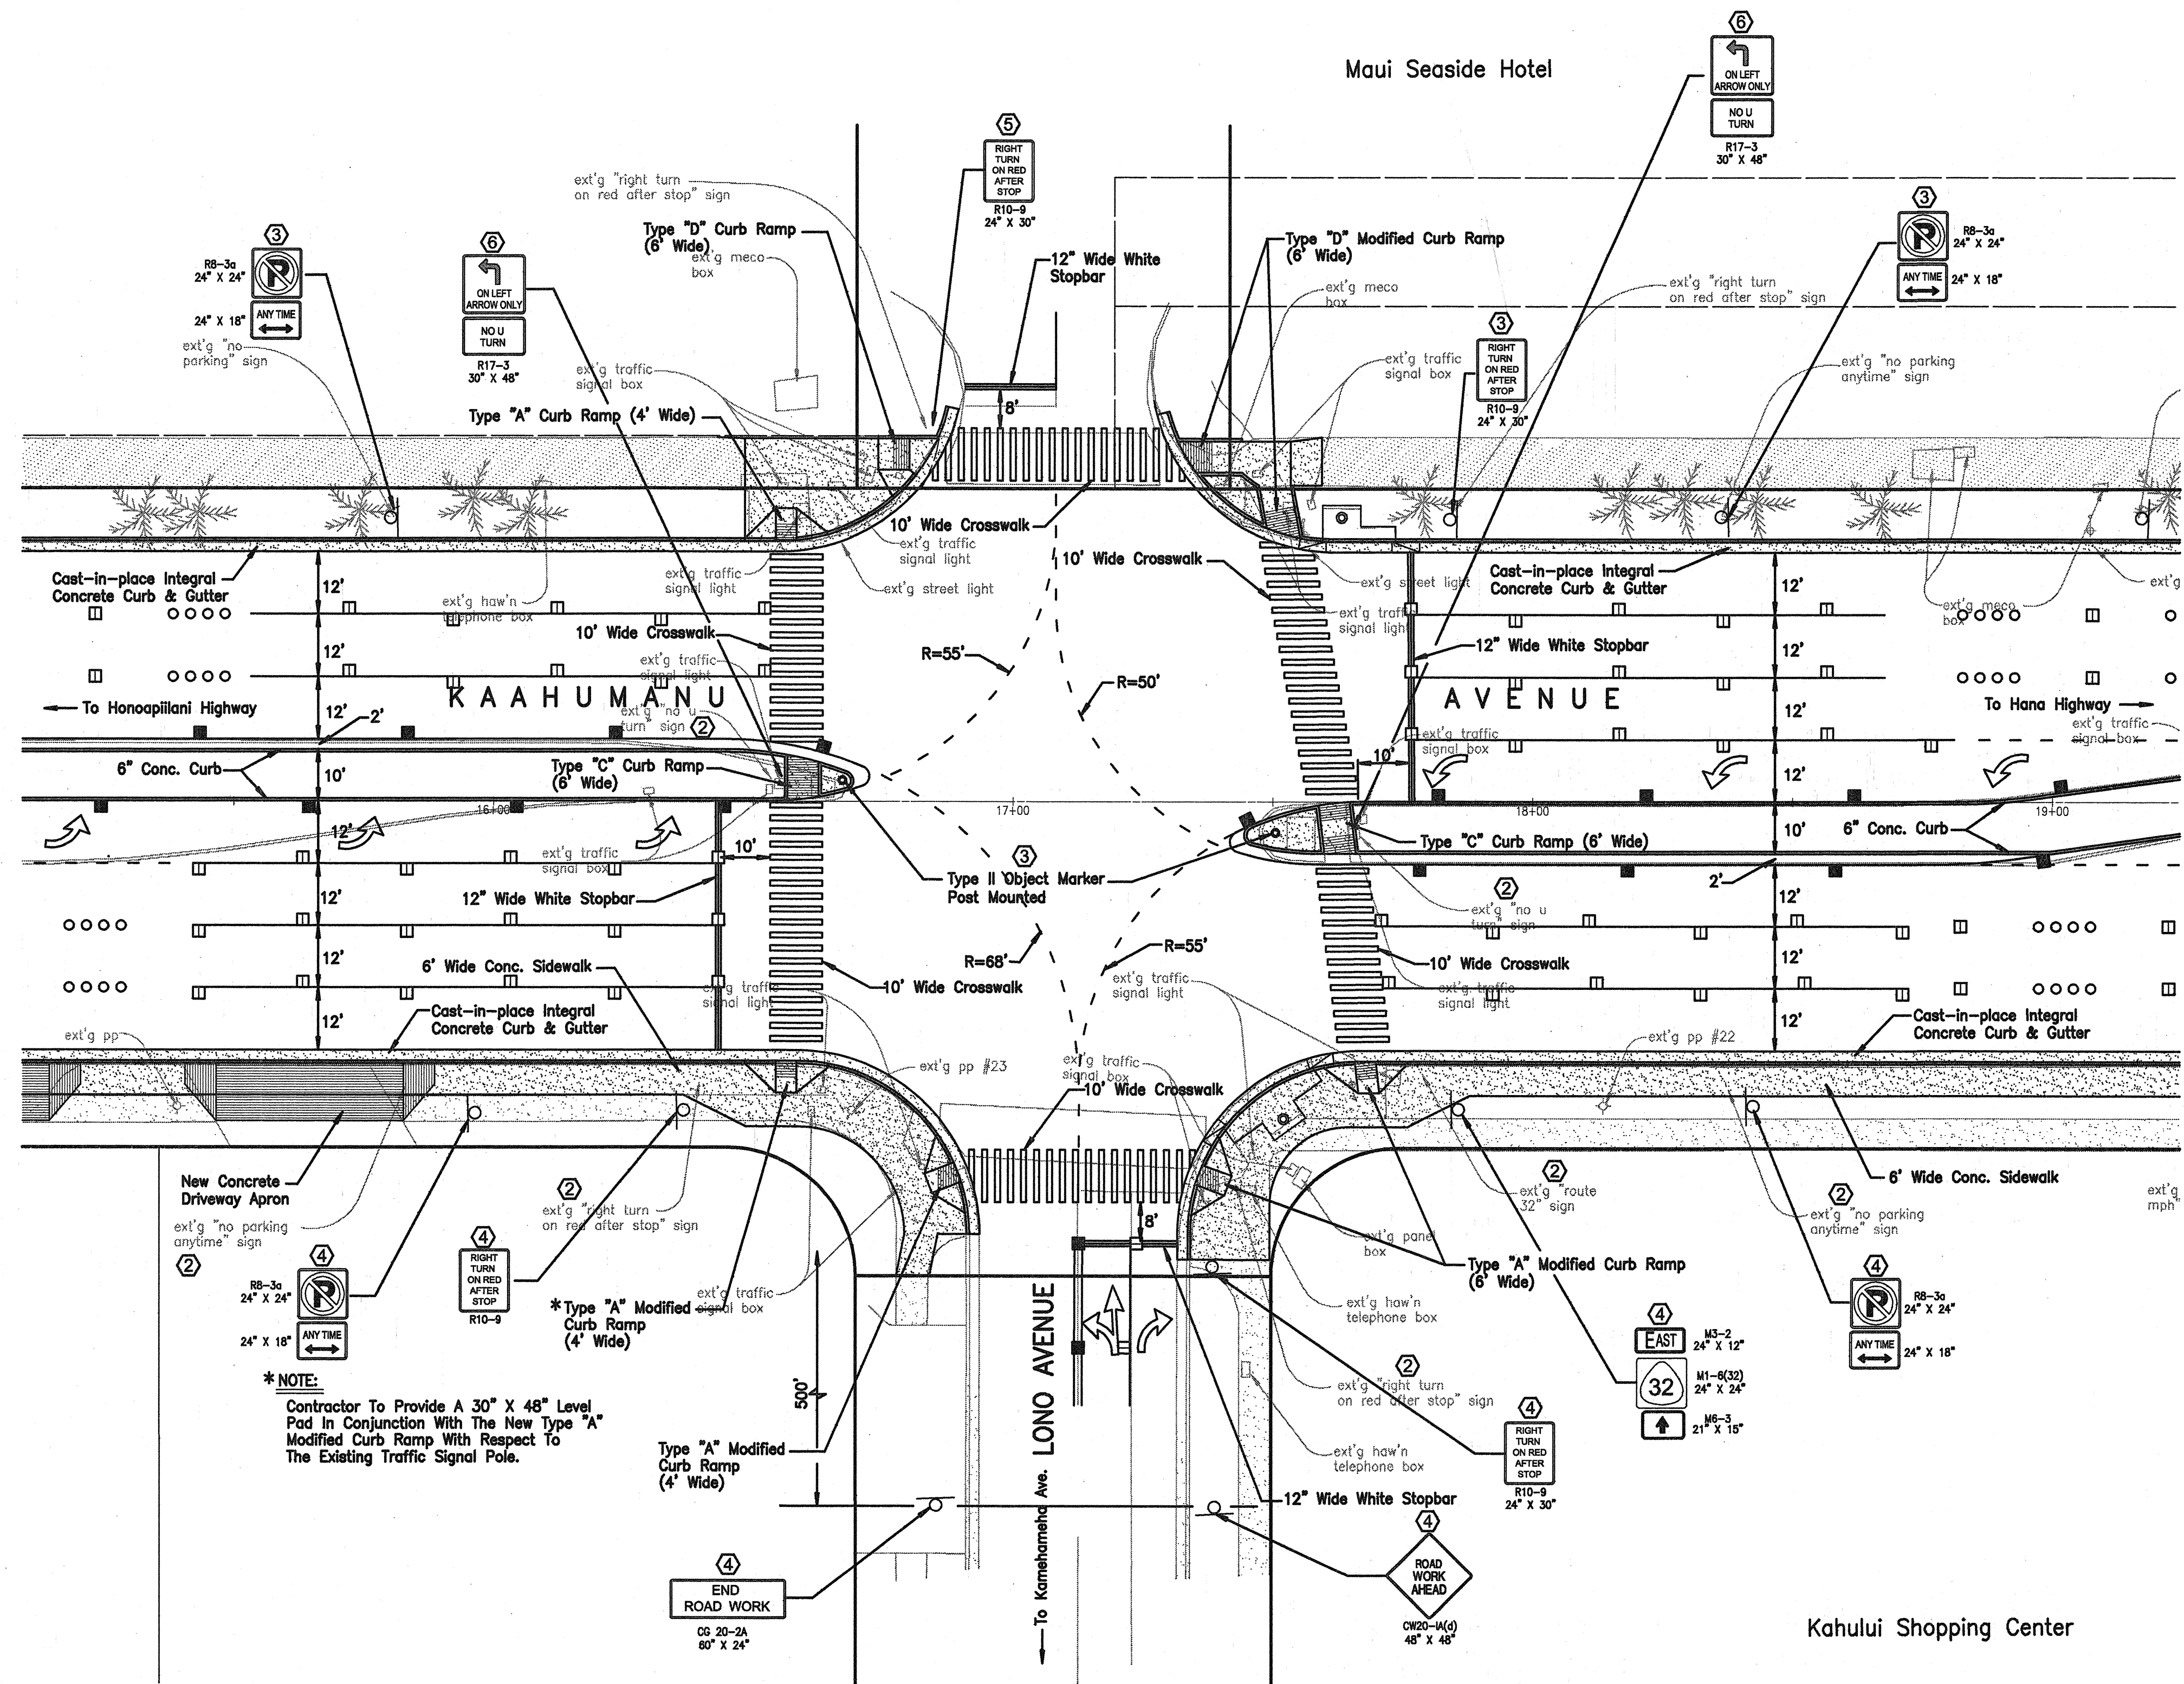


LEGEND:

- 4 EACH TYPE "A" RAISED PAVEMENT MARKERS
TYPE "C" RAISED PAVEMENT MARKERS AT 40'-0" O.C.
- 4" DOUBLE SOLID YELLOW STRIPES WITH TYPE "H" RAISED PAVEMENT MARKERS AT 20'-0" O.C. (TAPE, TYPE I OR THERMOPLASTIC EXTRUSION)
- 8" SOLID WHITE STRIPE W/ TYPE "C" RAISED PAVEMENT MARKERS AT 20'-0" O.C. (TAPE, TYPE I OR THERMOPLASTIC EXTRUSION)
- 4" YELLOW EDGE STRIPE WITH TYPE "H" RAISED PAVEMENT MARKERS AT 40'-0" O.C. (TAPE, TYPE II OR THERMOPLASTIC EXTRUSION)
- CHANNELIZING ISLAND OR DECELERATION LANE GORE (TAPE, TYPE II OR THERMOPLASTIC EXTRUSION)
- 4" OR 8" WHITE EDGE STRIPE W/ TYPE "C" RAISED PAVEMENT MARKERS AT 40'-0" O.C. (TAPE, TYPE II OR THERMOPLASTIC EXTRUSION)
- 4" WHITE GUIDELINES (TAPE, TYPE III OR THERMOPLASTIC EXTRUSION EXCEPT FOR BUS BAYS) (GUIDELINES FOR TURNING MOVEMENTS THROUGH INTERSECTIONS SHALL BE YELLOW)
- TRANSVERSE MEDIAN MARKING (TAPE, TYPE II OR THERMOPLASTIC EXTRUSION)
- TRANSVERSE SHOULDER MARKING (TAPE, TYPE II OR THERMOPLASTIC EXTRUSION)
- PAVEMENT ARROW (TAPE, TYPE III OR THERMOPLASTIC EXTRUSION)
- 2 CROSSWALK AND STOP LINE. ALL STOP LINES SHALL BE 10'-0" FROM CROSSWALK UNLESS OTHERWISE NOTED. THE CIRCLED NUMBER INDICATES THE NUMBER OF LANES FOR PAYMENT (TAPE, TYPE III OR THERMOPLASTIC EXTRUSION)
- BIKE LANE MARKING (PAINT)
- 1 EXISTING SIGN(S) AND POST(S) TO REMAIN
- 2 REMOVE EXISTING SIGN(S) AND POST(S)
- 3 REMOVE EXISTING AND INSTALL NEW SIGN(S) AND POST(S)
- 4 INSTALL NEW SIGN(S) AND POST(S)
- 5 RELOCATE EXISTING SIGN(S) AND POST(S)
- 6 REMOVE EXT'G AND INSTALL NEW SIGN(S) ON TRAFFIC SIGNAL POST(S)

* NOTE:
Contractor To Provide A 30" X 48" Level Pad In Conjunction With The New Type "A" Modified Curb Ramp With Respect To The Existing Traffic Signal Pole.

INTERSECTION - KAAHUMANU AVENUE / LONO AVENUE

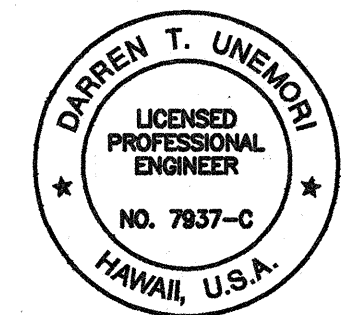

THIS WORK WAS PREPARED BY ME OR UNDER MY SUPERVISION
Signature: [Signature] 4/18/00

STATE OF HAWAII
DEPARTMENT OF TRANSPORTATION
HIGHWAYS DIVISION

INTERSECTION STRIPING & SIGNAGE PLAN


MAIN STREET RESURFACING
CENTRAL AVENUE TO KAAHUMANU AVENUE
AND
KAAHUMANU AVENUE RESURFACING
MAIN STREET TO HOBSON AVENUE
Fed. Aid Project No. NH-032-1(8)

SCALE: AS NOTED

DATE	DATE	DATE	DATE	DATE
DESIGNED BY	DESIGNED BY	DESIGNED BY	DESIGNED BY	DESIGNED BY
CHECKED BY	CHECKED BY	CHECKED BY	CHECKED BY	CHECKED BY
NO.	NO.	NO.	NO.	NO.

88proj/98048/compans/11-81004.dwg


FED. ROAD DIST. NO.	STATE	FED. AID PROJ. NO.	FISCAL YEAR	SHEET NO.	TOTAL SHEETS
HAWAII	HAW.	NH-032-1(8)	2000	74	111

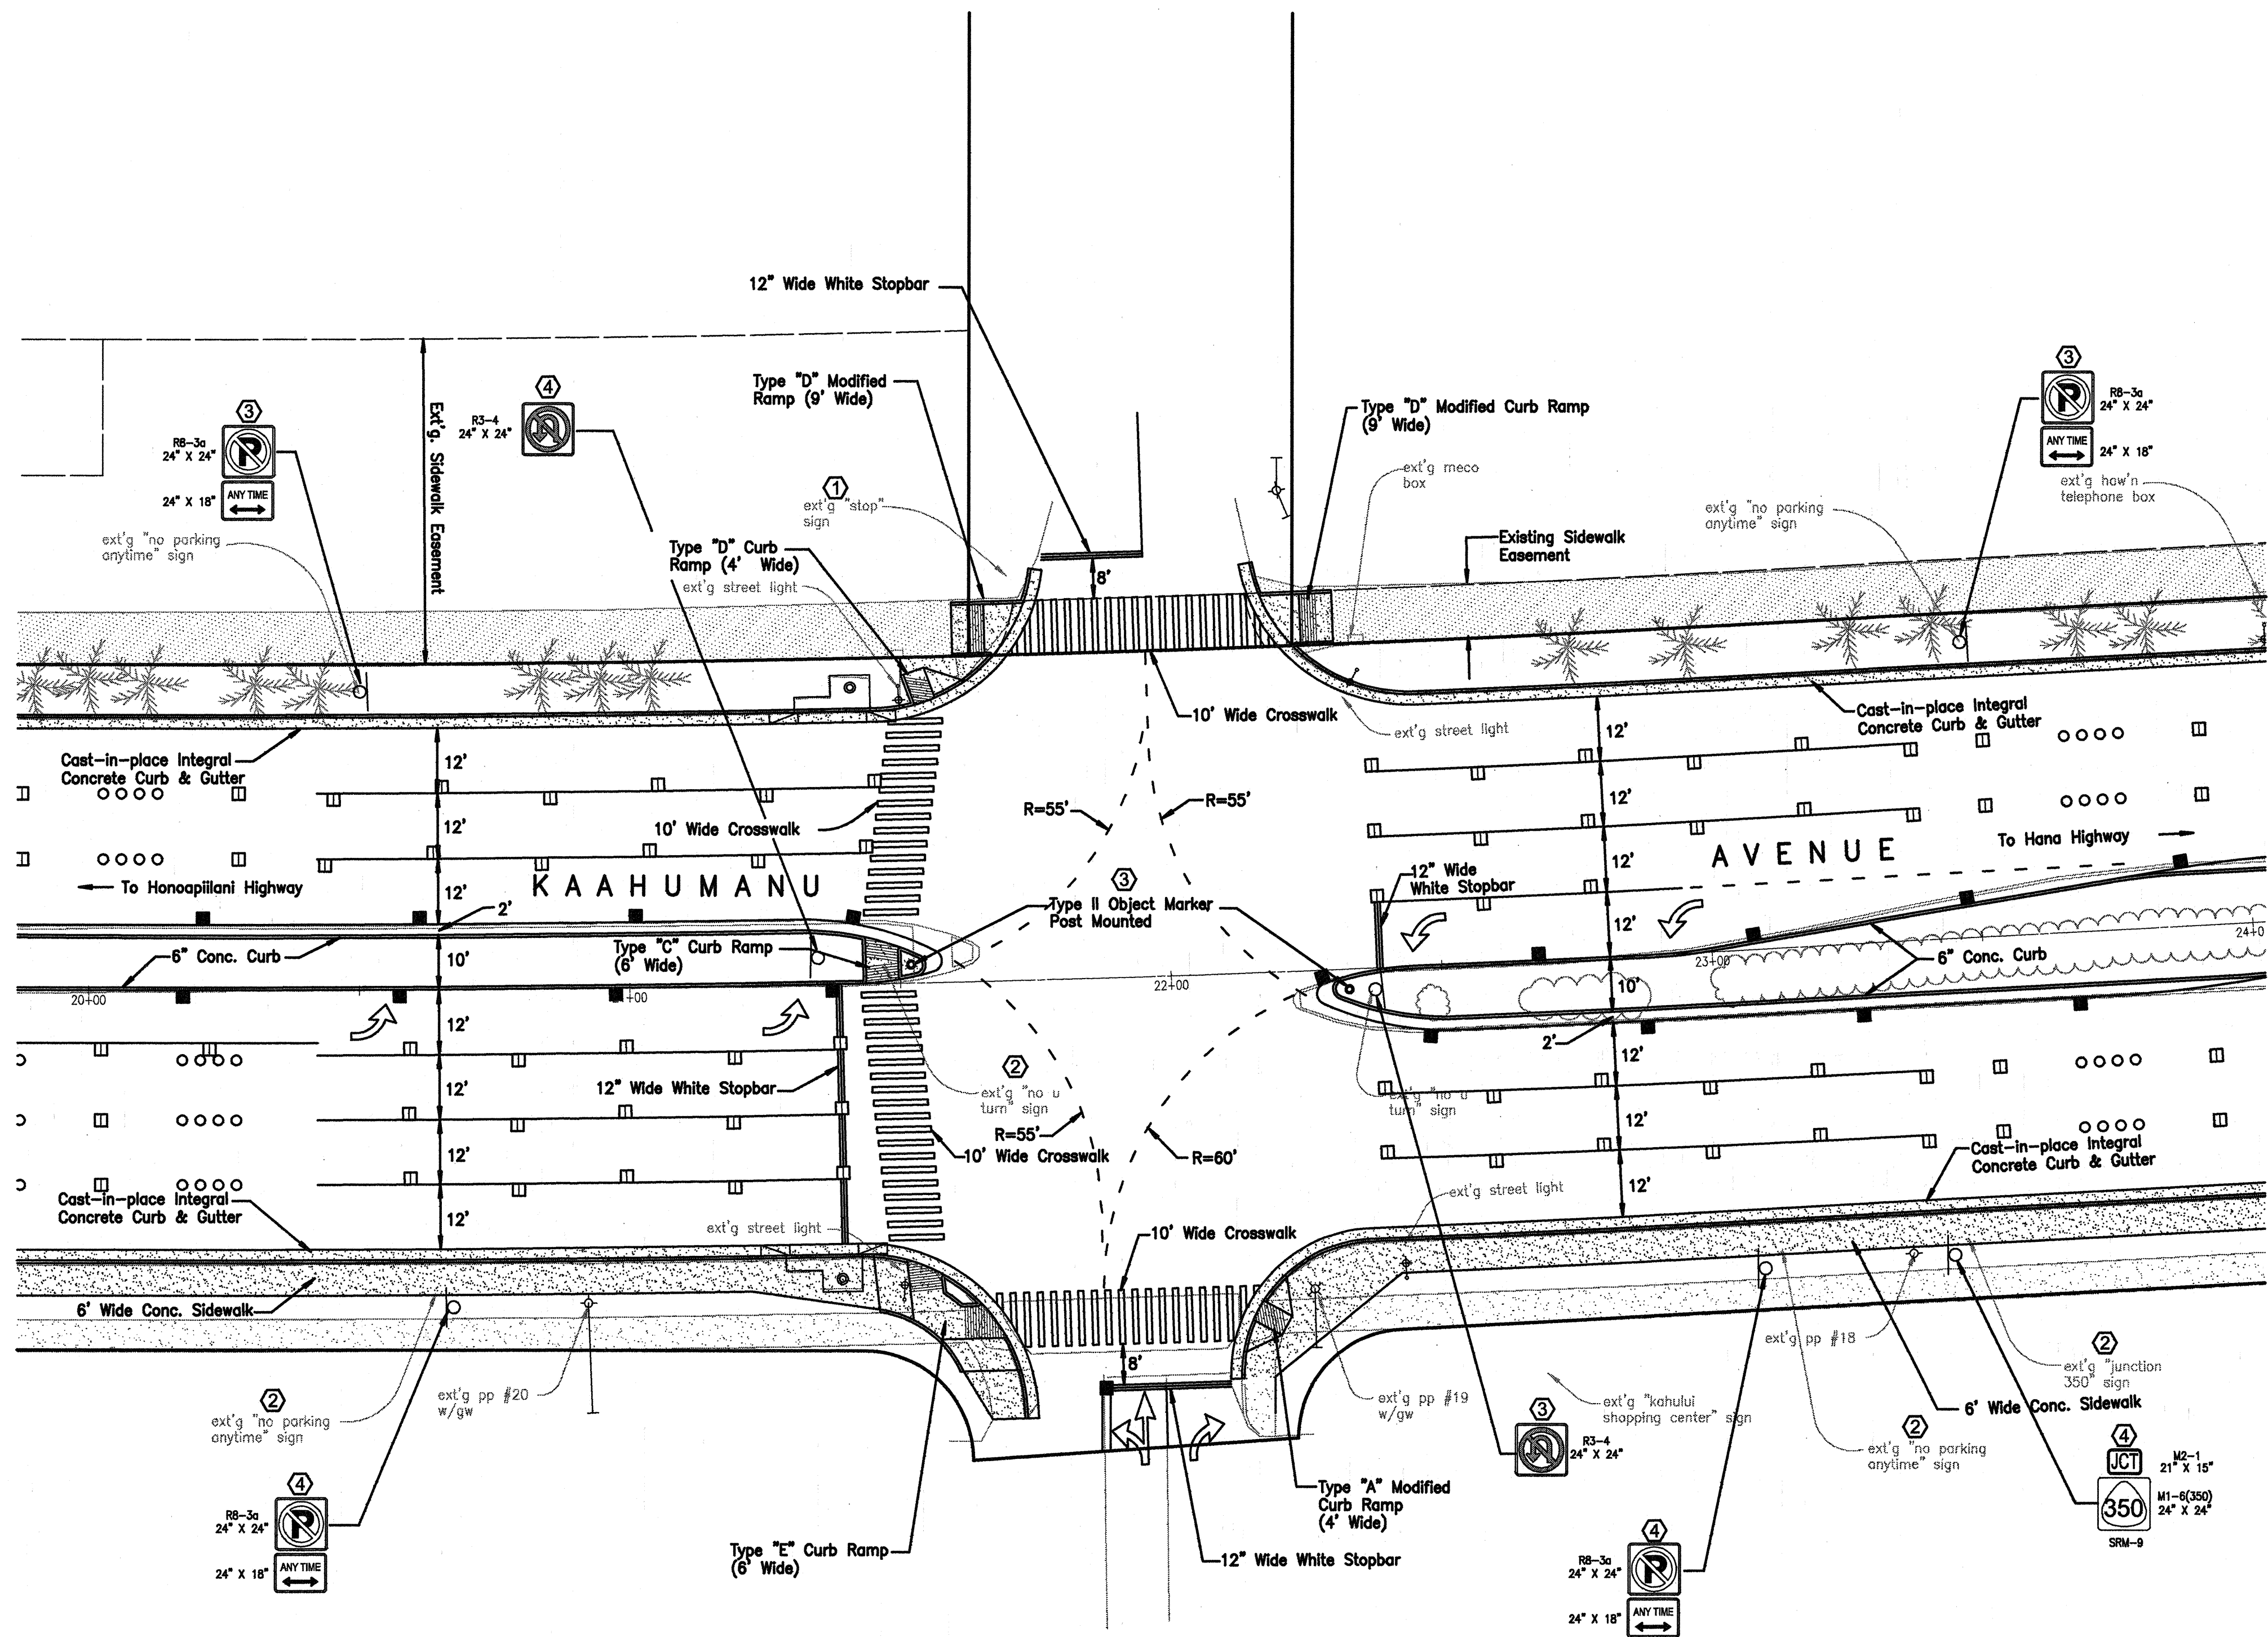

LEGEND:

- 4 EACH TYPE "A" RAISED PAVEMENT MARKERS
TYPE "C" RAISED PAVEMENT MARKERS AT 40'-0" O.C.
- 4" DOUBLE SOLID YELLOW STRIPES WITH TYPE "H" RAISED PAVEMENT MARKERS AT 20'-0" O.C. (TAPE, TYPE I OR THERMOPLASTIC EXTRUSION)
- 8" SOLID WHITE STRIPE W/ TYPE "C" RAISED PAVEMENT MARKERS AT 20'-0" O.C. (TAPE, TYPE I OR THERMOPLASTIC EXTRUSION)
- 4" YELLOW EDGE STRIPE WITH TYPE "H" RAISED PAVEMENT MARKERS AT 40'-0" O.C. (TAPE, TYPE II OR THERMOPLASTIC EXTRUSION)
- CHANNELIZING ISLAND OR DECELERATION LANE GORE (TAPE, TYPE II OR THERMOPLASTIC EXTRUSION)
- 4" OR 8" WHITE EDGE STRIPE W/ TYPE "C" RAISED PAVEMENT MARKERS AT 40'-0" O.C. (TAPE, TYPE II OR THERMOPLASTIC EXTRUSION)
- 4" WHITE GUIDELINES (TAPE, TYPE III OR THERMOPLASTIC EXTRUSION EXCEPT FOR BUS BAYS) (GUIDELINES FOR TURNING MOVEMENTS THROUGH INTERSECTIONS SHALL BE YELLOW)
- TRANSVERSE MEDIAN MARKING (TAPE, TYPE II OR THERMOPLASTIC EXTRUSION)
- TRANSVERSE SHOULDER MARKING (TAPE, TYPE II OR THERMOPLASTIC EXTRUSION)
- PAVEMENT ARROW (TAPE, TYPE III OR THERMOPLASTIC EXTRUSION)
- CROSSWALK AND STOP LINE. ALL STOP LINES SHALL BE 10'-0" FROM CROSSWALK UNLESS OTHERWISE NOTED. THE CIRCLED NUMBER INDICATES THE NUMBER OF LANES FOR PAYMENT (TAPE, TYPE III OR THERMOPLASTIC EXTRUSION)
- BIKE LANE MARKING (PAINT)
- EXISTING SIGN(S) AND POST(S) TO REMAIN
- REMOVE EXISTING SIGN(S) AND POST(S)
- REMOVE EXISTING AND INSTALL NEW SIGN(S) AND POST(S)
- INSTALL NEW SIGN(S) AND POST(S)
- RELOCATE EXISTING SIGN(S) AND POST(S)
- REMOVE EXT'G AND INSTALL NEW SIGN(S) ON TRAFFIC SIGNAL POST(S)

INTERSECTION - KAAHUMANU AVENUE / KAHULUI SHOPPING CENTER ENTRANCE

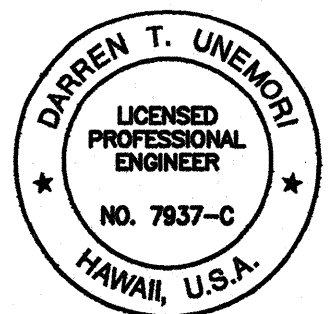

THIS WORK WAS PREPARED BY ME
OR UNDER MY SUPERVISION
Signature


STATE OF HAWAII
DEPARTMENT OF TRANSPORTATION
HIGHWAYS DIVISION
INTERSECTION STRIPING & SIGNAGE PLAN
MAIN STREET RESURFACING
CENTRAL AVENUE TO KAAHUMANU AVENUE
AND
KAAHUMANU AVENUE RESURFACING
MAIN STREET TO HOBSON AVENUE
Fed. Aid Project No. NH-032-1(8)

SCALE: AS NOTED

SHEET No. 11 OF 15 SHEETS

DESIGNED BY	DATE
CHECKED BY	DATE
NOTED BY	DATE
QUANTITIES BY	DATE
ORIGINAL PLAN	DATE

98001/08049/compans/fin-at-00a.dwg

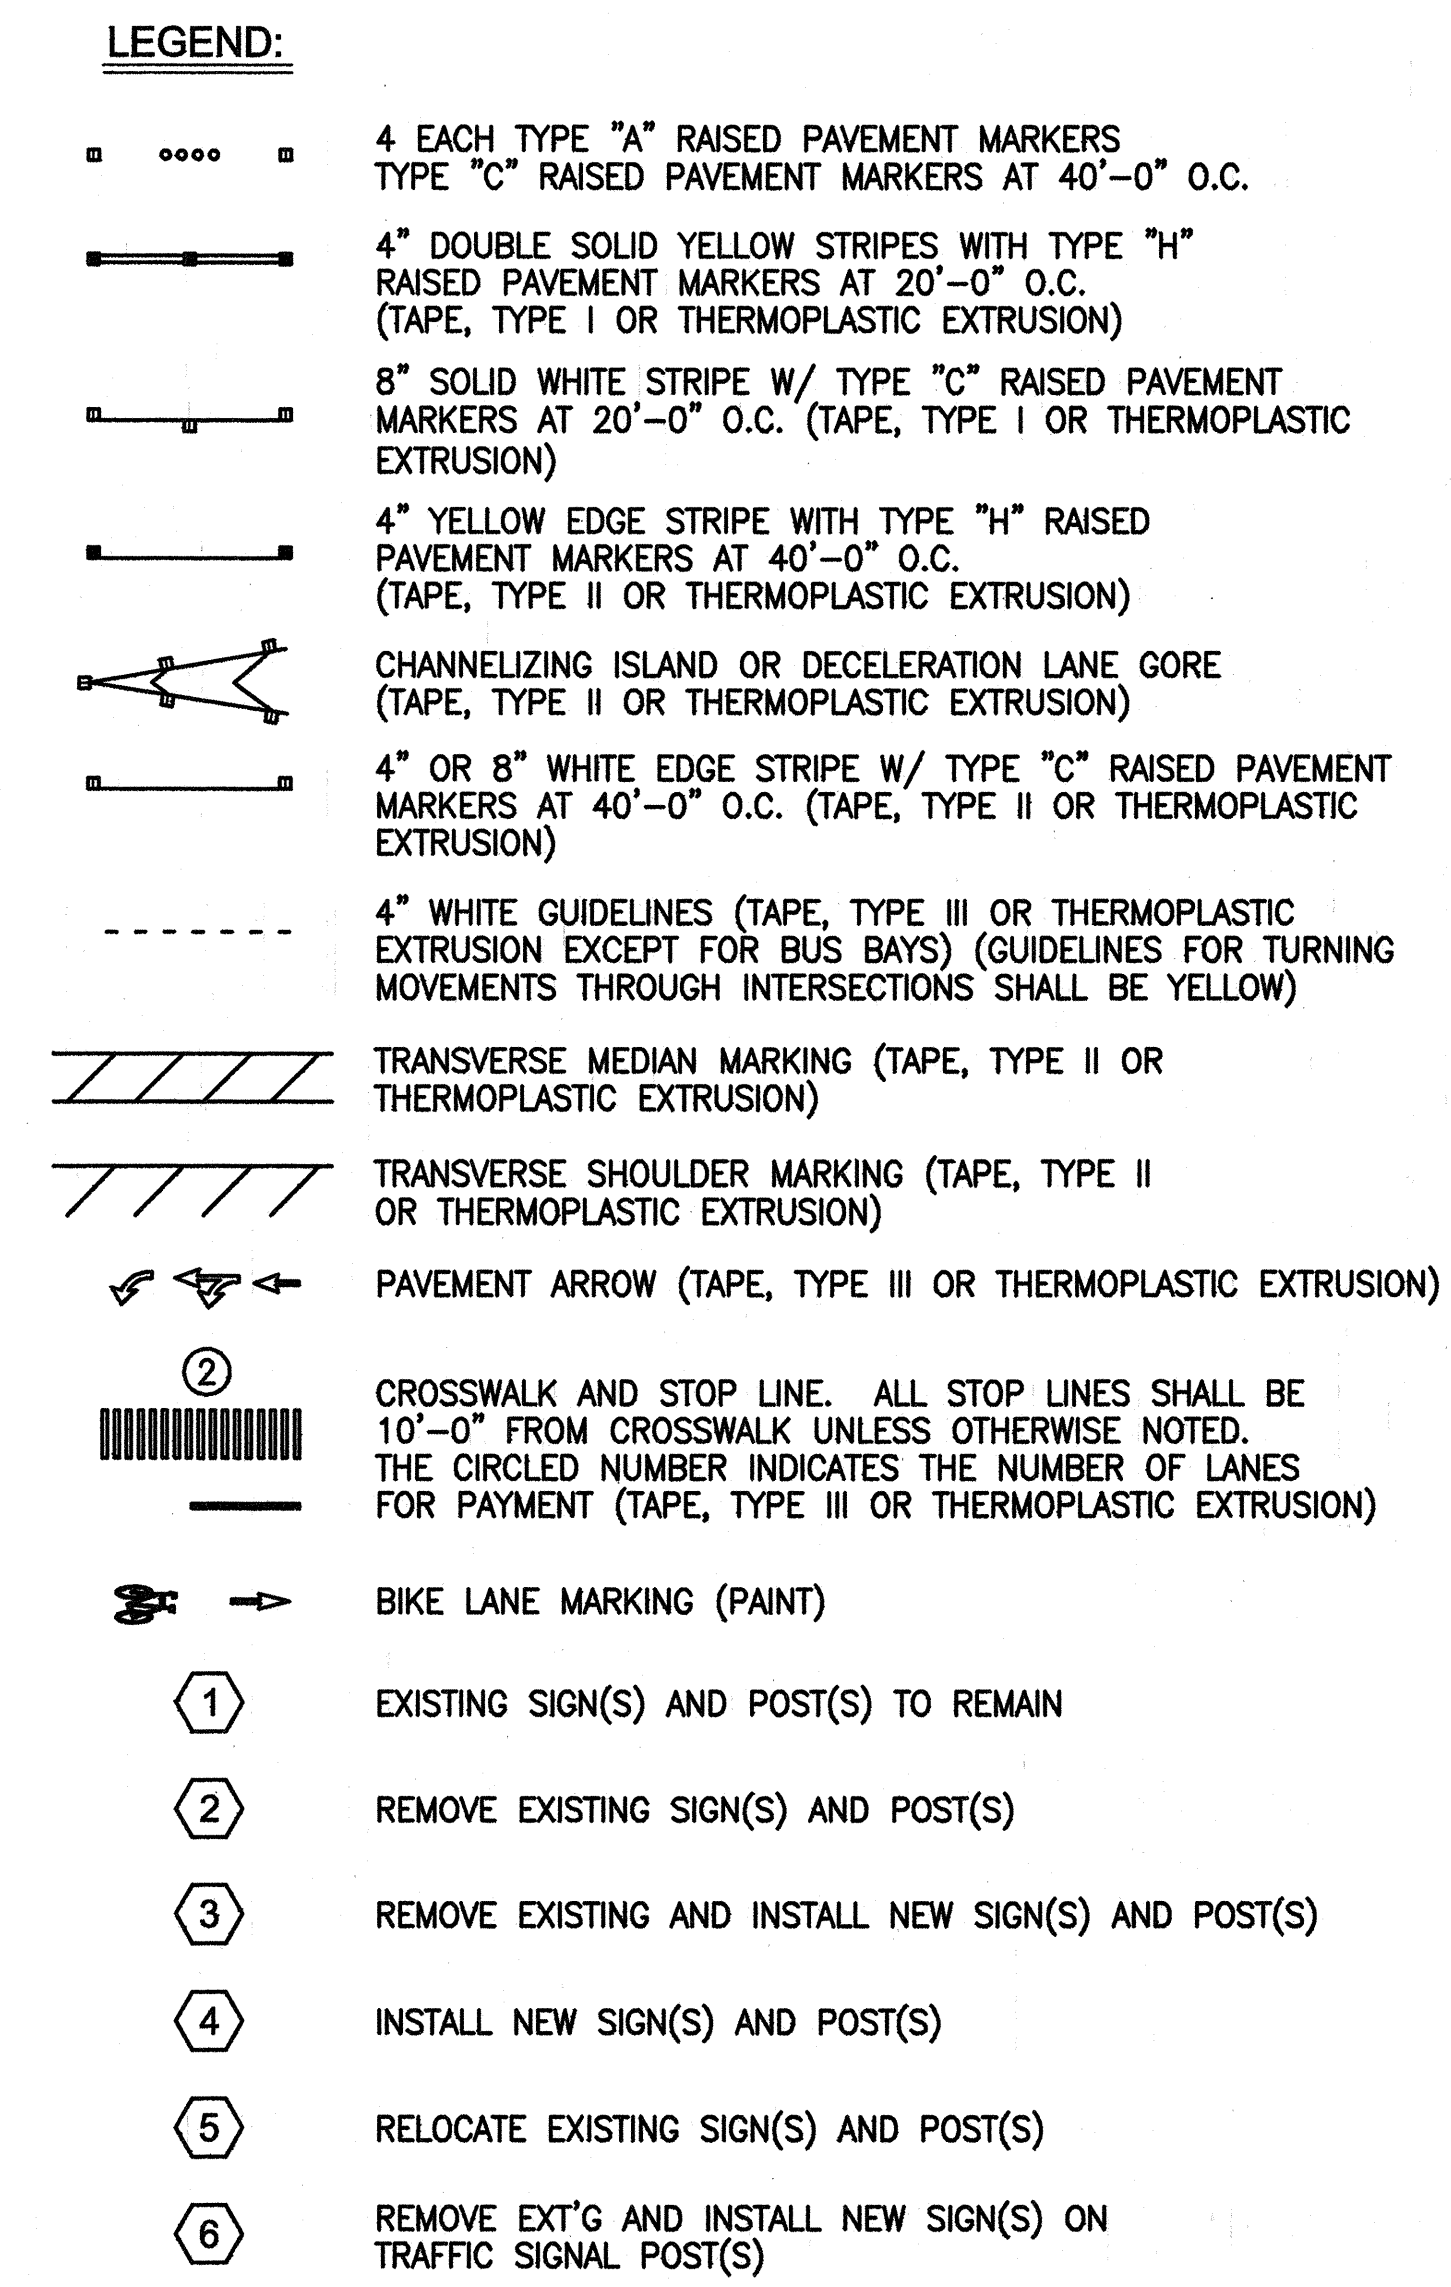

DARREN T. UNEMORI
 LICENSED
 PROFESSIONAL
 ENGINEER
 NO. 7937-C
 HAWAII, U.S.A.

THIS WORK WAS PREPARED BY ME
 OR UNDER MY SUPERVISION


 Signature

STATE OF HAWAII
DEPARTMENT OF TRANSPORTATION
HIGHWAYS DIVISION

INTERSECTION STRIPING & SIGNAGE PLAN


MAIN STREET RESURFACING
CENTRAL AVENUE TO KAAHUMANU AVENUE
AND
KAAHUMANU AVENUE RESURFACING
MAIN STREET TO HOBSON AVENUE
Fed. Aid Project No. NH-032-1(8)

SCALE: AS NOTED

SHEET No. 12 OF 15 SHEETS

FED. ROAD DIST. NO.	STATE	FED. AID PROJ. NO.	FISCAL YEAR	SHEET NO.	TOTAL SHEETS
HAWAII	HAW.	NH-032-1(8)	2000	76	111


TRUE NORTH
SCALE: 1 IN. = 20 FT.

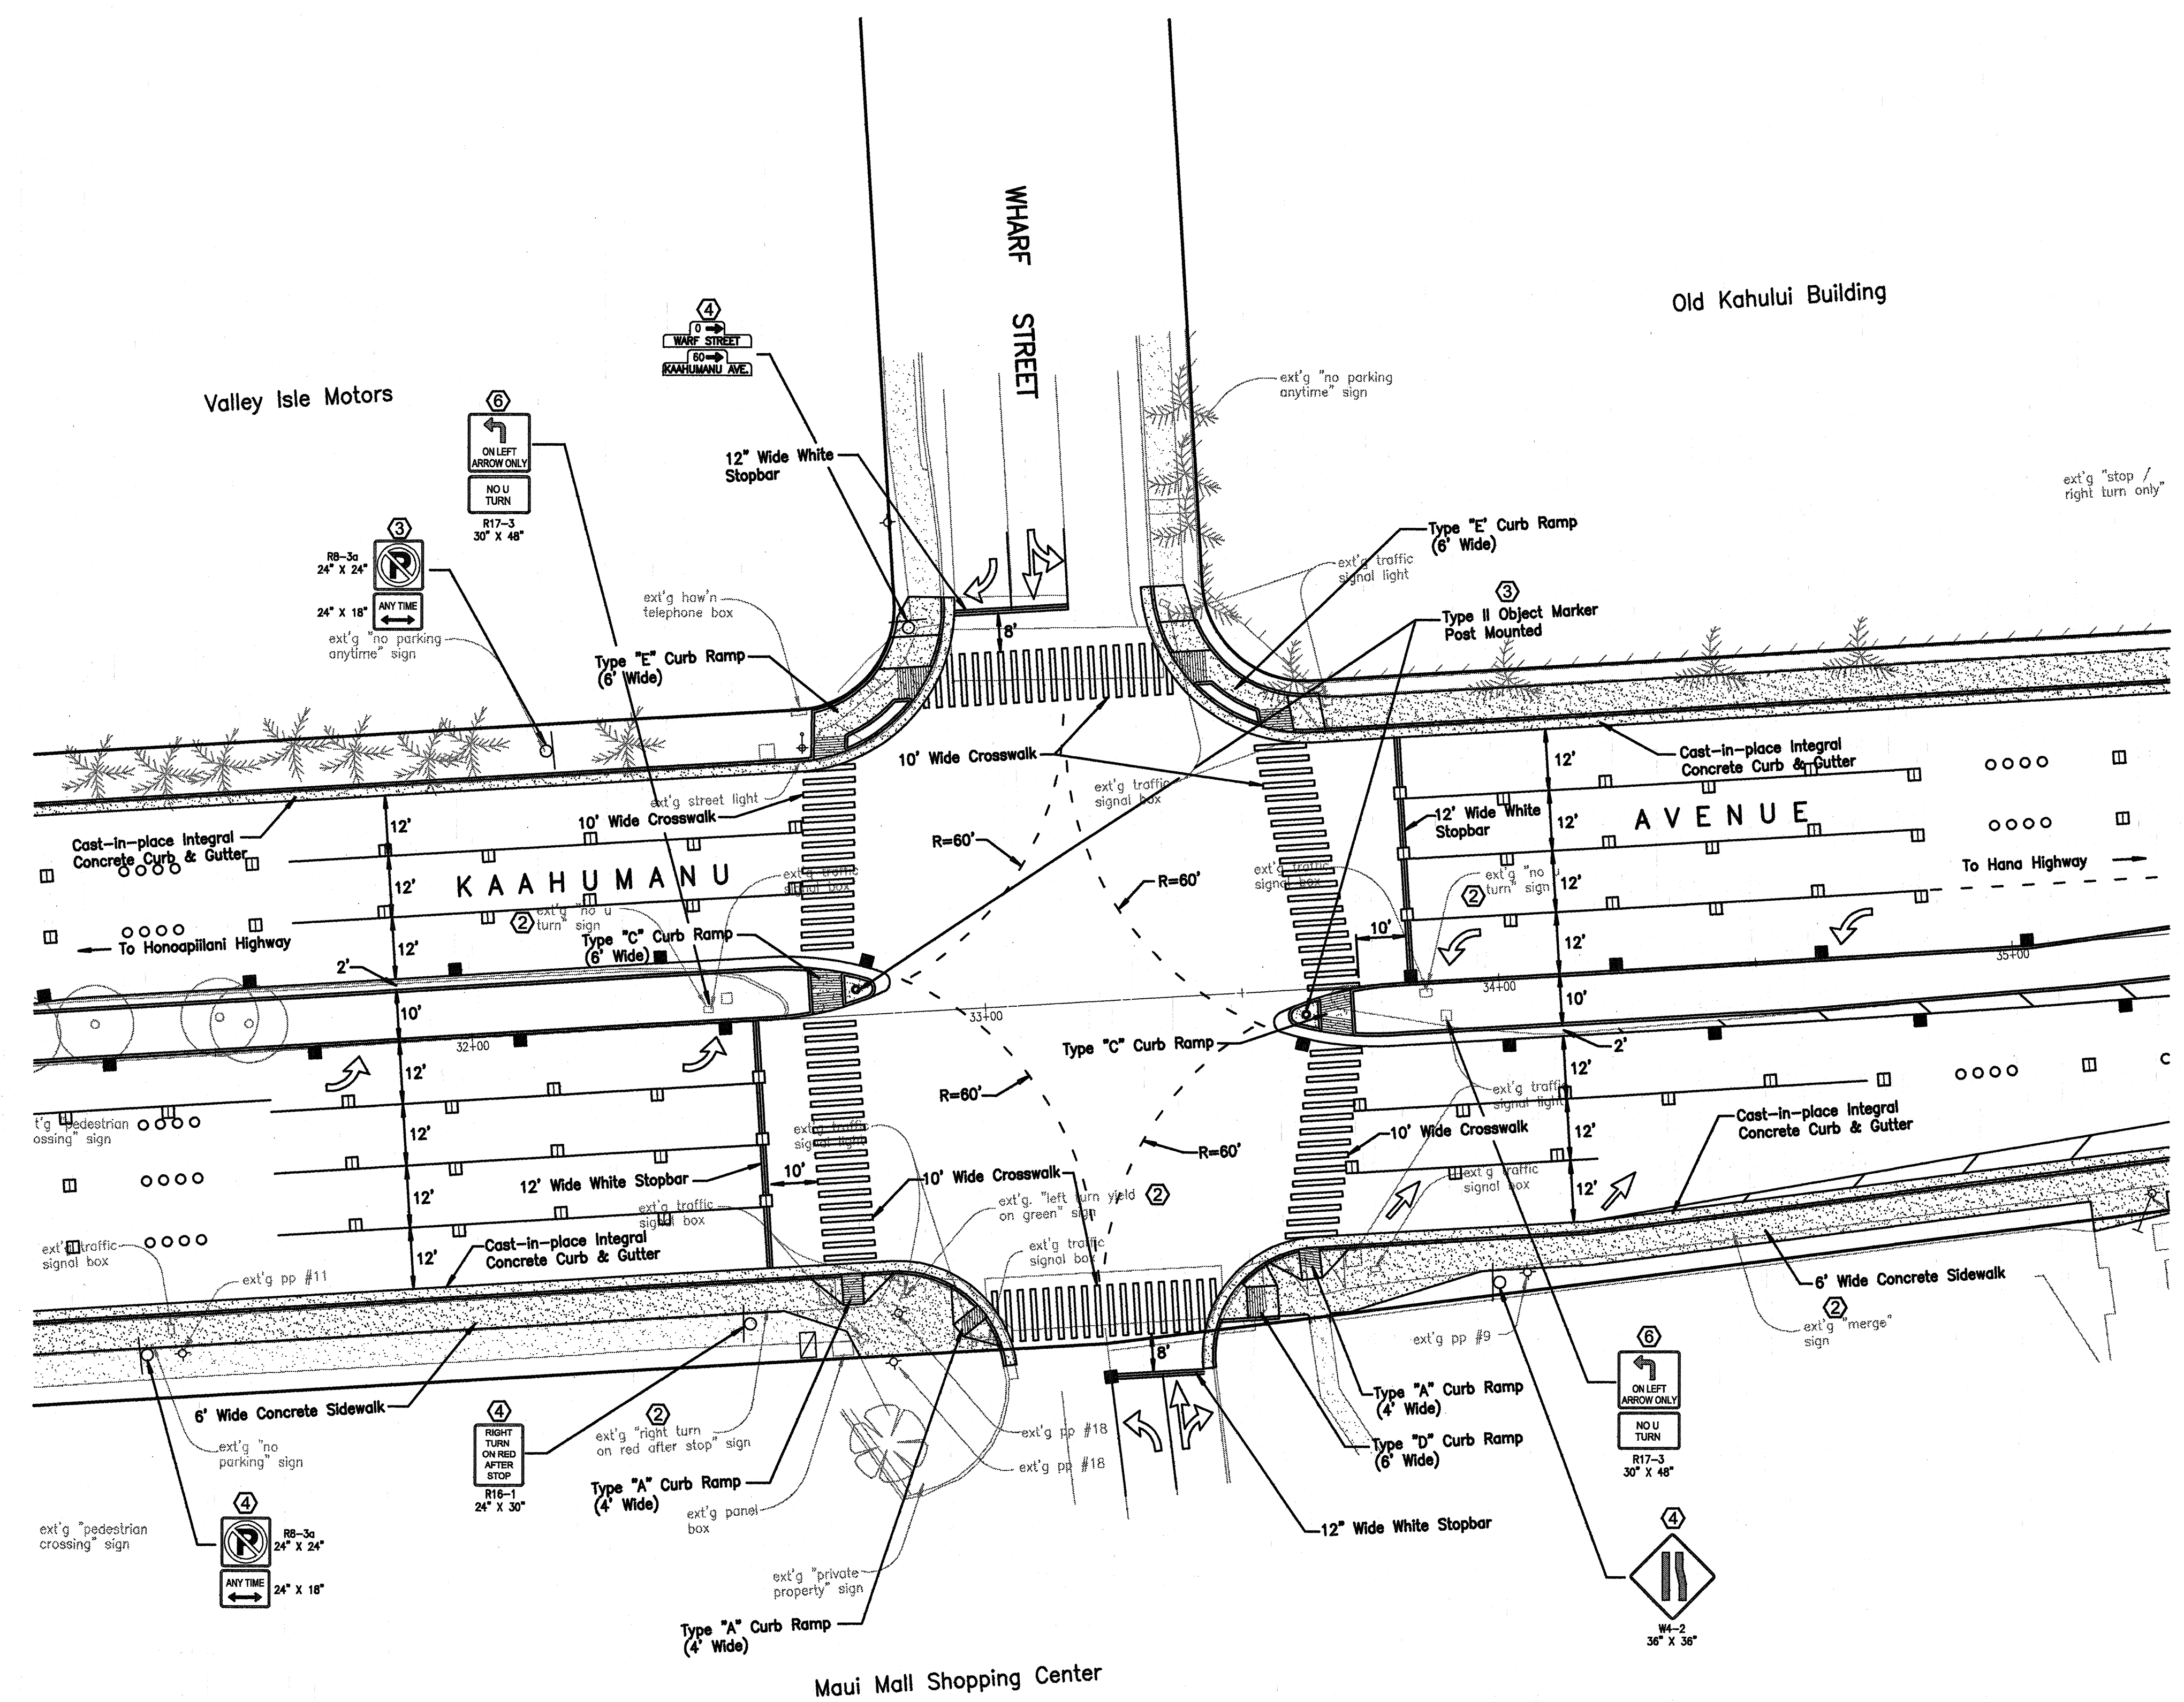

LEGEND:

- 4 EACH TYPE "A" RAISED PAVEMENT MARKERS
TYPE "C" RAISED PAVEMENT MARKERS AT 40'-0" O.C.
- 4" DOUBLE SOLID YELLOW STRIPES WITH TYPE "H" RAISED PAVEMENT MARKERS AT 20'-0" O.C. (TAPE, TYPE I OR THERMOPLASTIC EXTRUSION)
- 8" SOLID WHITE STRIPE W/ TYPE "C" RAISED PAVEMENT MARKERS AT 20'-0" O.C. (TAPE, TYPE I OR THERMOPLASTIC EXTRUSION)
- 4" YELLOW EDGE STRIPE WITH TYPE "H" RAISED PAVEMENT MARKERS AT 40'-0" O.C. (TAPE, TYPE II OR THERMOPLASTIC EXTRUSION)
- CHANNELIZING ISLAND OR DECELERATION LANE GORE (TAPE, TYPE II OR THERMOPLASTIC EXTRUSION)
- 4" OR 8" WHITE EDGE STRIPE W/ TYPE "C" RAISED PAVEMENT MARKERS AT 40'-0" O.C. (TAPE, TYPE II OR THERMOPLASTIC EXTRUSION)
- 4" WHITE GUIDELINES (TAPE, TYPE III OR THERMOPLASTIC EXTRUSION EXCEPT FOR BUS BAYS) (GUIDELINES FOR TURNING MOVEMENTS THROUGH INTERSECTIONS SHALL BE YELLOW)
- TRANSVERSE MEDIAN MARKING (TAPE, TYPE II OR THERMOPLASTIC EXTRUSION)
- TRANSVERSE SHOULDER MARKING (TAPE, TYPE II OR THERMOPLASTIC EXTRUSION)
- PAVEMENT ARROW (TAPE, TYPE III OR THERMOPLASTIC EXTRUSION)
- CROSSWALK AND STOP LINE. ALL STOP LINES SHALL BE 10'-0" FROM CROSSWALK UNLESS OTHERWISE NOTED. THE CIRCLED NUMBER INDICATES THE NUMBER OF LANES FOR PAYMENT (TAPE, TYPE III OR THERMOPLASTIC EXTRUSION)
- BIKE LANE MARKING (PAINT)
- EXISTING SIGN(S) AND POST(S) TO REMAIN
- REMOVE EXISTING SIGN(S) AND POST(S)
- REMOVE EXISTING AND INSTALL NEW SIGN(S) AND POST(S)
- INSTALL NEW SIGN(S) AND POST(S)
- RELOCATE EXISTING SIGN(S) AND POST(S)
- REMOVE EXT'G AND INSTALL NEW SIGN(S) ON TRAFFIC SIGNAL POST(S)

INTERSECTION - KAAHUMANU AVENUE / WHARF STREET

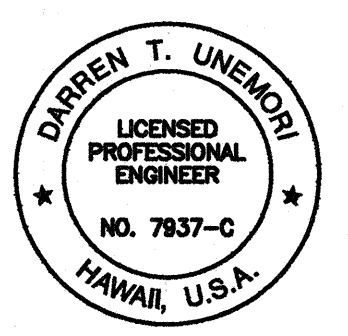

THIS WORK WAS PREPARED BY ME OR UNDER MY SUPERVISION
Signature

STATE OF HAWAII
DEPARTMENT OF TRANSPORTATION
HIGHWAYS DIVISION

INTERSECTION STRIPING & SIGNAGE PLAN


MAIN STREET RESURFACING
CENTRAL AVENUE TO KAAHUMANU AVENUE
AND
KAAHUMANU AVENUE RESURFACING
MAIN STREET TO HOBSON AVENUE
Fed. Aid Project No. NH-032-1(8)

SCALE: AS NOTED

DATE	DATE	DATE	DATE	DATE
DESIGNED BY	DESIGNED BY	DESIGNED BY	DESIGNED BY	DESIGNED BY
TRACED BY	TRACED BY	TRACED BY	TRACED BY	TRACED BY
NOTE BOOK	NOTE BOOK	NOTE BOOK	NOTE BOOK	NOTE BOOK
CHECKED BY	CHECKED BY	CHECKED BY	CHECKED BY	CHECKED BY

88proj/98049/compans/in-at0a.dwg

FED. ROAD DIST. NO.	STATE	FED. AID PROJ. NO.	FISCAL YEAR	SHEET NO.	TOTAL SHEETS
HAWAII	HAW.	NH-032-1(8)	2000	77	111

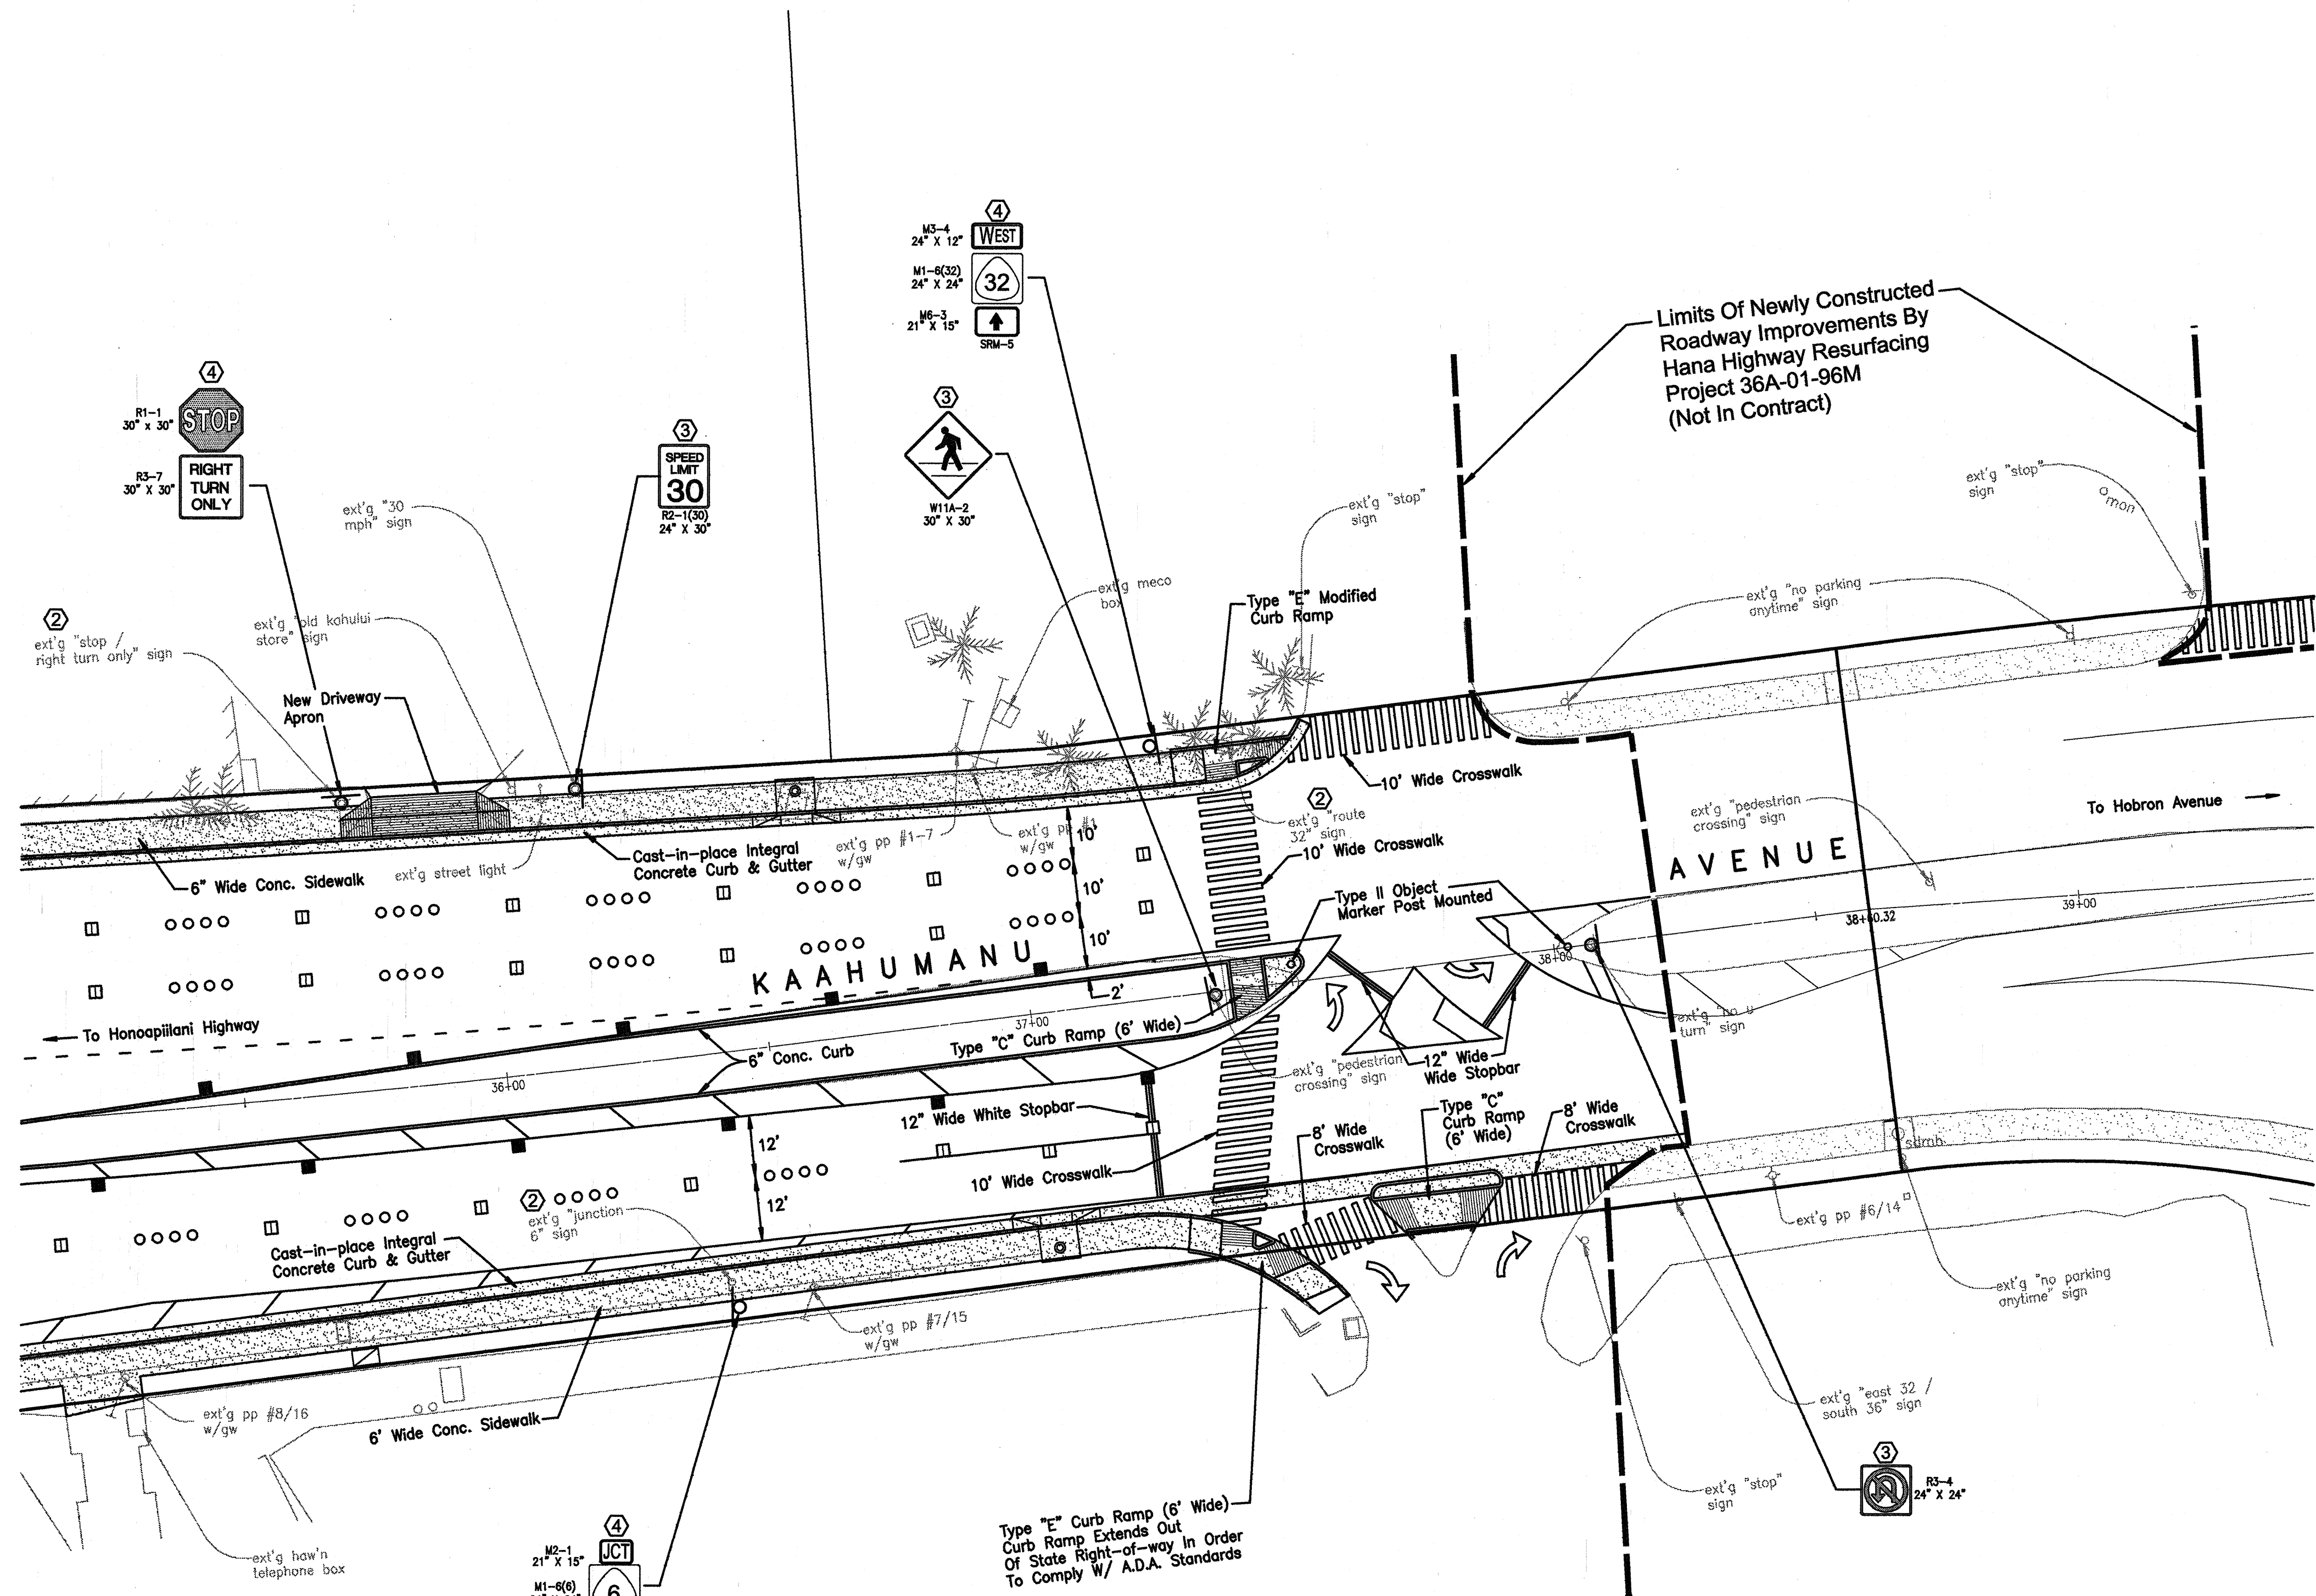


LEGEND:

- 4 EACH TYPE "A" RAISED PAVEMENT MARKERS
TYPE "C" RAISED PAVEMENT MARKERS AT 40'-0" O.C.
- 4" DOUBLE SOLID YELLOW STRIPES WITH TYPE "H"
RAISED PAVEMENT MARKERS AT 20'-0" O.C.
(TAPE, TYPE I OR THERMOPLASTIC EXTRUSION)
- 8" SOLID WHITE STRIPE W/ TYPE "C" RAISED PAVEMENT
MARKERS AT 20'-0" O.C. (TAPE, TYPE I OR THERMOPLASTIC
EXTRUSION)
- 4" YELLOW EDGE STRIPE WITH TYPE "H" RAISED
PAVEMENT MARKERS AT 40'-0" O.C.
(TAPE, TYPE II OR THERMOPLASTIC EXTRUSION)
- CHANNELIZING ISLAND OR DECELERATION LANE GORE
(TAPE, TYPE II OR THERMOPLASTIC EXTRUSION)
- 4" OR 8" WHITE EDGE STRIPE W/ TYPE "C" RAISED PAVEMENT
MARKERS AT 40'-0" O.C. (TAPE, TYPE II OR THERMOPLASTIC
EXTRUSION)
- 4" WHITE GUIDELINES (TAPE, TYPE III OR THERMOPLASTIC
EXTRUSION EXCEPT FOR BUS BAYS) (GUIDELINES FOR TURNING
MOVEMENTS THROUGH INTERSECTIONS SHALL BE YELLOW)
- TRANSVERSE MEDIAN MARKING (TAPE, TYPE II OR
THERMOPLASTIC EXTRUSION)
- TRANSVERSE SHOULDER MARKING (TAPE, TYPE II
OR THERMOPLASTIC EXTRUSION)
- PAVEMENT ARROW (TAPE, TYPE III OR THERMOPLASTIC EXTRUSION)
- CROSSWALK AND STOP LINE. ALL STOP LINES SHALL BE
10'-0" FROM CROSSWALK UNLESS OTHERWISE NOTED.
THE CIRCLED NUMBER INDICATES THE NUMBER OF LANES
FOR PAYMENT (TAPE, TYPE III OR THERMOPLASTIC EXTRUSION)
- BIKE LANE MARKING (PAINT)
- EXISTING SIGN(S) AND POST(S) TO REMAIN
- REMOVE EXISTING SIGN(S) AND POST(S)
- REMOVE EXISTING AND INSTALL NEW SIGN(S) AND POST(S)
- INSTALL NEW SIGN(S) AND POST(S)
- RELOCATE EXISTING SIGN(S) AND POST(S)
- REMOVE EXT'G AND INSTALL NEW SIGN(S) ON
TRAFFIC SIGNAL POST(S)

DATE	DATE	DATE	DATE	DATE	DATE
DESIGNED BY	DESIGNED BY	DESIGNED BY	DESIGNED BY	DESIGNED BY	DESIGNED BY
CHECKED BY	CHECKED BY	CHECKED BY	CHECKED BY	CHECKED BY	CHECKED BY
ORIGINAL PLAN	NOTE BOOK	NOTE BOOK	NOTE BOOK	NOTE BOOK	NOTE BOOK
NO.	NO.	NO.	NO.	NO.	NO.

INTERSECTION - KAAHUMANU AVENUE AT STA. 38+00±

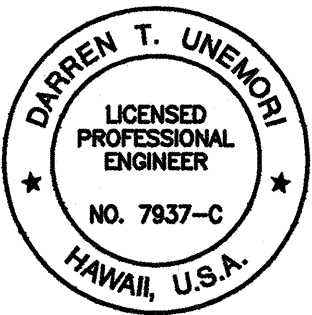


THIS WORK WAS PREPARED BY ME
OR UNDER MY SUPERVISION
[Signature]
Signature

STATE OF HAWAII
DEPARTMENT OF TRANSPORTATION
HIGHWAYS DIVISION
INTERSECTION STRIPING & SIGNAGE PLAN
MAIN STREET RESURFACING
CENTRAL AVENUE TO KAAHUMANU AVENUE
AND
KAAHUMANU AVENUE RESURFACING
MAIN STREET TO HOBRON AVENUE
Fed. Aid Project No. NH-032-1(8)


SCALE: AS NOTED
SHEET No. 14 OF 15 SHEETS

ORIGINAL PLAN	SURVEY PLOTTED BY _____ DATE _____			
	DRAWN BY _____ DATE _____			
NOTE BOOK	TRACED BY _____ DATE _____			
	DESIGNED BY _____ DATE _____			
	QUANTITIES BY _____ DATE _____			
	CHECKED BY _____ DATE _____			
No. _____				

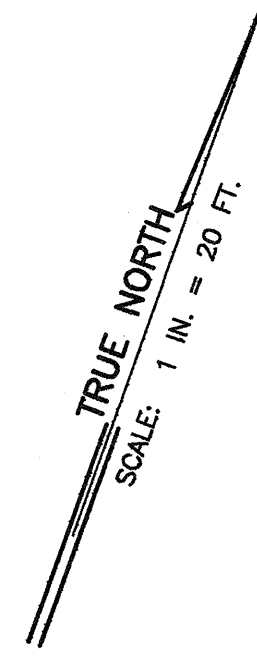

LEGEND:

- 4 EACH TYPE "A" RAISED PAVEMENT MARKERS
TYPE "C" RAISED PAVEMENT MARKERS AT 40'-0" O.C.
- 4" DOUBLE SOLID YELLOW STRIPES WITH TYPE "H"
RAISED PAVEMENT MARKERS AT 20'-0" O.C.
(TAPE, TYPE I OR THERMOPLASTIC EXTRUSION)
- 8" SOLID WHITE STRIPE W/ TYPE "C" RAISED PAVEMENT
MARKERS AT 20'-0" O.C. (TAPE, TYPE I OR THERMOPLASTIC
EXTRUSION)
- 4" YELLOW EDGE STRIPE WITH TYPE "H" RAISED
PAVEMENT MARKERS AT 40'-0" O.C.
(TAPE, TYPE II OR THERMOPLASTIC EXTRUSION)
- CHANNELIZING ISLAND OR DECELERATION LANE GORE
(TAPE, TYPE II OR THERMOPLASTIC EXTRUSION)
- 4" OR 8" WHITE EDGE STRIPE W/ TYPE "C" RAISED PAVEMENT
MARKERS AT 40'-0" O.C. (TAPE, TYPE II OR THERMOPLASTIC
EXTRUSION)
- 4" WHITE GUIDELINES (TAPE, TYPE III OR THERMOPLASTIC
EXTRUSION EXCEPT FOR BUS BAYS) (GUIDELINES FOR TURNING
MOVEMENTS THROUGH INTERSECTIONS SHALL BE YELLOW)
- TRANSVERSE MEDIAN MARKING (TAPE, TYPE II OR
THERMOPLASTIC EXTRUSION)
- TRANSVERSE SHOULDER MARKING (TAPE, TYPE II
OR THERMOPLASTIC EXTRUSION)
- PAVEMENT ARROW (TAPE, TYPE III OR THERMOPLASTIC EXTRUSION)
- CROSSWALK AND STOP LINE. ALL STOP LINES SHALL BE
10'-0" FROM CROSSWALK UNLESS OTHERWISE NOTED.
THE CIRCLED NUMBER INDICATES THE NUMBER OF LANES
FOR PAYMENT (TAPE, TYPE III OR THERMOPLASTIC EXTRUSION)
- BIKE LANE MARKING (PAINT)
- EXISTING SIGN(S) AND POST(S) TO REMAIN
- REMOVE EXISTING SIGN(S) AND POST(S)
- REMOVE EXISTING AND INSTALL NEW SIGN(S) AND POST(S)
- INSTALL NEW SIGN(S) AND POST(S)
- RELOCATE EXISTING SIGN(S) AND POST(S)
- REMOVE EXT'G AND INSTALL NEW SIGN(S) ON
TRAFFIC SIGNAL POST(S)

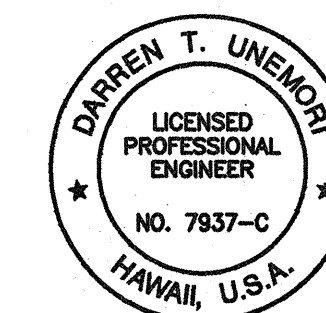

THIS WORK WAS PREPARED BY ME
OR UNDER MY SUPERVISION

Sh. T. - 4/18/00
Signature

STATE OF HAWAII
DEPARTMENT OF TRANSPORTATION
HIGHWAYS DIVISION

INTERSECTION STRIPING & SIGNAGE PLAN

MAIN STREET RESURFACING
CENTRAL AVENUE TO KAAHUMANU AVENUE
AND
KAAHUMANU AVENUE RESURFACING
MAIN STREET TO HOBSON AVENUE
Fed. Aid Project No. NH-032-1(8)

SCALE: AS NOTED

SHEET No. 15 OF 15 SHEETS