
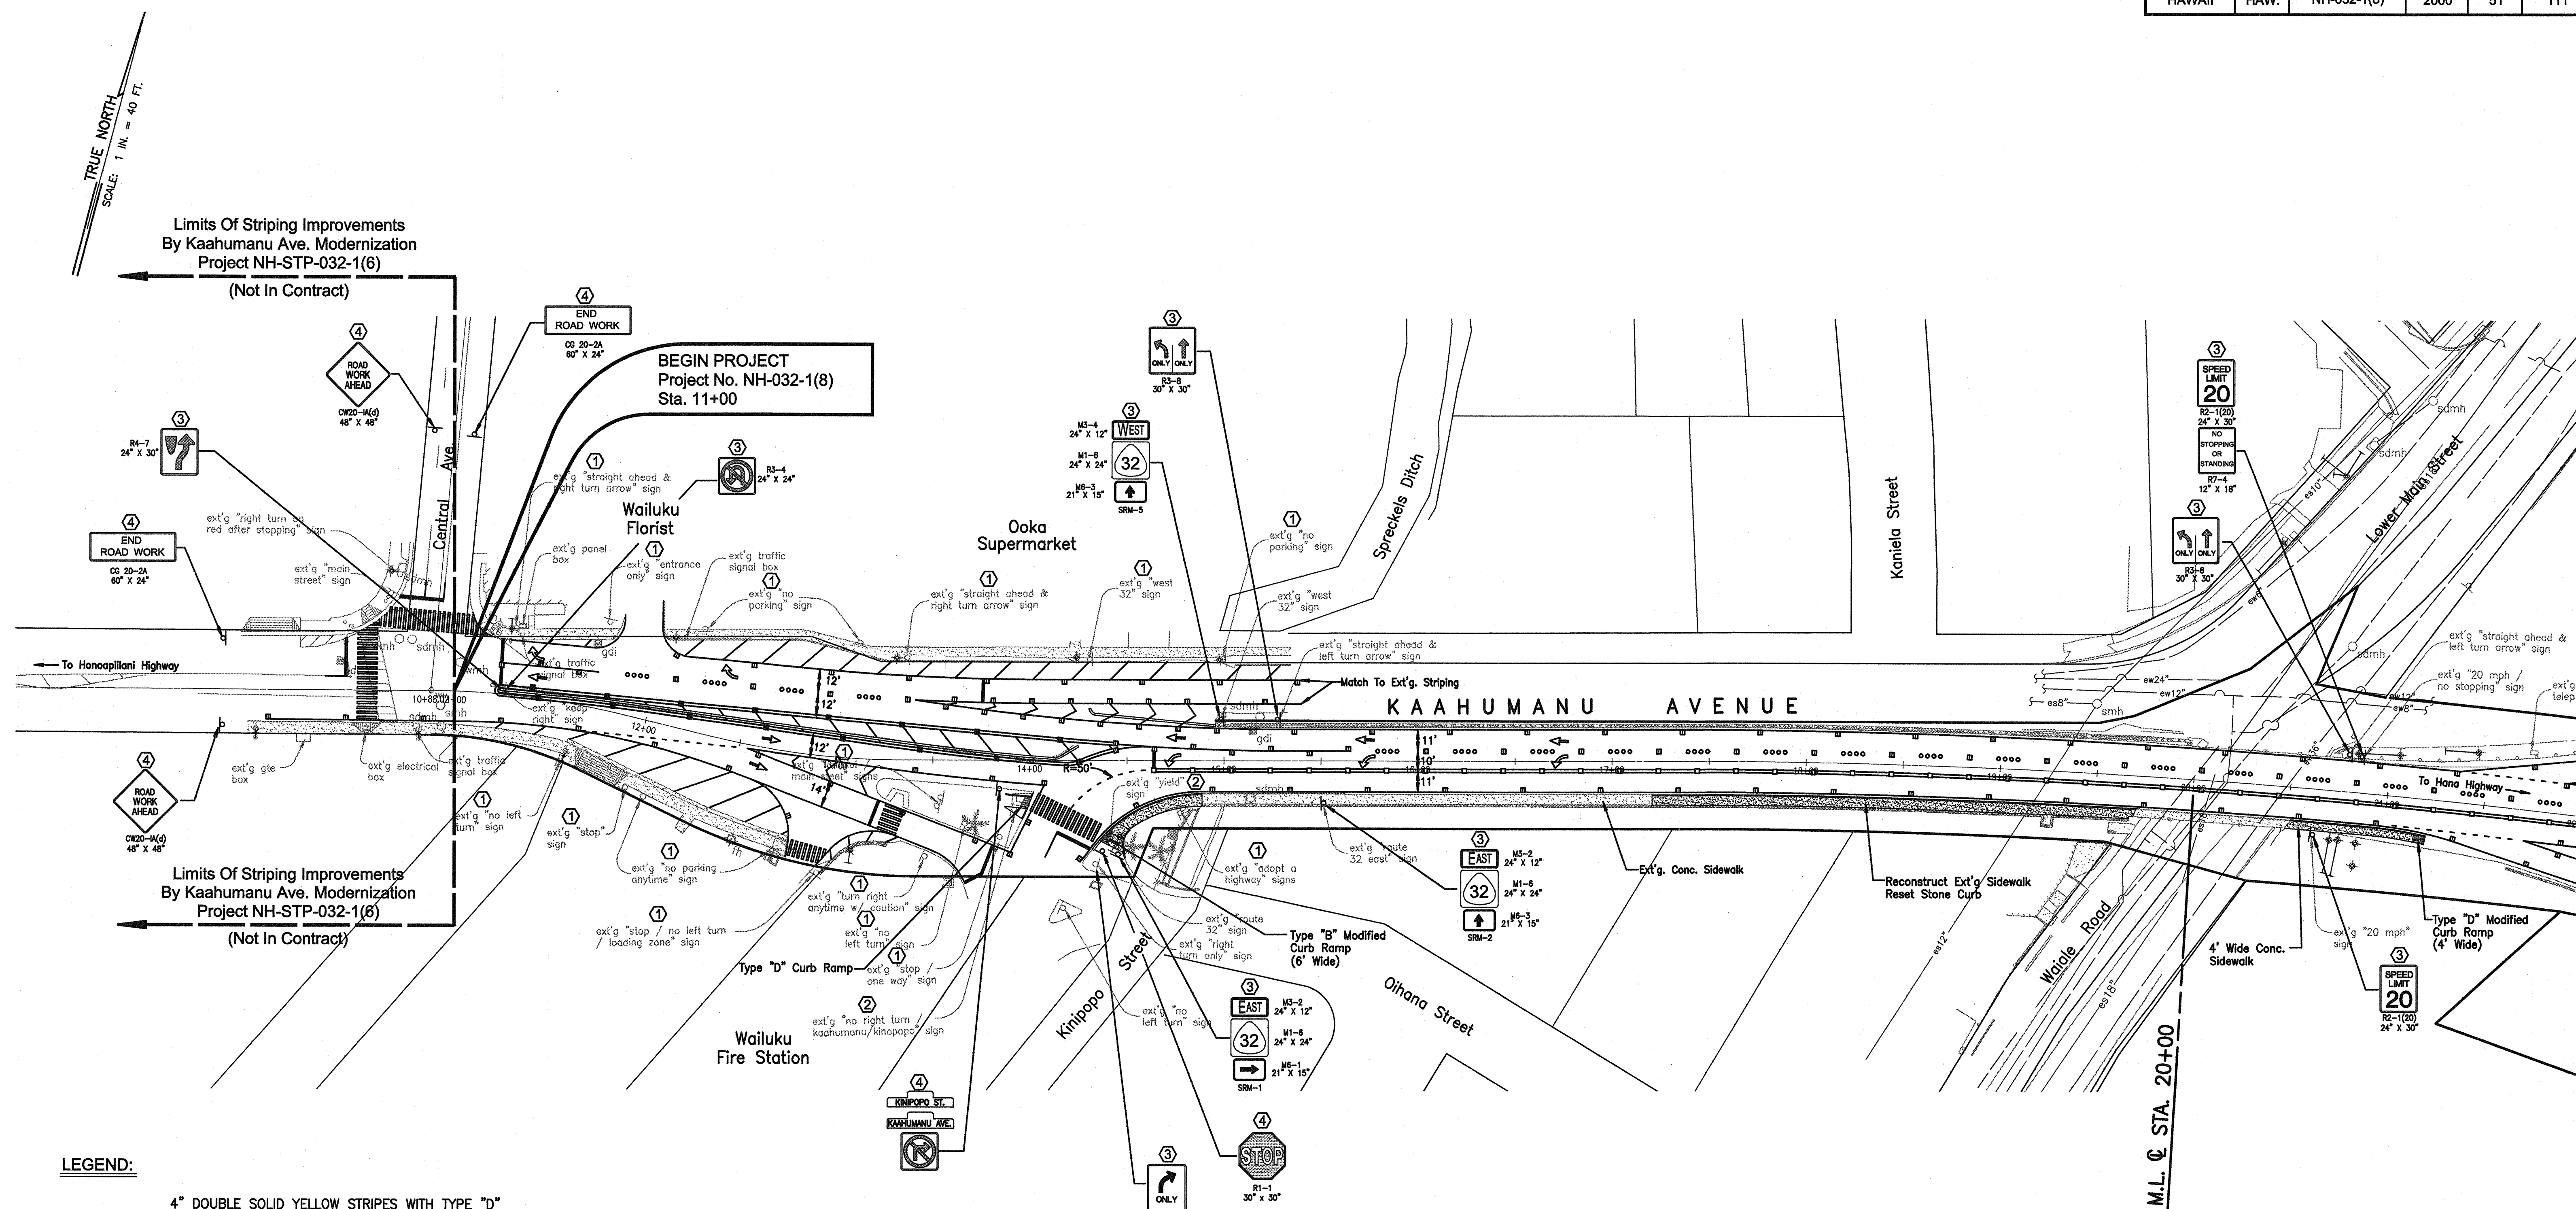 


FED. ROAD DIST. NO.	STATE	FED. AID PROJ. NO.	FISCAL YEAR	SHEET NO.	TOTAL SHEETS
HAWAII	HAW.	NH-032-1(8)	2000	51	111




LEGEND:

- 4" DOUBLE SOLID YELLOW STRIPES WITH TYPE "D" RAISED PAVEMENT MARKERS AT 20'-0" O.C. (TAPE, TYPE I OR THERMOPLASTIC EXTRUSION)
- 4 EACH TYPE "A" RAISED PAVEMENT MARKERS TYPE "C" RAISED PAVEMENT MARKERS AT 40'-0" O.C.
- 4" DOUBLE SOLID YELLOW STRIPES WITH TYPE "H" RAISED PAVEMENT MARKERS AT 20'-0" O.C. (TAPE, TYPE II OR THERMOPLASTIC EXTRUSION)
- 8" SOLID WHITE STRIPE W/ TYPE "C" RAISED PAVEMENT MARKERS AT 20'-0" O.C. (TAPE, TYPE I OR THERMOPLASTIC EXTRUSION)
- 4" YELLOW EDGE STRIPE WITH TYPE "H" RAISED PAVEMENT MARKERS AT 40'-0" O.C. (TAPE, TYPE II OR THERMOPLASTIC EXTRUSION)
- CHANNELIZING ISLAND OR DECELERATION LANE GORE (TAPE, TYPE II OR THERMOPLASTIC EXTRUSION)
- 4" OR 8" WHITE EDGE STRIPE W/ TYPE "C" RAISED PAVEMENT MARKERS AT 40'-0" O.C. (TAPE, TYPE II OR THERMOPLASTIC EXTRUSION)

- | | |
|---|---|
|  | BIKE LANE MARKING (PAINT) |
|  | 4" WHITE GUIDELINES (TAPE, TYPE III OR THERMOPLASTIC EXTRUSION EXCEPT FOR BUS BAYS) (GUIDE LINES FOR TURNING MOVEMENTS THROUGH INTERSECTIONS SHALL BE YELLOW) |
|  | TRANSVERSE MEDIAN MARKING (TAPE, TYPE II OR THERMOPLASTIC EXTRUSION) |
|  | TRANSVERSE SHOULDER MARKING (TAPE, TYPE II OR THERMOPLASTIC EXTRUSION) |
|  | PAVEMENT ARROW (TAPE, TYPE III OR THERMOPLASTIC EXTRUSION) |
| 
② | CROSSWALK AND STOP LINE. ALL STOP LINES SHALL BE 10'-0" FROM CROSSWALK UNLESS OTHERWISE NOTED. THE CIRCLED NUMBER INDICATES THE NUMBER OF LANES FOR PAYMENT (TAPE, TYPE III OR THERMOPLASTIC EXTRUSION) |

- ① EXISTING SIGN(S) AND POST(S) TO REMAIN
- ② REMOVE EXISTING SIGN(S) AND POST(S)
- ③ REMOVE EXISTING AND INSTALL NEW SIGN(S) AND POST(S)
- ④ INSTALL NEW SIGN(S) AND POST(S)
- ⑤ RELOCATE EXISTING SIGN(S) AND POST(S)
- ⑥ REMOVE EXT'G. AND INSTALL NEW SIGN(S) ON TRAFFIC SIGNAL POST(S)

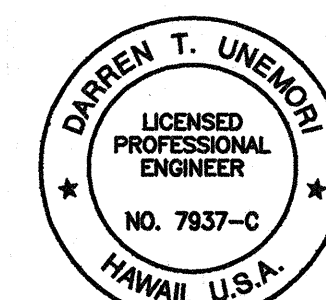

THIS WORK WAS PREPARED BY ME
OR UNDER MY SUPERVISION

[Signature] 4/18/79

STATE OF HAWAII
DEPARTMENT OF TRANSPORTATION
HIGHWAYS DIVISION


ROADWAY STRIPING & SIGNAGE PLAN

MAIN STREET RESURFACING
CENTRAL AVENUE TO KAAHUMANU AVENUE
AND
KAAHUMANU AVENUE RESURFACING
MAIN STREET TO HOBRON AVENUE
Fed. Aid Project No. NH-032-1(8)

SCALE: AS NOTED

SHEET No. 1 OF 13 SHEETS

FED. ROAD DIST. NO.	STATE	FED. AID PROJ. NO.	FISCAL YEAR	SHEET NO.	TOTAL SHEETS
HAWAII	HAW.	NH-032-1(8)	2000	52	111

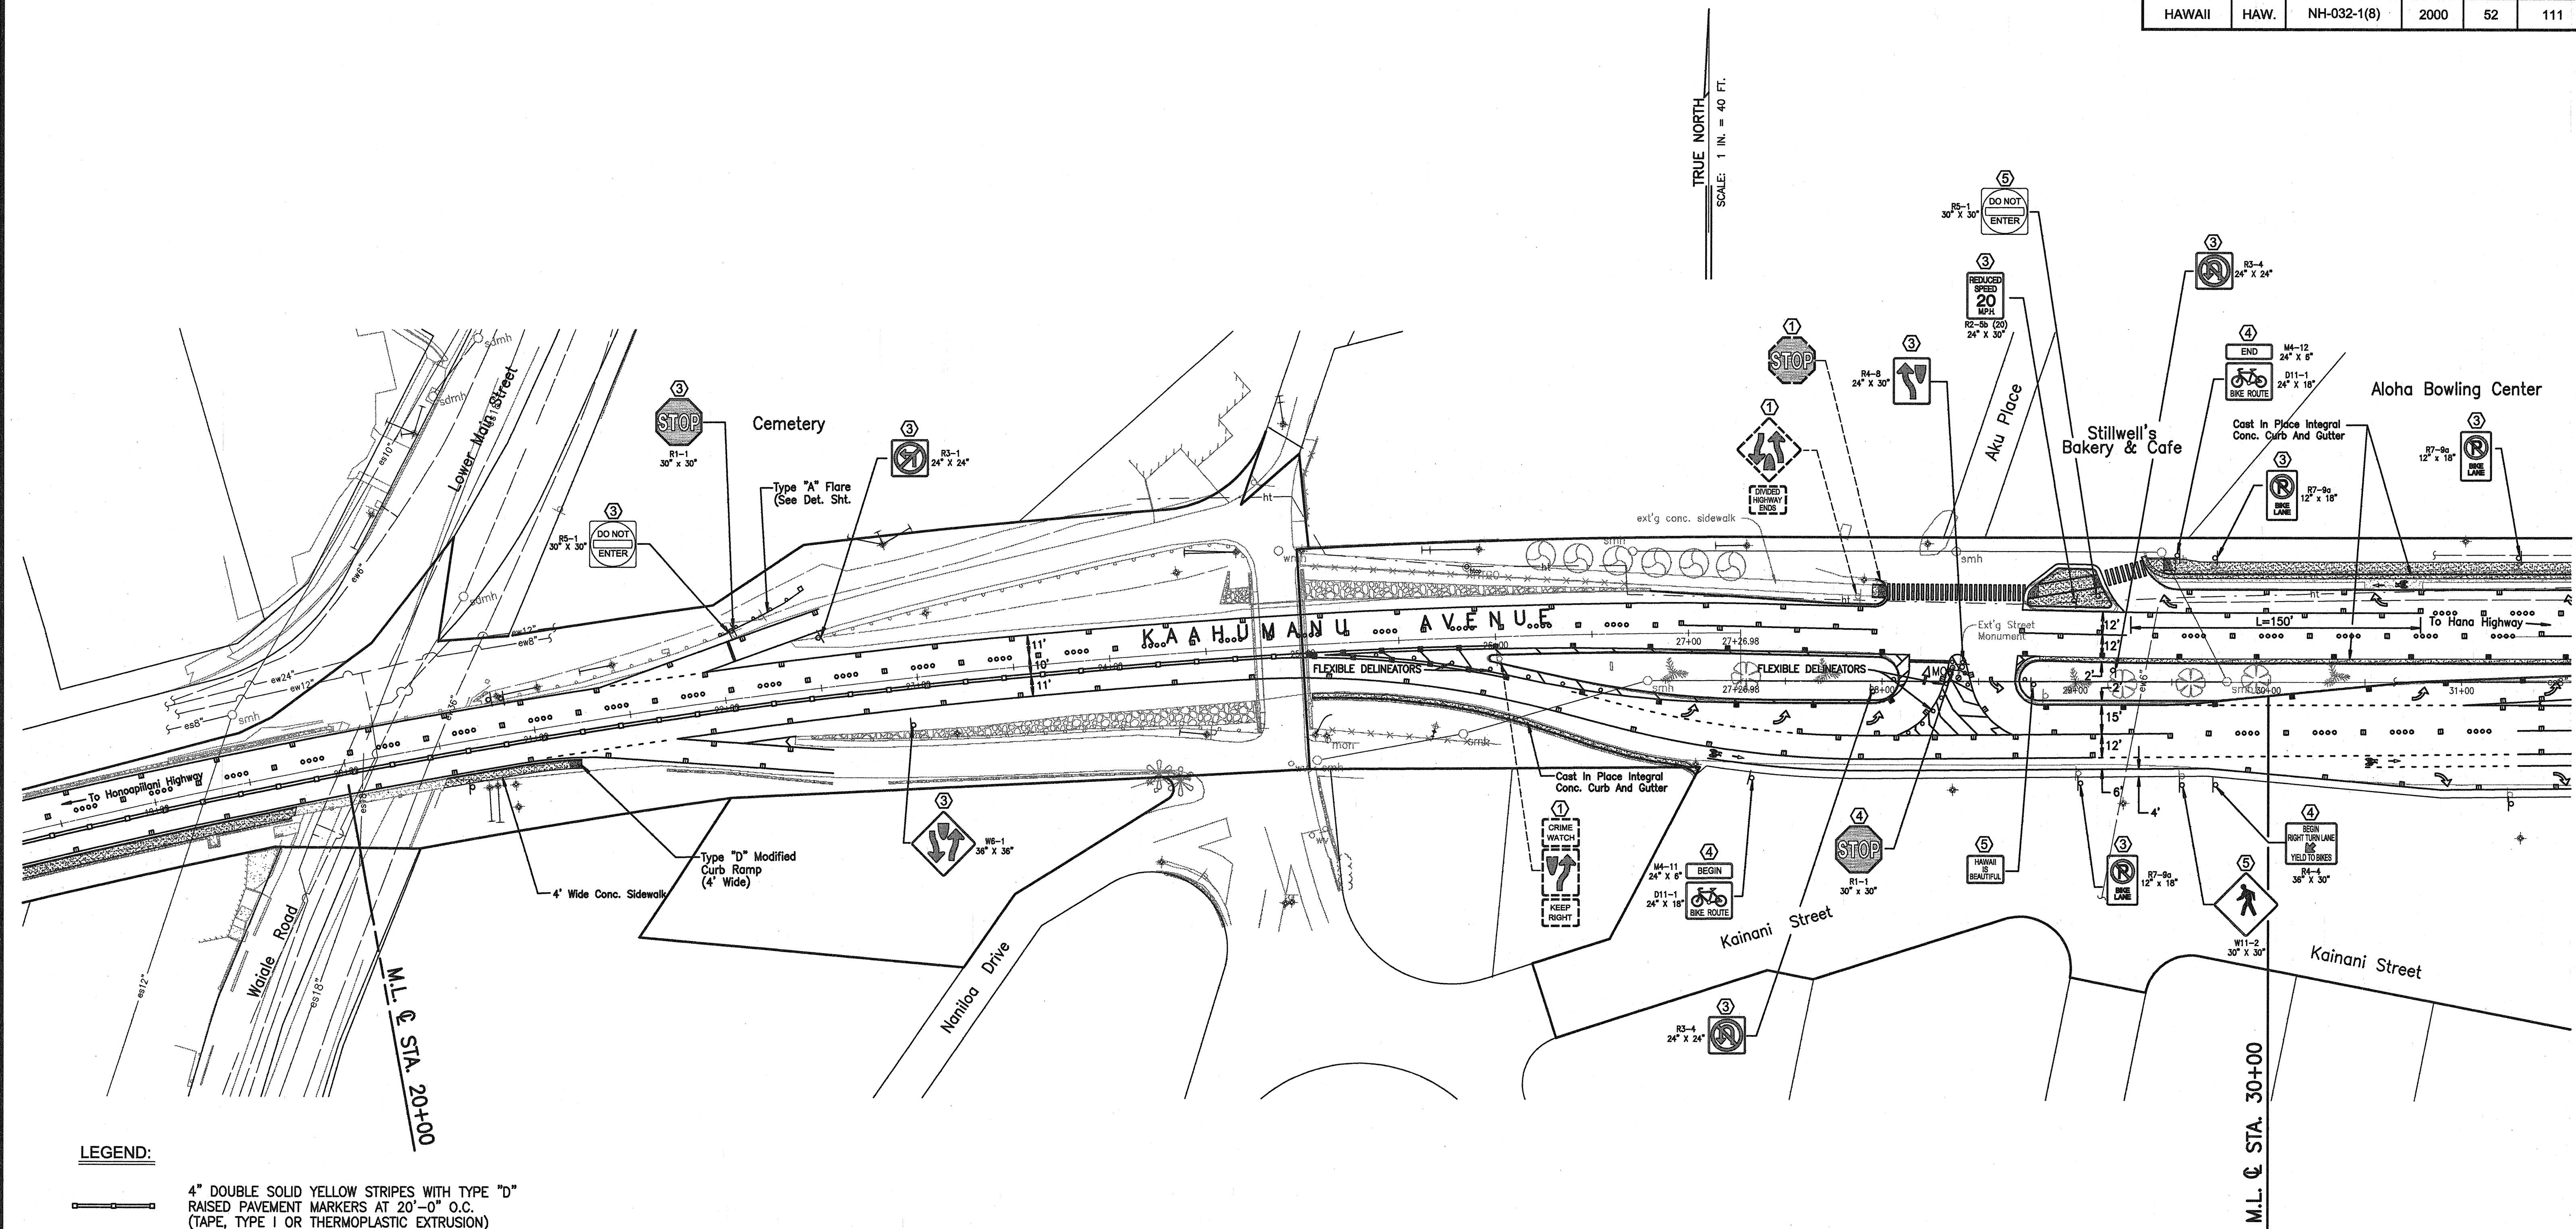


LEGEND:

- 4" DOUBLE SOLID YELLOW STRIPES WITH TYPE "D" RAISED PAVEMENT MARKERS AT 20'-0" O.C. (TAPE, TYPE I OR THERMOPLASTIC EXTRUSION)
- 4 EACH TYPE "A" RAISED PAVEMENT MARKERS TYPE "C" RAISED PAVEMENT MARKERS AT 40'-0" O.C.
- 4" DOUBLE SOLID YELLOW STRIPES WITH TYPE "H" RAISED PAVEMENT MARKERS AT 20'-0" O.C. (TAPE, TYPE II OR THERMOPLASTIC EXTRUSION)
- 8" SOLID WHITE STRIPE W/ TYPE "C" RAISED PAVEMENT MARKERS AT 20'-0" O.C. (TAPE, TYPE I OR THERMOPLASTIC EXTRUSION)
- 4" YELLOW EDGE STRIPE WITH TYPE "H" RAISED PAVEMENT MARKERS AT 40'-0" O.C. (TAPE, TYPE II OR THERMOPLASTIC EXTRUSION)
- CHANNELIZING ISLAND OR DECELERATION LANE GORE (TAPE, TYPE II OR THERMOPLASTIC EXTRUSION)
- 4" OR 8" WHITE EDGE STRIPE W/ TYPE "C" RAISED PAVEMENT MARKERS AT 40'-0" O.C. (TAPE, TYPE II OR THERMOPLASTIC EXTRUSION)

- BIKE LANE MARKING (PAINT)
- 4" WHITE GUIDELINES (TAPE, TYPE III OR THERMOPLASTIC EXTRUSION EXCEPT FOR BUS BAYS) (GUIDE LINES FOR TURNING MOVEMENTS THROUGH INTERSECTIONS SHALL BE YELLOW)
- TRANSVERSE MEDIAN MARKING (TAPE, TYPE II OR THERMOPLASTIC EXTRUSION)
- TRANSVERSE SHOULDER MARKING (TAPE, TYPE II OR THERMOPLASTIC EXTRUSION)
- PAVEMENT ARROW (TAPE, TYPE III OR THERMOPLASTIC EXTRUSION)
- CROSSWALK AND STOP LINE. ALL STOP LINES SHALL BE 10'-0" FROM CROSSWALK UNLESS OTHERWISE NOTED. THE CIRCLED NUMBER INDICATES THE NUMBER OF LANES FOR PAYMENT (TAPE, TYPE III OR THERMOPLASTIC EXTRUSION)


- 1 EXISTING SIGN(S) AND POST(S) TO REMAIN
- 2 REMOVE EXISTING SIGN(S) AND POST(S)
- 3 REMOVE EXISTING AND INSTALL NEW SIGN(S) AND POST(S)
- 4 INSTALL NEW SIGN(S) AND POST(S)
- 5 RELOCATE EXISTING SIGN(S) AND POST(S)
- 6 REMOVE EXT'G. AND INSTALL NEW SIGN(S) ON TRAFFIC SIGNAL POST(S)

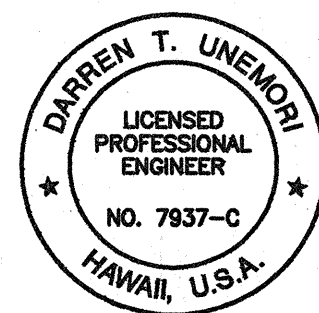

THIS WORK WAS PREPARED BY ME OR UNDER MY SUPERVISION
Signature 4/14/00

STATE OF HAWAII
DEPARTMENT OF TRANSPORTATION
HIGHWAYS DIVISION
ROADWAY STRIPING & SIGNAGE PLAN
MAIN STREET RESURFACING
CENTRAL AVENUE TO KAAHUMANU AVENUE
AND
KAAHUMANU AVENUE RESURFACING
MAIN STREET TO HOBSON AVENUE
Fed. Aid Project No. NH-032-1(8)
SCALE: AS NOTED


FED. ROAD DIST. NO.	STATE	FED. AID PROJ. NO.	FISCAL YEAR	SHEET NO.	TOTAL SHEETS
HAWAII	HAW.	NH-032-1(8)	2000	53R	111

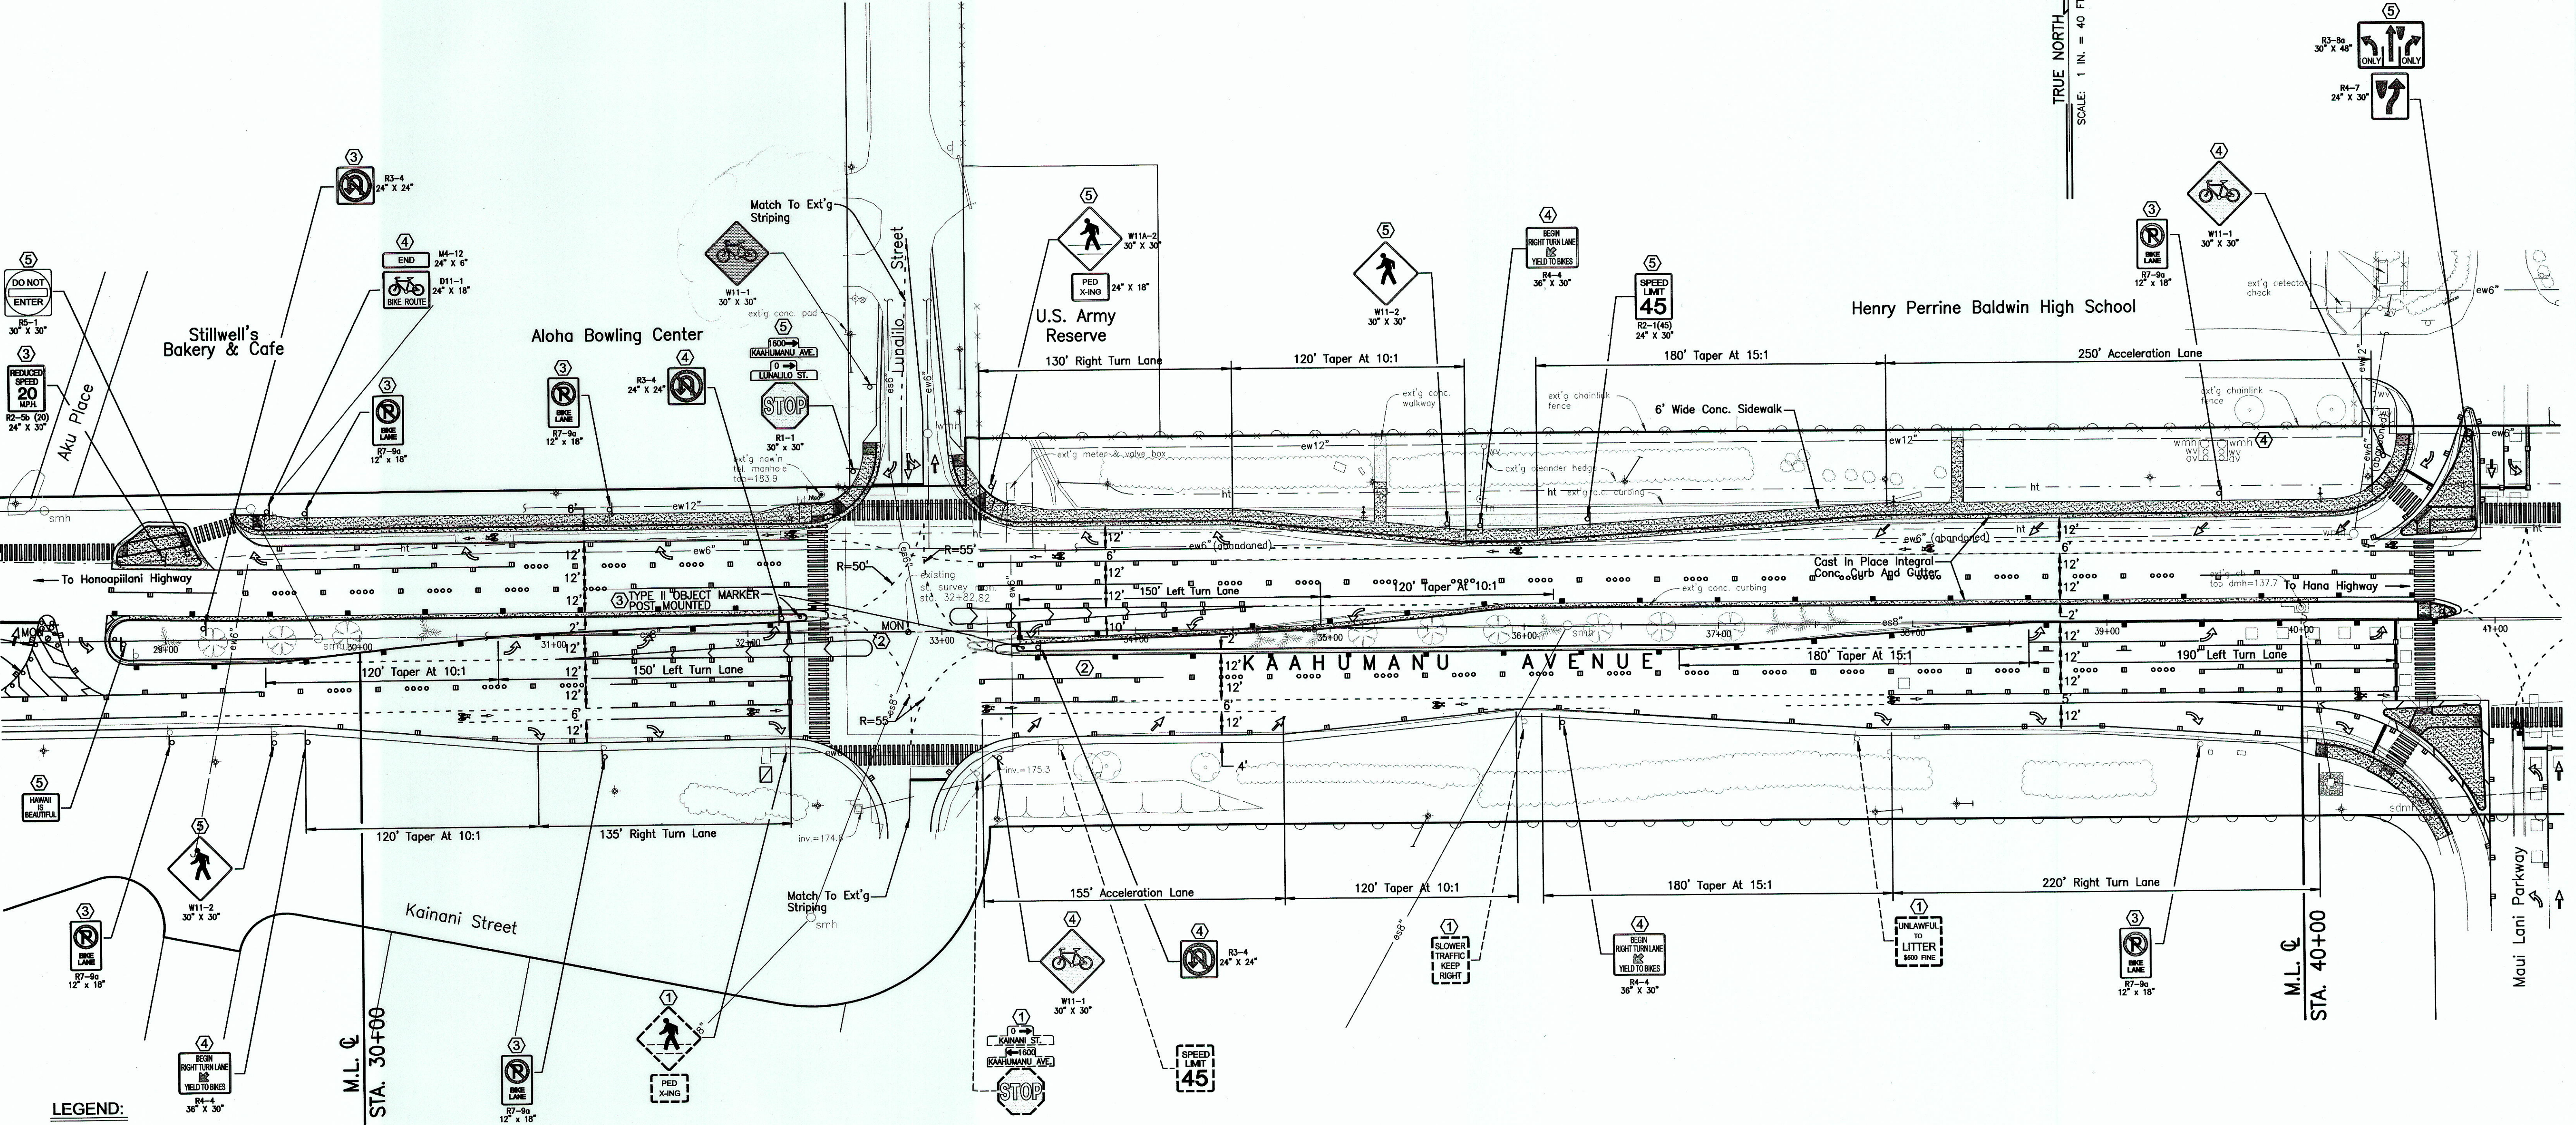

LEGEND:

- 4" DOUBLE SOLID YELLOW STRIPES WITH TYPE "D" RAISED PAVEMENT MARKERS AT 20'-0" O.C. (TAPE, TYPE I OR THERMOPLASTIC EXTRUSION)
- 4 EACH TYPE "A" RAISED PAVEMENT MARKERS TYPE "C" RAISED PAVEMENT MARKERS AT 40'-0" O.C.
- 4" DOUBLE SOLID YELLOW STRIPES WITH TYPE "H" RAISED PAVEMENT MARKERS AT 20'-0" O.C. (TAPE, TYPE II OR THERMOPLASTIC EXTRUSION)
- 8" SOLID WHITE STRIPE W/ TYPE "C" RAISED PAVEMENT MARKERS AT 20'-0" O.C. (TAPE, TYPE I OR THERMOPLASTIC EXTRUSION)
- 4" YELLOW EDGE STRIPE WITH TYPE "H" RAISED PAVEMENT MARKERS AT 40'-0" O.C. (TAPE, TYPE II OR THERMOPLASTIC EXTRUSION)
- CHANNELIZING ISLAND OR DECELERATION LANE GORE (TAPE, TYPE II OR THERMOPLASTIC EXTRUSION)
- 4" OR 8" WHITE EDGE STRIPE W/ TYPE "C" RAISED PAVEMENT MARKERS AT 40'-0" O.C. (TAPE, TYPE II OR THERMOPLASTIC EXTRUSION)
- BIKE LANE MARKING (PAINT)
- 4" WHITE GUIDELINES (TAPE, TYPE III OR THERMOPLASTIC EXTRUSION EXCEPT FOR BUS BAYS) (GUIDE LINES FOR TURNING MOVEMENTS THROUGH INTERSECTIONS SHALL BE YELLOW)
- TRANSVERSE MEDIAN MARKING (TAPE, TYPE II OR THERMOPLASTIC EXTRUSION)
- TRANSVERSE SHOULDER MARKING (TAPE, TYPE II OR THERMOPLASTIC EXTRUSION)
- PAVEMENT ARROW (TAPE, TYPE III OR THERMOPLASTIC EXTRUSION)
- CROSSWALK AND STOP LINE. ALL STOP LINES SHALL BE 10'-0" FROM CROSSWALK UNLESS OTHERWISE NOTED. THE CIRCLED NUMBER INDICATES THE NUMBER OF LANES FOR PAYMENT (TAPE, TYPE III OR THERMOPLASTIC EXTRUSION)

- 1 EXISTING SIGN(S) AND POST(S) TO REMAIN
- 2 REMOVE EXISTING SIGN(S) AND POST(S)
- 3 REMOVE EXISTING AND INSTALL NEW SIGN(S) AND POST(S)
- 4 INSTALL NEW SIGN(S) AND POST(S)
- 5 RELOCATE EXISTING SIGN(S) AND POST(S)
- 6 REMOVE EXT'G. AND INSTALL NEW SIGN(S) ON TRAFFIC SIGNAL POST(S)

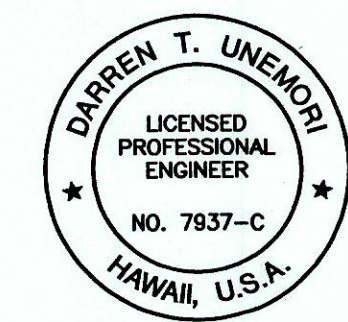

THIS WORK WAS PREPARED BY ME OR UNDER MY SUPERVISION

Signature

STATE OF HAWAII
DEPARTMENT OF TRANSPORTATION
HIGHWAYS DIVISION


ROADWAY STRIPING & SIGNAGE PLAN

MAIN STREET RESURFACING
CENTRAL AVENUE TO KAAHUMANU AVENUE
AND
KAAHUMANU AVENUE RESURFACING
MAIN STREET TO HOBSON AVENUE
Fed. Aid Project No. NH-032-1(8)

SCALE: AS NOTED
SHEET No. 3 OF 13 SHEETS

"AS-BUILT"

FED. ROAD DIST. NO.	STATE	FED. AID PROJ. NO.	FISCAL YEAR	SHEET NO.	TOTAL SHEETS
HAWAII	HAW.	NH-032-1(8)	2000	53	111

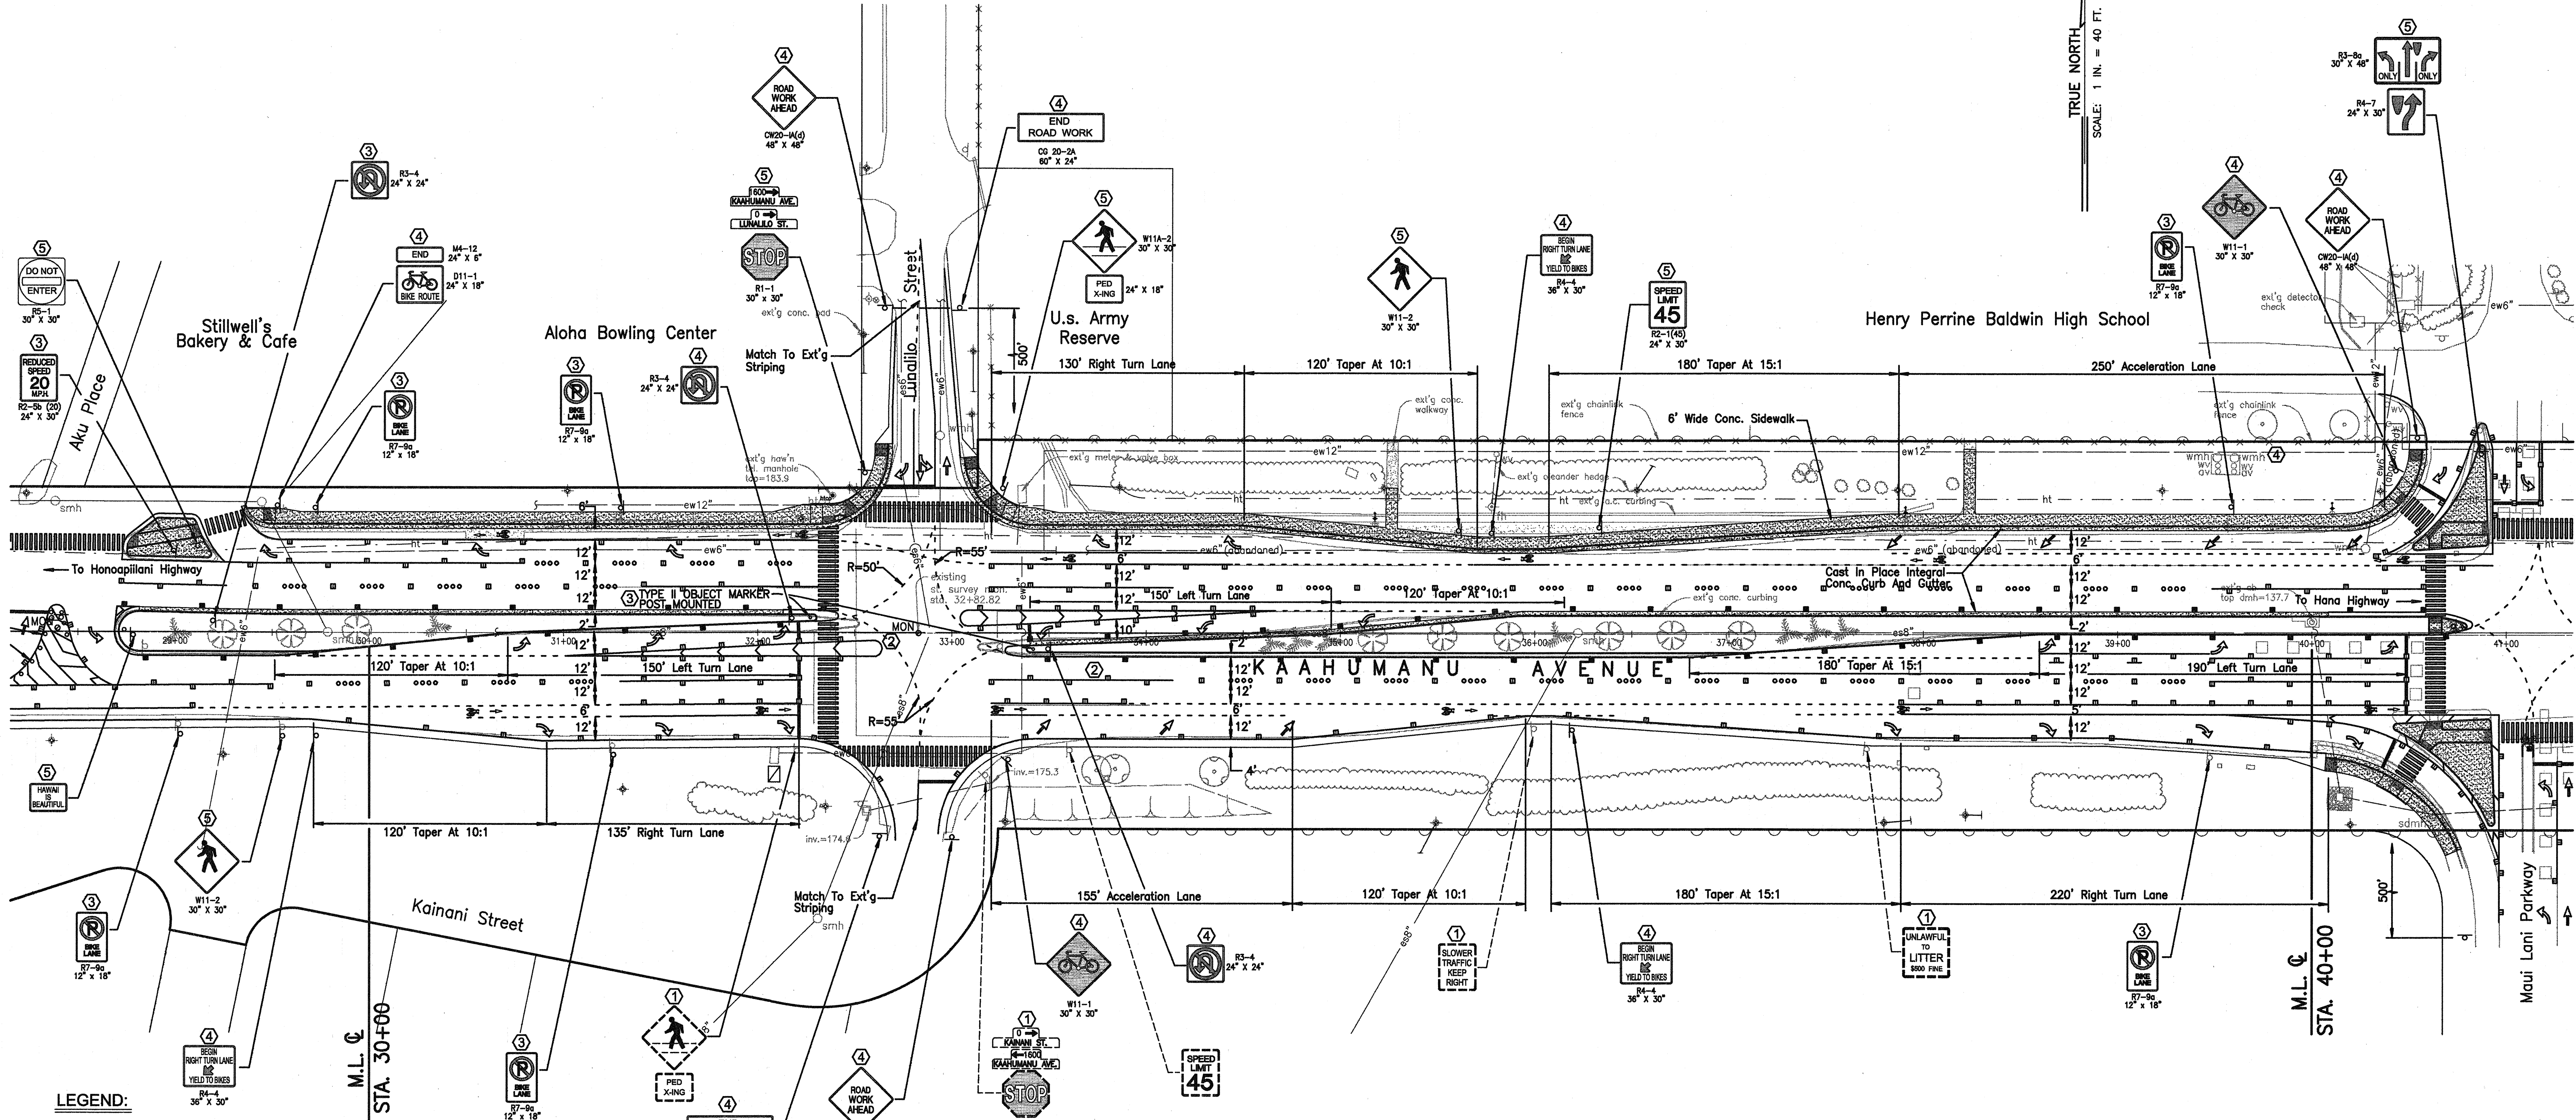


DATE	DATE	DATE	DATE	DATE
DATE	DATE	DATE	DATE	DATE
LEGEND:

- 4" DOUBLE SOLID YELLOW STRIPES WITH TYPE "D" RAISED PAVEMENT MARKERS AT 20'-0" O.C. (TAPE, TYPE I OR THERMOPLASTIC EXTRUSION)
- 4 EACH TYPE "A" RAISED PAVEMENT MARKERS TYPE "C" RAISED PAVEMENT MARKERS AT 40'-0" O.C.
- 4" DOUBLE SOLID YELLOW STRIPES WITH TYPE "H" RAISED PAVEMENT MARKERS AT 20'-0" O.C. (TAPE, TYPE II OR THERMOPLASTIC EXTRUSION)
- 8" SOLID WHITE STRIPE W/ TYPE "C" RAISED PAVEMENT MARKERS AT 20'-0" O.C. (TAPE, TYPE I OR THERMOPLASTIC EXTRUSION)
- 4" YELLOW EDGE STRIPE WITH TYPE "H" RAISED PAVEMENT MARKERS AT 40'-0" O.C. (TAPE, TYPE II OR THERMOPLASTIC EXTRUSION)
- CHANNELIZING ISLAND OR DECELERATION LANE GORE (TAPE, TYPE II OR THERMOPLASTIC EXTRUSION)
- 4" OR 8" WHITE EDGE STRIPE W/ TYPE "C" RAISED PAVEMENT MARKERS AT 40'-0" O.C. (TAPE, TYPE II OR THERMOPLASTIC EXTRUSION)
- BIKE LANE MARKING (PAINT)
- 4" WHITE GUIDELINES (TAPE, TYPE III OR THERMOPLASTIC EXTRUSION EXCEPT FOR BUS BAYS) (GUIDE LINES FOR TURNING MOVEMENTS THROUGH INTERSECTIONS SHALL BE YELLOW)
- TRANSVERSE MEDIAN MARKING (TAPE, TYPE II OR THERMOPLASTIC EXTRUSION)
- TRANSVERSE SHOULDER MARKING (TAPE, TYPE II OR THERMOPLASTIC EXTRUSION)
- PAVEMENT ARROW (TAPE, TYPE III OR THERMOPLASTIC EXTRUSION)
- CROSSWALK AND STOP LINE. ALL STOP LINES SHALL BE 10'-0" FROM CROSSWALK UNLESS OTHERWISE NOTED. THE CIRCLED NUMBER INDICATES THE NUMBER OF LANES FOR PAYMENT (TAPE, TYPE III OR THERMOPLASTIC EXTRUSION)

- 1 EXISTING SIGN(S) AND POST(S) TO REMAIN
- 2 REMOVE EXISTING SIGN(S) AND POST(S)
- 3 REMOVE EXISTING AND INSTALL NEW SIGN(S) AND POST(S)
- 4 INSTALL NEW SIGN(S) AND POST(S)
- 5 RELOCATE EXISTING SIGN(S) AND POST(S)
- 6 REMOVE EXT'G. AND INSTALL NEW SIGN(S) ON TRAFFIC SIGNAL POST(S)

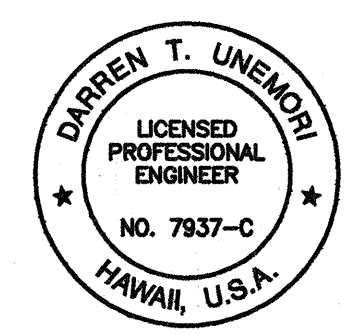

THIS WORK WAS PREPARED BY ME OR UNDER MY SUPERVISION
Signature: [Signature] 4/14/00


STATE OF HAWAII
DEPARTMENT OF TRANSPORTATION
HIGHWAYS DIVISION

ROADWAY STRIPING & SIGNAGE PLAN

MAIN STREET RESURFACING
CENTRAL AVENUE TO KAAHUMANU AVENUE
AND
KAAHUMANU AVENUE RESURFACING
MAIN STREET TO HOBSON AVENUE
Fed. Aid Project No. NH-032-1(8)

SCALE: AS NOTED


FED. ROAD DIST. NO.	STATE	FED. AID PROJ. NO.	FISCAL YEAR	SHEET NO.	TOTAL SHEETS
HAWAII	HAW.	NH-032-1(8)	2000	54R	111

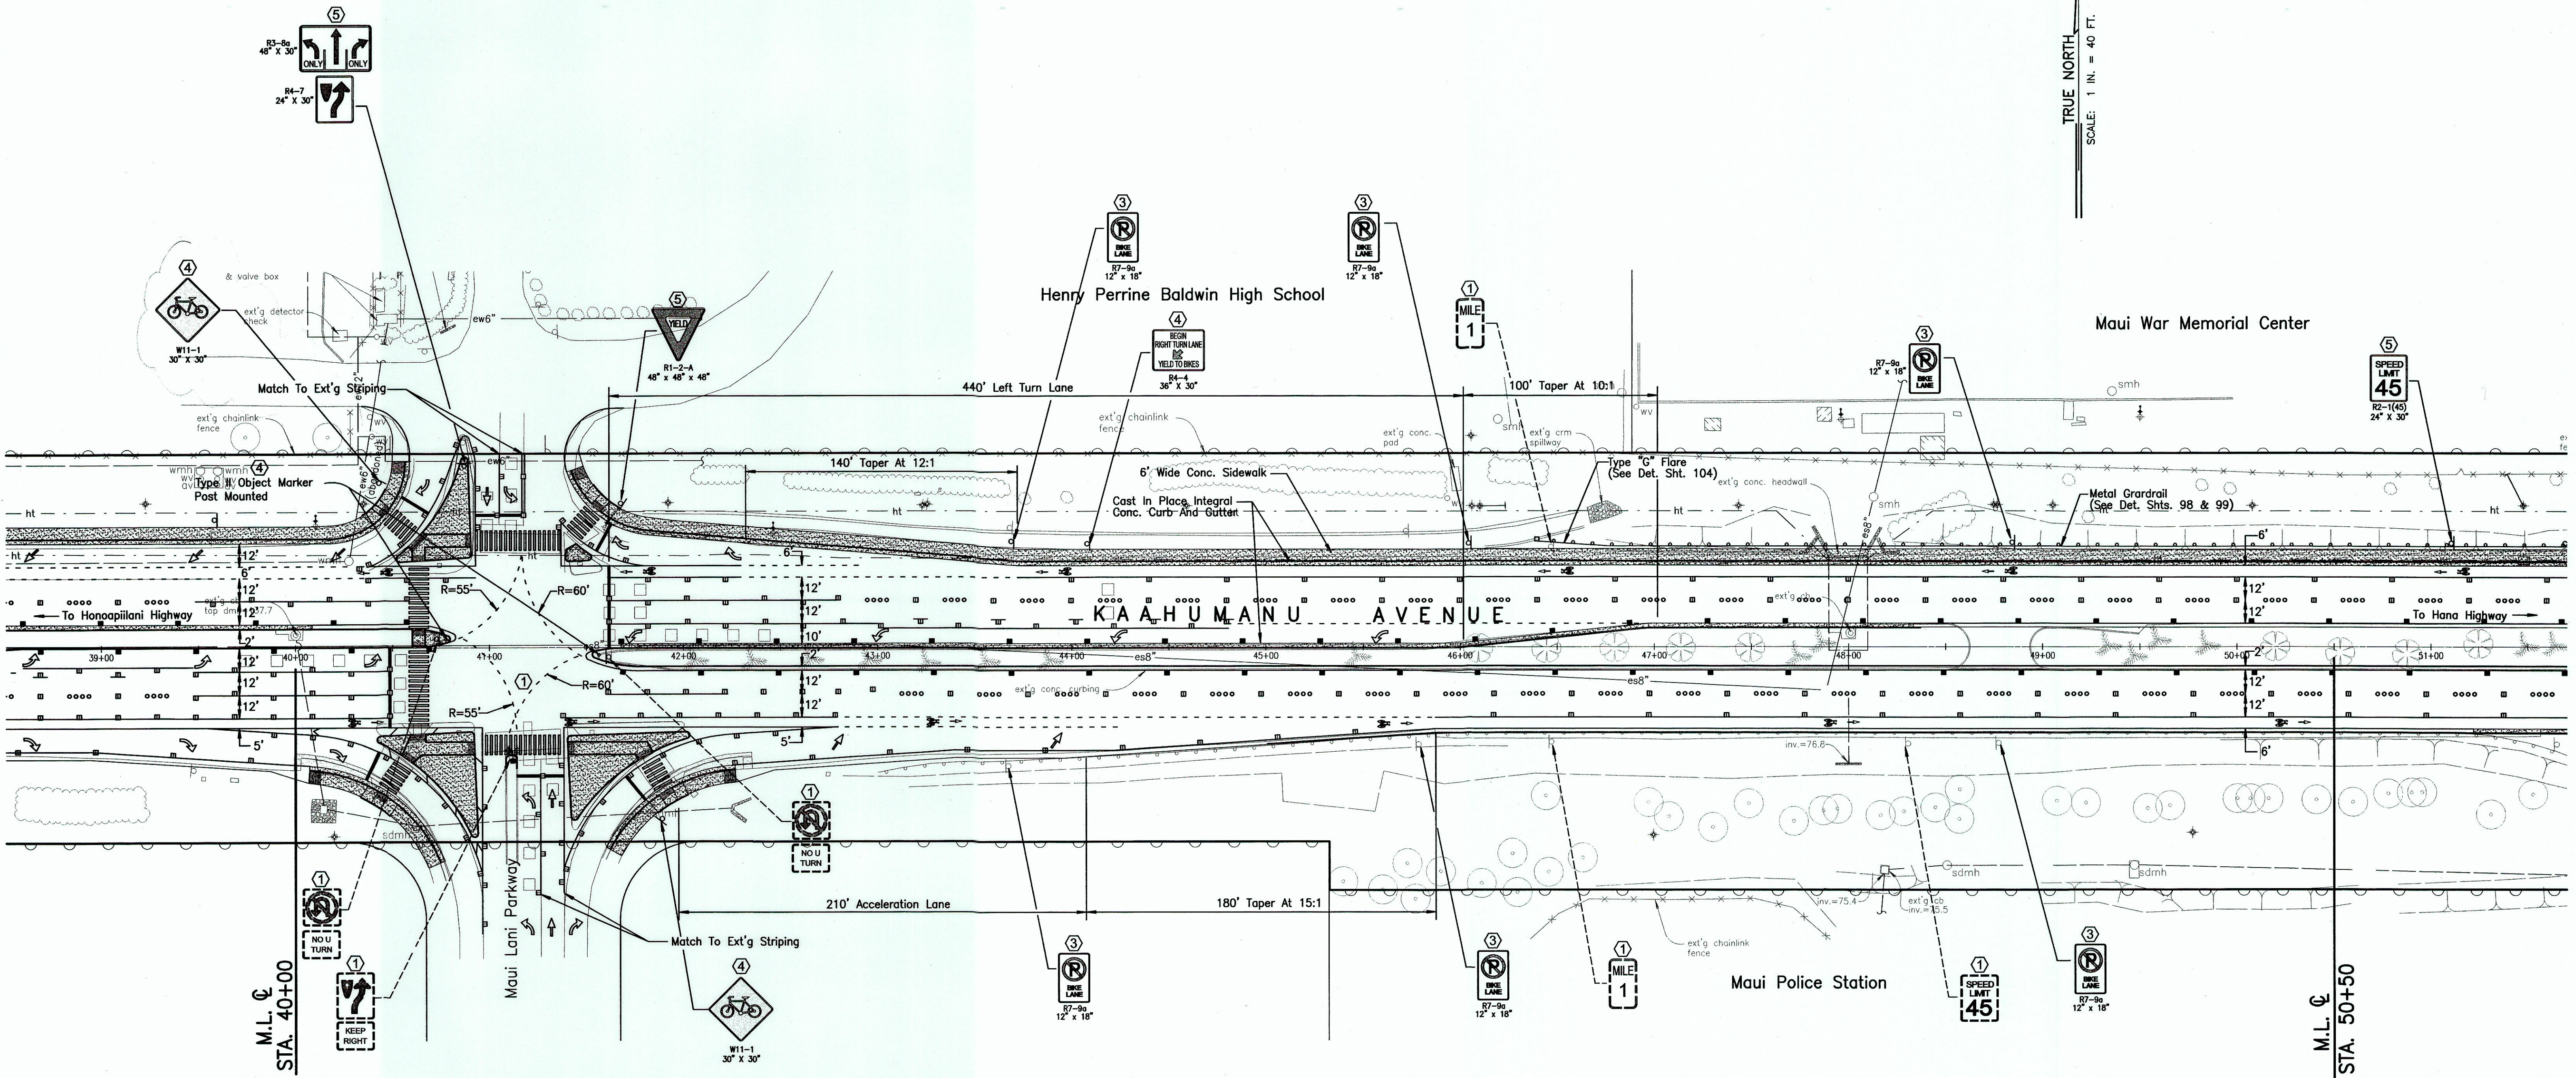

LEGEND:

- 4" DOUBLE SOLID YELLOW STRIPES WITH TYPE "D" RAISED PAVEMENT MARKERS AT 20'-0" O.C. (TAPE, TYPE I OR THERMOPLASTIC EXTRUSION)
- 4 EACH TYPE "A" RAISED PAVEMENT MARKERS TYPE "C" RAISED PAVEMENT MARKERS AT 40'-0" O.C.
- 4" DOUBLE SOLID YELLOW STRIPES WITH TYPE "H" RAISED PAVEMENT MARKERS AT 20'-0" O.C. (TAPE, TYPE II OR THERMOPLASTIC EXTRUSION)
- 8" SOLID WHITE STRIPE W/ TYPE "C" RAISED PAVEMENT MARKERS AT 20'-0" O.C. (TAPE, TYPE I OR THERMOPLASTIC EXTRUSION)
- 4" YELLOW EDGE STRIPE WITH TYPE "H" RAISED PAVEMENT MARKERS AT 40'-0" O.C. (TAPE, TYPE II OR THERMOPLASTIC EXTRUSION)
- CHANNELIZING ISLAND OR DECELERATION LANE GORE (TAPE, TYPE II OR THERMOPLASTIC EXTRUSION)
- 4" OR 8" WHITE EDGE STRIPE W/ TYPE "C" RAISED PAVEMENT MARKERS AT 40'-0" O.C. (TAPE, TYPE II OR THERMOPLASTIC EXTRUSION)
- BIKE LANE MARKING (PAINT)
- 4" WHITE GUIDELINES (TAPE, TYPE III OR THERMOPLASTIC EXTRUSION EXCEPT FOR BUS BAYS) (GUIDE LINES FOR TURNING MOVEMENTS THROUGH INTERSECTIONS SHALL BE YELLOW)
- TRANSVERSE MEDIAN MARKING (TAPE, TYPE II OR THERMOPLASTIC EXTRUSION)
- TRANSVERSE SHOULDER MARKING (TAPE, TYPE II OR THERMOPLASTIC EXTRUSION)
- PAVEMENT ARROW (TAPE, TYPE III OR THERMOPLASTIC EXTRUSION)
- CROSSWALK AND STOP LINE. ALL STOP LINES SHALL BE 10'-0" FROM CROSSWALK UNLESS OTHERWISE NOTED. THE CIRCLED NUMBER INDICATES THE NUMBER OF LANES FOR PAYMENT (TAPE, TYPE III OR THERMOPLASTIC EXTRUSION)

- 1 EXISTING SIGN(S) AND POST(S) TO REMAIN
- 2 REMOVE EXISTING SIGN(S) AND POST(S)
- 3 REMOVE EXISTING AND INSTALL NEW SIGN(S) AND POST(S)
- 4 INSTALL NEW SIGN(S) AND POST(S)
- 5 RELOCATE EXISTING SIGN(S) AND POST(S)
- 6 REMOVE EXT'G. AND INSTALL NEW SIGN(S) ON TRAFFIC SIGNAL POST(S)

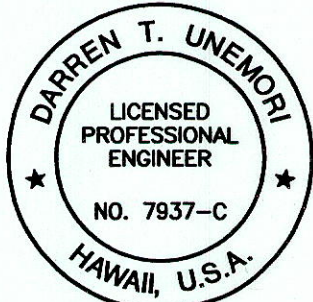

THIS WORK WAS PREPARED BY ME OR UNDER MY SUPERVISION

Signature

STATE OF HAWAII
DEPARTMENT OF TRANSPORTATION
HIGHWAYS DIVISION
ROADWAY STRIPING & SIGNAGE PLAN
MAIN STREET RESURFACING
CENTRAL AVENUE TO KAAHUMANU AVENUE
AND
KAAHUMANU AVENUE RESURFACING
MAIN STREET TO HOBSON AVENUE
Fed. Aid Project No. NH-032-1(8)


SCALE: AS NOTED
SHEET No. 4 OF 13 SHEETS

"AS-BUILT"

54R

DATE	DATE	DATE	DATE	DATE
SURVEY PLOTTED BY	DESIGNED BY	DESIGNED BY	DESIGNED BY	DESIGNED BY
ORIGINAL PLAN	NOTE BOOK	NOTE BOOK	NOTE BOOK	NOTE BOOK
No.	No.	No.	No.	No.

FED. ROAD DIST. NO.	STATE	FED. AID PROJ. NO.	FISCAL YEAR	SHEET NO.	TOTAL SHEETS
HAWAII	HAW.	NH-032-1(8)	2000	54	111

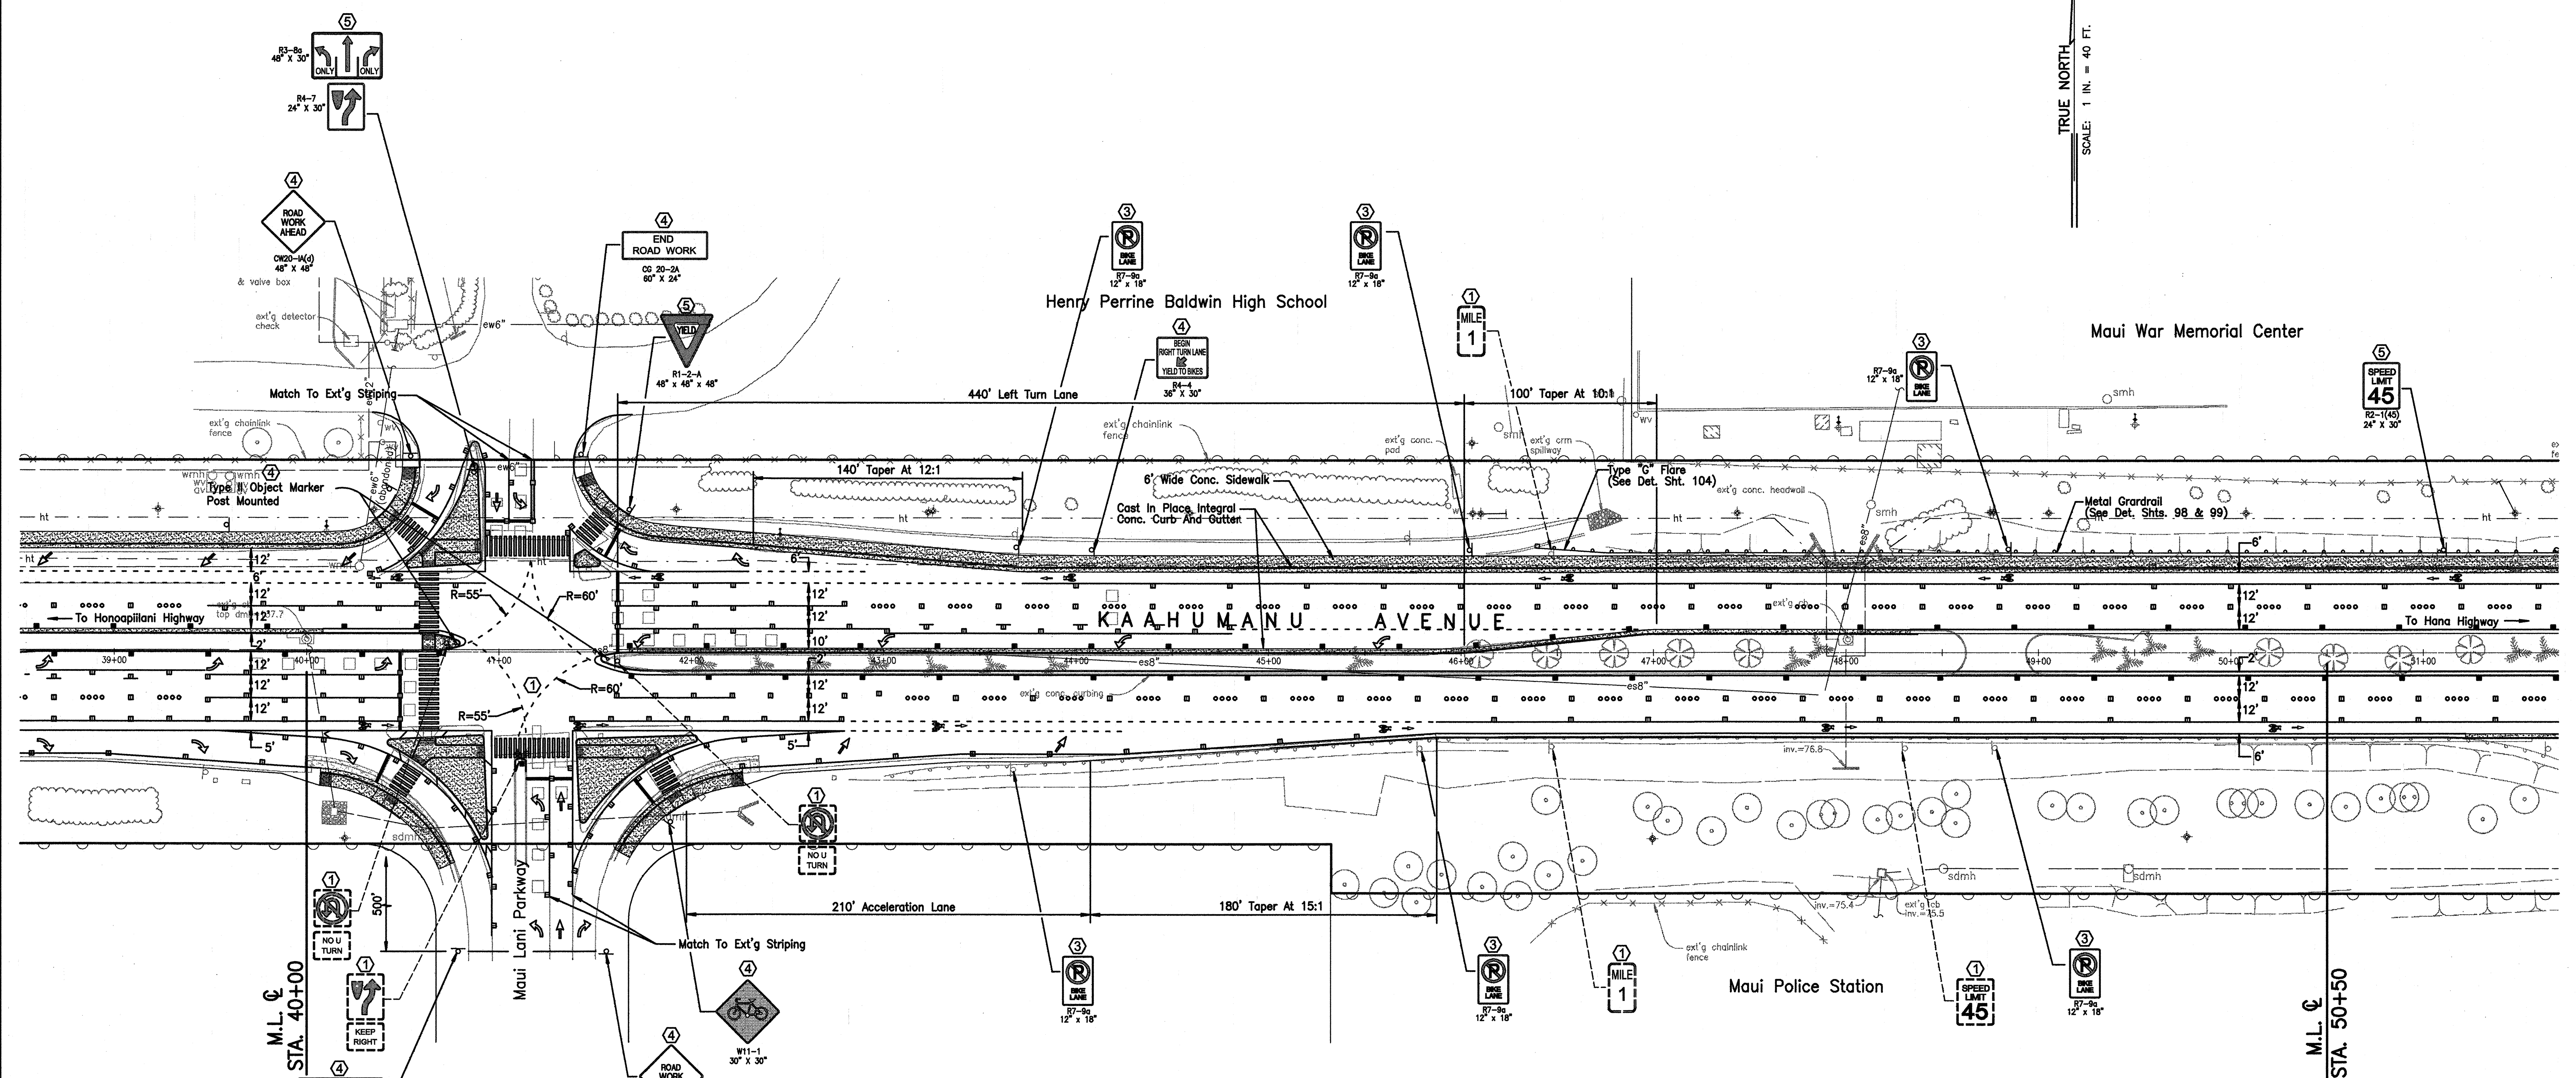

DATE	DATE	DATE	DATE	DATE	DATE
DESIGNED BY	DESIGNED BY	DESIGNED BY	DESIGNED BY	DESIGNED BY	DESIGNED BY
CHECKED BY	CHECKED BY	CHECKED BY	CHECKED BY	CHECKED BY	CHECKED BY
NO.	NO.	NO.	NO.	NO.	NO.

LEGEND:

- 4" DOUBLE SOLID YELLOW STRIPES WITH TYPE "D" RAISED PAVEMENT MARKERS AT 20'-0" O.C. (TAPE, TYPE I OR THERMOPLASTIC EXTRUSION)
- 4 EACH TYPE "A" RAISED PAVEMENT MARKERS TYPE "C" RAISED PAVEMENT MARKERS AT 40'-0" O.C.
- 4" DOUBLE SOLID YELLOW STRIPES WITH TYPE "H" RAISED PAVEMENT MARKERS AT 20'-0" O.C. (TAPE, TYPE II OR THERMOPLASTIC EXTRUSION)
- 8" SOLID WHITE STRIPE W/ TYPE "C" RAISED PAVEMENT MARKERS AT 20'-0" O.C. (TAPE, TYPE I OR THERMOPLASTIC EXTRUSION)
- 4" YELLOW EDGE STRIPE WITH TYPE "H" RAISED PAVEMENT MARKERS AT 40'-0" O.C. (TAPE, TYPE II OR THERMOPLASTIC EXTRUSION)
- CHANNELIZING ISLAND OR DECELERATION LANE GORE (TAPE, TYPE II OR THERMOPLASTIC EXTRUSION)
- 4" OR 8" WHITE EDGE STRIPE W/ TYPE "C" RAISED PAVEMENT MARKERS AT 40'-0" O.C. (TAPE, TYPE II OR THERMOPLASTIC EXTRUSION)
- BIKE LANE MARKING (PAINT)
- 4" WHITE GUIDELINES (TAPE, TYPE III OR THERMOPLASTIC EXTRUSION EXCEPT FOR BUS BAYS) (GUIDE LINES FOR TURNING MOVEMENTS THROUGH INTERSECTIONS SHALL BE YELLOW)
- TRANSVERSE MEDIAN MARKING (TAPE, TYPE II OR THERMOPLASTIC EXTRUSION)
- TRANSVERSE SHOULDER MARKING (TAPE, TYPE II OR THERMOPLASTIC EXTRUSION)
- PAVEMENT ARROW (TAPE, TYPE III OR THERMOPLASTIC EXTRUSION)
- CROSSWALK AND STOP LINE. ALL STOP LINES SHALL BE 10'-0" FROM CROSSWALK UNLESS OTHERWISE NOTED. THE CIRCLED NUMBER INDICATES THE NUMBER OF LANES FOR PAYMENT (TAPE, TYPE III OR THERMOPLASTIC EXTRUSION)

- 1 EXISTING SIGN(S) AND POST(S) TO REMAIN
- 2 REMOVE EXISTING SIGN(S) AND POST(S)
- 3 REMOVE EXISTING AND INSTALL NEW SIGN(S) AND POST(S)
- 4 INSTALL NEW SIGN(S) AND POST(S)
- 5 RELOCATE EXISTING SIGN(S) AND POST(S)
- 6 REMOVE EXT'G. AND INSTALL NEW SIGN(S) ON TRAFFIC SIGNAL POST(S)

DARREN T. UNEMORI
LICENSED PROFESSIONAL ENGINEER
NO. 7937-C
HAWAII, U.S.A.

THIS WORK WAS PREPARED BY ME
OR UNDER MY SUPERVISION

Signature

STATE OF HAWAII
DEPARTMENT OF TRANSPORTATION
HIGHWAYS DIVISION

ROADWAY STRIPING & SIGNAGE PLAN


MAIN STREET RESURFACING
CENTRAL AVENUE TO KAAHUMANU AVENUE
AND
KAAHUMANU AVENUE RESURFACING
MAIN STREET TO HOBSON AVENUE
Fed. Aid Project No. NH-032-1(8)

SCALE: AS NOTED

SHEET No. 4 OF 13 SHEETS

FED. ROAD DIST. NO.	STATE	FED. AID PROJ. NO.	FISCAL YEAR	SHEET NO.	TOTAL SHEETS
HAWAII	HAW.	NH-032-1(8)	2000	55R	111


TRUE NORTH
SCALE: 1 IN. = 40 FT.

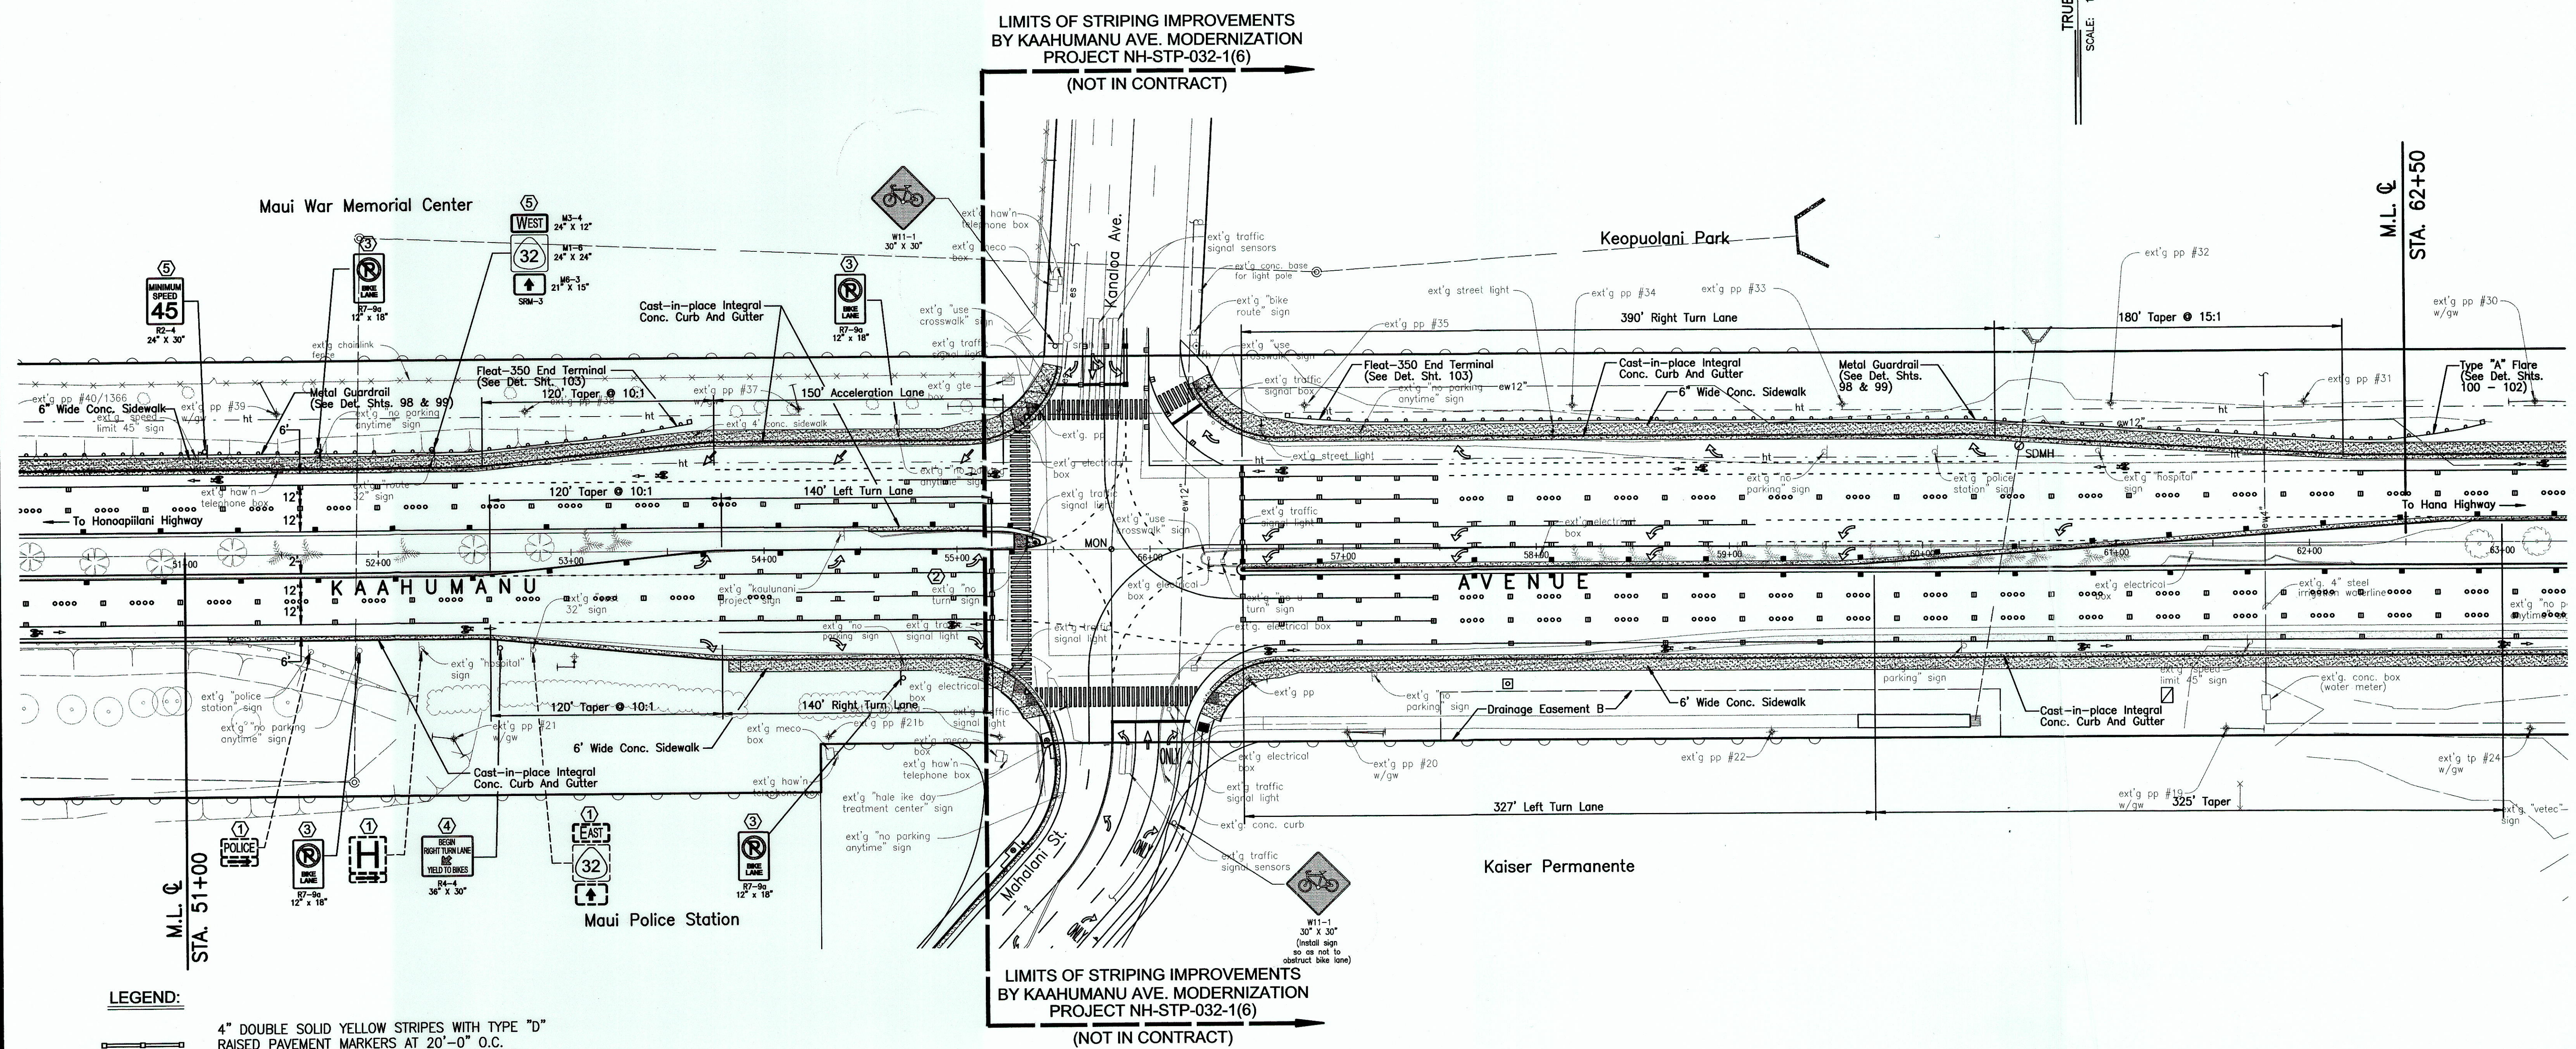

SURVEY PLOTTED BY	DATE
DRAWN BY	DATE
TRACED BY	DATE
CHECKED BY	DATE
NOTED BY	DATE
DATE	

LEGEND:

- 4" DOUBLE SOLID YELLOW STRIPES WITH TYPE "D" RAISED PAVEMENT MARKERS AT 20'-0" O.C. (TAPE, TYPE I OR THERMOPLASTIC EXTRUSION)
- 4 EACH TYPE "A" RAISED PAVEMENT MARKERS TYPE "C" RAISED PAVEMENT MARKERS AT 40'-0" O.C.
- 4" DOUBLE SOLID YELLOW STRIPES WITH TYPE "H" RAISED PAVEMENT MARKERS AT 20'-0" O.C. (TAPE, TYPE II OR THERMOPLASTIC EXTRUSION)
- 8" SOLID WHITE STRIPE W/ TYPE "C" RAISED PAVEMENT MARKERS AT 20'-0" O.C. (TAPE, TYPE I OR THERMOPLASTIC EXTRUSION)
- 4" YELLOW EDGE STRIPE WITH TYPE "H" RAISED PAVEMENT MARKERS AT 40'-0" O.C. (TAPE, TYPE II OR THERMOPLASTIC EXTRUSION)
- CHANNELIZING ISLAND OR DECELERATION LANE GORE (TAPE, TYPE II OR THERMOPLASTIC EXTRUSION)
- 4" OR 8" WHITE EDGE STRIPE W/ TYPE "C" RAISED PAVEMENT MARKERS AT 40'-0" O.C. (TAPE, TYPE II OR THERMOPLASTIC EXTRUSION)
- BIKE LANE MARKING (PAINT)
- 4" WHITE GUIDELINES (TAPE, TYPE III OR THERMOPLASTIC EXTRUSION EXCEPT FOR BUS BAYS) (GUIDE LINES FOR TURNING MOVEMENTS THROUGH INTERSECTIONS SHALL BE YELLOW)
- TRANSVERSE MEDIAN MARKING (TAPE, TYPE II OR THERMOPLASTIC EXTRUSION)
- TRANSVERSE SHOULDER MARKING (TAPE, TYPE II OR THERMOPLASTIC EXTRUSION)
- PAVEMENT ARROW (TAPE, TYPE III OR THERMOPLASTIC EXTRUSION)
- CROSSWALK AND STOP LINE. ALL STOP LINES SHALL BE 10'-0" FROM CROSSWALK UNLESS OTHERWISE NOTED. THE CIRCLED NUMBER INDICATES THE NUMBER OF LANES FOR PAYMENT (TAPE, TYPE III OR THERMOPLASTIC EXTRUSION)
- EXISTING SIGN(S) AND POST(S) TO REMAIN
- REMOVE EXISTING SIGN(S) AND POST(S)
- REMOVE EXISTING AND INSTALL NEW SIGN(S) AND POST(S)
- INSTALL NEW SIGN(S) AND POST(S)
- RELOCATE EXISTING SIGN(S) AND POST(S)
- REMOVE EXT'G. AND INSTALL NEW SIGN(S) ON TRAFFIC SIGNAL POST(S)

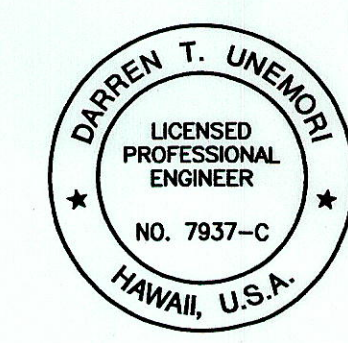

THIS WORK WAS PREPARED BY ME OR UNDER MY SUPERVISION
Signature

STATE OF HAWAII
DEPARTMENT OF TRANSPORTATION
HIGHWAYS DIVISION

ROADWAY STRIPING & SIGNAGE PLAN

MAIN STREET RESURFACING
CENTRAL AVENUE TO KAAHUMANU AVENUE
AND
KAAHUMANU AVENUE RESURFACING
MAIN STREET TO HOBSON AVENUE
Fed. Aid Project No. NH-032-1(8)


SCALE: AS NOTED

SHEET No. 5 OF 13 SHEETS

"AS-BUILT"

FED. ROAD DIST. NO.	STATE	FED. AID PROJ. NO.	FISCAL YEAR	SHEET NO.	TOTAL SHEETS
HAWAII	HAW.	NH-032-1(8)	2000	55	111

TRUE NORTH
SCALE: 1 IN. = 40 FT.

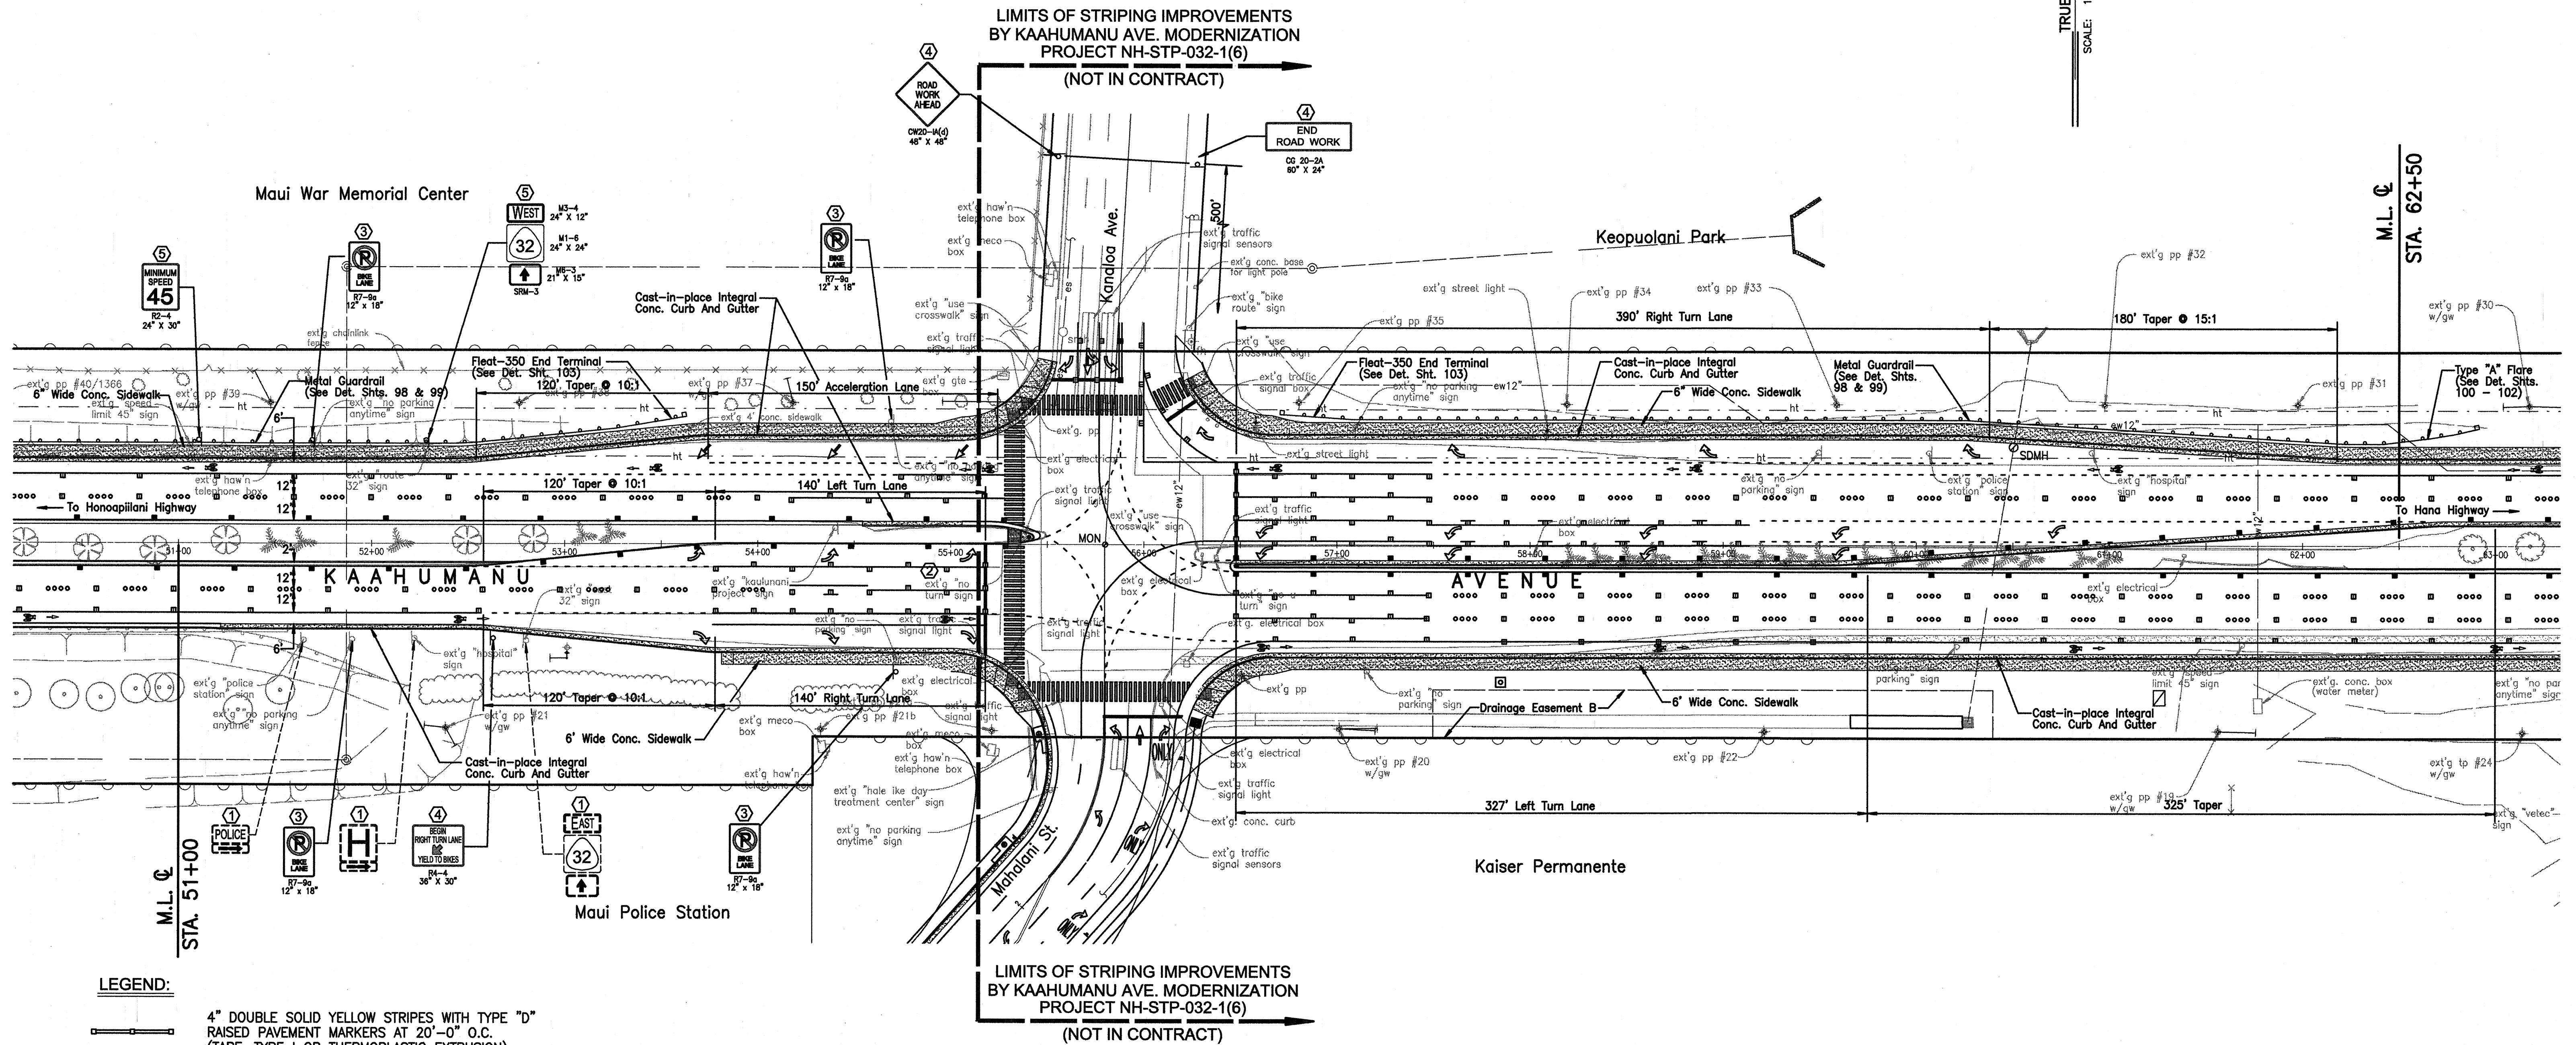


LEGEND:

- 4" DOUBLE SOLID YELLOW STRIPES WITH TYPE "D" RAISED PAVEMENT MARKERS AT 20'-0" O.C. (TAPE, TYPE I OR THERMOPLASTIC EXTRUSION)
- 4 EACH TYPE "A" RAISED PAVEMENT MARKERS TYPE "C" RAISED PAVEMENT MARKERS AT 40'-0" O.C.
- 4" DOUBLE SOLID YELLOW STRIPES WITH TYPE "H" RAISED PAVEMENT MARKERS AT 20'-0" O.C. (TAPE, TYPE II OR THERMOPLASTIC EXTRUSION)
- 8" SOLID WHITE STRIPE W/ TYPE "C" RAISED PAVEMENT MARKERS AT 20'-0" O.C. (TAPE, TYPE I OR THERMOPLASTIC EXTRUSION)
- 4" YELLOW EDGE STRIPE WITH TYPE "H" RAISED PAVEMENT MARKERS AT 40'-0" O.C. (TAPE, TYPE II OR THERMOPLASTIC EXTRUSION)
- CHANNELIZING ISLAND OR DECELERATION LANE GORE (TAPE, TYPE II OR THERMOPLASTIC EXTRUSION)
- 4" OR 8" WHITE EDGE STRIPE W/ TYPE "C" RAISED PAVEMENT MARKERS AT 40'-0" O.C. (TAPE, TYPE II OR THERMOPLASTIC EXTRUSION)

- BIKE LANE MARKING (PAINT)
- 4" WHITE GUIDELINES (TAPE, TYPE III OR THERMOPLASTIC EXTRUSION EXCEPT FOR BUS BAYS) (GUIDE LINES FOR TURNING MOVEMENTS THROUGH INTERSECTIONS SHALL BE YELLOW)
- TRANSVERSE MEDIAN MARKING (TAPE, TYPE II OR THERMOPLASTIC EXTRUSION)
- TRANSVERSE SHOULDER MARKING (TAPE, TYPE II OR THERMOPLASTIC EXTRUSION)
- PAVEMENT ARROW (TAPE, TYPE III OR THERMOPLASTIC EXTRUSION)
- CROSSWALK AND STOP LINE. ALL STOP LINES SHALL BE 10'-0" FROM CROSSWALK UNLESS OTHERWISE NOTED. THE CIRCLED NUMBER INDICATES THE NUMBER OF LANES FOR PAYMENT (TAPE, TYPE III OR THERMOPLASTIC EXTRUSION)

- 1 EXISTING SIGN(S) AND POST(S) TO REMAIN
- 2 REMOVE EXISTING SIGN(S) AND POST(S)
- 3 REMOVE EXISTING AND INSTALL NEW SIGN(S) AND POST(S)
- 4 INSTALL NEW SIGN(S) AND POST(S)
- 5 RELOCATE EXISTING SIGN(S) AND POST(S)
- 6 REMOVE EXT'G. AND INSTALL NEW SIGN(S) ON TRAFFIC SIGNAL POST(S)

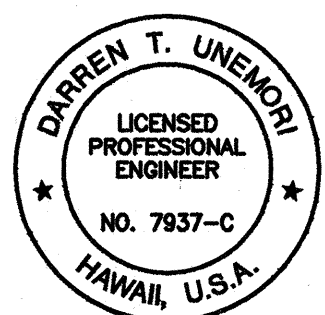


THIS WORK WAS PREPARED BY ME OR UNDER MY SUPERVISION
Signature

STATE OF HAWAII
DEPARTMENT OF TRANSPORTATION
HIGHWAYS DIVISION
ROADWAY STRIPING & SIGNAGE PLAN
MAIN STREET RESURFACING
CENTRAL AVENUE TO KAAHALAMANU AVENUE
AND
KAAHALAMANU AVENUE RESURFACING
MAIN STREET TO HOBSON AVENUE
Fed. Aid Project No. NH-032-1(8)
SCALE: AS NOTED
SHEET No. 5 OF 13 SHEETS

DATE	DATE	DATE	DATE	DATE	DATE
DESIGNED BY	DESIGNED BY	DESIGNED BY	DESIGNED BY	DESIGNED BY	DESIGNED BY
CHECKED BY	CHECKED BY	CHECKED BY	CHECKED BY	CHECKED BY	CHECKED BY
ORIGINAL PLAN	NOTE BOOK	NO.			

88601/28049/comp/eng/cv-std-000

FED. ROAD DIST. NO.	STATE	FED. AID PROJ. NO.	FISCAL YEAR	SHEET NO.	TOTAL SHEETS
HAWAII	HAW.	NH-032-1(8)	2000	56	111

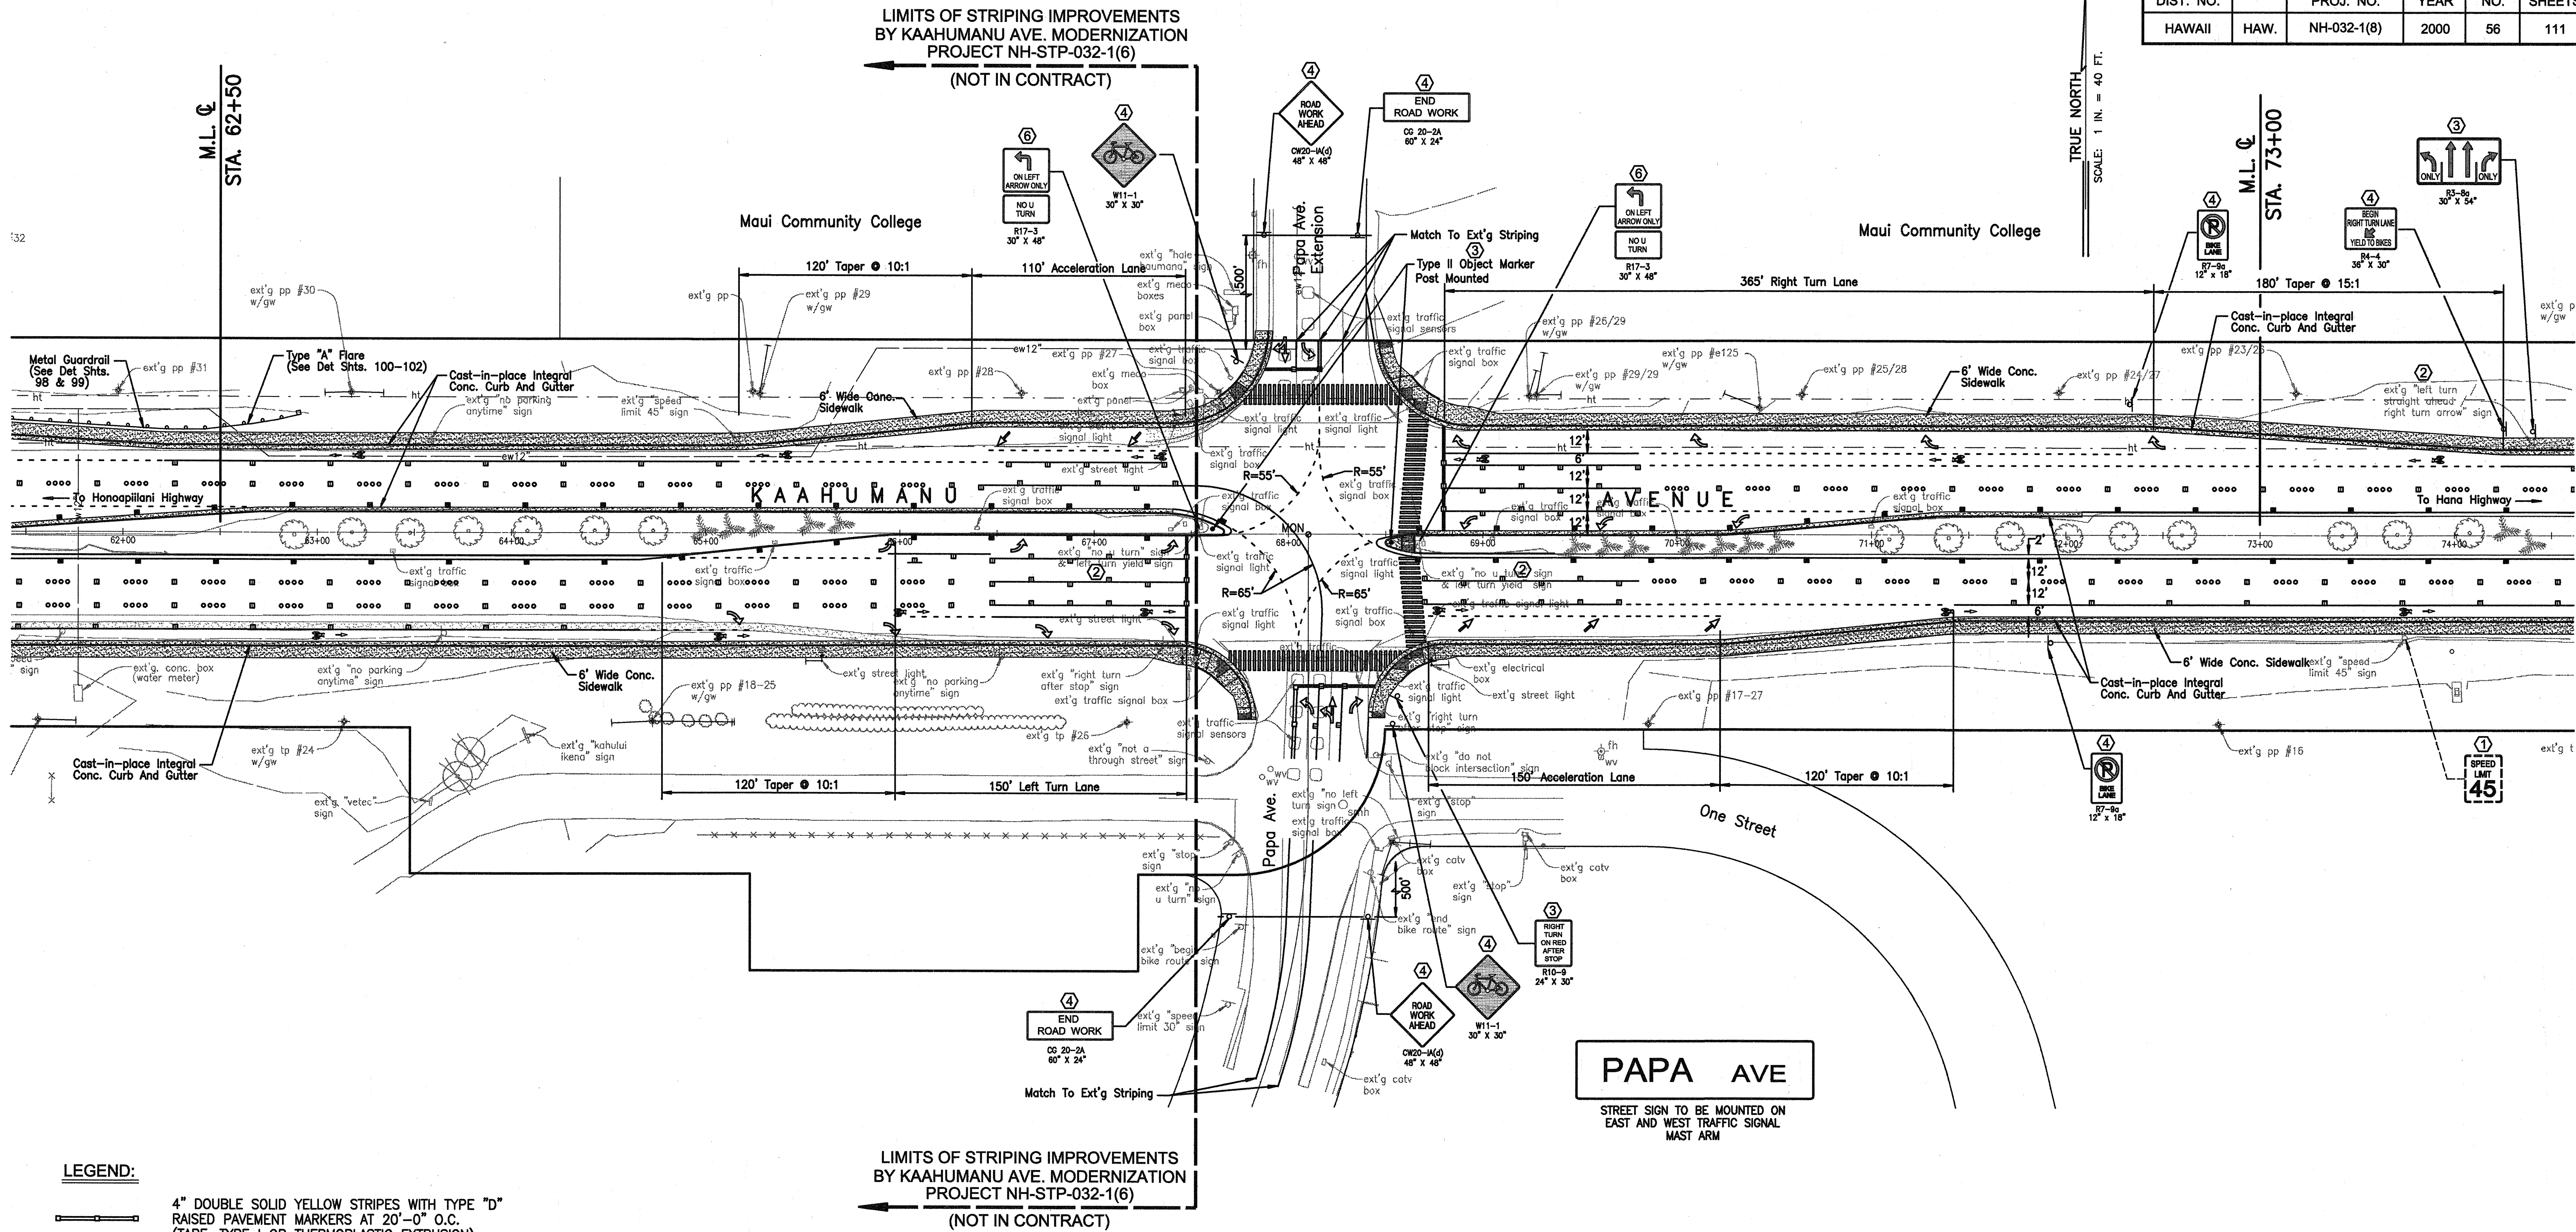


LEGEND:

- 4" DOUBLE SOLID YELLOW STRIPES WITH TYPE "D" RAISED PAVEMENT MARKERS AT 20'-0" O.C. (TAPE, TYPE I OR THERMOPLASTIC EXTRUSION)
- 4 EACH TYPE "A" RAISED PAVEMENT MARKERS TYPE "C" RAISED PAVEMENT MARKERS AT 40'-0" O.C.
- 4" DOUBLE SOLID YELLOW STRIPES WITH TYPE "H" RAISED PAVEMENT MARKERS AT 20'-0" O.C. (TAPE, TYPE II OR THERMOPLASTIC EXTRUSION)
- 8" SOLID WHITE STRIPE W/ TYPE "C" RAISED PAVEMENT MARKERS AT 20'-0" O.C. (TAPE, TYPE I OR THERMOPLASTIC EXTRUSION)
- 4" YELLOW EDGE STRIPE WITH TYPE "H" RAISED PAVEMENT MARKERS AT 40'-0" O.C. (TAPE, TYPE II OR THERMOPLASTIC EXTRUSION)
- CHANNELIZING ISLAND OR DECELERATION LANE GORE (TAPE, TYPE II OR THERMOPLASTIC EXTRUSION)
- 4" OR 8" WHITE EDGE STRIPE W/ TYPE "C" RAISED PAVEMENT MARKERS AT 40'-0" O.C. (TAPE, TYPE II OR THERMOPLASTIC EXTRUSION)

- BIKE LANE MARKING (PAINT)
- 4" WHITE GUIDELINES (TAPE, TYPE III OR THERMOPLASTIC EXTRUSION EXCEPT FOR BUS BAYS) (GUIDE LINES FOR TURNING MOVEMENTS THROUGH INTERSECTIONS SHALL BE YELLOW)
- TRANSVERSE MEDIAN MARKING (TAPE, TYPE II OR THERMOPLASTIC EXTRUSION)
- TRANSVERSE SHOULDER MARKING (TAPE, TYPE II OR THERMOPLASTIC EXTRUSION)
- PAVEMENT ARROW (TAPE, TYPE III OR THERMOPLASTIC EXTRUSION)
- CROSSWALK AND STOP LINE. ALL STOP LINES SHALL BE 10'-0" FROM CROSSWALK UNLESS OTHERWISE NOTED. THE CIRCLED NUMBER INDICATES THE NUMBER OF LANES FOR PAYMENT (TAPE, TYPE III OR THERMOPLASTIC EXTRUSION)

- EXISTING SIGN(S) AND POST(S) TO REMAIN
- REMOVE EXISTING SIGN(S) AND POST(S)
- REMOVE EXISTING AND INSTALL NEW SIGN(S) AND POST(S)
- INSTALL NEW SIGN(S) AND POST(S)
- RELOCATE EXISTING SIGN(S) AND POST(S)
- REMOVE EXT'G. AND INSTALL NEW SIGN(S) ON TRAFFIC SIGNAL POST(S)

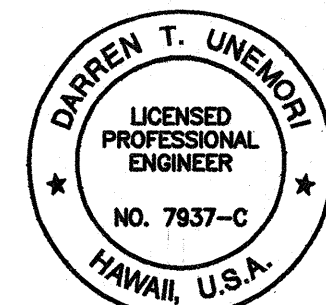


THIS WORK WAS PREPARED BY ME OR UNDER MY SUPERVISION
Signature

STATE OF HAWAII
DEPARTMENT OF TRANSPORTATION
HIGHWAYS DIVISION
ROADWAY STRIPING & SIGNAGE PLAN
MAIN STREET RESURFACING
CENTRAL AVENUE TO KAAHUMANU AVENUE
AND
KAAHUMANU AVENUE RESURFACING
MAIN STREET TO HOBSON AVENUE
Fed. Aid Project No. NH-032-1(8)

SCALE: AS NOTED
SHEET No. 6 OF 13 SHEETS

FED. ROAD DIST. NO.	STATE	FED. AID PROJ. NO.	FISCAL YEAR	SHEET NO.	TOTAL SHEETS
HAWAII	HAW.	NH-032-1(8)	2000	57	111

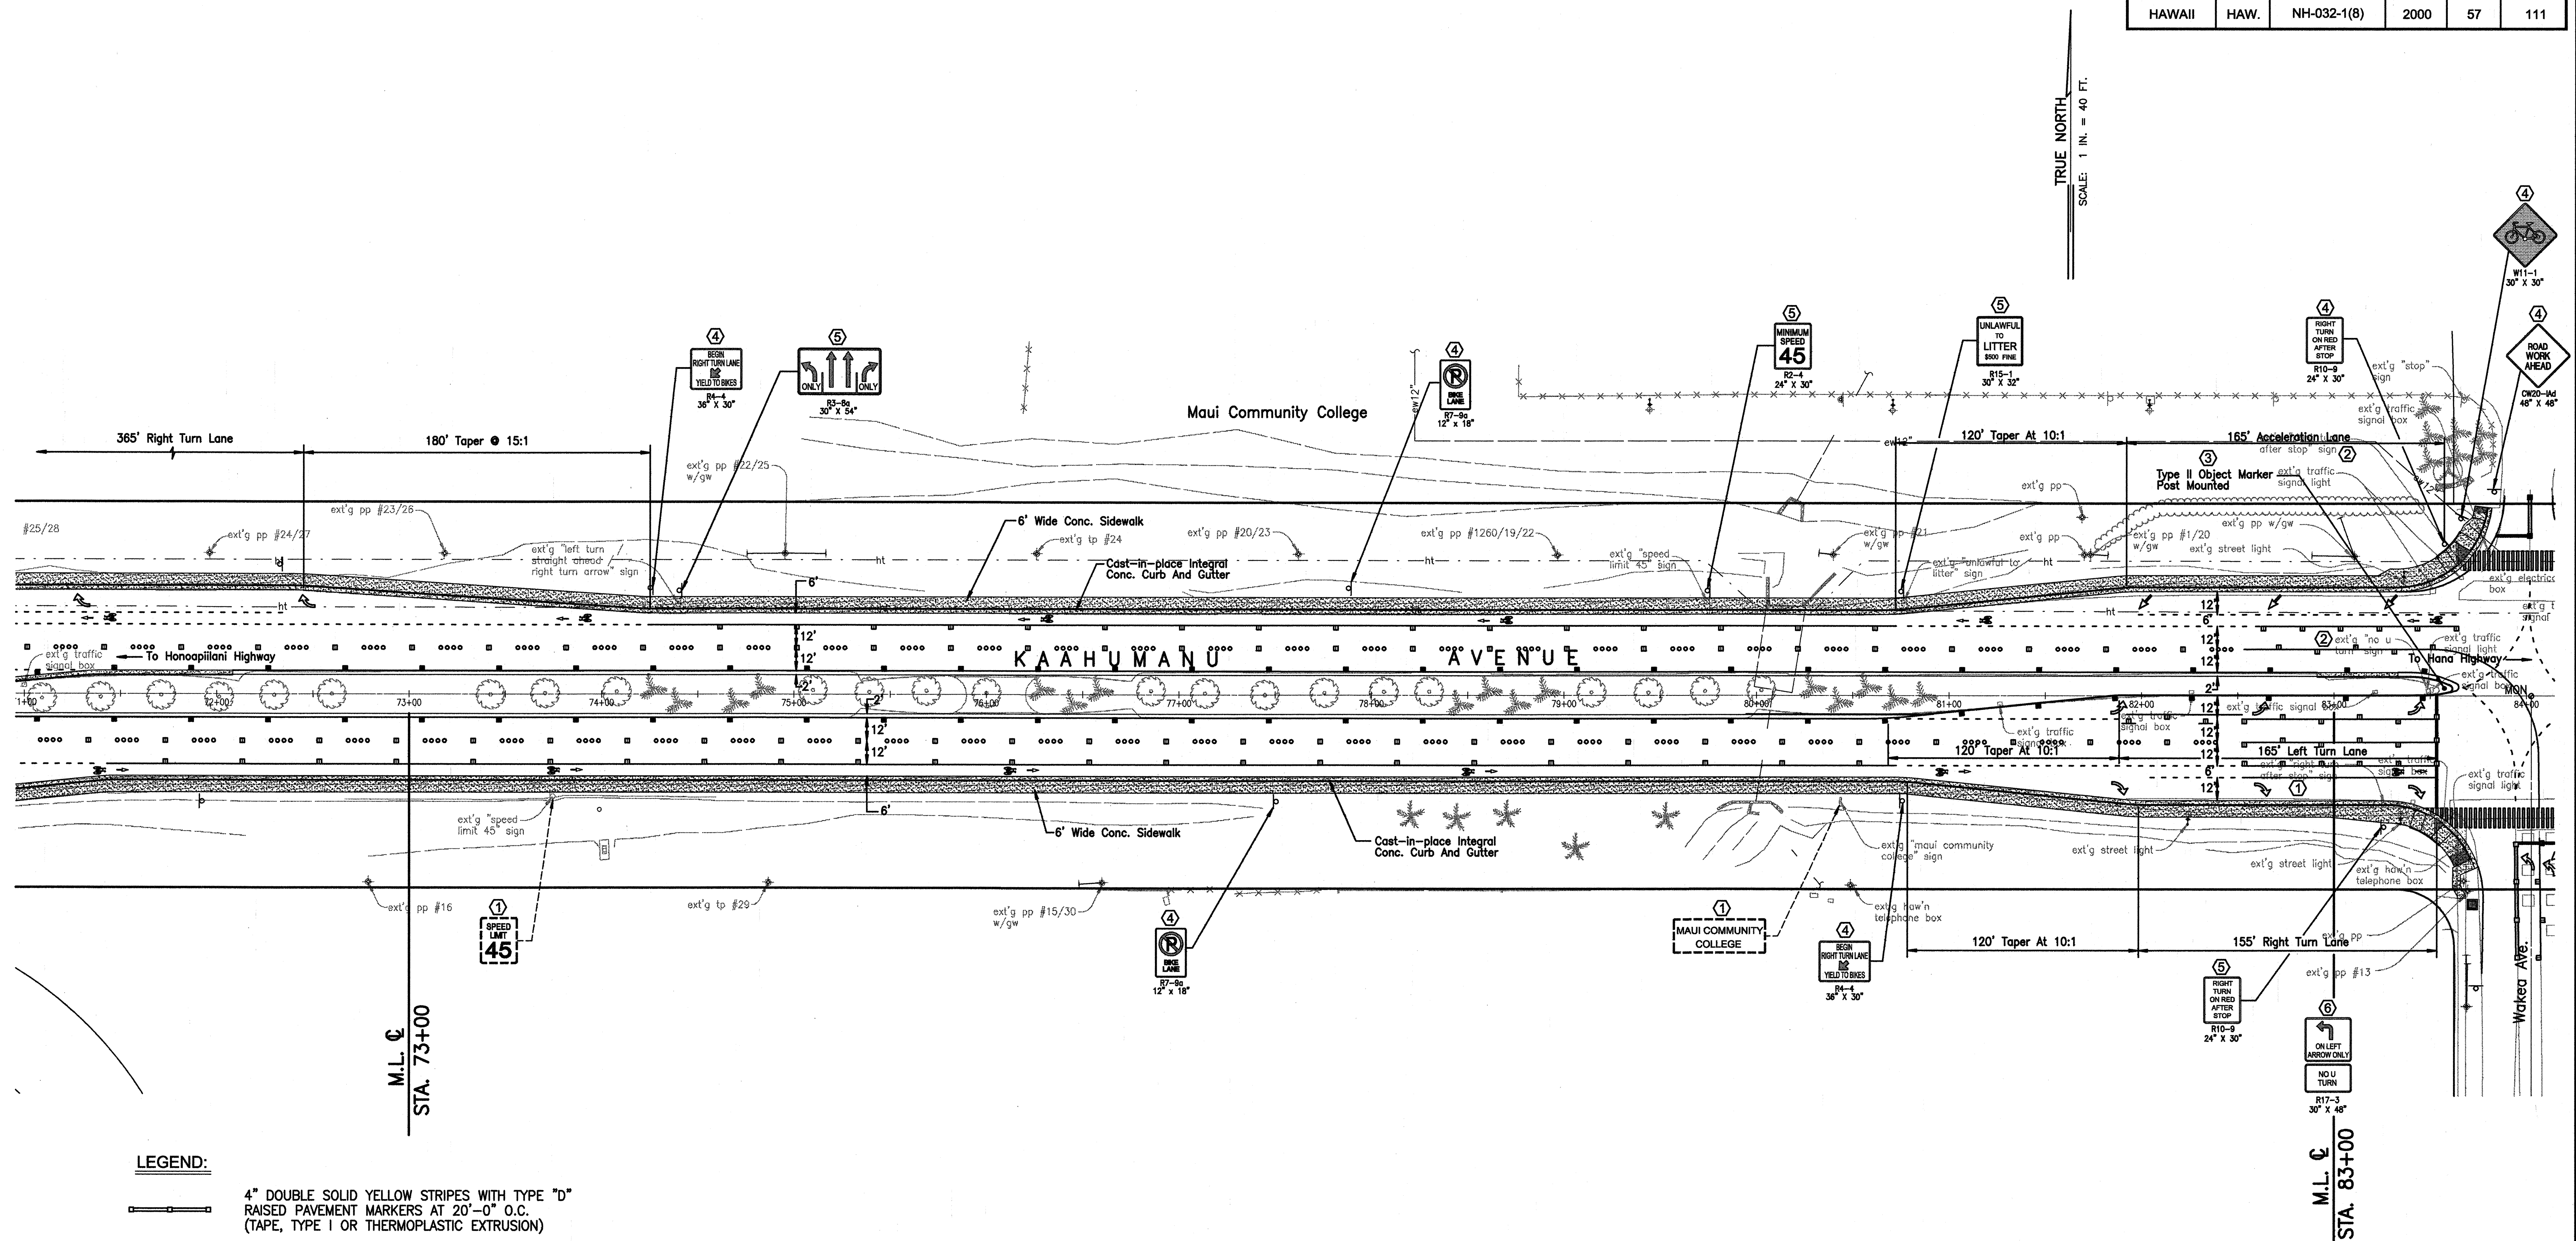


- LEGEND:**

- 4" DOUBLE SOLID YELLOW STRIPES WITH TYPE "D" RAISED PAVEMENT MARKERS AT 20'-0" O.C. (TAPE, TYPE I OR THERMOPLASTIC EXTRUSION)
- ○ ■
- 4 EACH TYPE "A" RAISED PAVEMENT MARKERS TYPE "C" RAISED PAVEMENT MARKERS AT 40'-0" O.C.
- ○ ○ ○ ■
- 4" DOUBLE SOLID YELLOW STRIPES WITH TYPE "H" RAISED PAVEMENT MARKERS AT 20'-0" O.C. (TAPE, TYPE II OR THERMOPLASTIC EXTRUSION)
- ■ ■ ■ ■
- 8" SOLID WHITE STRIPE W/ TYPE "C" RAISED PAVEMENT MARKERS AT 20'-0" O.C. (TAPE, TYPE I OR THERMOPLASTIC EXTRUSION)
- ■ ■ ■ ■
- 4" YELLOW EDGE STRIPE WITH TYPE "H" RAISED PAVEMENT MARKERS AT 40'-0" O.C. (TAPE, TYPE II OR THERMOPLASTIC EXTRUSION)
- ■ ■ ■ ■
- CHANNELIZING ISLAND OR DECELERATION LANE GORE (TAPE, TYPE II OR THERMOPLASTIC EXTRUSION)
- ■ ■ ■ ■
- 4" OR 8" WHITE EDGE STRIPE W/ TYPE "C" RAISED PAVEMENT MARKERS AT 40'-0" O.C. (TAPE, TYPE II OR THERMOPLASTIC EXTRUSION)
- ■ ■ ■ ■

- | | |
|--|---|
|  | BIKE LANE MARKING (PAINT) |
|  | 4" WHITE GUIDELINES (TAPE, TYPE III OR THERMOPLASTIC EXTRUSION EXCEPT FOR BUS BAYS) (GUIDE LINES FOR TURNING MOVEMENTS THROUGH INTERSECTIONS SHALL BE YELLOW) |
|  | TRANSVERSE MEDIAN MARKING (TAPE, TYPE II OR THERMOPLASTIC EXTRUSION) |
|  | TRANSVERSE SHOULDER MARKING (TAPE, TYPE II OR THERMOPLASTIC EXTRUSION) |
|  | PAVEMENT ARROW (TAPE, TYPE III OR THERMOPLASTIC EXTRUSION) |
| ②
 | CROSSWALK AND STOP LINE. ALL STOP LINES SHALL BE 10'-0" FROM CROSSWALK UNLESS OTHERWISE NOTED. THE CIRCLED NUMBER INDICATES THE NUMBER OF LANES FOR PAYMENT (TAPE, TYPE III OR THERMOPLASTIC EXTRUSION) |

1. EXISTING SIGN(S) AND POST(S) TO REMAIN
2. REMOVE EXISTING SIGN(S) AND POST(S)
3. REMOVE EXISTING AND INSTALL NEW SIGN(S) AND POST(S)
4. INSTALL NEW SIGN(S) AND POST(S)
5. RELOCATE EXISTING SIGN(S) AND POST(S)
6. REMOVE EXT'G. AND INSTALL NEW SIGN(S) ON TRAFFIC SIGNAL POST(S)

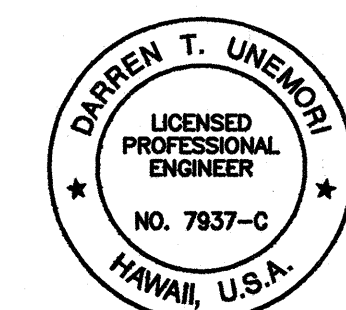

THIS WORK WAS PREPARED BY
OR UNDER MY SUPERVISION


Signature

STATE OF HAWAII
DEPARTMENT OF TRANSPORTATION
HIGHWAYS DIVISION

ROADWAY STRIPING & SIGNAGE PLAN

MAIN STREET RESURFACING
CENTRAL AVENUE TO KAAHUMANU AVENUE
AND
KAAHUMANU AVENUE RESURFACING
MAIN STREET TO HOBRON AVENUE
Fed. Aid Project No. NH-032-1(8)

SCALE: AS NOTED


SHEET No. 7 OF 13 SHEETS

FED. ROAD DIST. NO.	STATE	FED. AID PROJ. NO.	FISCAL YEAR	SHEET NO.	TOTAL SHEETS
HAWAII	HAW.	NH-032-1(8)	2000	58R	111

WAKEA AVE

STREET SIGN TO BE MOUNTED ON WEST TRAFFIC SIGNAL MAST ARM

TRUE NORTH
SCALE: 1 IN. = 40 FT.

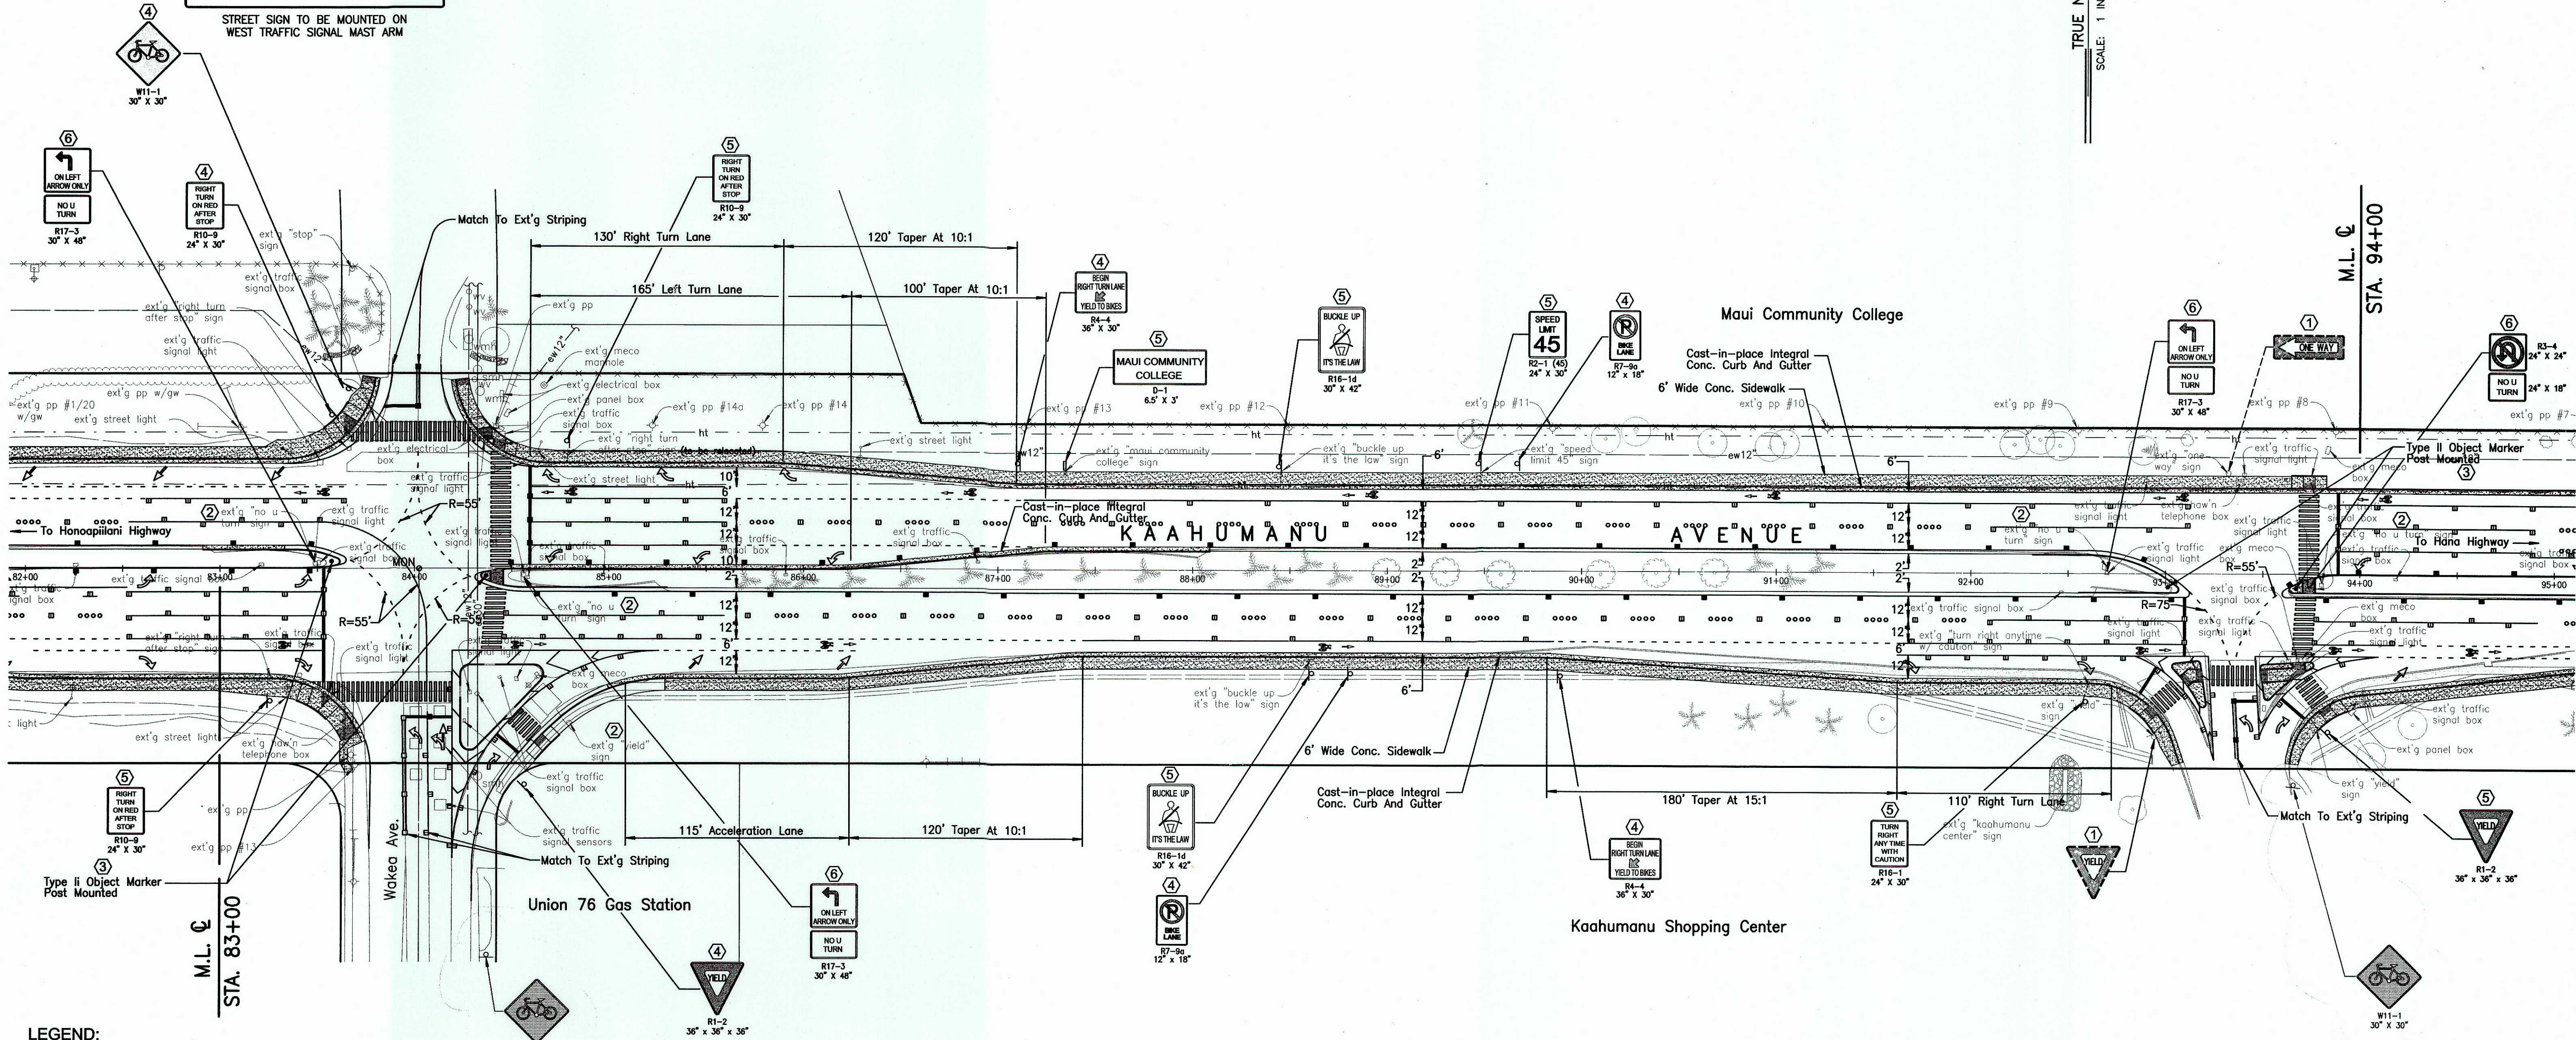


LEGEND:

- 4" DOUBLE SOLID YELLOW STRIPES WITH TYPE "D" RAISED PAVEMENT MARKERS AT 20'-0" O.C. (TAPE, TYPE I OR THERMOPLASTIC EXTRUSION)
- 4 EACH TYPE "A" RAISED PAVEMENT MARKERS TYPE "C" RAISED PAVEMENT MARKERS AT 40'-0" O.C.
- 4" DOUBLE SOLID YELLOW STRIPES WITH TYPE "H" RAISED PAVEMENT MARKERS AT 20'-0" O.C. (TAPE, TYPE II OR THERMOPLASTIC EXTRUSION)
- 8" SOLID WHITE STRIPE W/ TYPE "C" RAISED PAVEMENT MARKERS AT 20'-0" O.C. (TAPE, TYPE I OR THERMOPLASTIC EXTRUSION)
- 4" YELLOW EDGE STRIPE WITH TYPE "H" RAISED PAVEMENT MARKERS AT 40'-0" O.C. (TAPE, TYPE II OR THERMOPLASTIC EXTRUSION)
- CHANNELIZING ISLAND OR DECELERATION LANE GORE (TAPE, TYPE II OR THERMOPLASTIC EXTRUSION)
- 4" OR 8" WHITE EDGE STRIPE W/ TYPE "C" RAISED PAVEMENT MARKERS AT 40'-0" O.C. (TAPE, TYPE II OR THERMOPLASTIC EXTRUSION)

- BIKE LANE MARKING (PAINT)
- 4" WHITE GUIDELINES (TAPE, TYPE III OR THERMOPLASTIC EXTRUSION EXCEPT FOR BUS BAYS) (GUIDE LINES FOR TURNING MOVEMENTS THROUGH INTERSECTIONS SHALL BE YELLOW)
- TRANSVERSE MEDIAN MARKING (TAPE, TYPE II OR THERMOPLASTIC EXTRUSION)
- TRANSVERSE SHOULDER MARKING (TAPE, TYPE II OR THERMOPLASTIC EXTRUSION)
- PAVEMENT ARROW (TAPE, TYPE III OR THERMOPLASTIC EXTRUSION)
- CROSSWALK AND STOP LINE. ALL STOP LINES SHALL BE 10'-0" FROM CROSSWALK UNLESS OTHERWISE NOTED. THE CIRCLED NUMBER INDICATES THE NUMBER OF LANES FOR PAYMENT (TAPE, TYPE III OR THERMOPLASTIC EXTRUSION)

- 1 EXISTING SIGN(S) AND POST(S) TO REMAIN
- 2 REMOVE EXISTING SIGN(S) AND POST(S)
- 3 REMOVE EXISTING AND INSTALL NEW SIGN(S) AND POST(S)
- 4 INSTALL NEW SIGN(S) AND POST(S)
- 5 RELOCATE EXISTING SIGN(S) AND POST(S)
- 6 REMOVE EXT'G. AND INSTALL NEW SIGN(S) ON TRAFFIC SIGNAL POST(S)

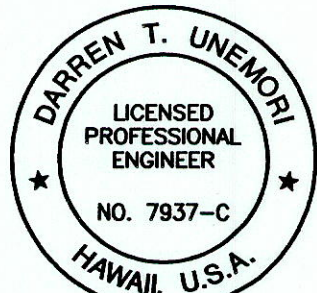

THIS WORK WAS PREPARED BY ME OR UNDER MY SUPERVISION

Signature

STATE OF HAWAII
DEPARTMENT OF TRANSPORTATION
HIGHWAYS DIVISION
ROADWAY STRIPING & SIGNAGE PLAN
MAIN STREET RESURFACING
CENTRAL AVENUE TO KAAHUMANU AVENUE
AND
KAAHUMANU AVENUE RESURFACING
MAIN STREET TO HOBSON AVENUE
Fed. Aid Project No. NH-032-1(8)

SCALE: AS NOTED

SHEET No. 8 OF 13 SHEETS

"AS-BUILT"


58R

FED. ROAD DIST. NO.	STATE	FED. AID PROJ. NO.	FISCAL YEAR	SHEET NO.	TOTAL SHEETS
HAWAII	HAW.	NH-032-1(8)	2000	58	111

TRUE NORTH
SCALE: 1 IN. = 40 FT.

WAKEA AVE


STREET SIGN TO BE MOUNTED ON WEST TRAFFIC SIGNAL MAST ARM

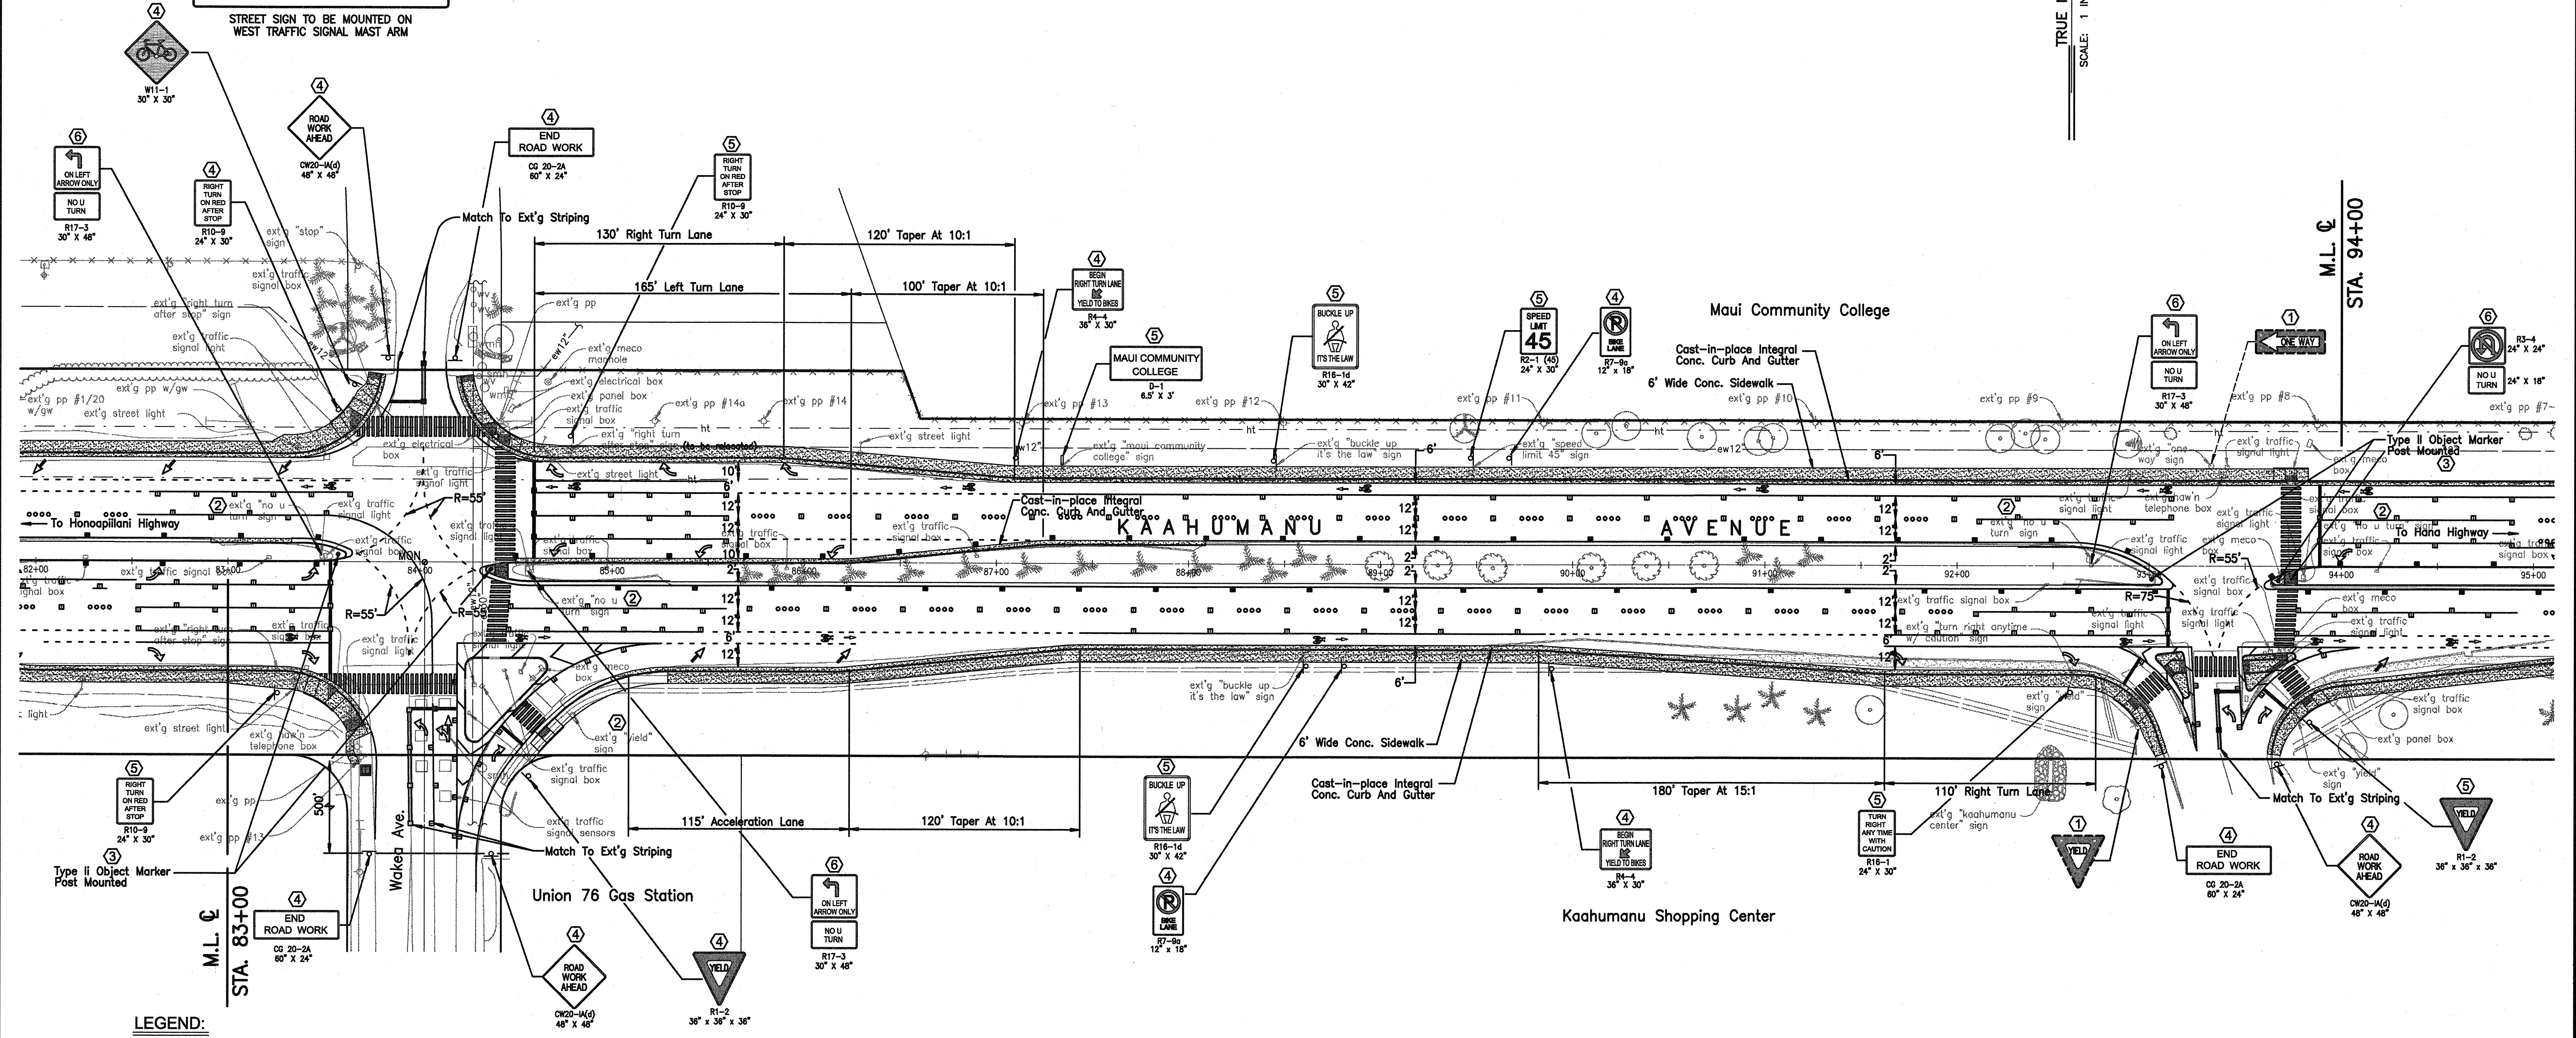

LEGEND:

- 4" DOUBLE SOLID YELLOW STRIPES WITH TYPE "D" RAISED PAVEMENT MARKERS AT 20'-0" O.C. (TAPE, TYPE I OR THERMOPLASTIC EXTRUSION)
- 4 EACH TYPE "A" RAISED PAVEMENT MARKERS TYPE "C" RAISED PAVEMENT MARKERS AT 40'-0" O.C.
- 4" DOUBLE SOLID YELLOW STRIPES WITH TYPE "H" RAISED PAVEMENT MARKERS AT 20'-0" O.C. (TAPE, TYPE II OR THERMOPLASTIC EXTRUSION)
- 8" SOLID WHITE STRIPE W/ TYPE "C" RAISED PAVEMENT MARKERS AT 20'-0" O.C. (TAPE, TYPE I OR THERMOPLASTIC EXTRUSION)
- 4" YELLOW EDGE STRIPE WITH TYPE "H" RAISED PAVEMENT MARKERS AT 40'-0" O.C. (TAPE, TYPE II OR THERMOPLASTIC EXTRUSION)
- CHANNELIZING ISLAND OR DECELERATION LANE GORE (TAPE, TYPE II OR THERMOPLASTIC EXTRUSION)
- 4" OR 8" WHITE EDGE STRIPE W/ TYPE "C" RAISED PAVEMENT MARKERS AT 40'-0" O.C. (TAPE, TYPE II OR THERMOPLASTIC EXTRUSION)
- BIKE LANE MARKING (PAINT)
- 4" WHITE GUIDELINES (TAPE, TYPE III OR THERMOPLASTIC EXTRUSION EXCEPT FOR BUS BAYS) (GUIDE LINES FOR TURNING MOVEMENTS THROUGH INTERSECTIONS SHALL BE YELLOW)
- TRANSVERSE MEDIAN MARKING (TAPE, TYPE II OR THERMOPLASTIC EXTRUSION)
- TRANSVERSE SHOULDER MARKING (TAPE, TYPE II OR THERMOPLASTIC EXTRUSION)
- PAVEMENT ARROW (TAPE, TYPE III OR THERMOPLASTIC EXTRUSION)
- CROSSWALK AND STOP LINE. ALL STOP LINES SHALL BE 10'-0" FROM CROSSWALK UNLESS OTHERWISE NOTED. THE CIRCLED NUMBER INDICATES THE NUMBER OF LANES FOR PAYMENT (TAPE, TYPE III OR THERMOPLASTIC EXTRUSION)

- 1 EXISTING SIGN(S) AND POST(S) TO REMAIN
- 2 REMOVE EXISTING SIGN(S) AND POST(S)
- 3 REMOVE EXISTING AND INSTALL NEW SIGN(S) AND POST(S)
- 4 INSTALL NEW SIGN(S) AND POST(S)
- 5 RELOCATE EXISTING SIGN(S) AND POST(S)
- 6 REMOVE EXT'G. AND INSTALL NEW SIGN(S) ON TRAFFIC SIGNAL POST(S)

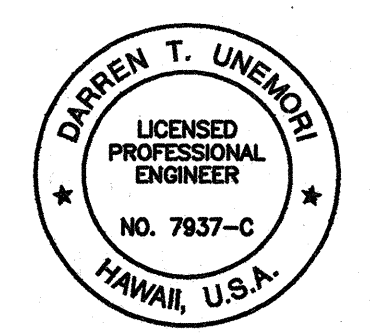

THIS WORK WAS PREPARED BY ME OR UNDER MY SUPERVISION
Signature 4/10/00


STATE OF HAWAII
DEPARTMENT OF TRANSPORTATION
HIGHWAYS DIVISION

ROADWAY STRIPING & SIGNAGE PLAN

MAIN STREET RESURFACING
CENTRAL AVENUE TO KAAHUMANU AVENUE
AND
KAAHUMANU AVENUE RESURFACING
MAIN STREET TO HOBSON AVENUE
Fed. Aid Project No. NH-032-1(8)

SCALE: AS NOTED

FED. ROAD DIST. NO.	STATE	FED. AID PROJ. NO.	FISCAL YEAR	SHEET NO.	TOTAL SHEETS
HAWAII	HAW.	NH-032-1(8)	2000	59R	111

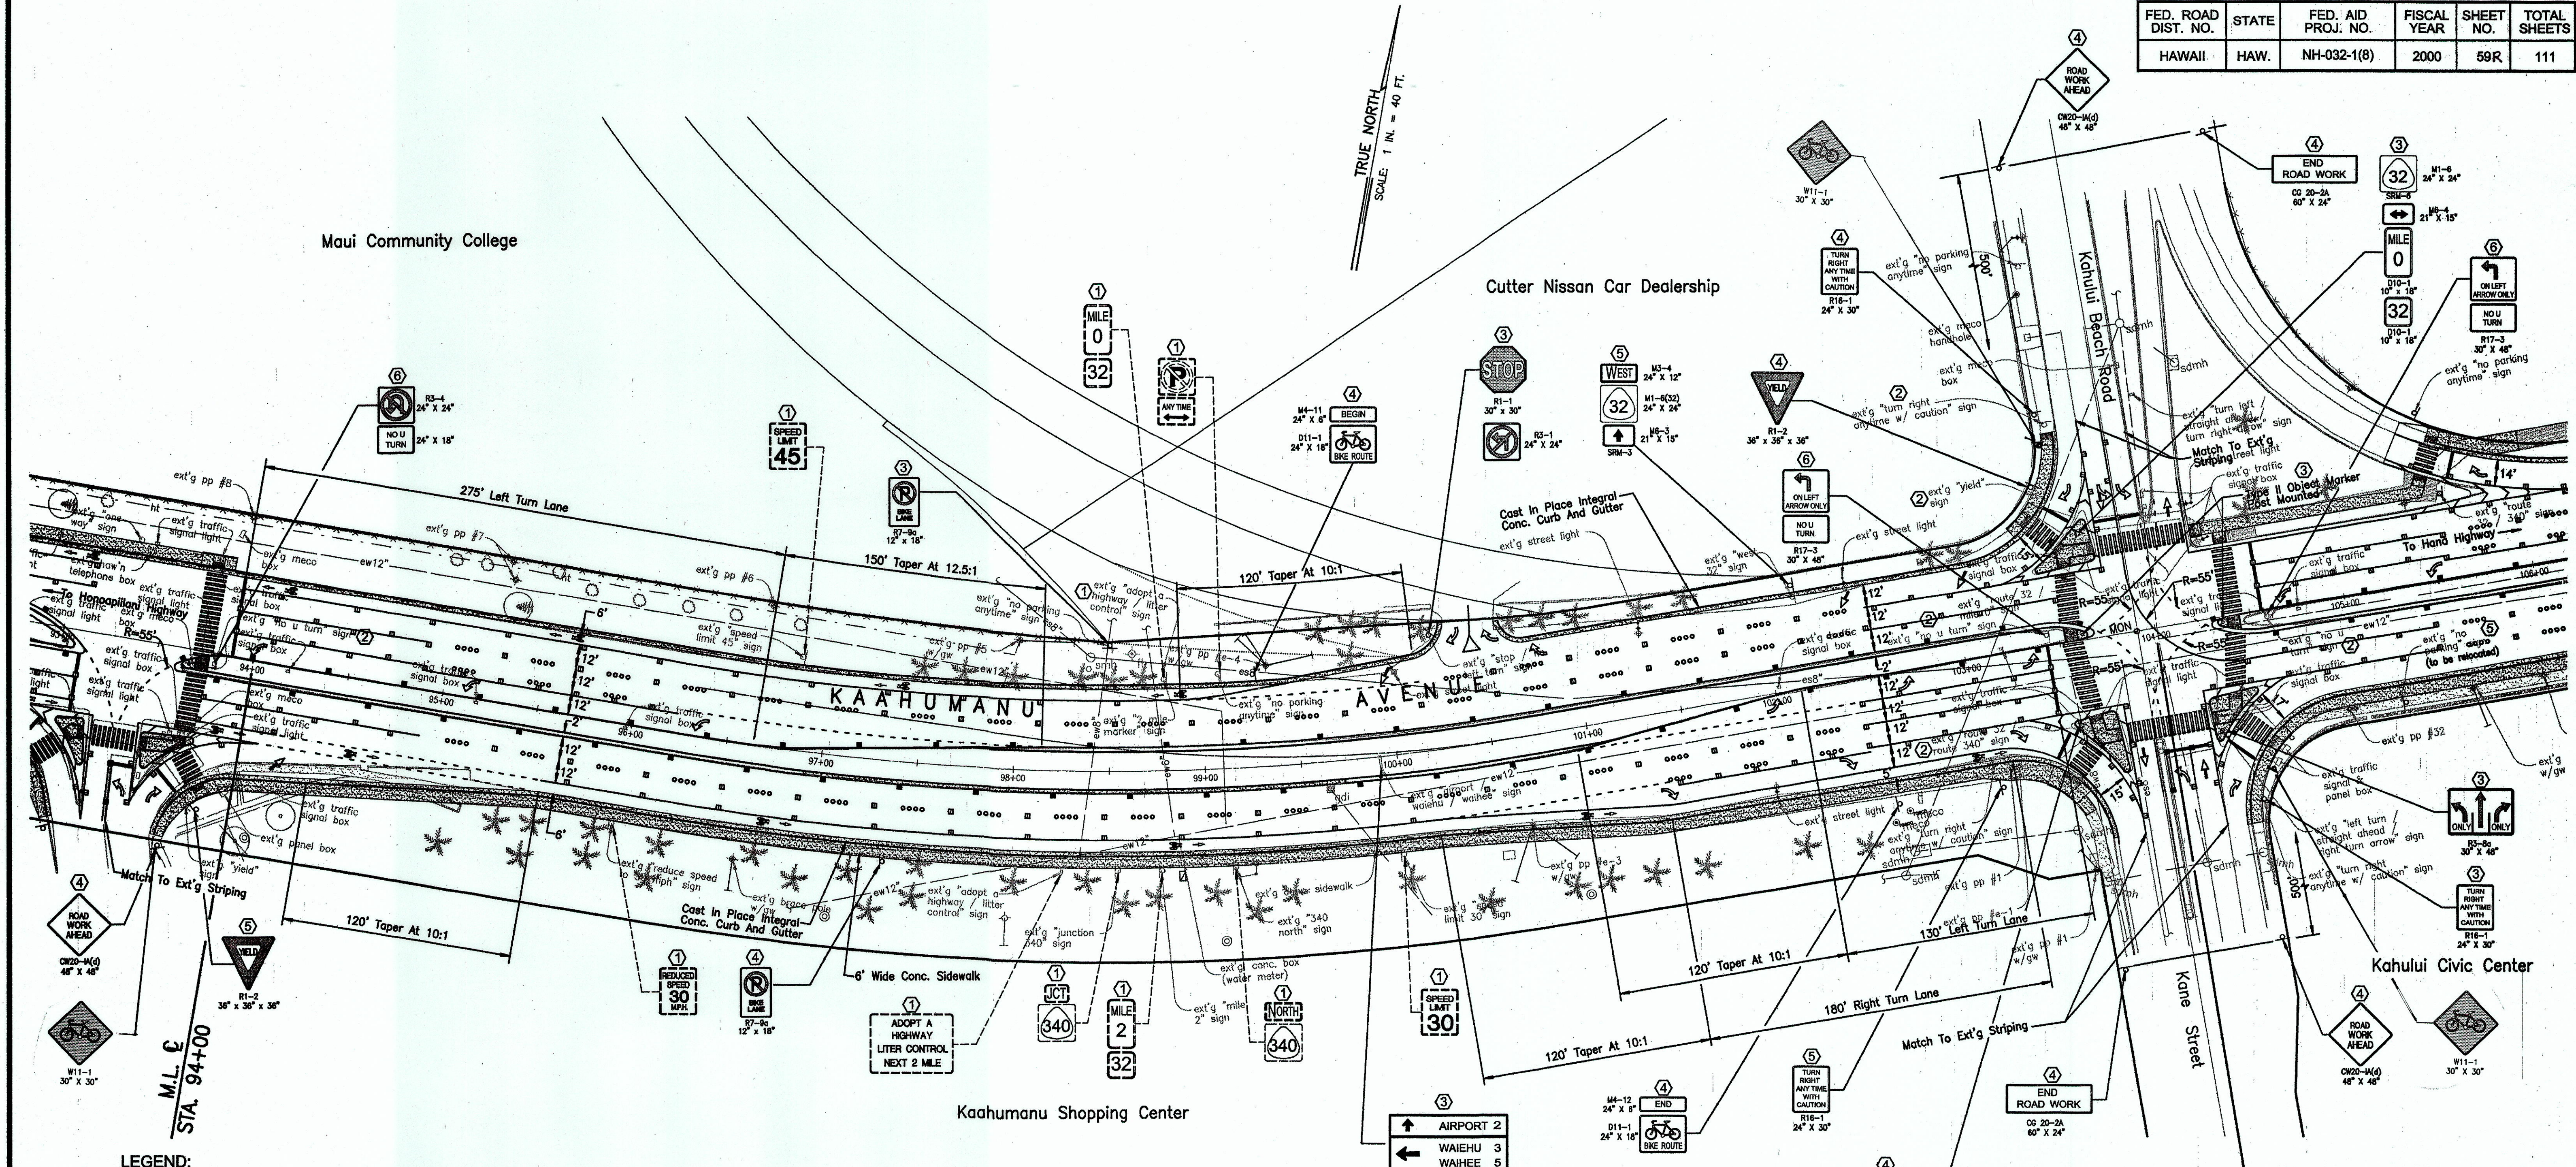

LEGEND:

- 4" DOUBLE SOLID YELLOW STRIPES WITH TYPE "D" RAISED PAVEMENT MARKERS AT 20'-0" O.C. (TAPE, TYPE I OR THERMOPLASTIC EXTRUSION)
- 4 EACH TYPE "A" RAISED PAVEMENT MARKERS TYPE "C" RAISED PAVEMENT MARKERS AT 40'-0" O.C.
- 4" DOUBLE SOLID YELLOW STRIPES WITH TYPE "H" RAISED PAVEMENT MARKERS AT 20'-0" O.C. (TAPE, TYPE II OR THERMOPLASTIC EXTRUSION)
- 8" SOLID WHITE STRIPE W/ TYPE "C" RAISED PAVEMENT MARKERS AT 20'-0" O.C. (TAPE, TYPE I OR THERMOPLASTIC EXTRUSION)
- 4" YELLOW EDGE STRIPE WITH TYPE "H" RAISED PAVEMENT MARKERS AT 40'-0" O.C. (TAPE, TYPE II OR THERMOPLASTIC EXTRUSION)
- CHANNELIZING ISLAND OR DECELERATION LANE GORE (TAPE, TYPE II OR THERMOPLASTIC EXTRUSION)
- 4" OR 8" WHITE EDGE STRIPE W/ TYPE "C" RAISED PAVEMENT MARKERS AT 40'-0" O.C. (TAPE, TYPE II OR THERMOPLASTIC EXTRUSION)
- BIKE LANE MARKING (PAINT)
- 4" WHITE GUIDELINES (TAPE, TYPE III OR THERMOPLASTIC EXTRUSION EXCEPT FOR BUS BAYS) (GUIDE LINES FOR TURNING MOVEMENTS THROUGH INTERSECTIONS SHALL BE YELLOW)
- TRANSVERSE MEDIAN MARKING (TAPE, TYPE II OR THERMOPLASTIC EXTRUSION)
- TRANSVERSE SHOULDER MARKING (TAPE, TYPE II OR THERMOPLASTIC EXTRUSION)
- PAVEMENT ARROW (TAPE, TYPE III OR THERMOPLASTIC EXTRUSION)
- CROSSWALK AND STOP LINE. ALL STOP LINES SHALL BE 10'-0" FROM CROSSWALK UNLESS OTHERWISE NOTED. THE CIRCLED NUMBER INDICATES THE NUMBER OF LANES FOR PAYMENT (TAPE, TYPE III OR THERMOPLASTIC EXTRUSION)

- 1 EXISTING SIGN(S) AND POST(S) TO REMAIN
- 2 REMOVE EXISTING SIGN(S) AND POST(S)
- 3 REMOVE EXISTING AND INSTALL NEW SIGN(S) AND POST(S)
- 4 INSTALL NEW SIGN(S) AND POST(S)
- 5 RELOCATE EXISTING SIGN(S) AND POST(S)
- 6 REMOVE EXT'G. AND INSTALL NEW SIGN(S) ON TRAFFIC SIGNAL POST(S)

DARREN T. UNEMORI
LICENSED PROFESSIONAL ENGINEER
NO. 7937-C
HAWAII, U.S.A.


THIS WORK WAS PREPARED BY ME OR UNDER MY SUPERVISION

STATE OF HAWAII
DEPARTMENT OF TRANSPORTATION
HIGHWAYS DIVISION
ROADWAY STRIPING & SIGNAGE PLAN
MAIN STREET RESURFACING
CENTRAL AVENUE TO KAAHUMANU AVENUE
AND
KAAHUMANU AVENUE RESURFACING
MAIN STREET TO HOBRON AVENUE
Fed. Aid Project No. NH-032-1(8)
SCALE: AS NOTED
SHEET No. 9 OF 13 SHEETS

"AS-BUILT"

59R

FED. ROAD DIST. NO.	STATE	FED. AID PROJ. NO.	FISCAL YEAR	SHEET NO.	TOTAL SHEETS
HAWAII	HAW.	NH-032-1(8)	2000	60R	111

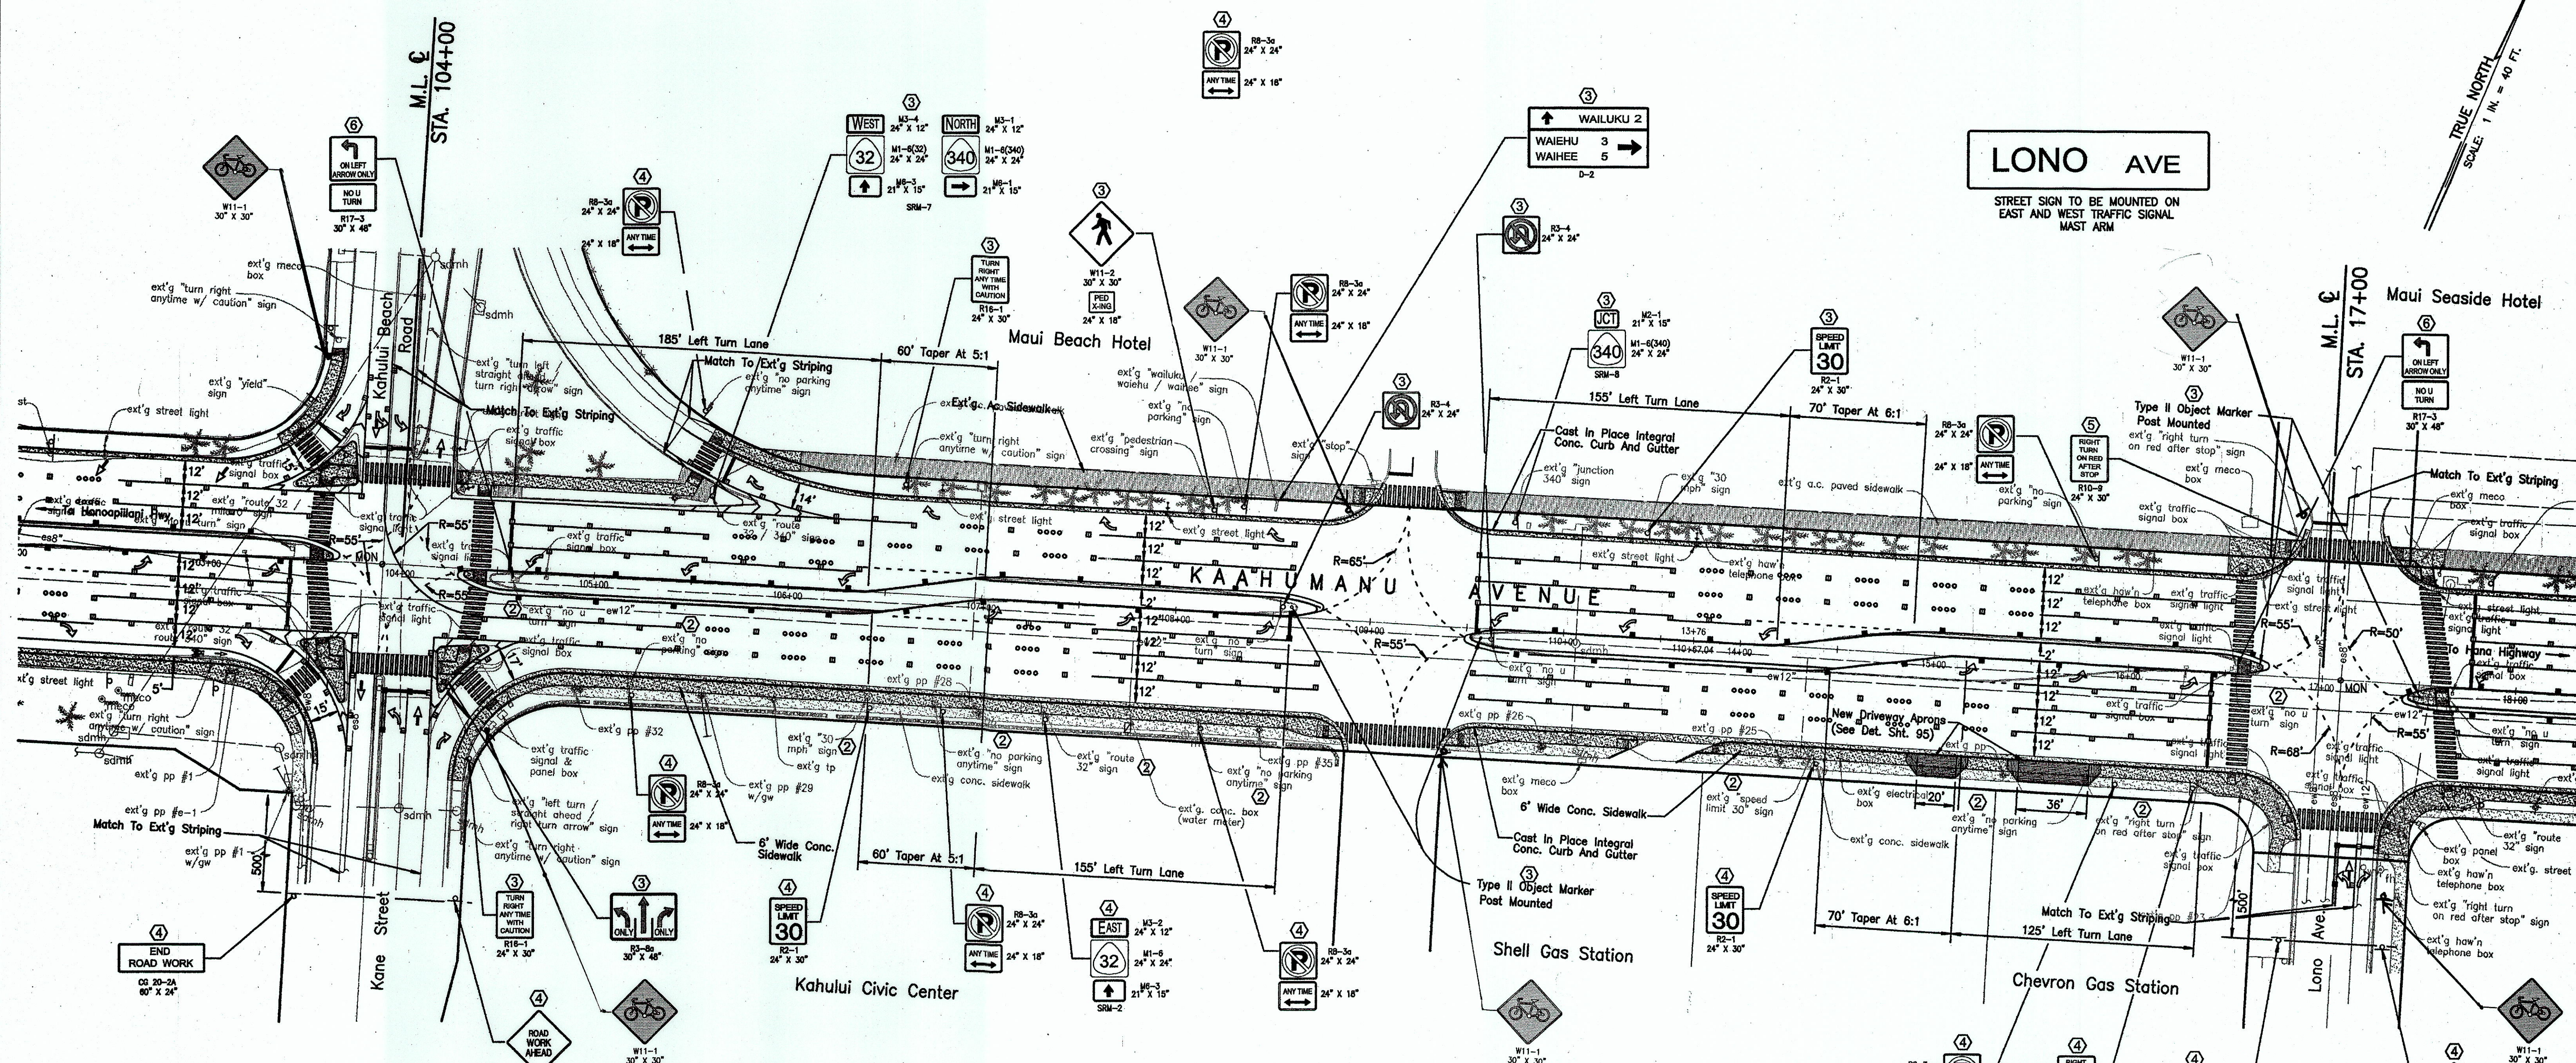

DATE	DATE	DATE	DATE	DATE
DESIGNED BY	DESIGNED BY	DESIGNED BY	DESIGNED BY	DESIGNED BY
TRACED BY	TRACED BY	TRACED BY	TRACED BY	TRACED BY
NOTED BY	NOTED BY	NOTED BY	NOTED BY	NOTED BY
CHECKED BY	CHECKED BY	CHECKED BY	CHECKED BY	CHECKED BY

LEGEND:

- 4" DOUBLE SOLID YELLOW STRIPES WITH TYPE "D" RAISED PAVEMENT MARKERS AT 20'-0" O.C. (TAPE, TYPE I OR THERMOPLASTIC EXTRUSION)
- 4 EACH TYPE "A" RAISED PAVEMENT MARKERS TYPE "C" RAISED PAVEMENT MARKERS AT 40'-0" O.C.
- 4" DOUBLE SOLID YELLOW STRIPES WITH TYPE "H" RAISED PAVEMENT MARKERS AT 20'-0" O.C. (TAPE, TYPE II OR THERMOPLASTIC EXTRUSION)
- 8" SOLID WHITE STRIPE W/ TYPE "C" RAISED PAVEMENT MARKERS AT 20'-0" O.C. (TAPE, TYPE I OR THERMOPLASTIC EXTRUSION)
- 4" YELLOW EDGE STRIPE WITH TYPE "H" RAISED PAVEMENT MARKERS AT 40'-0" O.C. (TAPE, TYPE II OR THERMOPLASTIC EXTRUSION)
- CHANNELIZING ISLAND OR DECELERATION LANE GORE (TAPE, TYPE II OR THERMOPLASTIC EXTRUSION)
- 4" OR 8" WHITE EDGE STRIPE W/ TYPE "C" RAISED PAVEMENT MARKERS AT 40'-0" O.C. (TAPE, TYPE II OR THERMOPLASTIC EXTRUSION)
- BIKE LANE MARKING (PAINT)
- 4" WHITE GUIDELINES (TAPE, TYPE III OR THERMOPLASTIC EXTRUSION EXCEPT FOR BUS BAYS) (GUIDE LINES FOR TURNING MOVEMENTS THROUGH INTERSECTIONS SHALL BE YELLOW)
- TRANSVERSE MEDIAN MARKING (TAPE, TYPE II OR THERMOPLASTIC EXTRUSION)
- TRANSVERSE SHOULDER MARKING (TAPE, TYPE II OR THERMOPLASTIC EXTRUSION)
- PAVEMENT ARROW (TAPE, TYPE III OR THERMOPLASTIC EXTRUSION)
- CROSSWALK AND STOP LINE. ALL STOP LINES SHALL BE 10'-0" FROM CROSSWALK UNLESS OTHERWISE NOTED. THE CIRCLED NUMBER INDICATES THE NUMBER OF LANES FOR PAYMENT (TAPE, TYPE III OR THERMOPLASTIC EXTRUSION)

- 1 EXISTING SIGN(S) AND POST(S) TO REMAIN
- 2 REMOVE EXISTING SIGN(S) AND POST(S)
- 3 REMOVE EXISTING AND INSTALL NEW SIGN(S) AND POST(S)
- 4 INSTALL NEW SIGN(S) AND POST(S)
- 5 RELOCATE EXISTING SIGN(S) AND POST(S)
- 6 REMOVE EXT'G. AND INSTALL NEW SIGN(S) ON TRAFFIC SIGNAL POST(S)

DARREN T. UNEMORI
LICENSED PROFESSIONAL ENGINEER
NO. 7937-C
HAWAII, U.S.A.

THIS WORK WAS PREPARED BY ME OR UNDER MY SUPERVISION

[Signature]

STATE OF HAWAII
DEPARTMENT OF TRANSPORTATION
HIGHWAYS DIVISION


ROADWAY STRIPING & SIGNAGE PLAN

MAIN STREET RESURFACING
CENTRAL AVENUE TO KAAHUMANU AVENUE
AND
KAAHUMANU AVENUE RESURFACING
MAIN STREET TO HOBSON AVENUE
Fed. Aid Project No. NH-032-1(8)

SCALE: AS NOTED

"AS-BUILT"


FED. ROAD DIST. NO.	STATE	FED. AID PROJ. NO.	FISCAL YEAR	SHEET NO.	TOTAL SHEETS
HAWAII	HAW.	NH-032-1(8)	2000	61R	111

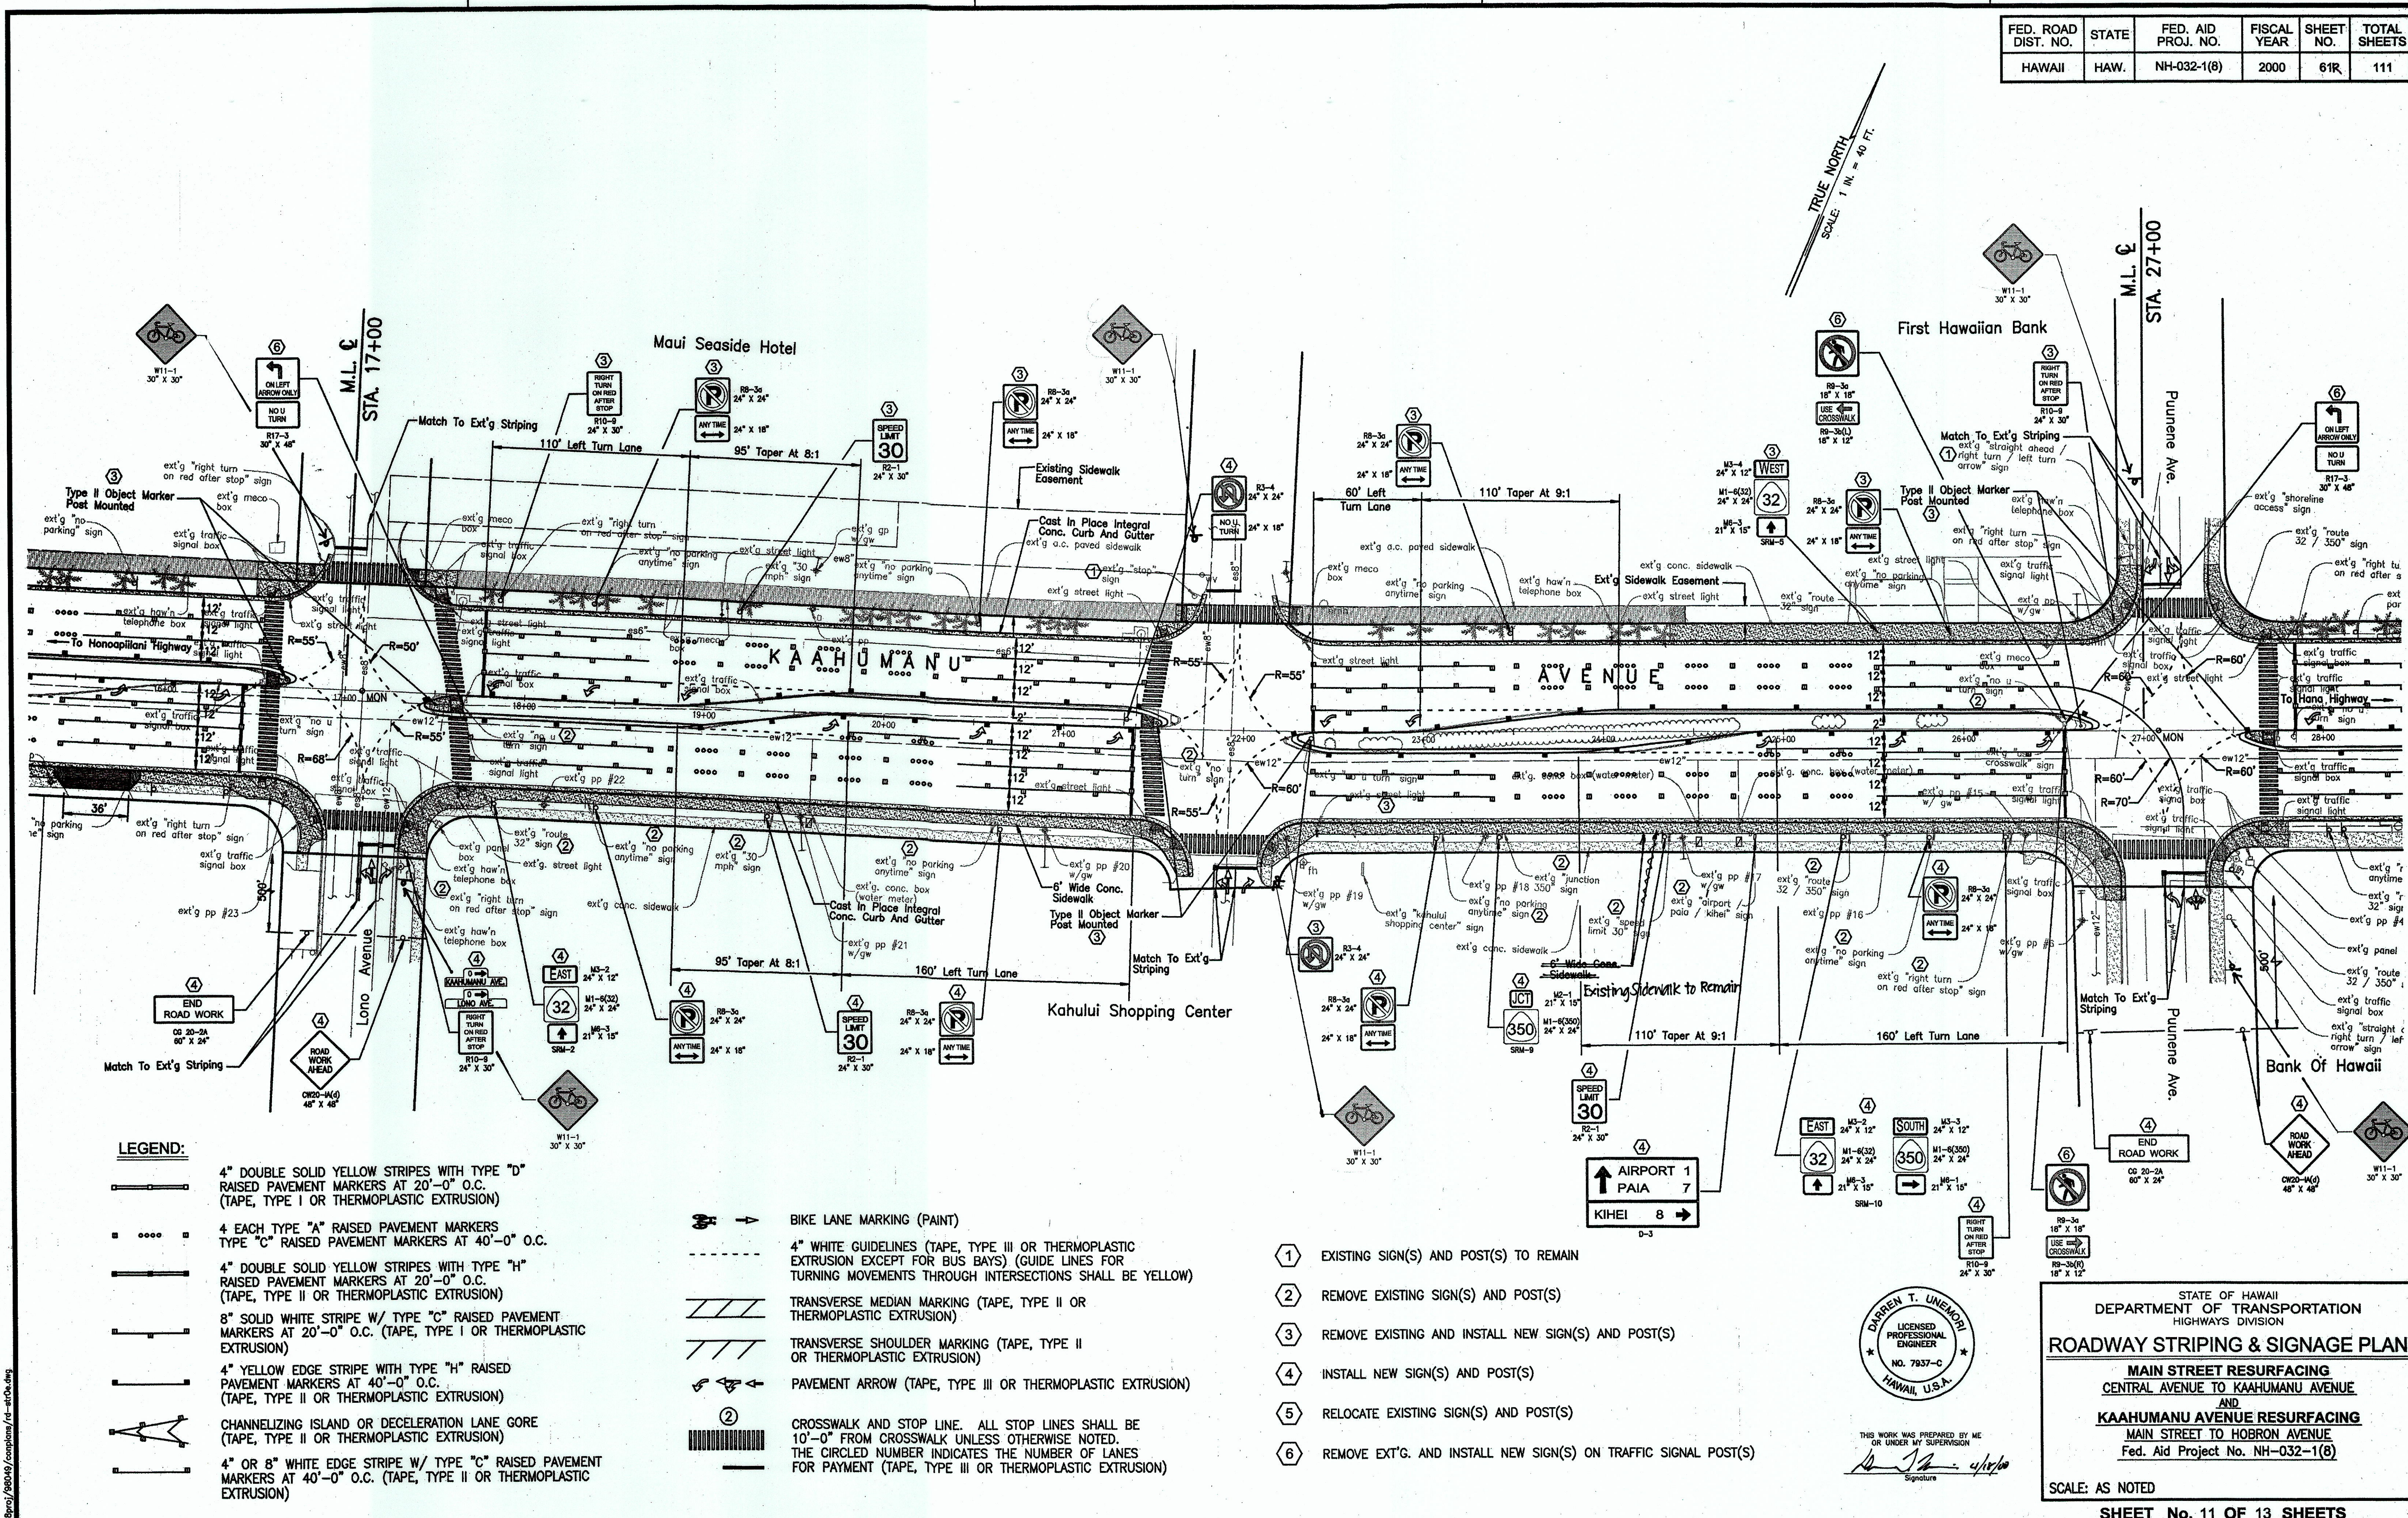

LEGEND:

- 4" DOUBLE SOLID YELLOW STRIPES WITH TYPE "D" RAISED PAVEMENT MARKERS AT 20'-0" O.C. (TAPE, TYPE I OR THERMOPLASTIC EXTRUSION)
- 4 EACH TYPE "A" RAISED PAVEMENT MARKERS TYPE "C" RAISED PAVEMENT MARKERS AT 40'-0" O.C.
- 4" DOUBLE SOLID YELLOW STRIPES WITH TYPE "H" RAISED PAVEMENT MARKERS AT 20'-0" O.C. (TAPE, TYPE II OR THERMOPLASTIC EXTRUSION)
- 8" SOLID WHITE STRIPE W/ TYPE "C" RAISED PAVEMENT MARKERS AT 20'-0" O.C. (TAPE, TYPE I OR THERMOPLASTIC EXTRUSION)
- 4" YELLOW EDGE STRIPE WITH TYPE "H" RAISED PAVEMENT MARKERS AT 40'-0" O.C. (TAPE, TYPE II OR THERMOPLASTIC EXTRUSION)
- CHANNELIZING ISLAND OR DECELERATION LANE GORE (TAPE, TYPE II OR THERMOPLASTIC EXTRUSION)
- 4" OR 8" WHITE EDGE STRIPE W/ TYPE "C" RAISED PAVEMENT MARKERS AT 40'-0" O.C. (TAPE, TYPE II OR THERMOPLASTIC EXTRUSION)
- BIKE LANE MARKING (PAINT)
- 4" WHITE GUIDELINES (TAPE, TYPE III OR THERMOPLASTIC EXTRUSION EXCEPT FOR BUS BAYS) (GUIDE LINES FOR TURNING MOVEMENTS THROUGH INTERSECTIONS SHALL BE YELLOW)
- TRANSVERSE MEDIAN MARKING (TAPE, TYPE II OR THERMOPLASTIC EXTRUSION)
- TRANSVERSE SHOULDER MARKING (TAPE, TYPE II OR THERMOPLASTIC EXTRUSION)
- PAVEMENT ARROW (TAPE, TYPE III OR THERMOPLASTIC EXTRUSION)
- CROSSWALK AND STOP LINE. ALL STOP LINES SHALL BE 10'-0" FROM CROSSWALK UNLESS OTHERWISE NOTED. THE CIRCLED NUMBER INDICATES THE NUMBER OF LANES FOR PAYMENT (TAPE, TYPE III OR THERMOPLASTIC EXTRUSION)

- 1 EXISTING SIGN(S) AND POST(S) TO REMAIN
- 2 REMOVE EXISTING SIGN(S) AND POST(S)
- 3 REMOVE EXISTING AND INSTALL NEW SIGN(S) AND POST(S)
- 4 INSTALL NEW SIGN(S) AND POST(S)
- 5 RELOCATE EXISTING SIGN(S) AND POST(S)
- 6 REMOVE EXT'G. AND INSTALL NEW SIGN(S) ON TRAFFIC SIGNAL POST(S)

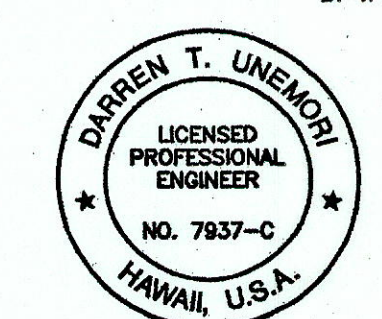

THIS WORK WAS PREPARED BY ME OR UNDER MY SUPERVISION
 Signature: *[Signature]* 4/10/00

STATE OF HAWAII
 DEPARTMENT OF TRANSPORTATION
 HIGHWAYS DIVISION

ROADWAY STRIPING & SIGNAGE PLAN

MAIN STREET RESURFACING
 CENTRAL AVENUE TO KAHUUMANU AVENUE
 AND
 KAHUUMANU AVENUE RESURFACING
 MAIN STREET TO HOBSON AVENUE
 Fed. Aid Project No. NH-032-1(8)

SCALE: AS NOTED


SHEET No. 11 OF 13 SHEETS

"AS-BUILT"

61R

FED. ROAD DIST. NO.	STATE	FED. AID PROJ. NO.	FISCAL YEAR	SHEET NO.	TOTAL SHEETS
HAWAII	HAW.	NH-032-1(8)	2000	62A	111


TRUE NORTH
SCALE: 1 in. = 40 ft.

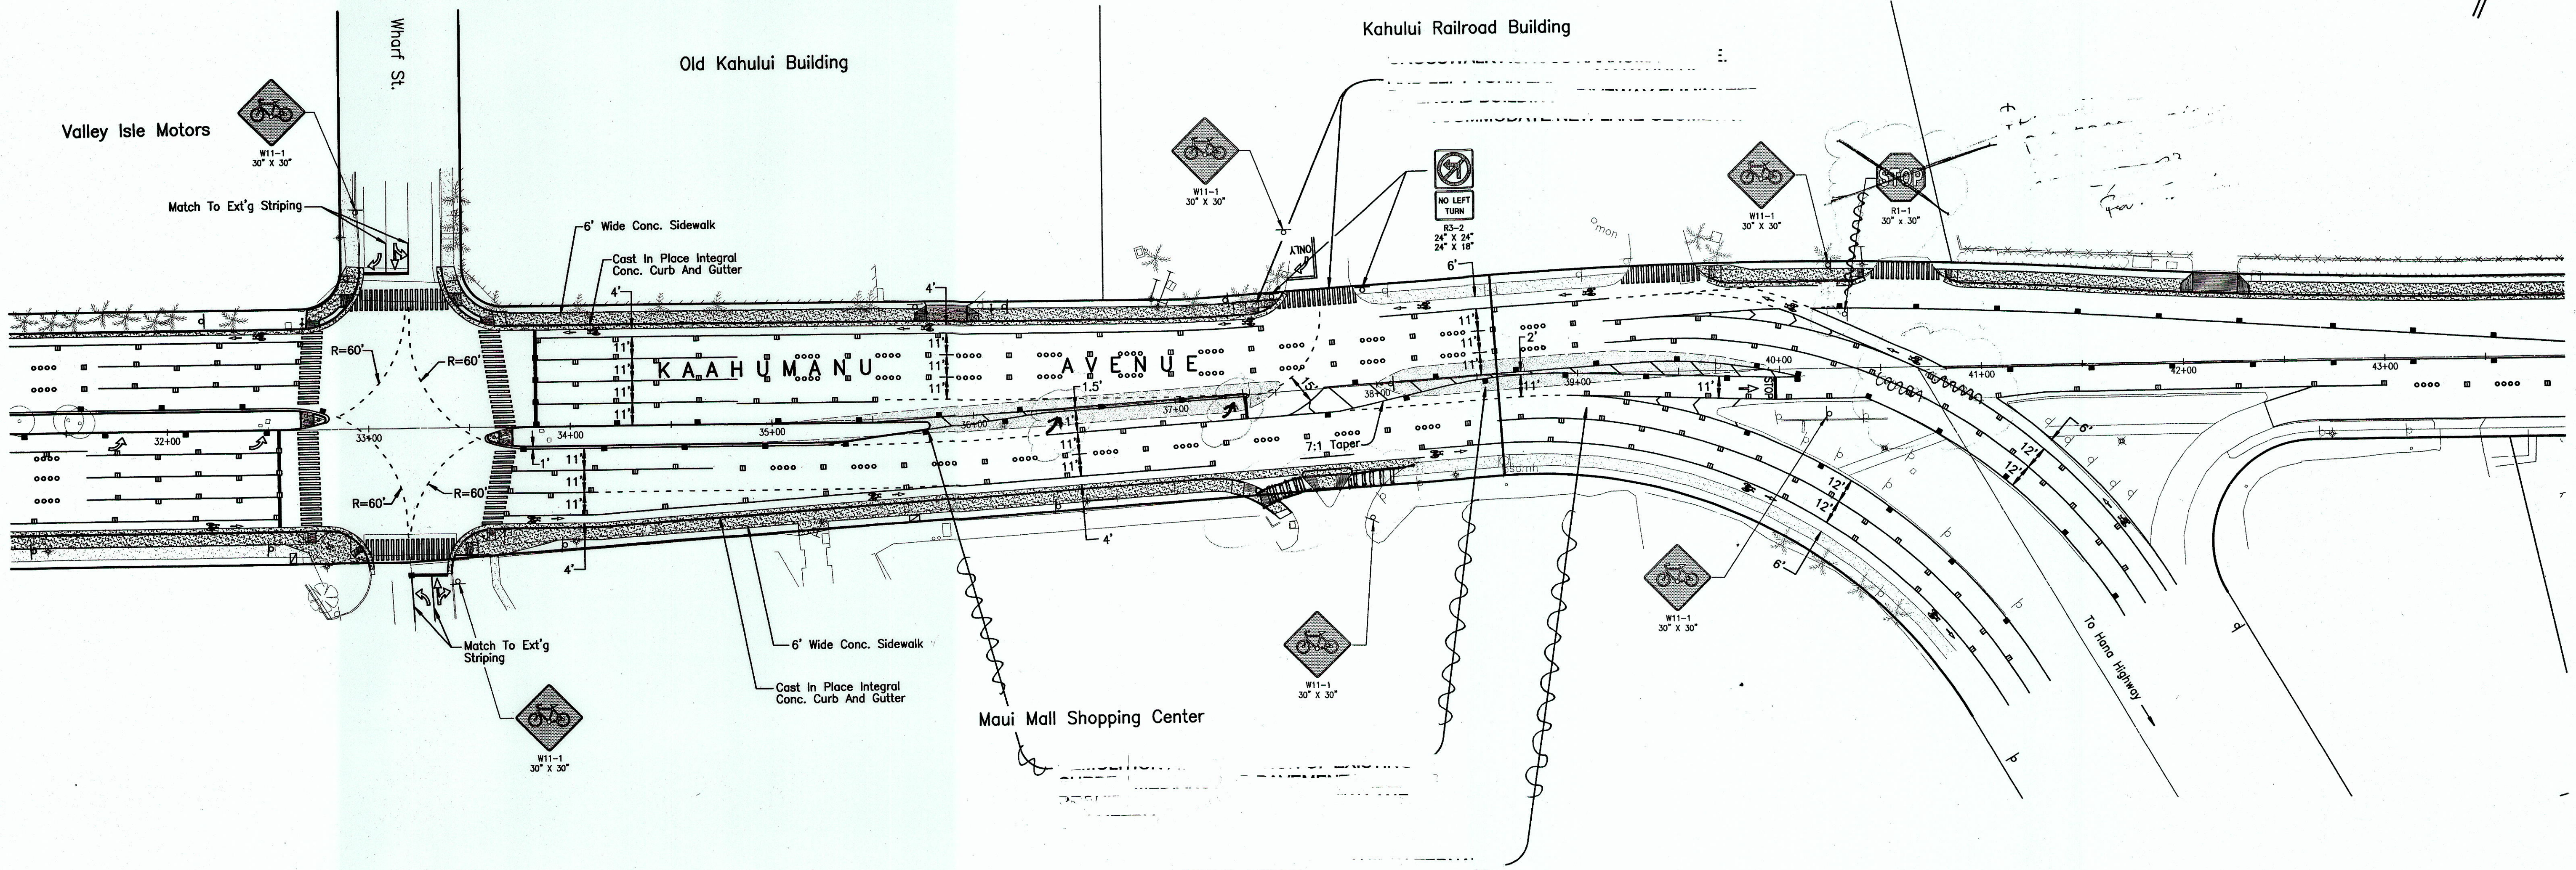

LEGEND:

- 4" DOUBLE SOLID YELLOW STRIPES WITH TYPE "D" RAISED PAVEMENT MARKERS AT 20'-0" O.C. (TAPE, TYPE I OR THERMOPLASTIC EXTRUSION)
- 4 EACH TYPE "A" RAISED PAVEMENT MARKERS TYPE "C" RAISED PAVEMENT MARKERS AT 40'-0" O.C.
- 4" DOUBLE SOLID YELLOW STRIPES WITH TYPE "H" RAISED PAVEMENT MARKERS AT 20'-0" O.C. (TAPE, TYPE II OR THERMOPLASTIC EXTRUSION)
- 8" SOLID WHITE STRIPE W/ TYPE "C" RAISED PAVEMENT MARKERS AT 20'-0" O.C. (TAPE, TYPE I OR THERMOPLASTIC EXTRUSION)
- 4" YELLOW EDGE STRIPE WITH TYPE "H" RAISED PAVEMENT MARKERS AT 40'-0" O.C. (TAPE, TYPE II OR THERMOPLASTIC EXTRUSION)
- CHANNELIZING ISLAND OR DECELERATION LANE GORE (TAPE, TYPE II OR THERMOPLASTIC EXTRUSION)
- 4" OR 8" WHITE EDGE STRIPE W/ TYPE "C" RAISED PAVEMENT MARKERS AT 40'-0" O.C. (TAPE, TYPE II OR THERMOPLASTIC EXTRUSION)
- BIKE LANE MARKING (PAINT)
- 4" WHITE GUIDELINES (TAPE, TYPE III OR THERMOPLASTIC EXTRUSION EXCEPT FOR BUS BAYS) (GUIDE LINES FOR TURNING MOVEMENTS THROUGH INTERSECTIONS SHALL BE YELLOW)
- TRANSVERSE MEDIAN MARKING (TAPE, TYPE II OR THERMOPLASTIC EXTRUSION)
- TRANSVERSE SHOULDER MARKING (TAPE, TYPE II OR THERMOPLASTIC EXTRUSION)
- PAVEMENT ARROW (TAPE, TYPE III OR THERMOPLASTIC EXTRUSION)
- CROSSWALK AND STOP LINE. ALL STOP LINES SHALL BE 10'-0" FROM CROSSWALK UNLESS OTHERWISE NOTED. THE CIRCLED NUMBER INDICATES THE NUMBER OF LANES FOR PAYMENT (TAPE, TYPE III OR THERMOPLASTIC EXTRUSION)
- 1 EXISTING SIGN(S) AND POST(S) TO REMAIN
- 2 REMOVE EXISTING SIGN(S) AND POST(S)
- 3 REMOVE EXISTING AND INSTALL NEW SIGN(S) AND POST(S)
- 4 INSTALL NEW SIGN(S) AND POST(S)
- 5 RELOCATE EXISTING SIGN(S) AND POST(S)
- 6 REMOVE EXT'G. AND INSTALL NEW SIGN(S) ON TRAFFIC SIGNAL POST(S)

DATE	DATE	DATE	DATE	DATE	DATE
SURVEY PLOTTED BY	DRAWN BY	DESIGNED BY	CHECKED BY	IN CHARGE	DATE
PLAN	BOOK	NOTE	DATE	DATE	DATE

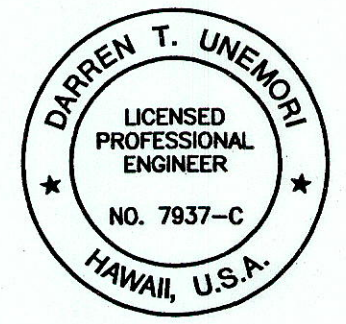

THIS WORK WAS PREPARED BY ME OR UNDER MY SUPERVISION
Signature

STATE OF HAWAII
DEPARTMENT OF TRANSPORTATION
HIGHWAYS DIVISION
ROADWAY STRIPING & SIGNAGE PLAN
MAIN STREET RESURFACING
CENTRAL AVENUE TO KAAHUMANU AVENUE
AND
KAAHUMANU AVENUE RESURFACING
MAIN STREET TO HOBSON AVENUE
Fed. Aid Project No. NH-032-1(8)
SCALE: AS NOTED

FED. ROAD DIST. NO.	STATE	FED. AID PROJ. NO.	FISCAL YEAR	SHEET NO.	TOTAL SHEETS
HAWAII	HAW.	NH-032-1(8)	2000	63	111

