




INDEX TO DRAWINGS	
SHEET NO.	DESCRIPTION
1	TITLE SHEET
2	STANDARD PLANS SUMMARY
3	GENERAL NOTES AND LEGEND
4	GENERAL PLAN / SHEET INDEX
5-11	TYPICAL ROAD SECTIONS
12-24	ROADWAY IMPROVEMENT PLAN
25-37	ROADWAY GRADING PLAN
38-50	ROADWAY DRAINAGE PLAN
51-63	ROADWAY STRIPING & SIGNAGE PLAN
64-78	INTERSECTION STRIPING & SIGNAGE PLAN
79-94	INTERSECTION GRADING PLAN
95-97	CURB RAMP DETAILS AND NOTES
98-104	GUARDRAIL DETAILS
105-106	DRAINAGE DETAILS
107-108	WATER DETAILS
109	PAVEMENT MARKING DETAILS, NOTES AND SIGN PANEL LAYOUT
110-111	MISCELLANEOUS SUMMARIES

STATE OF HAWAII
DEPARTMENT OF TRANSPORTATION
HIGHWAYS DIVISION
HONOLULU, HAWAII
"AS-BUILT"
PLANS FOR
MAIN STREET RESURFACING
CENTRAL AVENUE TO KAAHUMANU AVENUE
AND
KAAHUMANU AVENUE RESURFACING
MAIN STREET TO HOBRON AVENUE
FEDERAL-AID PROJECT NO. NH-032-1(8)
DISTRICT OF WAILUKU
ISLAND OF MAUI

LOCATION OF PROJECT

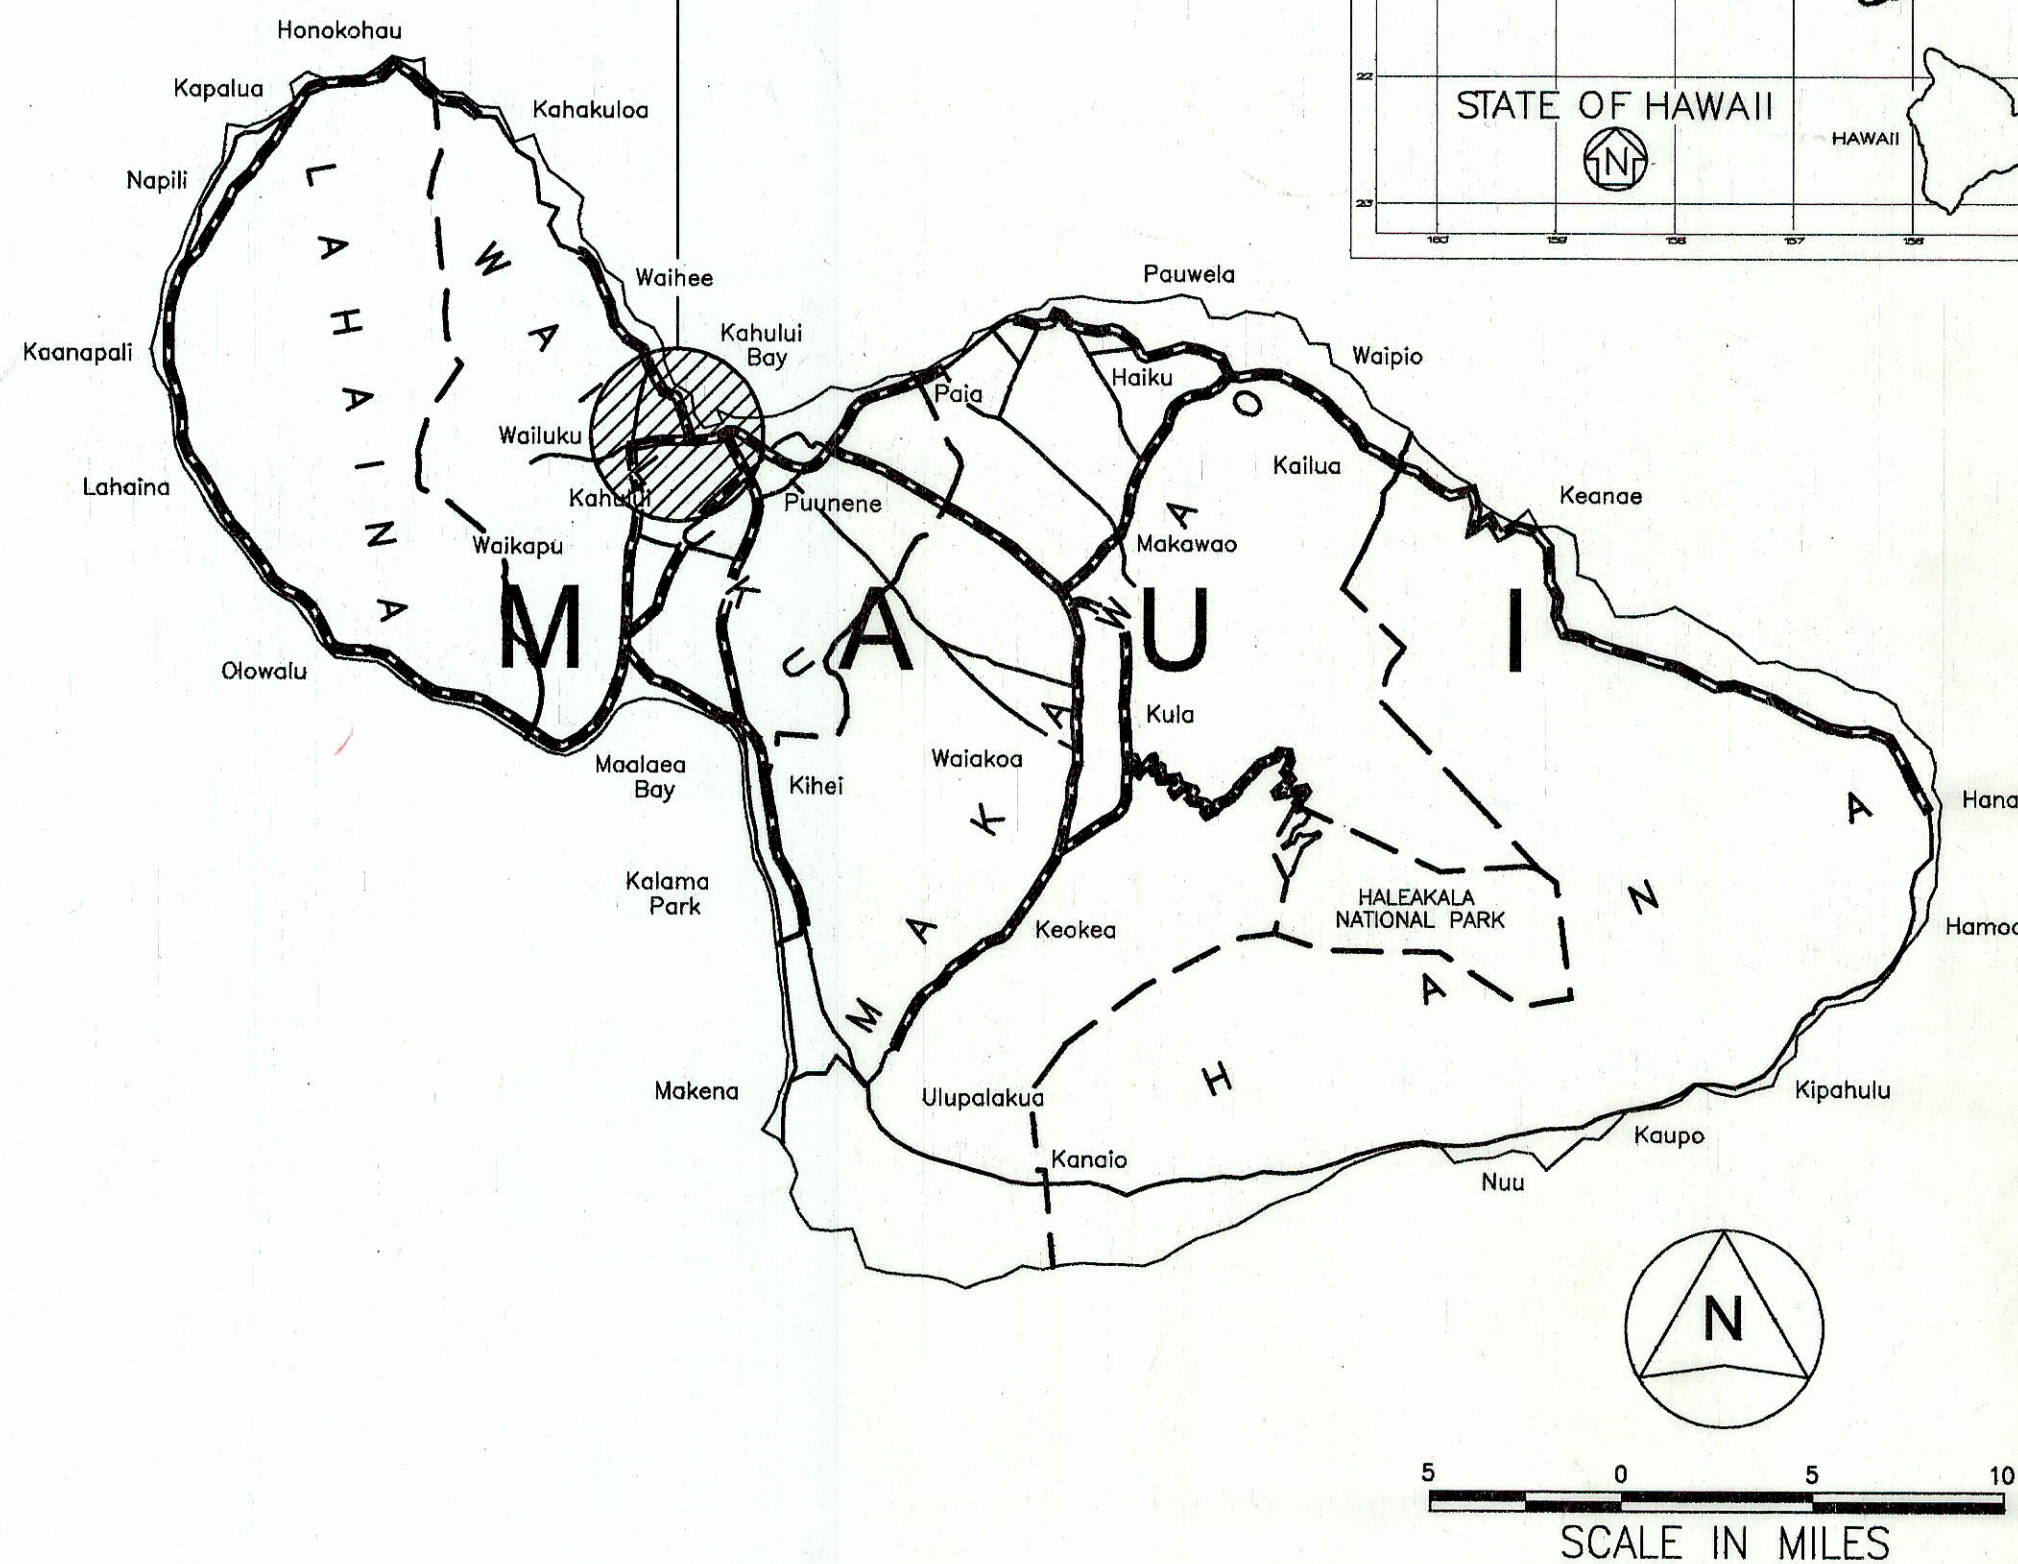

FED. ROAD DIST. NO.	STATE	FED. AID PROJ. NO.	FISCAL YEAR	SHEET NO.	TOTAL SHEETS
HAWAII	HAW.	NH-032-1(8)	2000	1	111

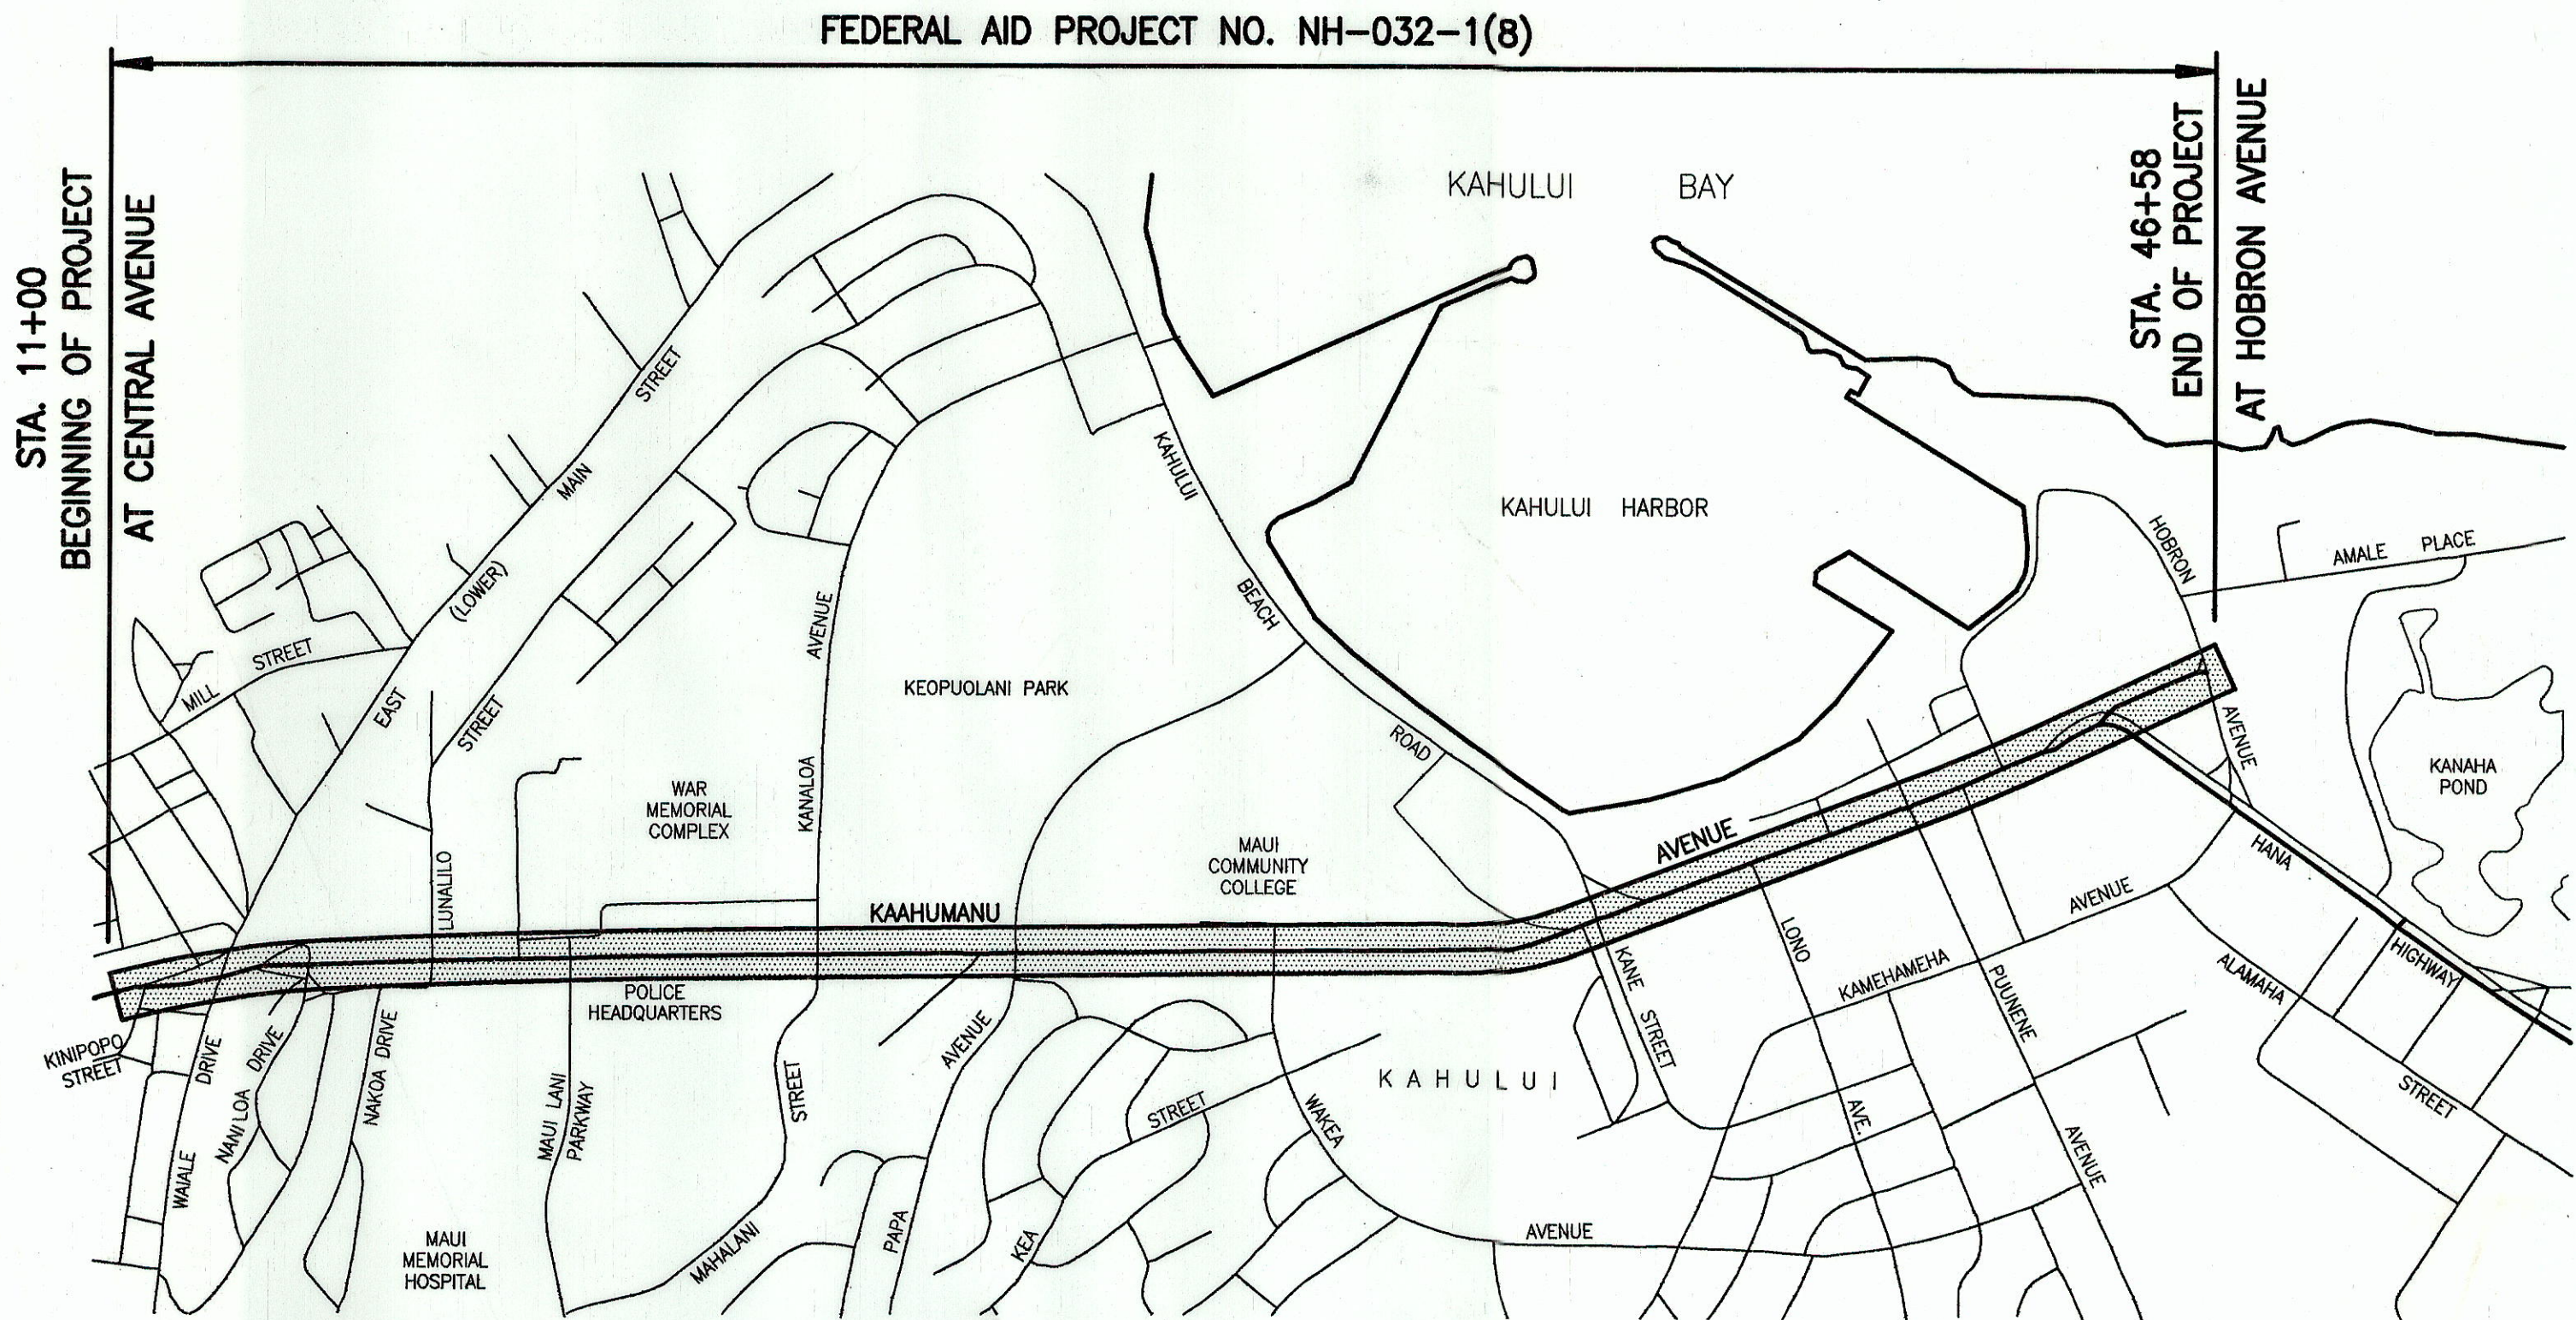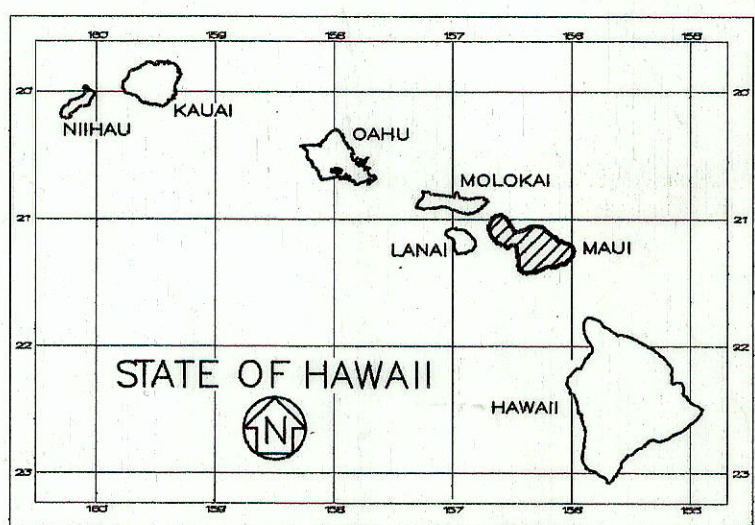

LAYOUT PLAN

GROSS LENGTH OF PROJECT 2.50 MILES
NET LENGTH OF PROJECT 2.50 MILES

0 1000 2000 3000 4000
SCALE IN FEET

— FEDERAL AID PROJECTS PREVIOUSLY CONSTRUCTED OR UNDER CONSTRUCTION

MILE POST 0.34 TO MILE POST 2.84

DESIGN DESIGNATION	MAIN ST. TO KANALOA AVE.	KANALOA AVE. TO PAPA AVE.	PAPA AVE. TO KAHULUI BEACH RD.	KAHULUI BEACH RD. TO PUUNENE AVE.	PUUNENE AVE. TO HANA HIGHWAY	HANA HIGHWAY TO HOBRON AVE.
ADT (1998)	31,630	40,970	31,450	54,280	36,330	3,550
ADT (2008)	34,950	45,270	34,750	66,950	44,810	4,380
DHV	2,970	4,070	2,950	5,360	3,580	390
K (DESIGN)	8.5	9.0	8.5	8.0	8.0	9.0
D (DESIGN)	55/45	55/45	55/45	55/45	55/45	55/45
T (DESIGN)	1.5	1.5	1.5	3.5	3.5	9.0
T24	1.5	1.5	1.5	4.5	4.5	7.5

CHANGES MADE DURING CONSTRUCTION HAVE BEEN INCORPORATED ON THESE PLANS EXCEPT CHANGES IN THE ORIGINAL THEORETICAL QUANTITIES. FOR ACTUAL QUANTITIES, REFER TO PROJECT LEDGER AND/OR COMPUTATION BOOK.

RESIDENT ENGINEER 4/21/16 DATE

DEPARTMENT OF TRANSPORTATION
STATE OF HAWAII
APPROVED: *[Signature]* 2/7/00
DIR. OF TRANSPORTATION DATE

WARREN S. UNEMORI ENG. DESIGNED BY R. HIRONAKA 692-7575 NOVEMBER, 1999 P. S. & E. BY DATE PHONE