


FED. ROAD DIST. NO.	STATE	PROJ. NO.	FISCAL YEAR	SHEET NO.	TOTAL SHEETS
HAWAII	HAW.	32A-01-12	2012	ADD.6	9

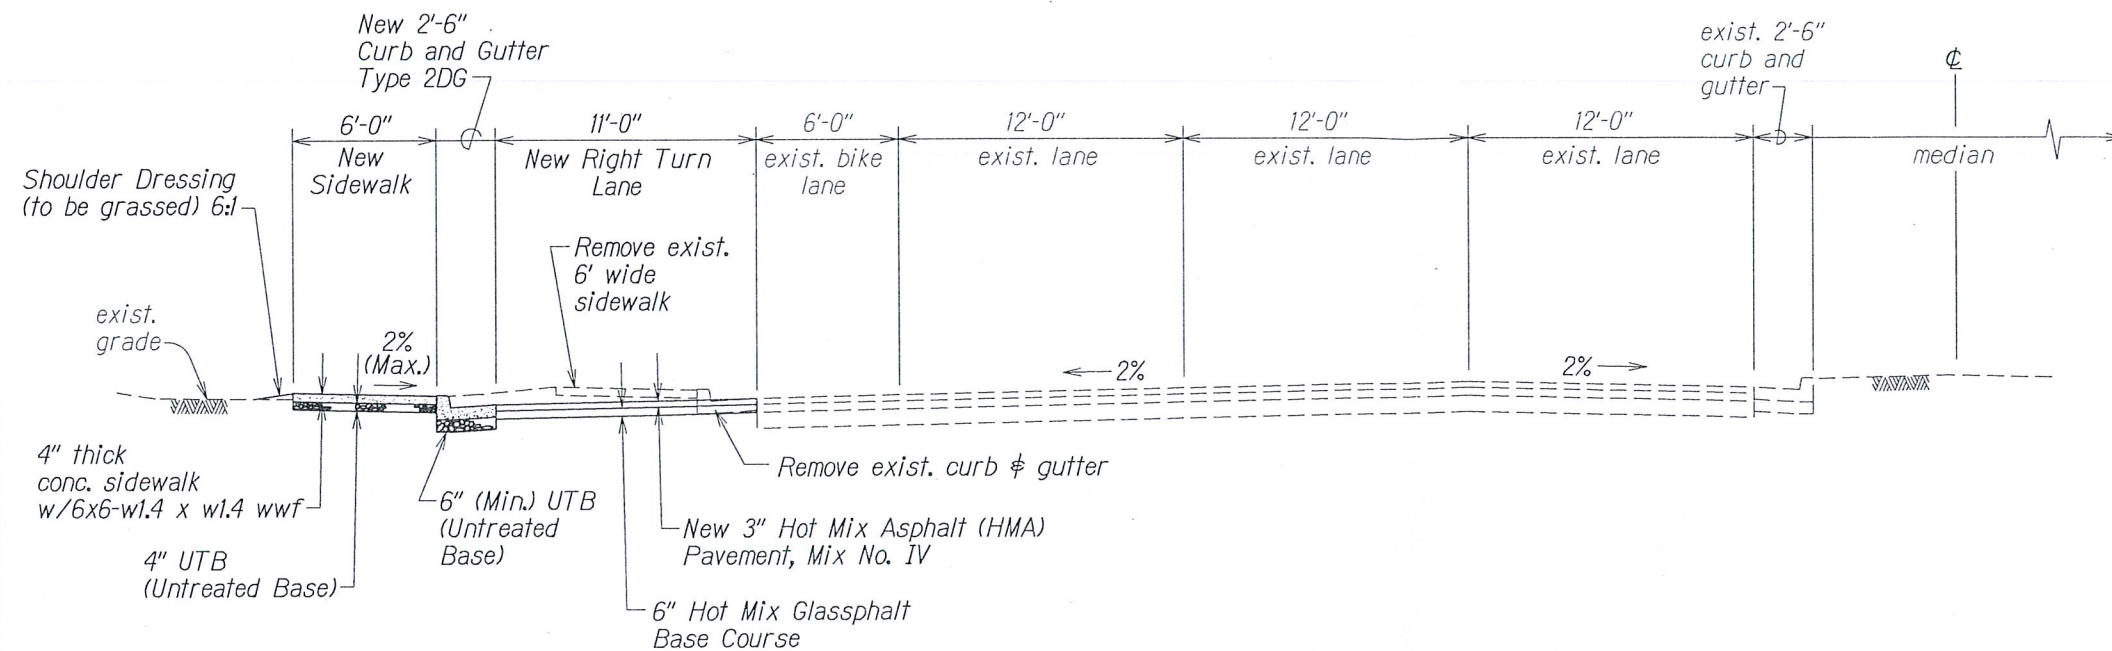


TYPICAL SECTION
 (KAAHUMANU AVENUE RIGHT TURN LANE
 INTO BALDWIN HIGH SCHOOL)
 Scale: 1/4" = 1'-0"

ORIGINAL PLAN	SURVEY PLOTTED BY	DATE
NOTE BOOK	DRAWN BY	
	DESIGNED BY	
	QUANTITIES BY	
	CHECKED BY	

6-14-12	Revise Typical Section.
DATE	REVISION
STATE OF HAWAII DEPARTMENT OF TRANSPORTATION HIGHWAYS DIVISION TYPICAL SECTION KAAHUMANU AVENUE IMPROVEMENTS RIGHT TURN LANE INTO BALDWIN HIGH SCHOOL Project No. 32A-01-12 Scale: As Shown Date: May, 2012	
SHEET No. 1 OF 1 SHEETS	

FED. ROAD DIST. NO.	STATE	PROJ. NO.	FISCAL YEAR	SHEET NO.	TOTAL SHEETS
HAWAII	HAW.	32A-01-12	2012	ADD.9	9

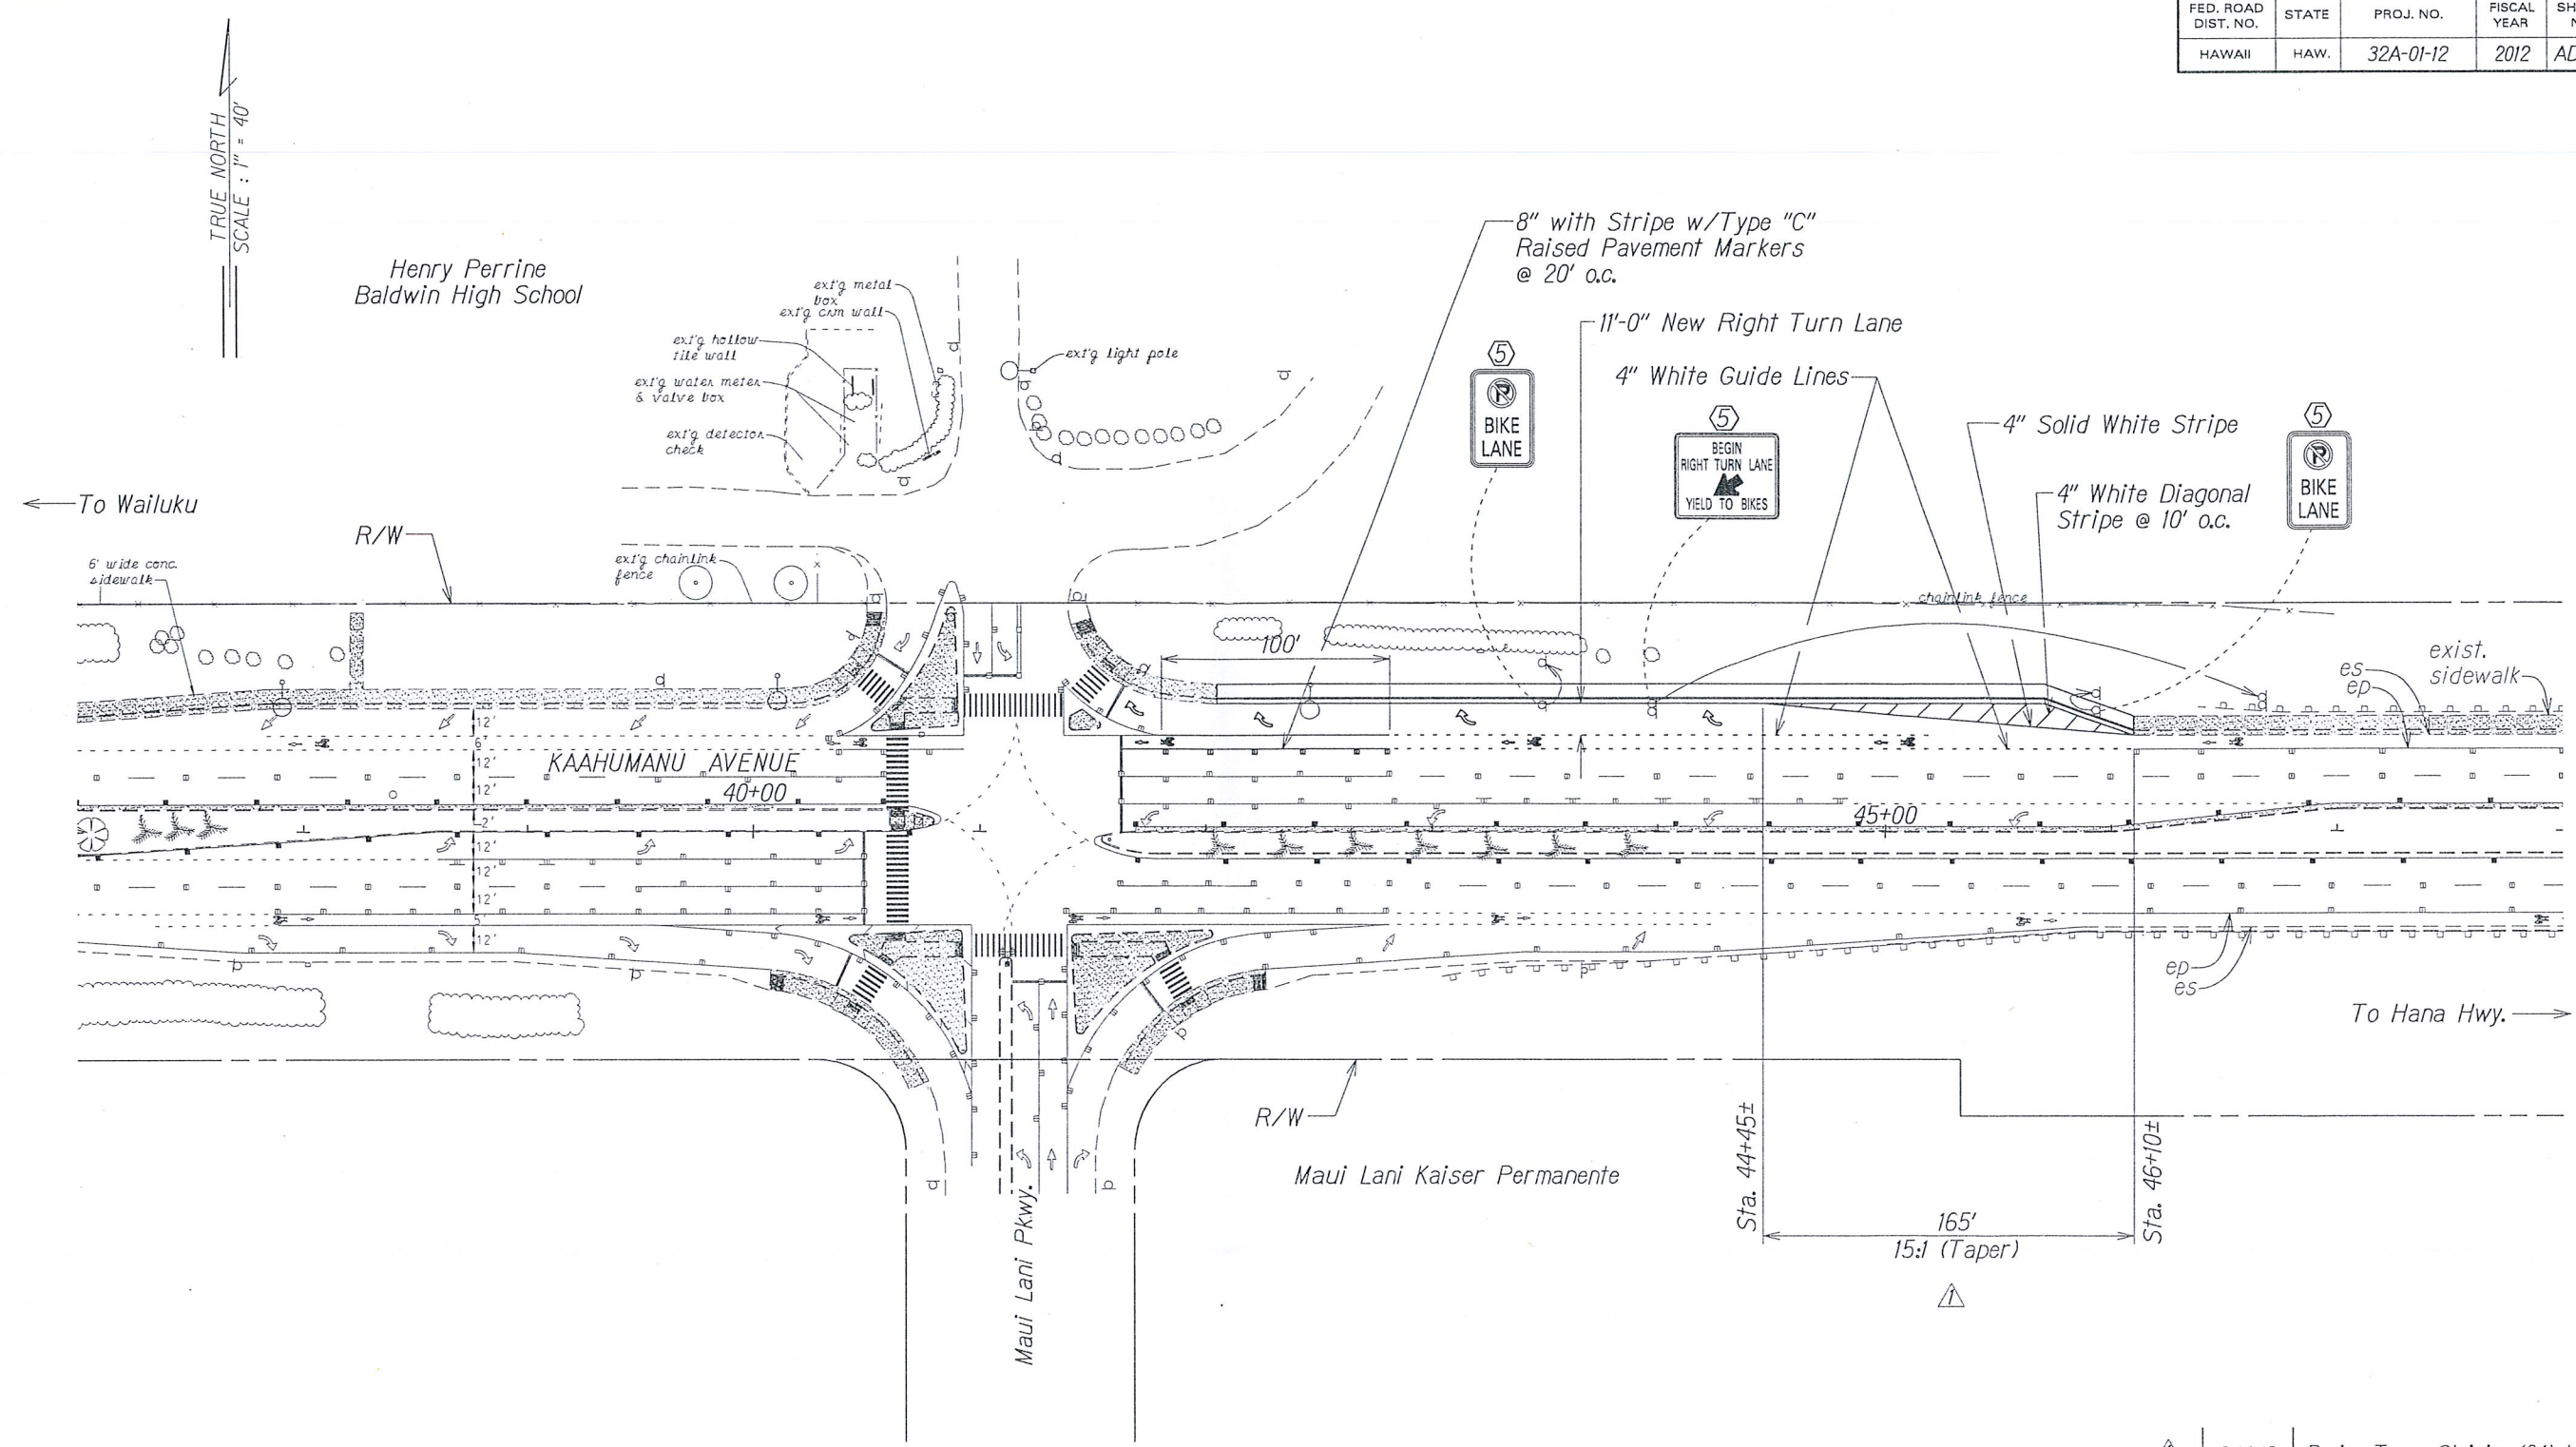

ORIGINAL PLAN	SURVEY PLOTTED BY	DATE
NOTED BY	DRIVEN BY	
NOTED BY	QUANTITIES BY	
NOTED BY	CHECKED BY	

KEY:
 (5) Relocate Existing Sign(s)

6-14-12	Revise Taper Striping (8:1) to (15:1).
6-14-12	Delete Key Nos. 1 to 4.
DATE	REVISION
STATE OF HAWAII DEPARTMENT OF TRANSPORTATION HIGHWAYS DIVISION SIGNING & PAVEMENT MARKING PLAN KAAHUMANU AVENUE IMPROVEMENTS RIGHT TURN LANE INTO BALDWIN HIGH SCHOOL Project No. 32A-01-12 Scale: 1" = 40' Date: May, 2012 SHEET No. 1 OF 1 SHEETS	

ADD.9