



FED. ROAD DIST. NO.	STATE	PROJ. NO.	FISCAL YEAR	SHEET NO.	TOTAL SHEETS
HAWAII	HAW.	32A-01-12	2012	ADD.6	9

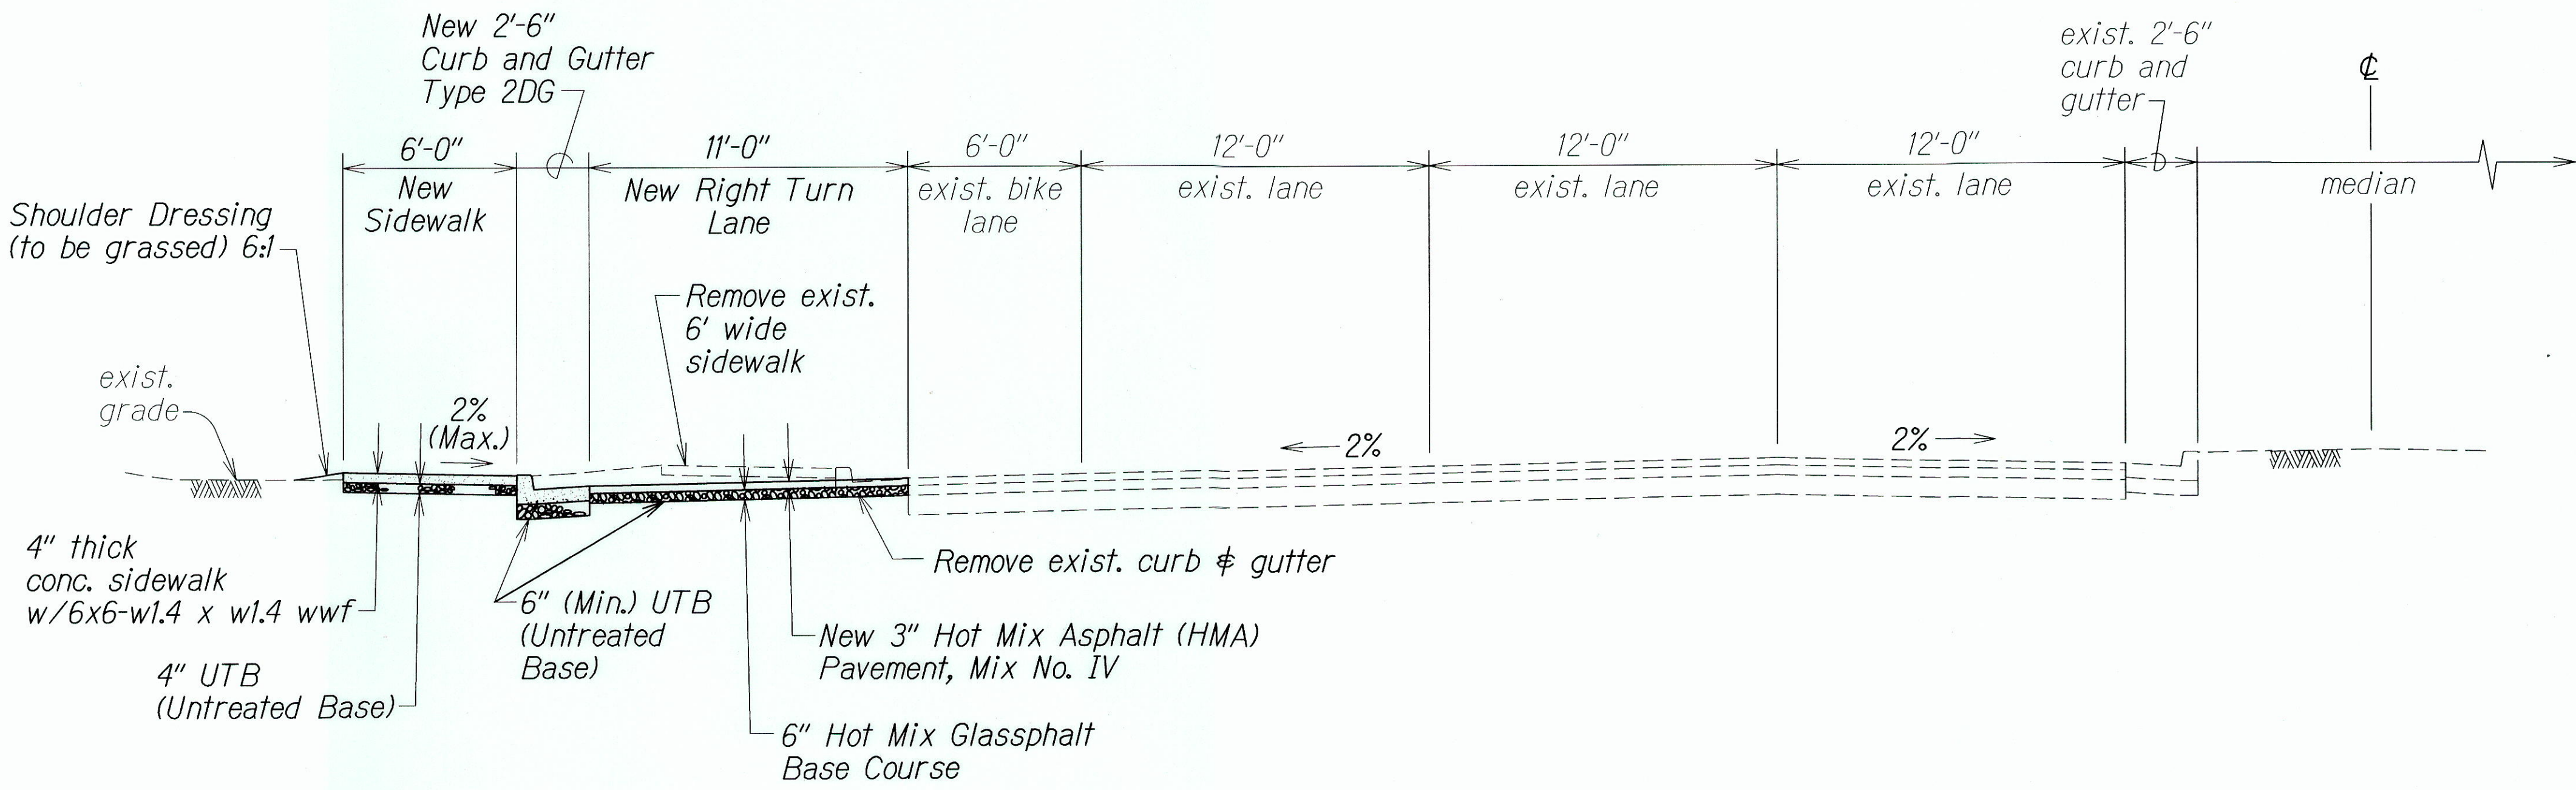

▲ TYPICAL SECTION  
(KAAHUMANU AVENUE RIGHT TURN LANE  
INTO BALDWIN HIGH SCHOOL)  
 Scale: 1/4" = 1'-0"

SURVEY PLOTTED BY	DATE
DRAWN BY	
TRACED BY	
QUANTITIES BY	
CHECKED BY	
ORIGINAL PLAN	
NOTE BOOK	
N <sup>o</sup> .	

	6-14-12	Revise Typical Section.
DATE	REVISION	
<div>STATE OF HAWAII DEPARTMENT OF TRANSPORTATION HIGHWAYS DIVISION  <u><b>TYPICAL SECTION</b></u>  <u>KAAHUMANU AVENUE IMPROVEMENTS</u> <u>RIGHT TURN LANE INTO</u> <u>BALDWIN HIGH SCHOOL</u> <u>Project No. 32A-01-12</u>  Scale: As Shown      Date: May, 2012</div>		
SHEET No. 1 OF 1 SHEETS		

LEGEND FOR	
AS-BUILT POSTINGS	
	Squiggly line for as-built deletion
	Double line for as-built deletion
Roadway	Text for as-built posting

"AS-BUILT"

ADD.6